

O.D.O.T. DISTRICT 2 SURVEY OFFICE (USE ONLY)

PERSONNEL _____ REFERENCE NO. 42 B SHEET 11 OF 16
 NOTES RHOADES DATE 4/14/14 ROUTE SR 18
 H.C. ROUSOS WEATHER CLOUDY COUNTY HENRY
 R.C. RHOADES TEMP. 58° TOWNSHIP BARTLOW
 _____ SECTION 24
 _____ T 3 N R 8 E

TYPE MONUMENT MAG/WASHER


ON SURFACE - ~~BELOW~~ ON

~~LEFT~~ - CL PAV'T - RIGHT 9.9'

2.0' TO RT EDGE PAVEMENT

S.L.M. 1054+05.09

Grid: Northing: 563682.017 Easting: 1584870.033

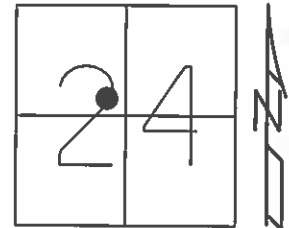

RECORD:
 PLAN STA 1054+13.47
 $\Delta = 19^\circ 01' LT$

FD PK/WASHER
 8/8/01, MB


SET PK/WASHER
 11/27/01, MC

DNF PK/WASHER
 SET MAG/WASHER
 WITH ORIGINAL TIES
 11/16/12
 GPS, CLB42
 11/20/12, SDC

GPS, REFB42
 4/15/14, TMR

SET MAG/WASHER
 7/25/14, EBW

GPS, NEWREFB42
 7/29/14, JMR

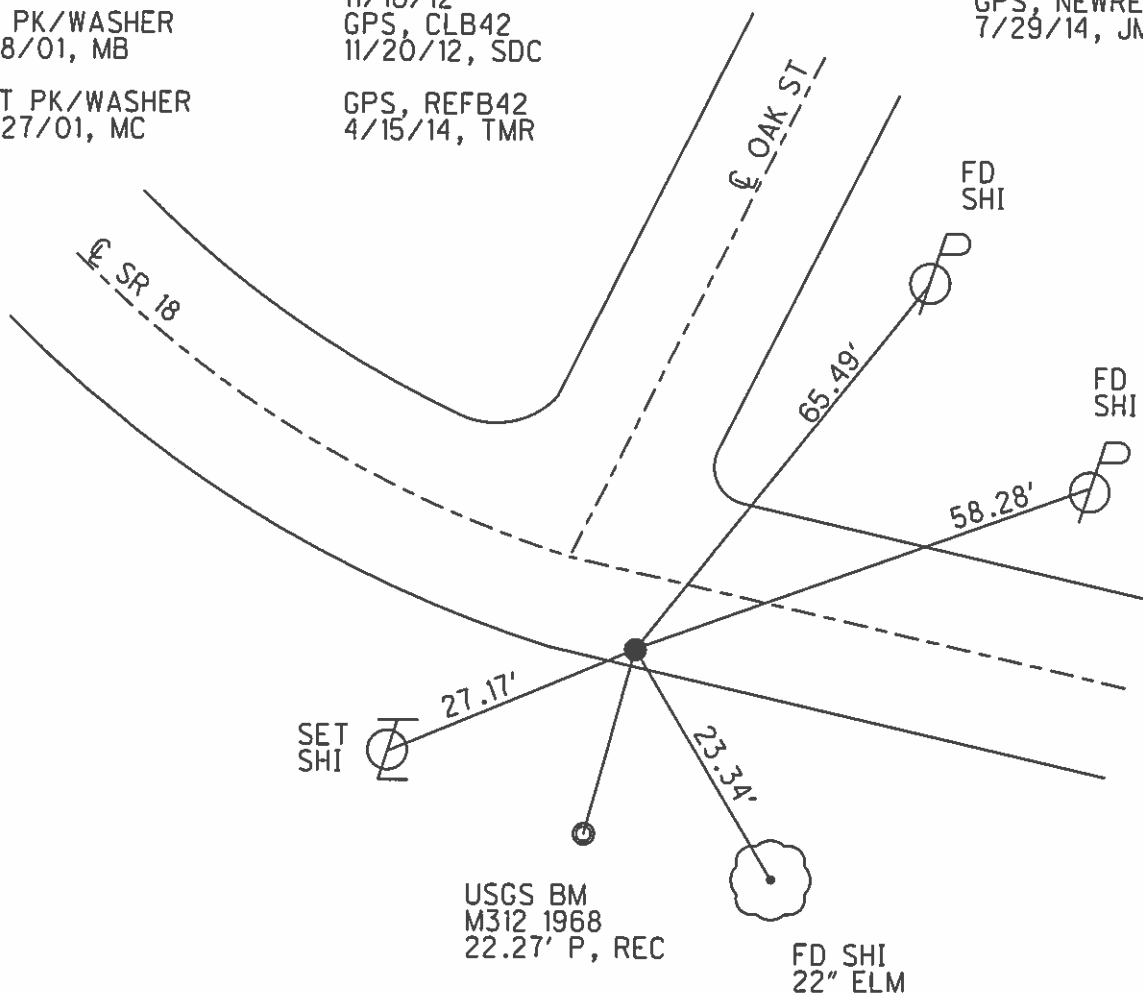

O.D.O.T. DISTRICT 2 SURVEY OFFICE

PERSONNEL

REFERENCE NO. 42-B

SHEET 10 OF 14

NOTES CAMERBURY

H.C. BARDHISEL

DATE 8-8-01

ROUTE 18

R.C. MOSER

WEATHER Sunny

COUNTY HENRY

Drawn By: MOSER

TEMP. +80°F

TOWNSHIP BARTLOW

SECTION 24

T3 N R 8 E


TYPE MONUMENT PK / WASHER

ON SURFACE - ~~BELOW~~ ON

~~LEFT -~~ PAV'T. - RIGHT 9.9' RT.

2.0' TO RT. EDGE PAVEMENT


S.L.M. 1053 + 99

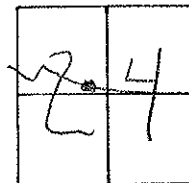

RECORD:

PLAN STA 1054 + 13.47
 $\Delta = 19^{\circ} 01' \text{ LT.}$

RESET PK/WASHER
 11-27-01
 MRC.

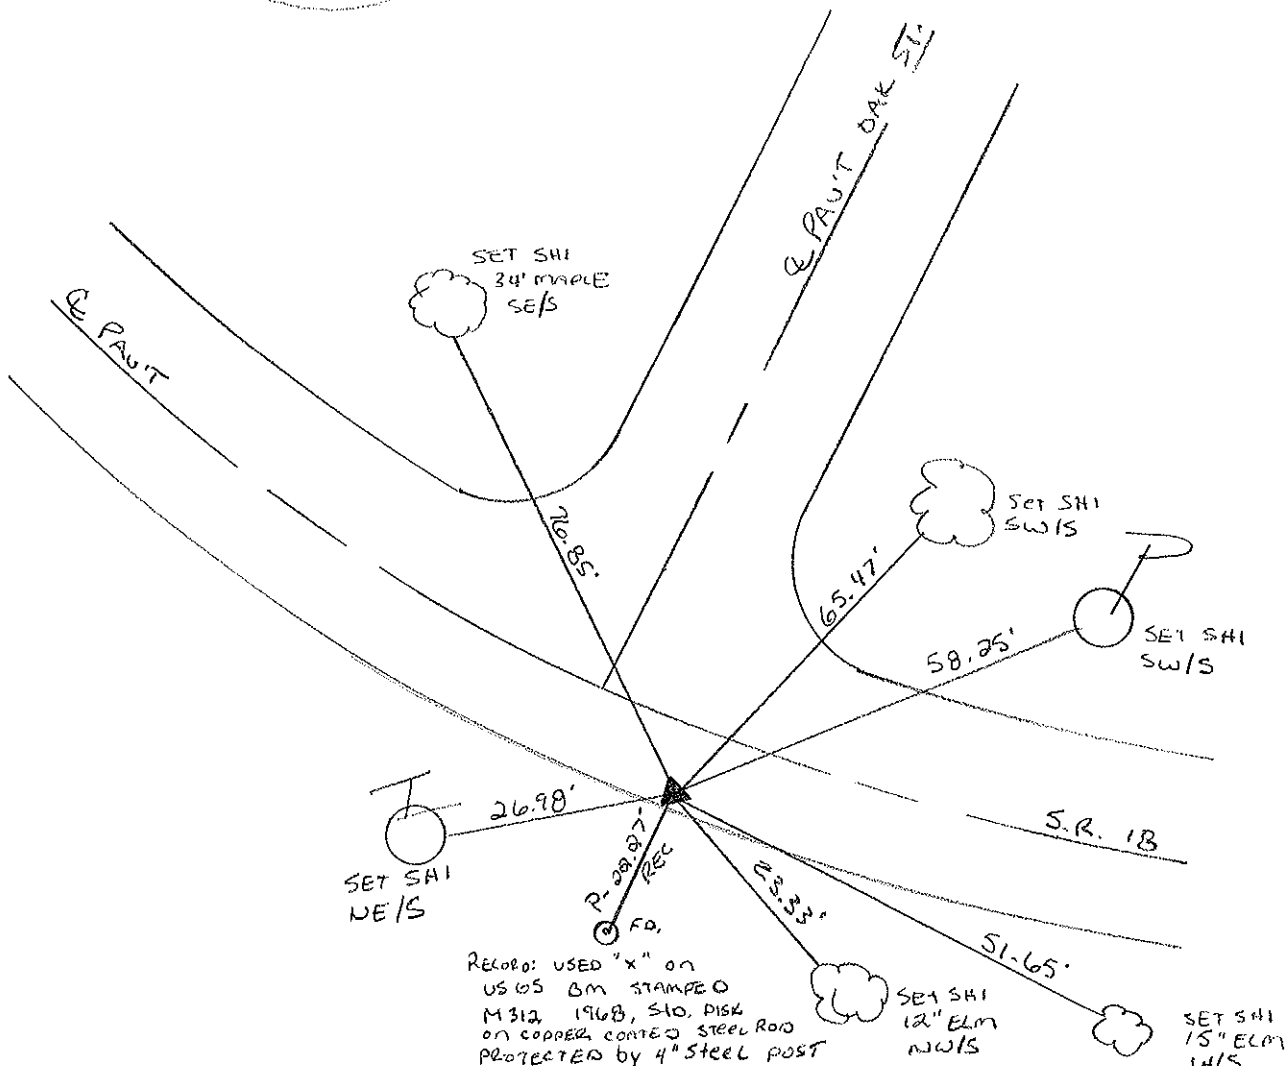

O.D.O.T. DISTRICT 2 SURVEY OFFICE

PERSONNEL _____

REFERENCE NO. 42-B

SHEET _____ OF _____

NOTES BARNHISEL

H.C. " "

R.C. HOFFMAN

DATE 10-19-90

WEATHER cloudy

TEMP. +43°

ROUTE 18

COUNTY HEARNY

TOWNSHIP BAETLOW

SECTION 24

T 3 N R 8 E


TYPE MONUMENT P.K. & Washer

ON SURFACE - BELOW yes

LEFT - & PAV'T. - RIGHT 9.9


2.0 TO RT EDGE PAVEMENT

S.L.M. 1053+99

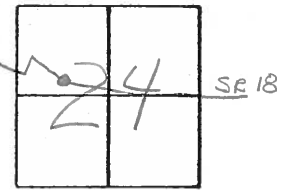

Record
PLAN STA: 1054+13.47
 $\Delta = 19^{\circ} 01' \text{ RT}$

Set P.K. / Washer
11-13-90
MB

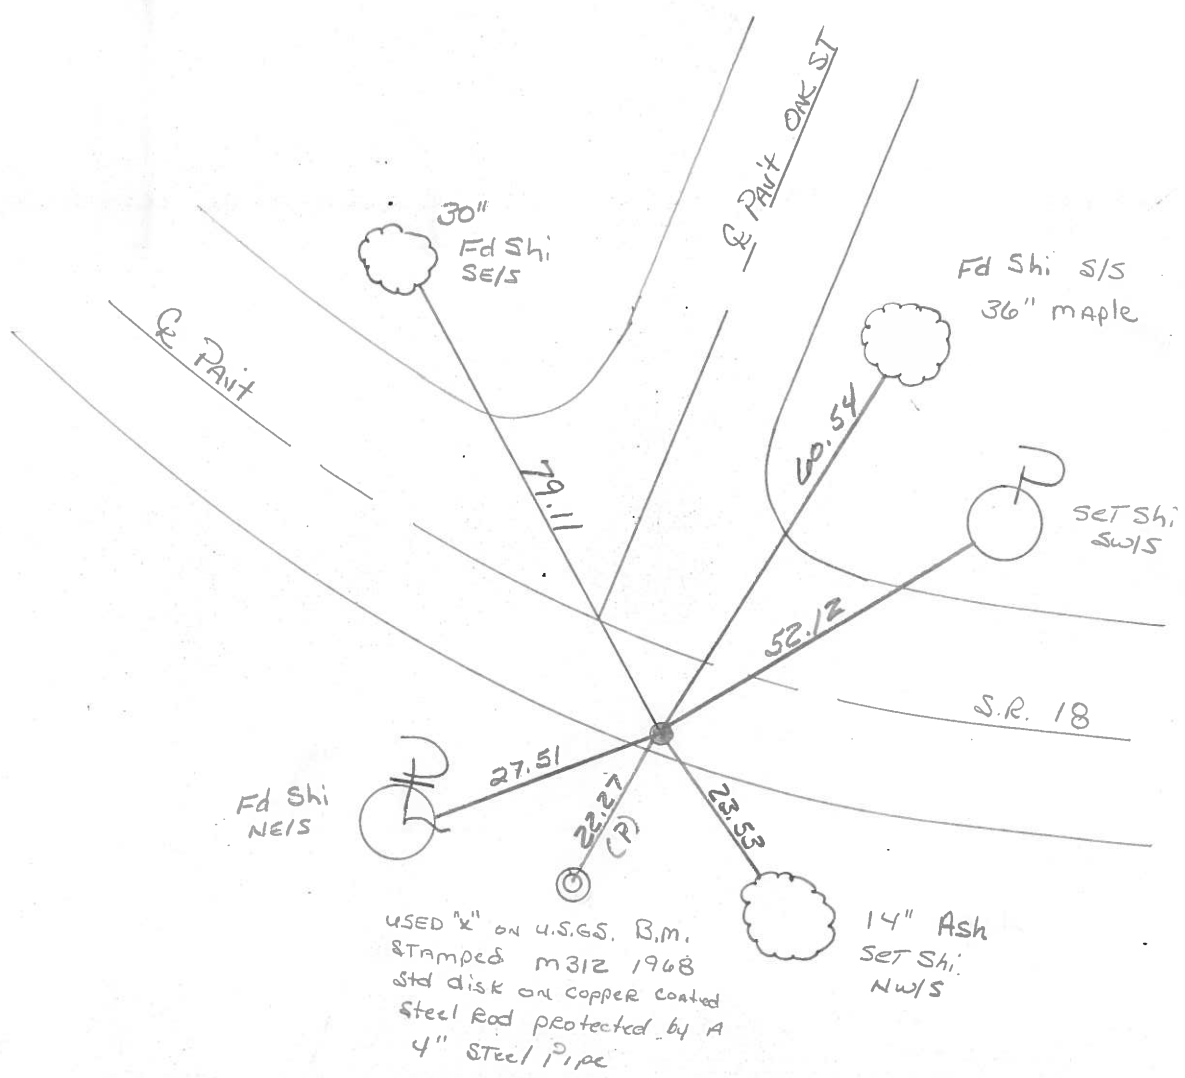

County HENRY S.R. 18

Date April 6, 83

Township BARTLOW

Weather OVERCAST

Section 24 (IN DESHLER)

Temp. +50°


T3N, R8E

Personnel HOFFMAN

HOUSEHOLDER

BARNHISEL

#42-B

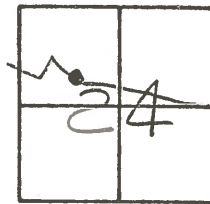

Fd SMALL R.R. spike @ surface

SLM 1053+92

10.7' Rt of & Paul SR18

1.1' TO S. EP SR18

4' EAST of & Paul N. OAK ST.


NOTE !!!

THIS REF. DOES NOT FIT CURVE DATA

SET P.K./WASHER

9-20-83

C.L.

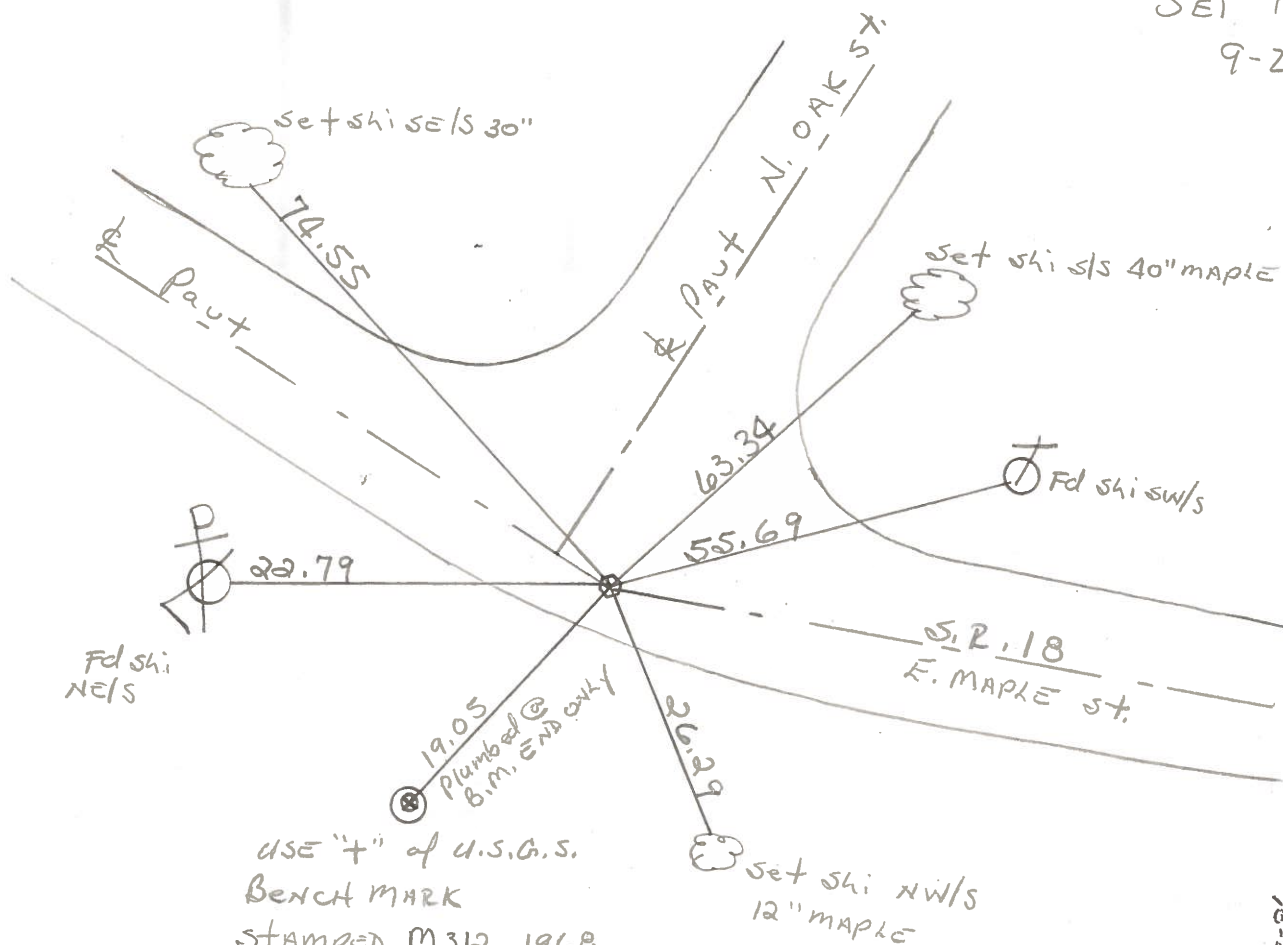

Fd shi NW/S

USE "t" of U.S.G.S. BENCH MARK STAMPED M312 1968 STD DISK ON COPPER COATED STEEL ROD PROTECTED BY A 4" STEEL PIPE

NOTES: THIS FROM 1983 SURVEY STONE IN OCT 74. A NEW SURVEY WAS DONE FOR BRIDGE #2001 ON MAY 6, 1983. A NEW P.I. WAS SET. THIS SHEET IS NO LONGER VALID.

Sketch 10-22-90

Q.D.O.T. DISTRICT 2 SURVEY OFFICE

SHEET _____ OF _____

County Henry S.R. 18

Date 9 May 83

Township Bartlow

Weather Clear

Section 24

Temp. 57°


T.N, R.E

Personnel I. Stone

P. Neuse

D. Curtis

42-B

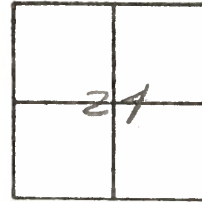


REF. No.

SET. P.K./WASHER

9-20-83


C.L.

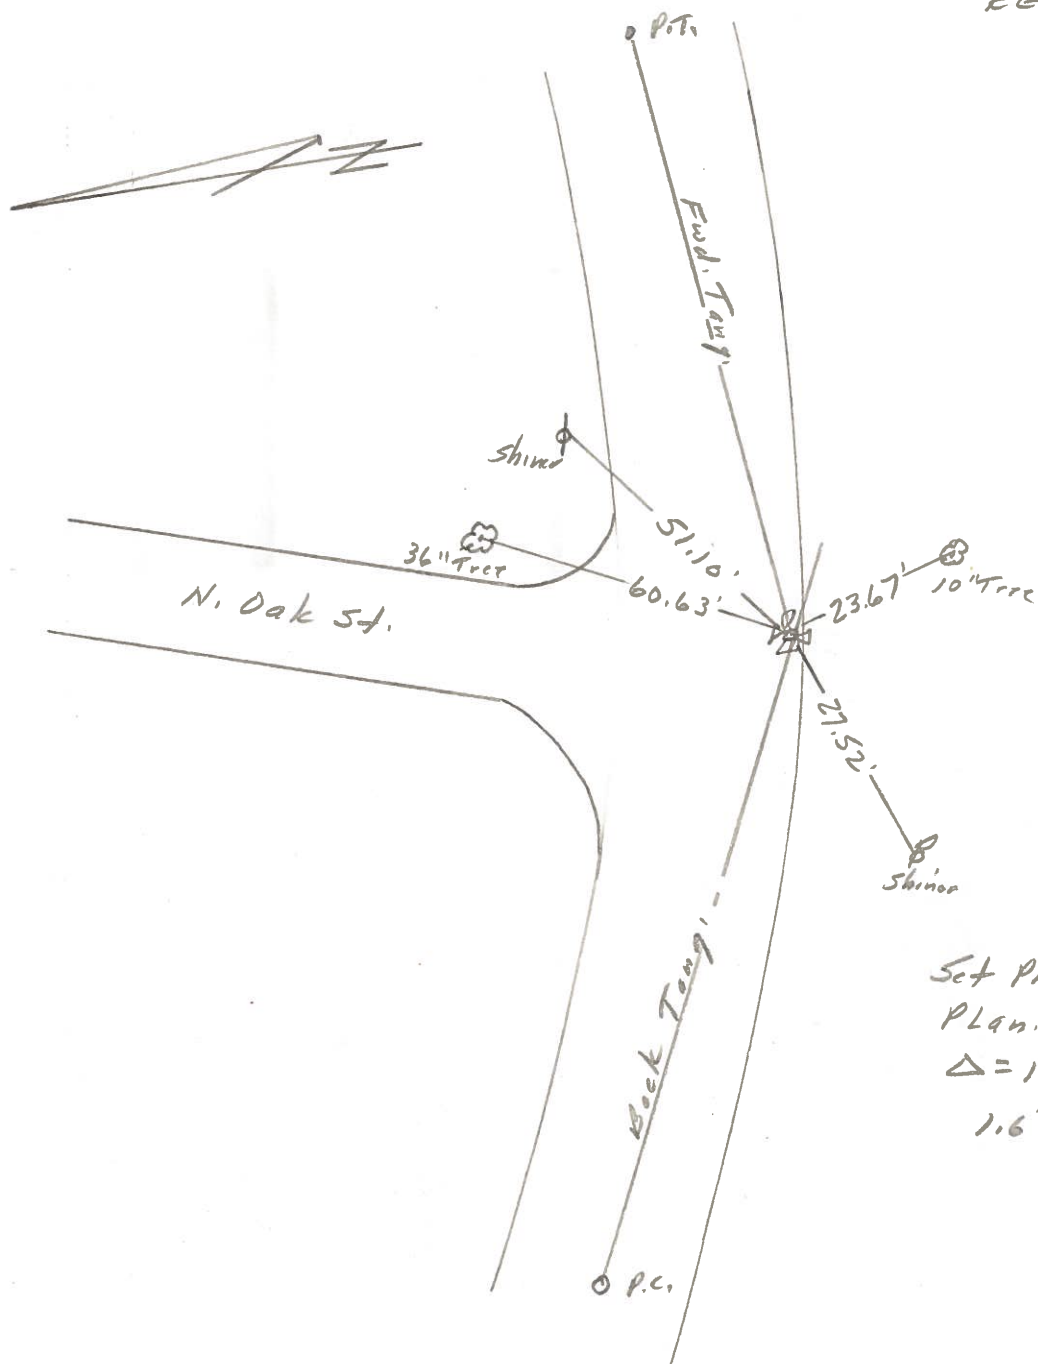

Set PK Nails per 1924
Plan. SLM Sta. 1054+13.47
 $\Delta = 19^{\circ}01' L+$
1.6' to S. edge put.

PERSONNEL	TITLE	PERSONNEL	TITLE	COUNTY	DATE	WEATHER	TEMP.
Stone				Henry	18 Sept. 74	Mild	70°
Michalak				S. R. #18			
Denno				SEC. Deshler			
Curtis							

DESCRIPTION Alignment LEFT CENTER LINE RIGHT JOB NO. 02999(6)

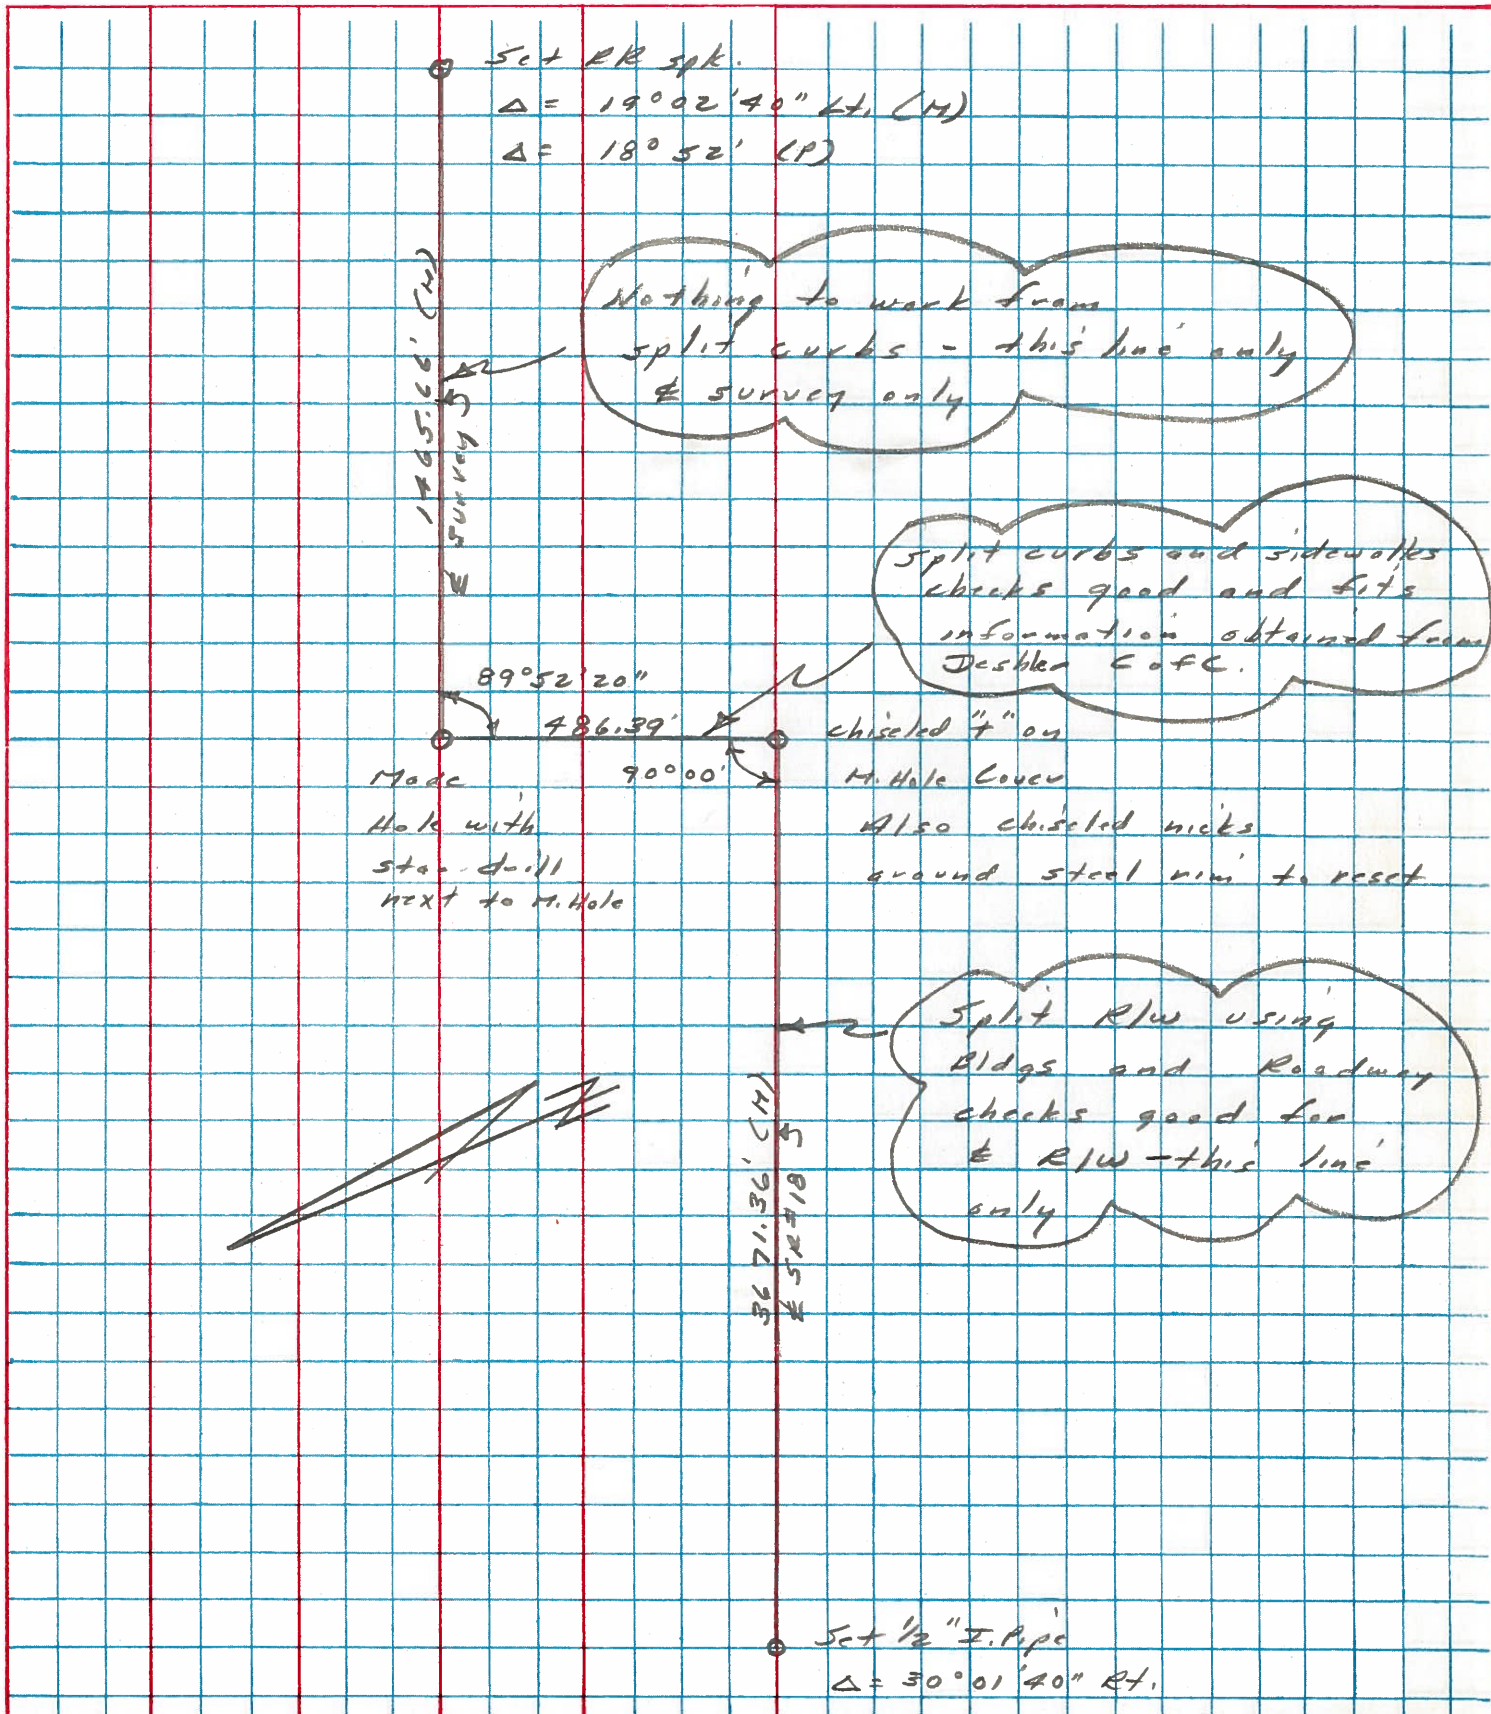

PERSONNEL	TITLE	PERSONNEL	TITLE	COUNTY	Henry	DATE	18 Sept. 74
Stone				S. R.	#18	WEATHER	Mild
Michalak				SEC.	Dashlee	TEMP.	70°
Deane							
Curtis							

DESCRIPTION _____ ALIGNMENT _____ JOB NO. 02999(0)

LEFT CENTER LINE RIGHT

