

O.D.O.T. DISTRICT 2 SURVEY OFFICE (USE ONLY)

PERSONNEL

REFERENCE NO. 43

SHEET 14 OF 17

NOTES AUBLE

DATE 5/18/21

ROUTE SR 18

H.C. NIESE

WEATHER CLEAR

COUNTY HENRY

R.C. O'DONNELL

TEMP. 67°

TOWNSHIP BARTLOW

SECTION 24

DWG BY NIESE

PID PAVETRAIN

T 3 N R 8 E

TYPE MONUMENT MAG/WASHER

ON SURFACE - ~~BELOW~~ ON

OFFSET 0.8' LT : ~~RT~~

9.5' TO LT EDGE PAVEMENT


STATION: 1073+67.52

HORZ. DATUM: NAD83(2011)


GEOID: NAVD88 2012A

GRID: NORTHING: 563279.579

EASTING: 1586790.738

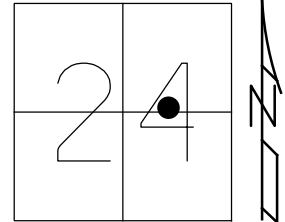


- RECORD:
 FD P.K./WASHER
 8/8/01, MB
 SET P.K./WASHER
 11/27/01, MC
 FD P.K./WASHER
 11/16/12, SDC
 11/20/12, SDC
 4/14/14, TMR
 4/15/14, TMR
 SET MAG/WASHER
 7/25/14, EBW
 FD MAG/WASHER
 7/29/14, JMR
 FD MAG/WASHER
 REF43
 5/18/21, JFO
 9/3/21, TDN

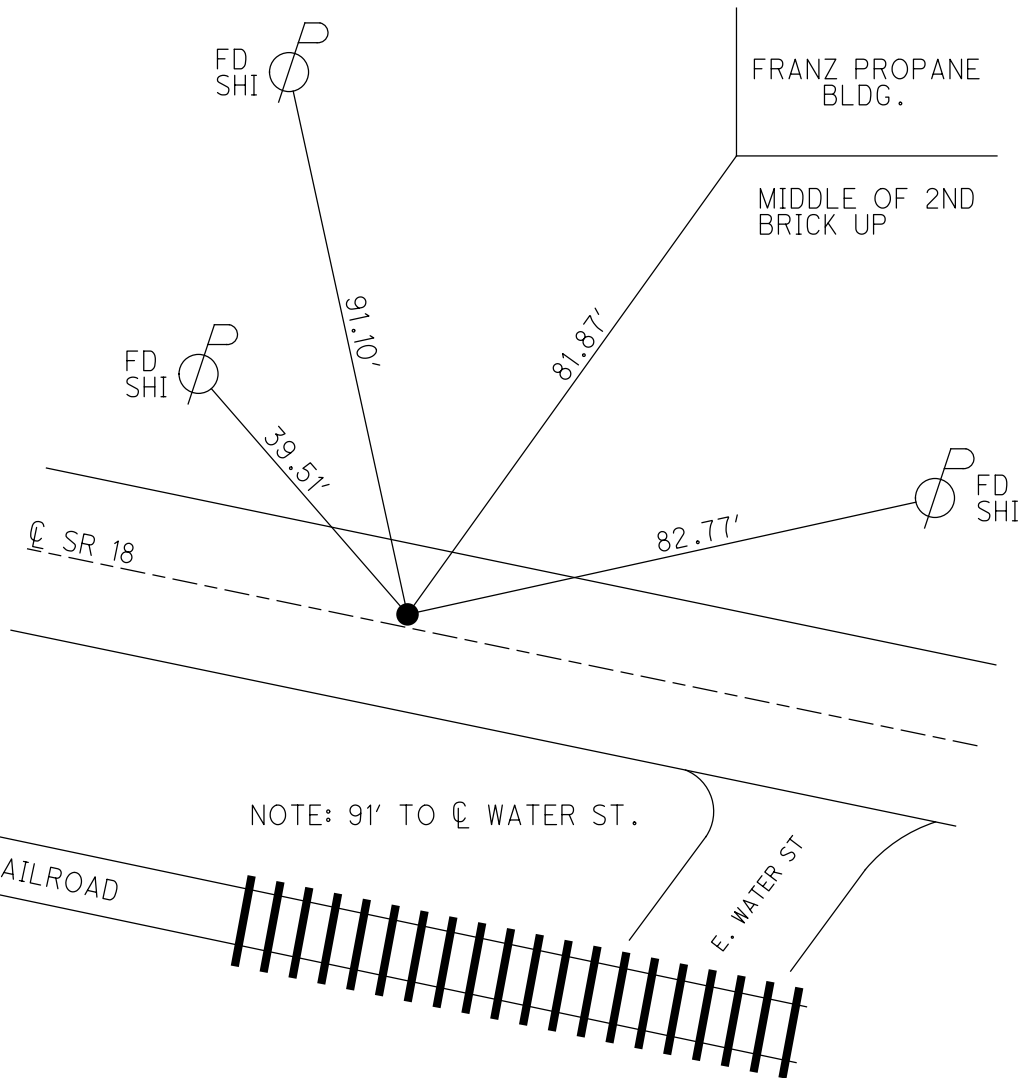

O.D.O.T. DISTRICT 2 SURVEY OFFICE (USE ONLY)


PERSONNEL	REFERENCE NO.	43	SHEET	13	OF	16
NOTES	RHOADES	DATE	4/14/14	ROUTE	SR 18	
H.C.	ROUSOS	WEATHER	CLOUDY	COUNTY	HENRY	
R.C.	RHOADES	TEMP.	58°	TOWNSHIP	BARTLOW	
				SECTION	24	
				T	3	N
				R	8	E

TYPE MONUMENT PK/WASHER
 ON SURFACE - ~~BELOW~~ ON
 LEFT - ☉ PAV'T - ~~RIGHT~~ 0.8'
9.5' TO LT EDGE PAVEMENT
 S.L.M. 1073+67.52
 Grid: Northing: 563173.013 Easting: 1588313.137

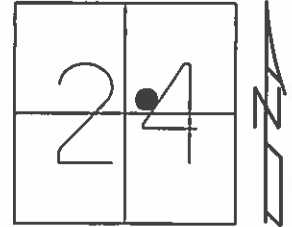

RECORD:

- FD PK/WASHER
8/8/01, MB
- SET PK/WASHER
11/27/01, MC
- FD PK/WASHER
11/16/12
GPS, CL43
11/20/12, SDC
- GPS, REF43
4/15/14, TMR
- SET MAG/WASHER
7/25/14, EBW
- GPS, NEWREF43
7/29/14, JMR

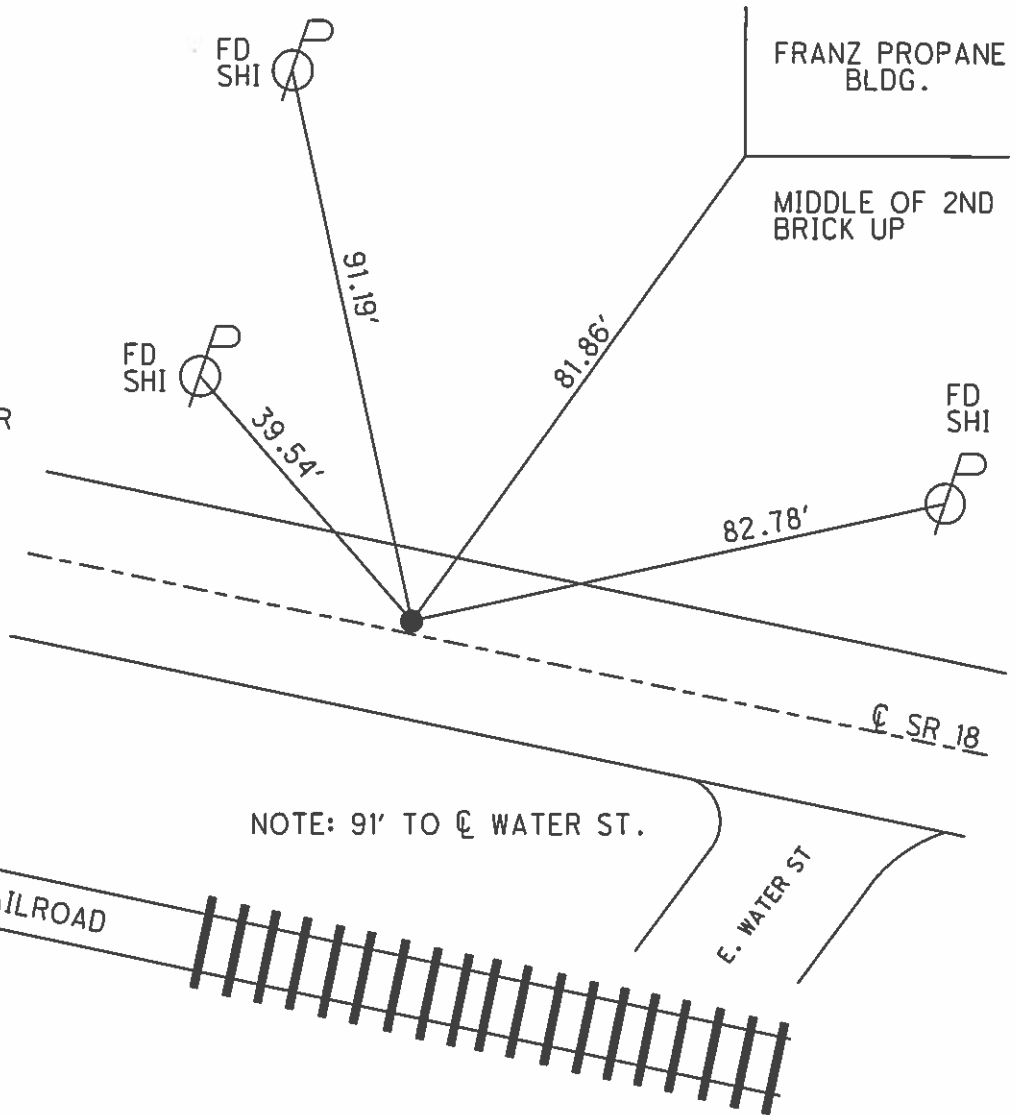

O.D.O.T. DISTRICT 2 SURVEY OFFICE

PERSONNEL

REFERENCE NO. 43

SHEET 12 OF 14

NOTES CANTERBURY

H.C. BARANISEL

DATE 8-8-01

ROUTE 18

R.C. MOSEK

WEATHER Sunny

COUNTY HENRY

DRAWN BY: MOSEK


TEMP. +80°F

TOWNSHIP CARTLOW

SECTION 24


T 3 N R 8 E

TYPE MONUMENT PK WASHER
 ON SURFACE - BELOW ON
 LEFT - C PAV'T. - RIGHT O.B. LT
9.5' TO LT. EDGE PAVEMENT
 S.L.M. 1073 +59

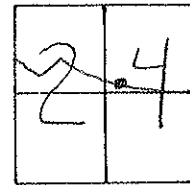

RESET PK WASHER
 11-27-01
 MRC

FRANZ PROPANE

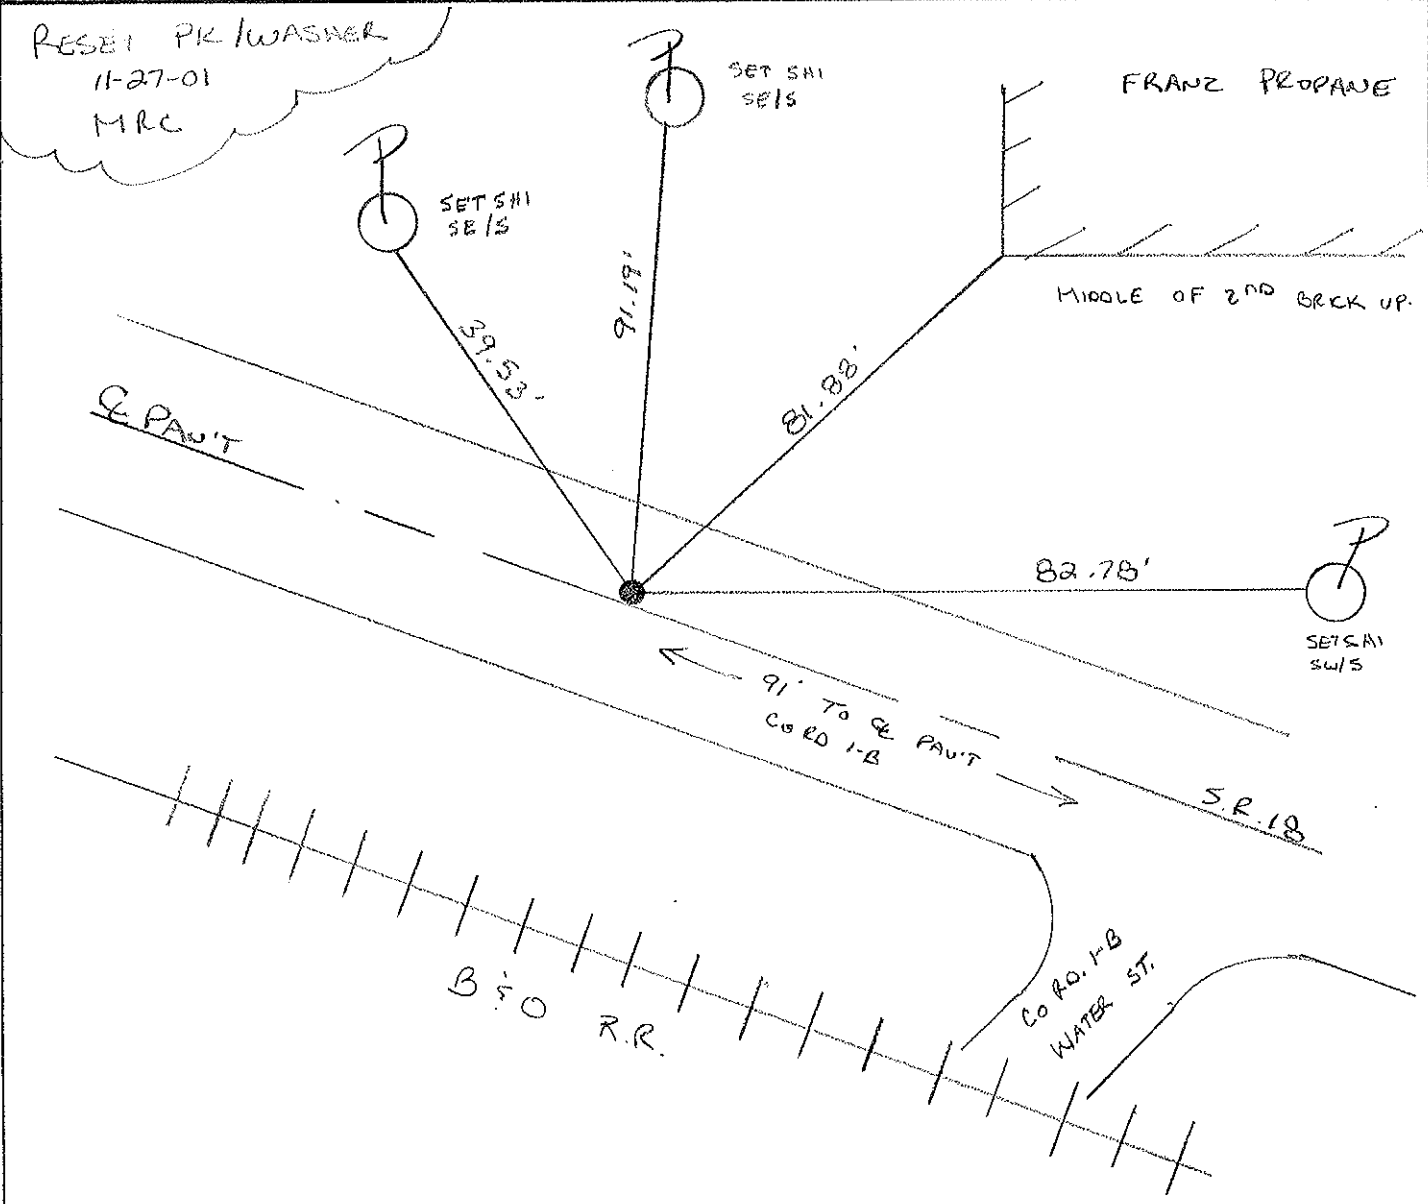

O.D.O.T. DISTRICT 2 SURVEY OFFICE

PERSONNEL _____

REFERENCE NO. 43

SHEET _____ OF _____

NOTES BARNHISEL

H.C. " "

DATE 10-19-90

ROUTE 18

R.C. HOFFMAN

WEATHER Cloudy

COUNTY HENRY

TEMP. +43°

TOWNSHIP BAETLOW

SECTION 24

T 3 N R 8 E


TYPE MONUMENT P.K. & Washer

ON SURFACE - BELOW YES


LEFT - 0 PAV'T. - RIGHT 1.0

9.5 TO LT EDGE PAVEMENT

S.L.M. 1073+59

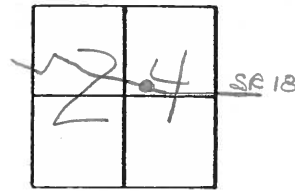

Set P.K./Washer
11-13-90
MB

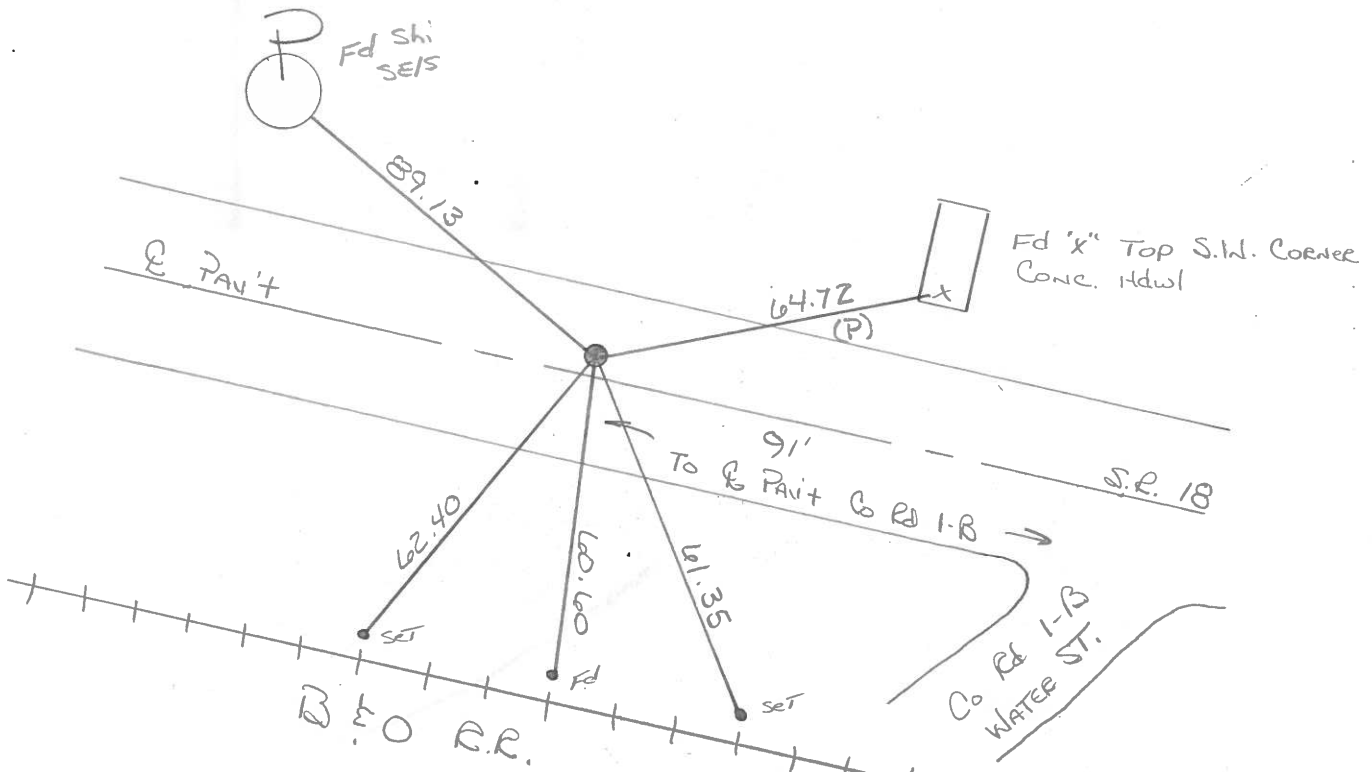

SET Shi's IN
TOP OF R.R. TIES

County HENRY S.R. 18

Date April 6, 83

Township BARTLOW

Weather OVERCAST

Section 24

Temp. +50°

T3N, R8E

Personnel HOFFMAN



HOUSEHOLDER

BARNHISEL

43

Fd SMALL R.R. SPK @ SURFACE

SLM 1073 +59


0.7' Lt of & PAUT

SET P.K./WASHER

10.1' TO N. EP.

10.5' TO S. EP.


9-20-83 G.L.

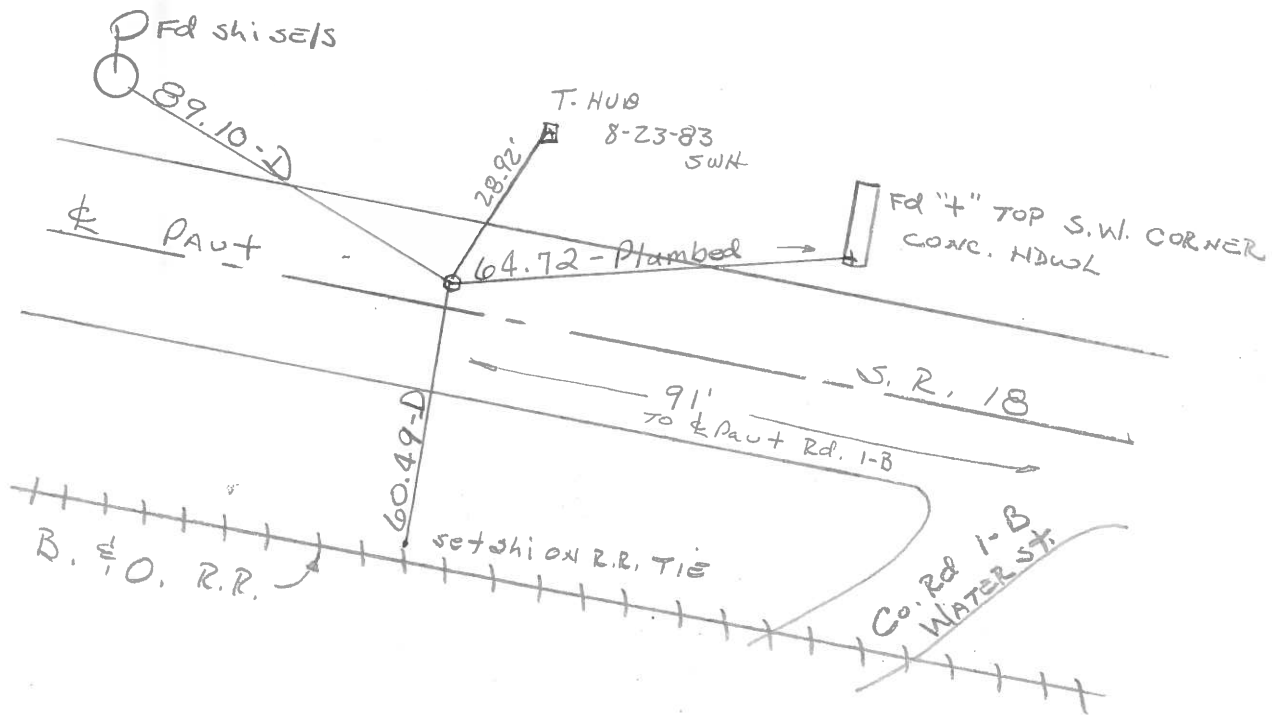

PERSONNEL	TITLE	PERSONNEL	TITLE	COUNTY	DATE
Stone				Henry	8 Oct. 77
Michaelak				S. R. #18	WEATHER Cool
Denno				SEC. Bartlow Twp.	TEMP. 51°
Curtis					

DESCRIPTION References to Control Points JOB NO. _____

LEFT CENTER LINE RIGHT

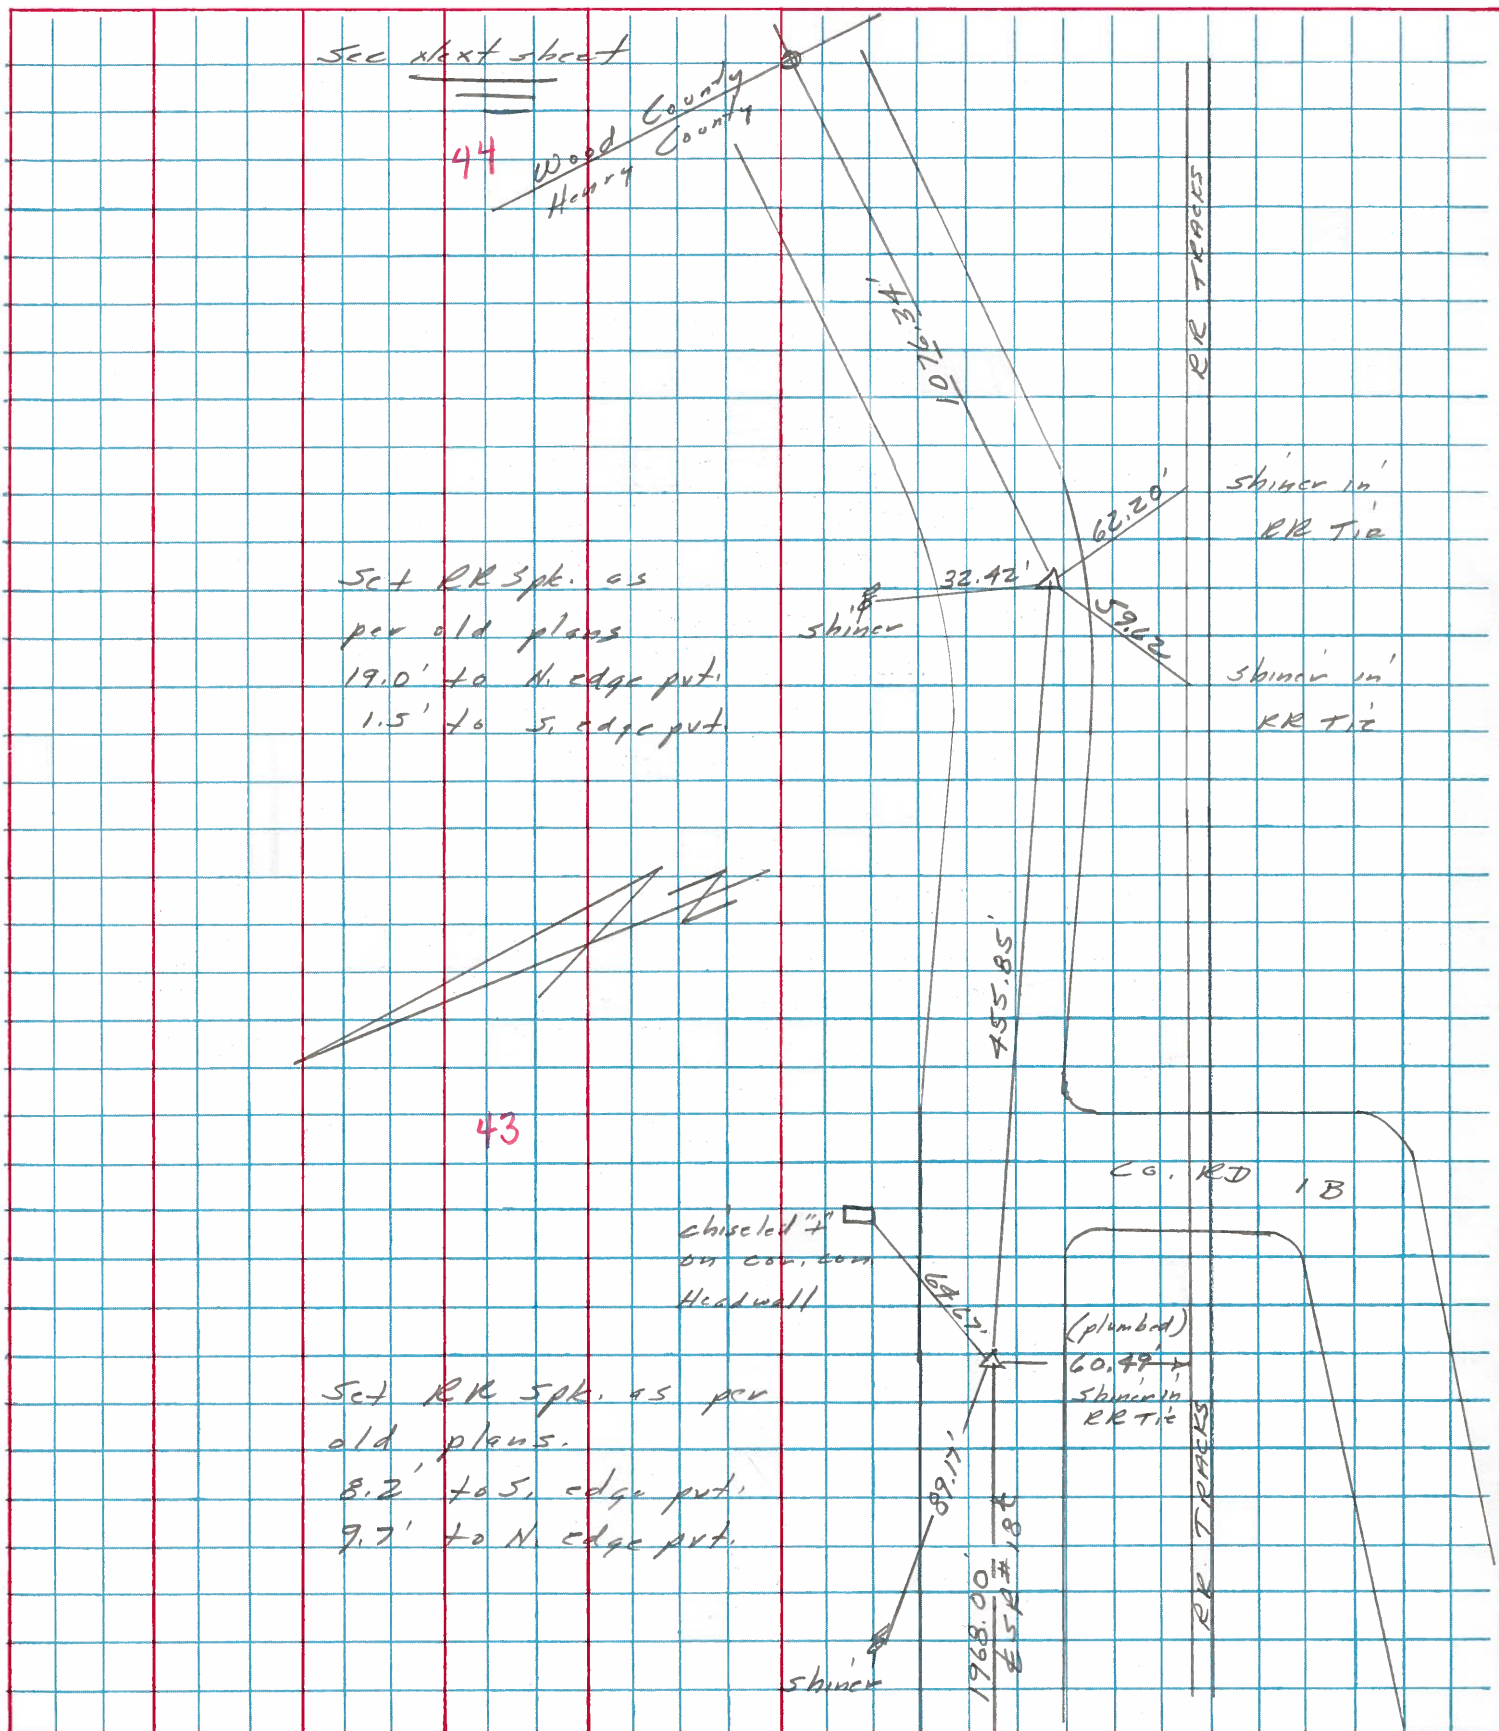

PERSONNEL	TITLE	PERSONNEL	TITLE	COUNTY	Henry	DATE	18 Sept. 74
Stone				S. R.	#18	WEATHER	Mild
Michalak				SEC.	Dashlee	TEMP.	70°
Deane							
Curtis							

DESCRIPTION _____ Alignment _____ JOB NO. 02999(0)

LEFT CENTER LINE RIGHT

