


O.D.O.T. DISTRICT 2 SURVEY OFFICE (USE ONLY)


PERSONNEL _____ REFERENCE NO. 43 A SHEET 15 OF 17
 NOTES AUBLE DATE 5/18/21 ROUTE SR 18
 H.C. NIESE WEATHER CLEAR COUNTY HENRY
 R.C. O'DONNELL TEMP. 70° TOWNSHIP BARTLOW
 SECTION 24
 DWG BY NIESE PID PAVETRAN T 3 N R 8 E

TYPE MONUMENT MAG/WASHER
 ON SURFACE - ~~BELOW~~ ON
 OFFSET Q PAVEMENT 8.0' ~~LT~~ : RT
3.0' TO RT EDGE PAVEMENT
 STATION: 1078+23.60

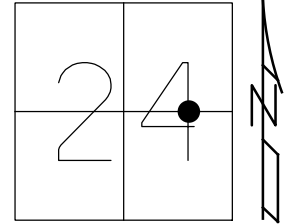

HORIZ.DATUM: NAD83(2011) GEOID: NAVD88 2012A
 GRID: NORTHING: 563172.976 EASTING: 1587234.160


- RECORD:
 FD P.K./WASHER
 8/8/01, MB
 SET P.K./WASHER
 11/27/01, MRC
 FD P.K./WASHER
 11/16/12, SDC
 11/20/12, SDC
 4/14/14, TMR
 4/15/14, TMR
 SET MAG/WASHER
 7/25/14, EBW
 FD MAG/WASHER
 7/29/14, JMR
 FD MAG/WASHER
 REFA43
 5/18/21, JFO
 9/3/21, TDN

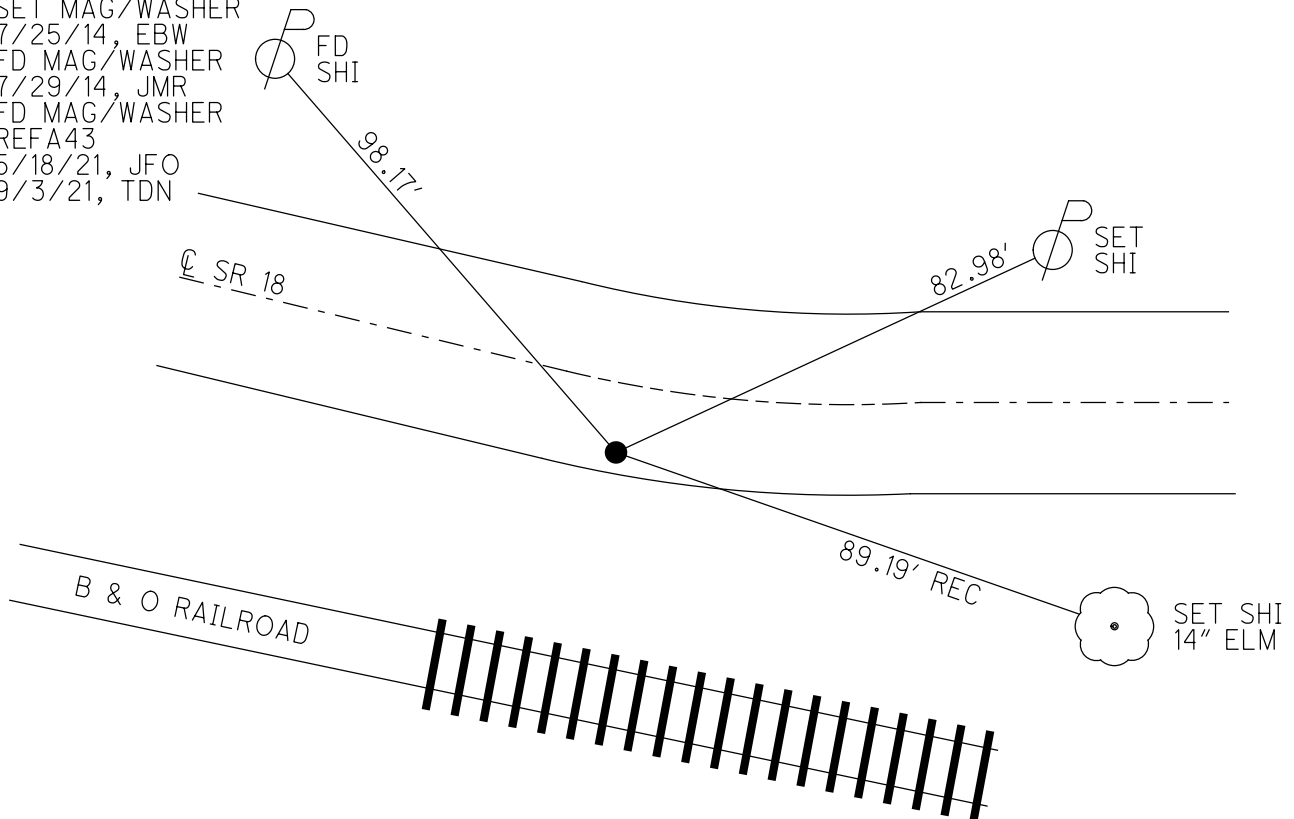

O.D.O.T. DISTRICT 2 SURVEY OFFICE (USE ONLY)


PERSONNEL _____ REFERENCE NO. 43 A SHEET 14 OF 16
 NOTES RHOADES DATE 4/14/14 ROUTE SR 18
 H.C. ROUSOS WEATHER CLOUDY COUNTY HENRY
 R.C. RHOADES TEMP. 58° TOWNSHIP BARTLOW
 _____ SECTION 11
 _____ T 3 N R 8 E

TYPE MONUMENT PK/WASHER
 ON SURFACE - ~~BELOW~~ ON
~~LEFT~~ - Q PAV'T - RIGHT 8.0'
3' TO RT EDGE PAVEMENT
 S.L.M. 1078+23.60

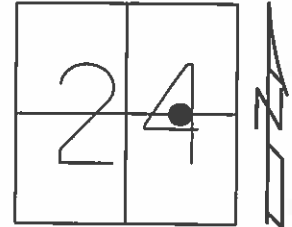

Grid: Northing: 563173.013 Easting: 1587234.087

RECORD:
 FD PK/WASHER 8/8/01, MB GPS, CLA43 11/20/12, SDC SET MAG/WASHER 7/25/14, EBW
 SET PK/WASHER 11/27/01, MRC GPS, REFA43 4/15/14, TMR GPS, NEWREFA43 7/29/14, JMR
 FD PK/WASHER 11/16/12, SDC

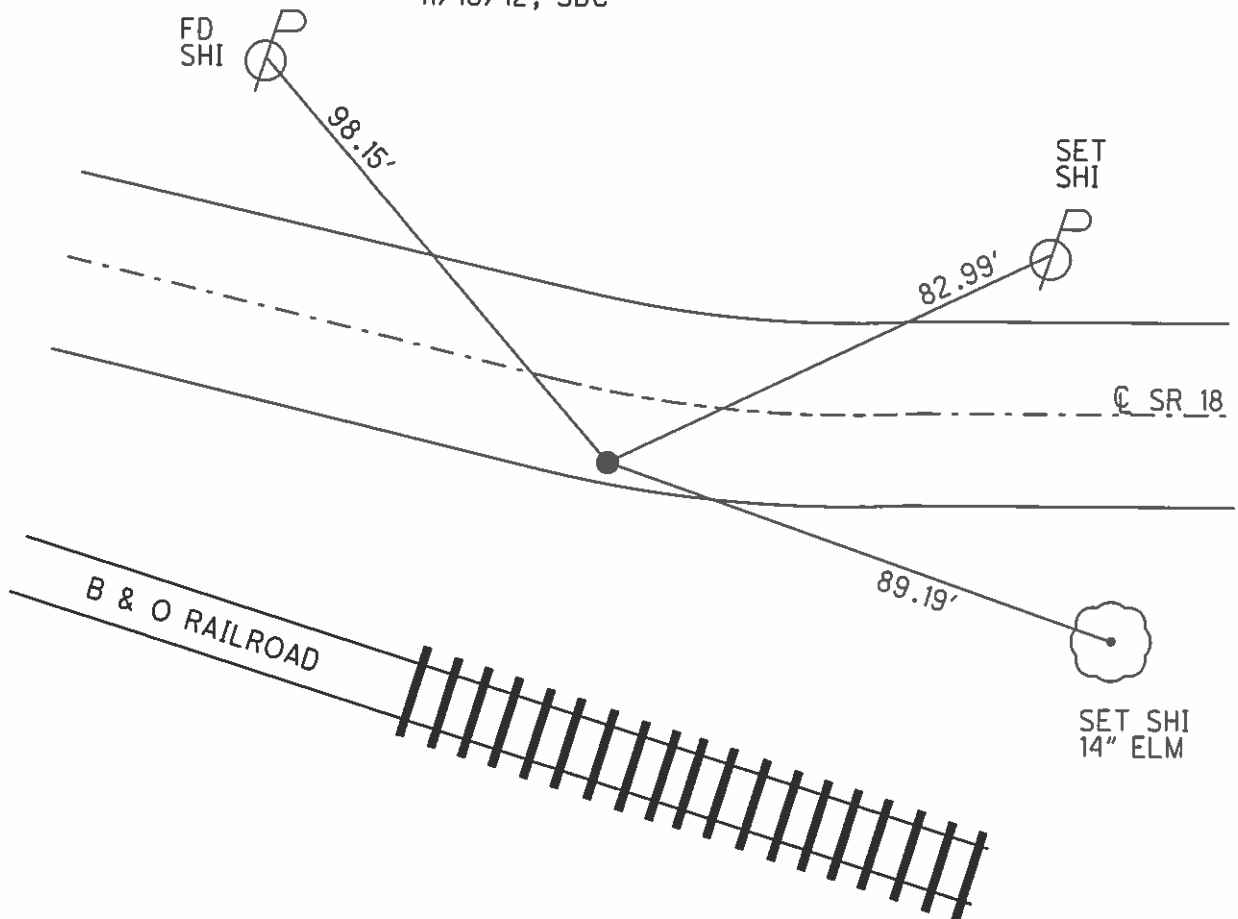

O.D.O.T. DISTRICT 2 SURVEY OFFICE

PERSONNEL

REFERENCE NO. 43-A

SHEET 13 OF 14

NOTES CANTERBURY

H.C. BARNHISEL

DATE 8-8-01

ROUTE 18

R.C. MOSEK

WEATHER Sunny

COUNTY HEWRY

DRAWN BY: MOSEK


TEMP. +80°F

TOWNSHIP BARTLOW


SECTION 24

T3 N R 8 E

TYPE MONUMENT PK? WASHER
 ON SURFACE - ~~BELOW~~ ON
~~LEFT - C/PAV'T.~~ - RIGHT 8.0' RT
3.0' TO RT. EDGE PAVEMENT
 S.L.M. 1078+15

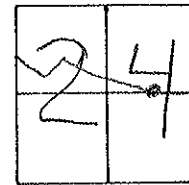

RESET PK/WASHER
 11-27-01
 MRC

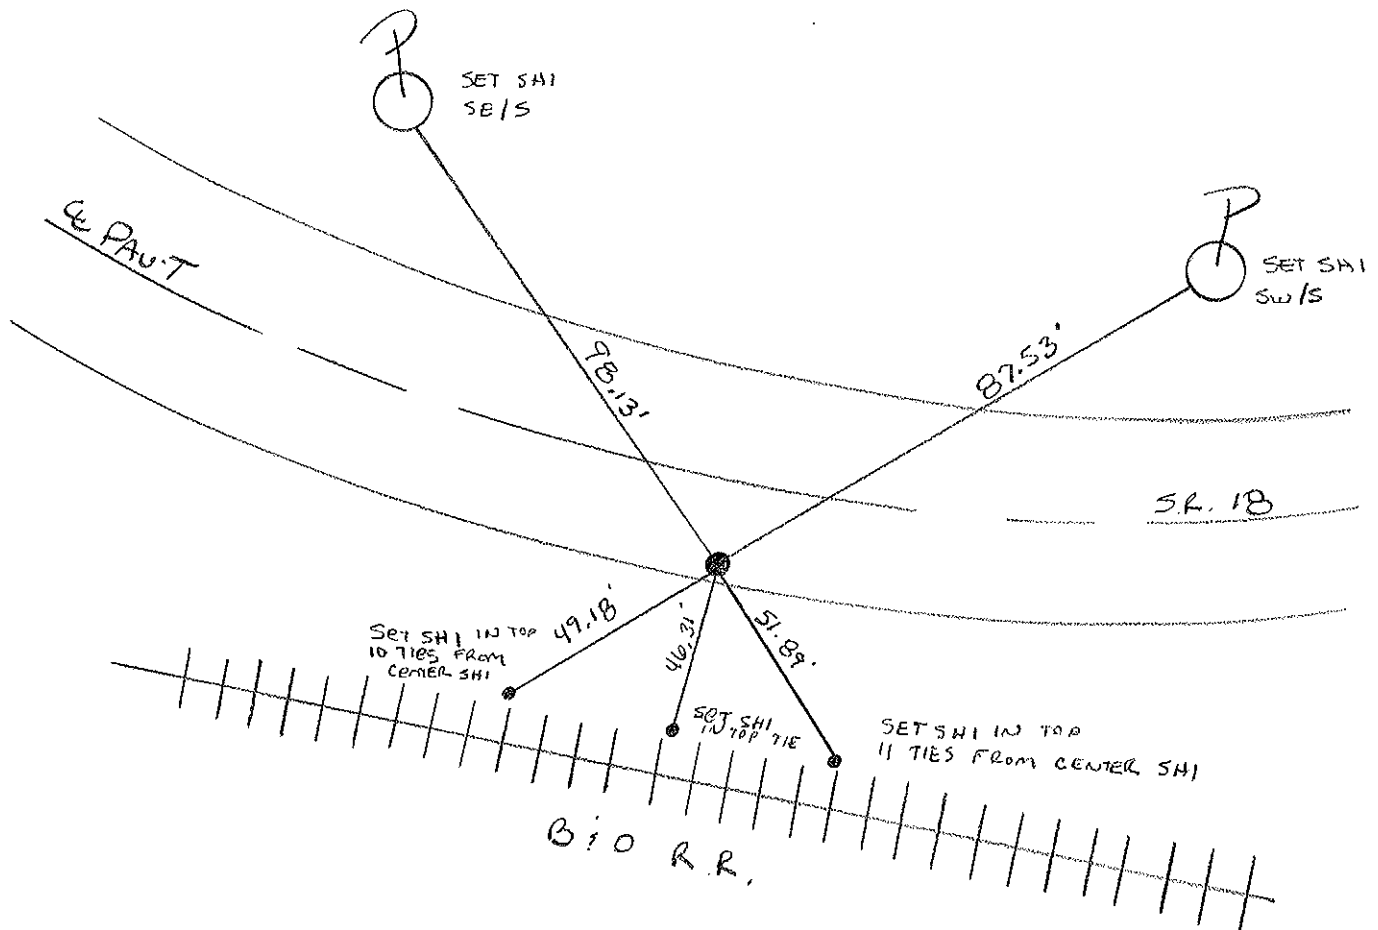

O.D.O.T. DISTRICT 2 SURVEY OFFICE

PERSONNEL _____

REFERENCE NO. 43-A

SHEET _____ OF _____

NOTES BARNHISEL

H.C. " "

DATE 10-19-90

ROUTE 18

R.C. HOFFMAN

WEATHER cloudy

COUNTY Henry

TEMP. +43°

TOWNSHIP BAETLOW

SECTION 24

T 3 N R 8 E


TYPE MONUMENT P.K. & Washer

ON SURFACE - ~~BELOW~~ yes


~~LEFT - C~~ PAV'T. - RIGHT 7.6

2.5 TO RT EDGE PAVEMENT

S.L.M. 1078.15

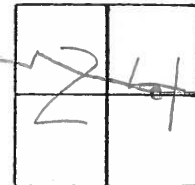

Set P.K. / Washer
 11.13.90
 MB

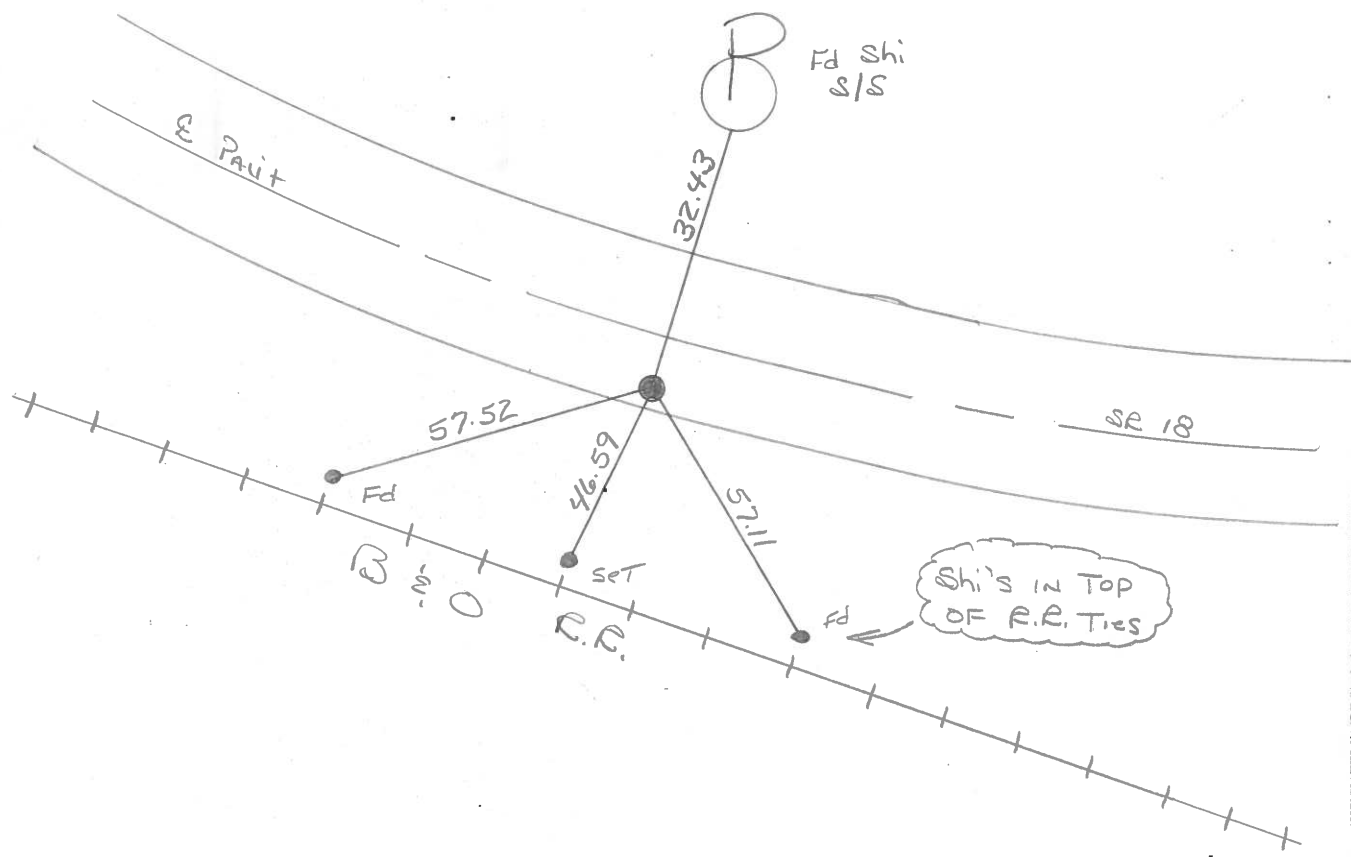

ODOT. DISTRICT 2 SURVEY OFFICE

SHEET _____ OF _____

County HENRY S.R. 18

Date April 6, 83

Township BARTLOW

Weather OVERCAST

Section 24

Temp. +50°


T3N, R8E

Personnel HOFFMAN

HOUSEHOLDER

BARNHISEL

#43-A

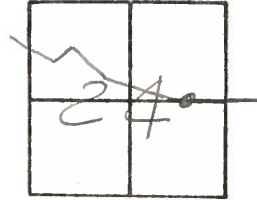

Fd SMALL R.R. SPK @ SURFACE

SLM 1078 + 15

7.8' RT of & Paot


2.3' TO S. EP.

18.8' TO N. EP.

SET P.K./WASHER

9-20-83


G.L.

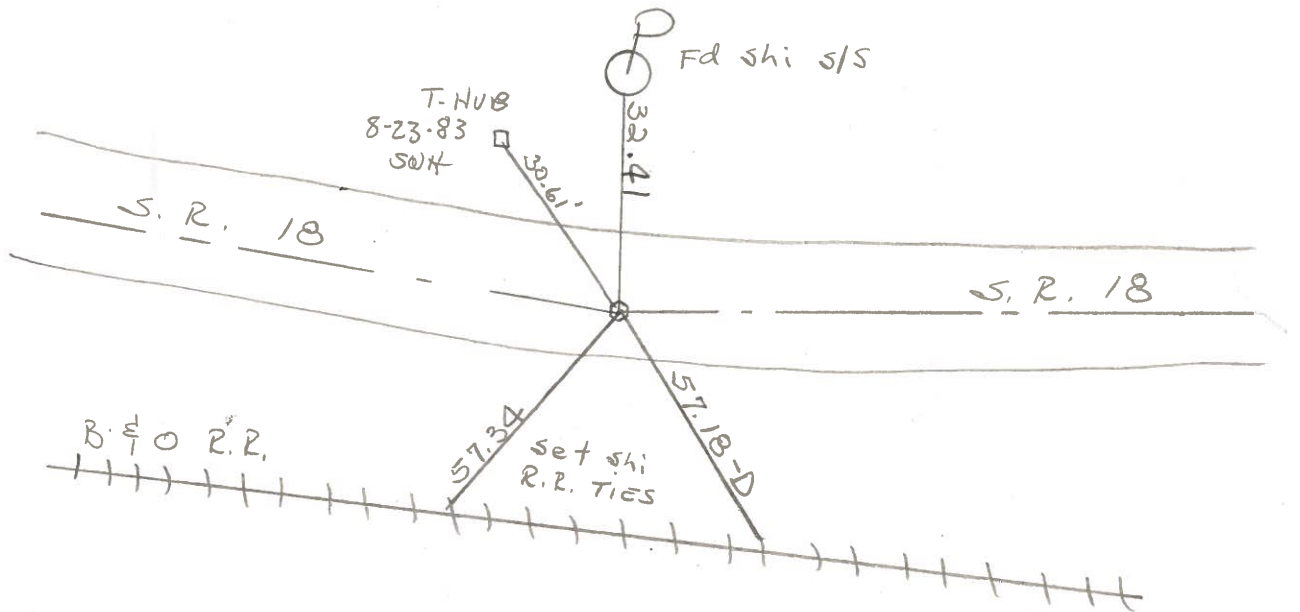

PERSONNEL	TITLE	PERSONNEL	TITLE	COUNTY	DATE
Stone				Henry	8 Oct. 77
Michaelak				S. R. #18	WEATHER Cool
Denno				SEC. Bartlow Twp.	TEMP. 51°
Curtis					

DESCRIPTION References to Control Points JOB NO. _____

LEFT CENTER LINE RIGHT

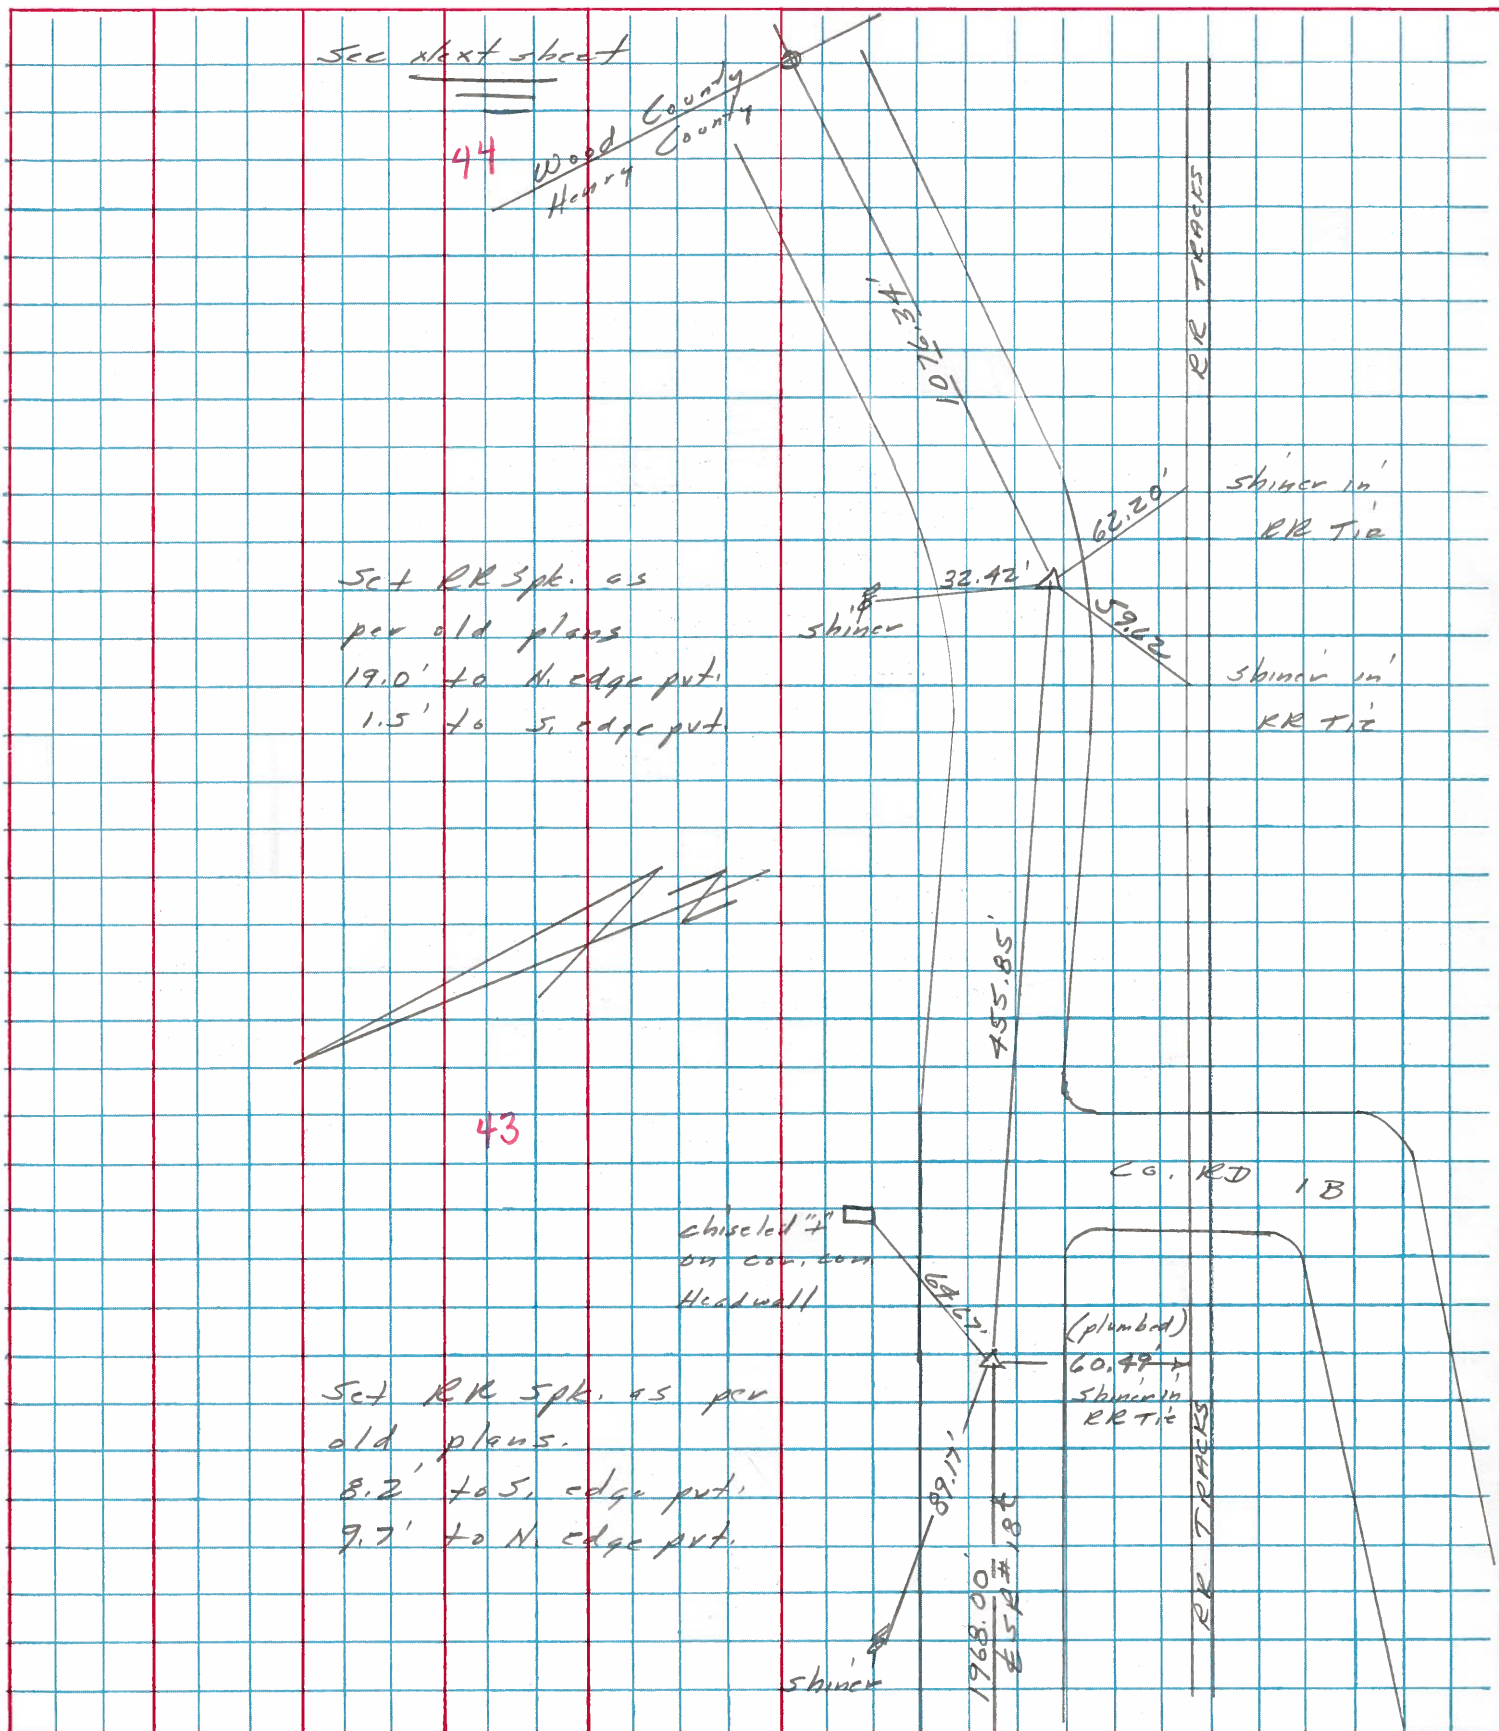

PERSONNEL	TITLE	PERSONNEL	TITLE	COUNTY	Henry	DATE	18 Sept. 74
Stone				S. R.	#18	WEATHER	Mild
Michalak				SEC.	Dashlee	TEMP.	70°
Deane							
Curtis							

DESCRIPTION _____ Alignment _____ JOB NO. 02999(0)

LEFT CENTER LINE RIGHT

