

O.D.O.T. DISTRICT 2 SURVEY OFFICE

PERSONNEL

REFERENCE NO. 44


SHEET 14 OF 14

NOTES CANTERBURY
 H.C. BARNHISEL
 R.C. MOSEK
Drawn by: MOSEK

DATE 8-8-01
 WEATHER Sunny
 TEMP. +80°F


ROUTE 18
 COUNTY HENRY-WOOD
 TOWNSHIP BARTLOW-JACKSON
 SECTION 24-19
 T 3 N R 8 E HENRY CO

TYPE MONUMENT See Below
 ON SURFACE - BELOW See Below
 LEFT- & PAV'T. - RIGHT See Below
 SEE TO BELOW EDGE PAVEMENT
 S.L.M. PT A 1098 T93 PT B 0400

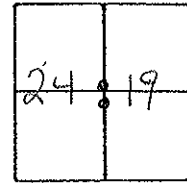

PT. A - FO. $\frac{5}{8}$ ROD 7"
 DOWN.
 20.2' RIGHT & SR 18
 9.2' RIGHT OF RIGHT E.O.P.
 19.2' W. OF & C.R.S

PT. B - FO PK/WASHER ATOP
 A 16 R.L. SPIKE.
 * MEASUREMENT ARE TO SPIKE *
 129' LT & SR 18
 2.3' LEFT OF LEFT E.O.P.
 18.9' W OF & C.R.N.

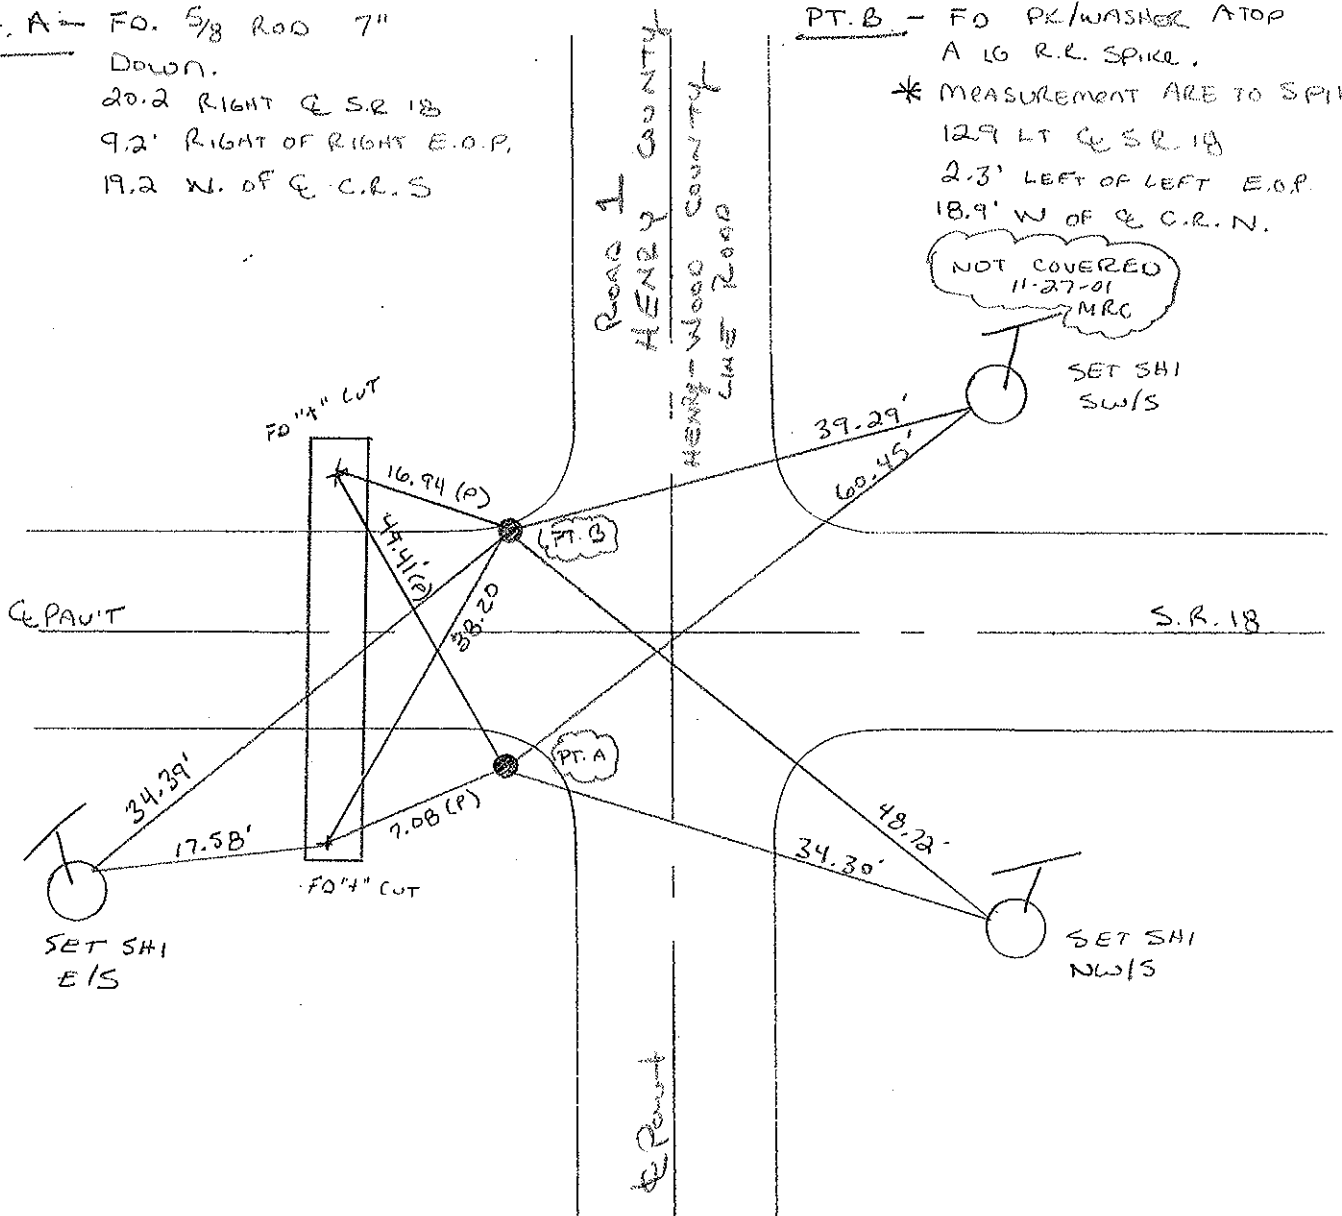

NOT COVERED
 11-27-01
 MRC

SET SH1
 SW/S

SET SH1
 E/S

SET SH1
 NW/S

O.D.O.T. DISTRICT 2 SURVEY OFFICE

PERSONNEL _____

REFERENCE NO. 44

SHEET _____ OF _____

NOTES BARNHISEL

H.C. " "

R.C. HOFFMAN

DATE 10-19-90

WEATHER cloudy

TEMP. +43°

ROUTE 18

COUNTY HENRY - WOOD

TOWNSHIP BARTLOW - JACKSON

SECTION 24 - 19

T 3 N R 8 E HENRY Co



TYPE MONUMENT PT A 5/8" Rod PT B Lg RR SPK

ON SURFACE - BELOW YES

~~LEFT~~ - E PAV'T. - ~~RIGHT~~ PTA 20.3 SOUTH PTB 13.3 NORTH

- TO - EDGE PAVEMENT 19.3 W. & Pav't 19.3 West & Pav't


S.L.M. PT A 1088+93 PT B 0+00

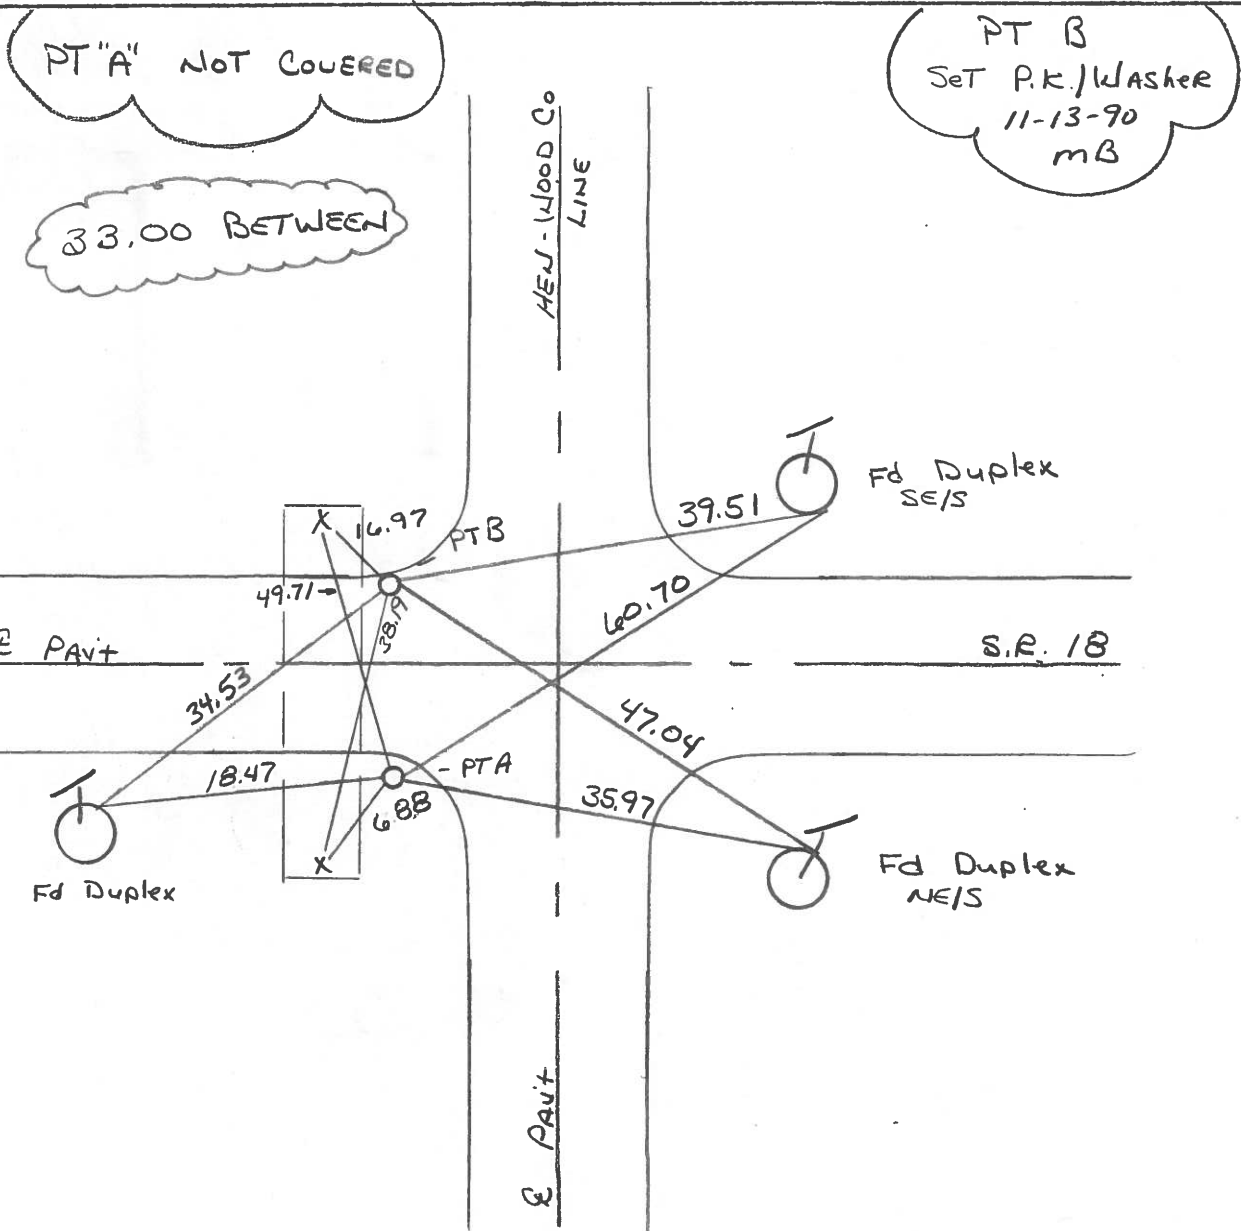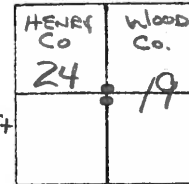

PERSONNEL	TITLE	PERSONNEL	TITLE
Stanc			
Curtis			
Michalske			
Denno			

COUNTY Henry DATE 8 Oct. 74
 S. R. #18 WEATHER Cool
 SEC. Bartlow Twp. TEMP. 52°

DESCRIPTION References to Control Points JOB NO. _____
 LEFT CENTER LINE RIGHT

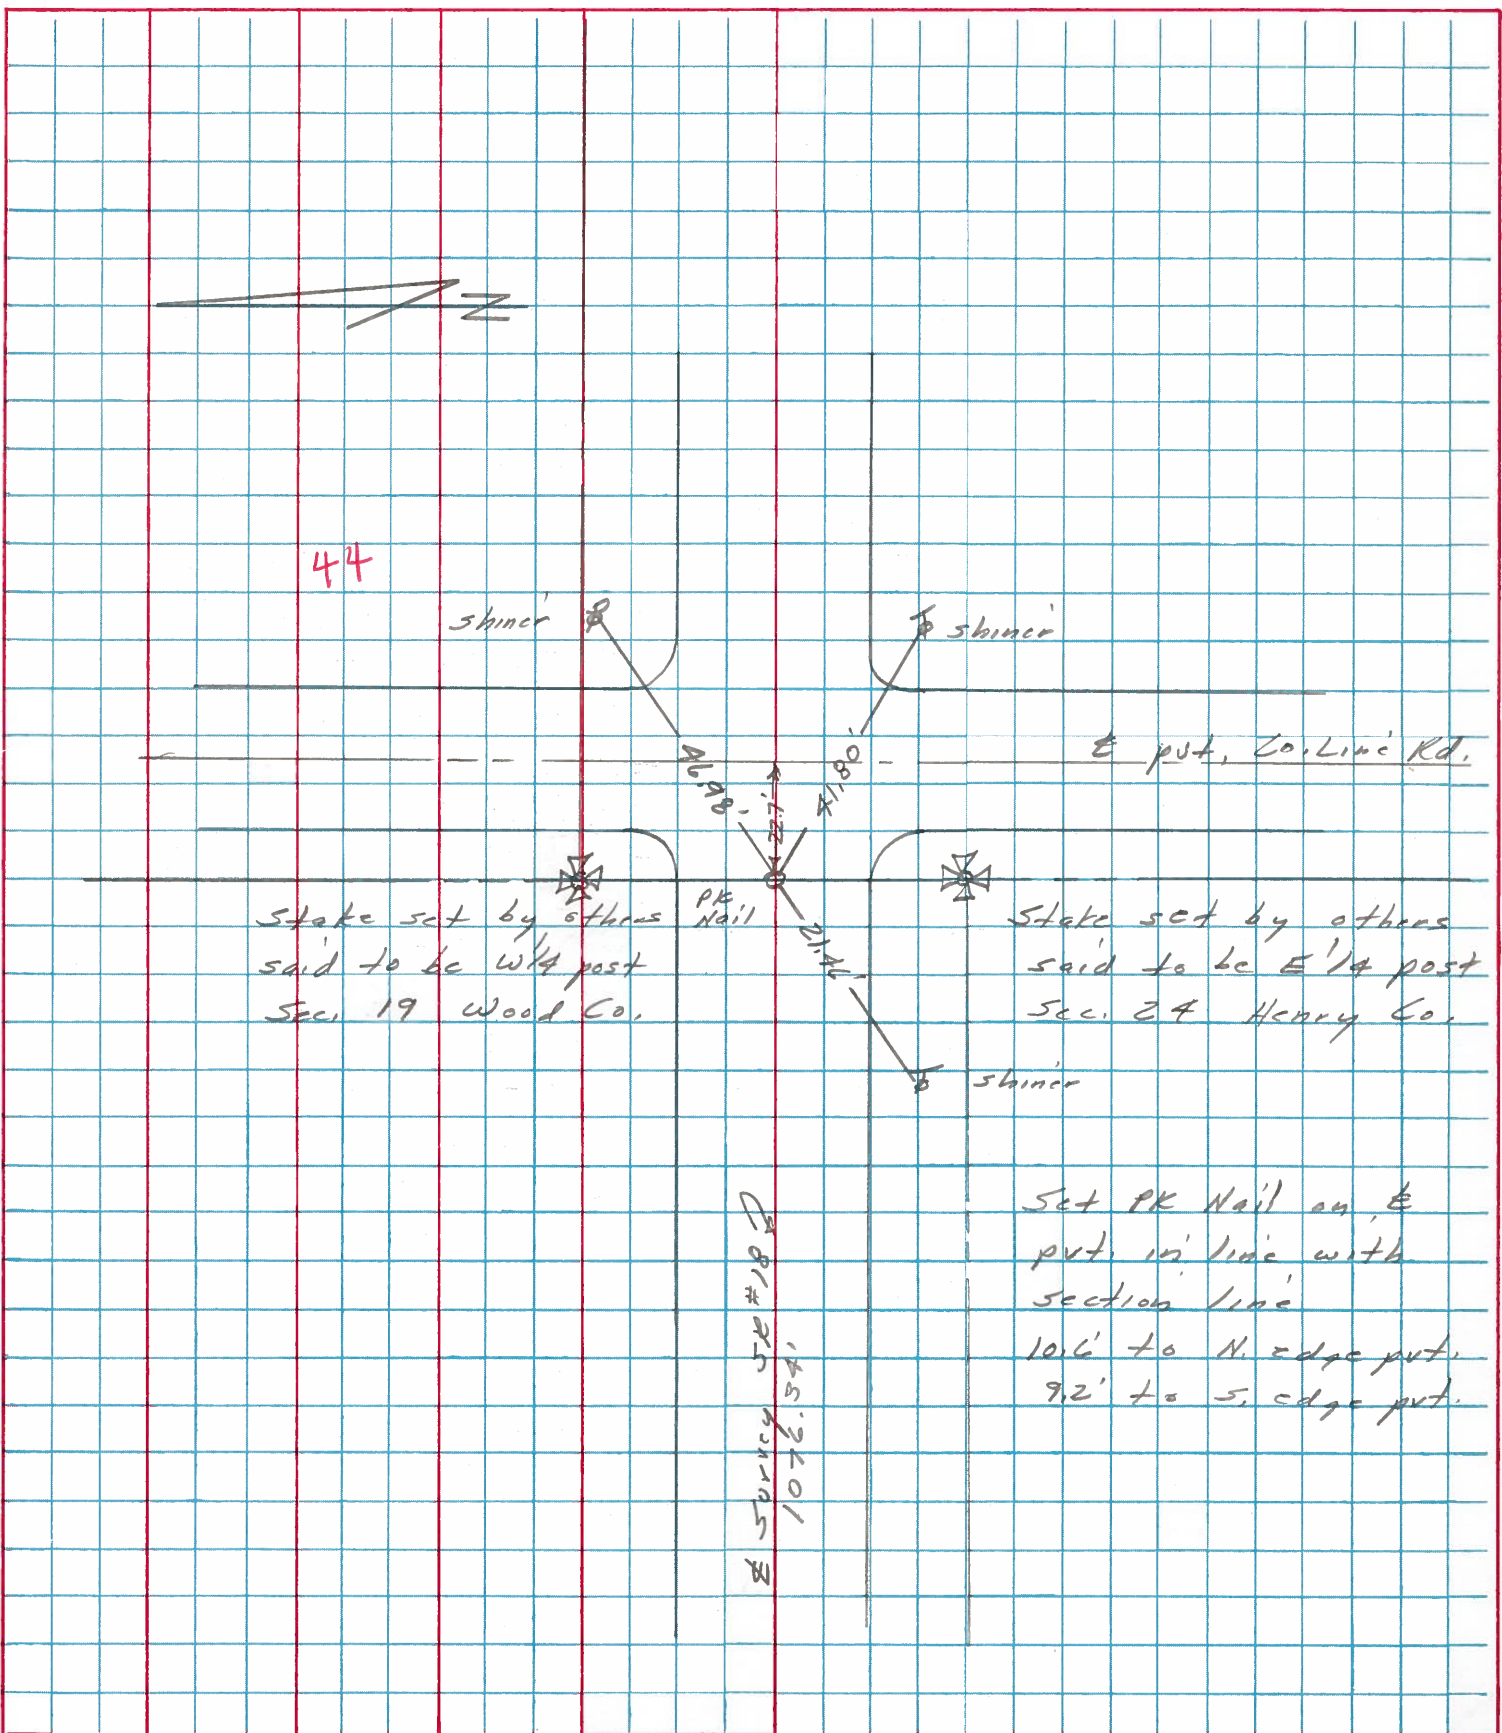

PERSONNEL	TITLE	PERSONNEL	TITLE	COUNTY	Henry	DATE	18 Sept. 74
Stone				S. R.	#18	WEATHER	Mild
Michalak				SEC.	Dashlee	TEMP.	70°
Deane							
Curtis							

DESCRIPTION _____ Alignment _____ JOB NO. 02999(0)

LEFT CENTER LINE RIGHT

