

O.D.O.T. DISTRICT 2 SURVEY OFFICE (USE ONLY)

PERSONNEL

REFERENCE NO. CR4A

SHEET 1 OF 1

NOTES RHOADES

DATE 8/17/20

ROUTE CR 4A

H.C. AUBLE

WEATHER SUNNY

COUNTY HENRY

R.C. RHOADES

TEMP. 75°

TOWNSHIP WASHINGTON

SECTION 33

DWG BY NIESE

PID 111616

T 6 N R 8 E

TYPE MONUMENT MONBOX W/ 1" IPIN

ON SURFACE - ~~BELOW~~ ON

OFFSET Q PAVEMENT ON LT : RT

TO EDGE PAVEMENT


STATION: 23+41.91

HORIZ.DATUM: NAD83(2011)


GEOID: NAVD88 2018

GRID: NORTHING: 646981.365

EASTING: 1569153.944

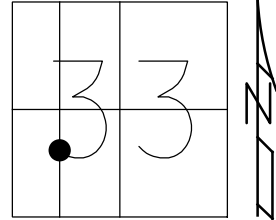

RECORD:  
 FD R.R.SPIKE  
 6/2006  
 FD MONBOX  
 W/ 1" IPIN  
 REFCR4A  
 8/17/20, DSA  
 CKREFCR4A  
 4/30/21, DSA

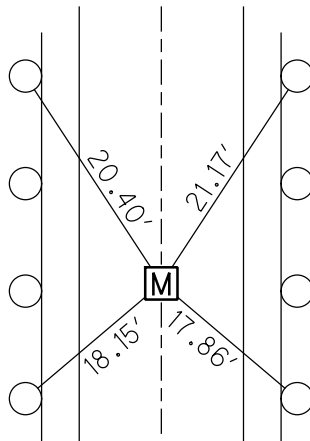

SET SHI'S  
 G.R. POSTS

BRIDGE OVER  
 US 24

Q CR 4A