


SHEET NO. _____
 COUNTY Henry DATE 9 April 81
 S. R. US # 24 WEATHER Fair
 SEC. 22.67 TEMP. 58°
 JOB NO. 026112

PERSONNEL TITLE PERSONNEL TITLE
Stone _____
Chas _____
 DESCRIPTION Bridge Information

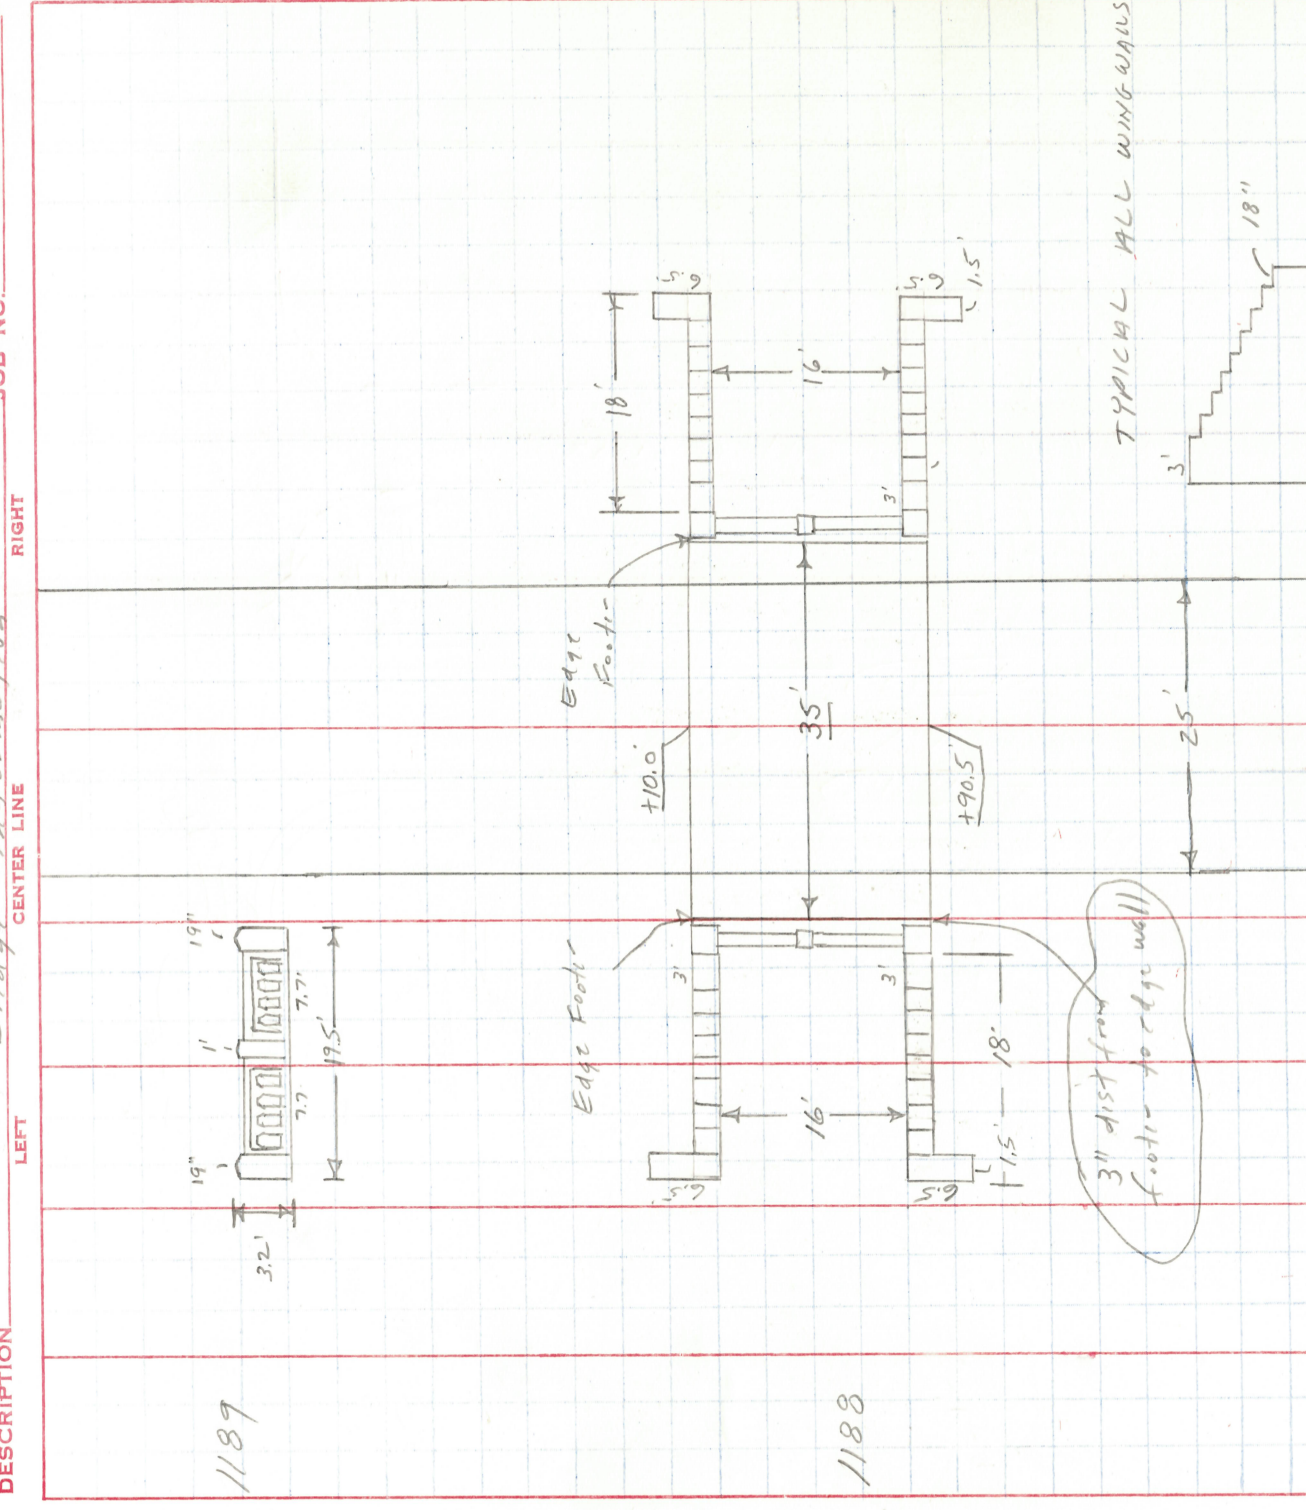

SHEET NO. _____

PERSONNEL TITLE PERSONNEL TITLE PERSONNEL TITLE
 Stone _____ County Henry DATE 9 April 81
 _____ S. R. US # 24 WEATHER Fair
 Crew _____ SEC. 22.67 TEMP. 60°

DESCRIPTION _____ CENTER LINE _____ RIGHT _____ JOB NO. 026112

DESCRIPTION	LEFT	CENTER LINE	RIGHT	JOB NO.
1187400	6.1 23	4.2 3 3.98 0 EP	4.2 3 4.8 10 8.7 22	026112
1187475	9.8 20	4.3 7 3.9 3 3.68 0 EP	3.9 3 4.5 8 6.0 16 9.6 19	
1188425	9.2 20	4.3 7 3.8 3 3.63 0 EP	4.1 3 5.2 11 10.7 16	
1189400	9.5 25	4.5 10 3.8 3 3.64 0 EP	3.9 3 4.5 8 5.0 14 6.9 20	