


O.D.O.T. DISTRICT 2 SURVEY OFFICE (USE ONLY)


PERSONNEL _____ REFERENCE NO. 3 SHEET 4 OF 29
NOTES LEU DATE 8/15/19 ROUTE US 24
H.C. _____ WEATHER _____ COUNTY HENRY
R.C. _____ TEMP. _____ TOWNSHIP NAPOLEON
DWG BY NIESE PID 95716 SECTION 30
T 5 N R 6 E

TYPE MONUMENT CMON
ON SURFACE - ~~BELOW~~ ON
OFFSET 0 PAVEMENT ON ~~RT~~ : ~~RT~~
- TO - EDGE PAVEMENT
STATION: 30+00

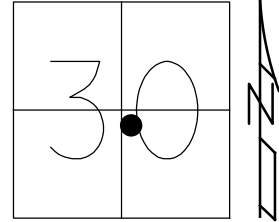

HORZ.DATUM: NAD83(2011) GEOID: 2012A
GRID: NORTHING: 621816.115 EASTING: 1496893.140

RECORD:
STA.30+66.60
FD CMON
7/23/75, TOMSIC
STA30
8/15/19, JLL

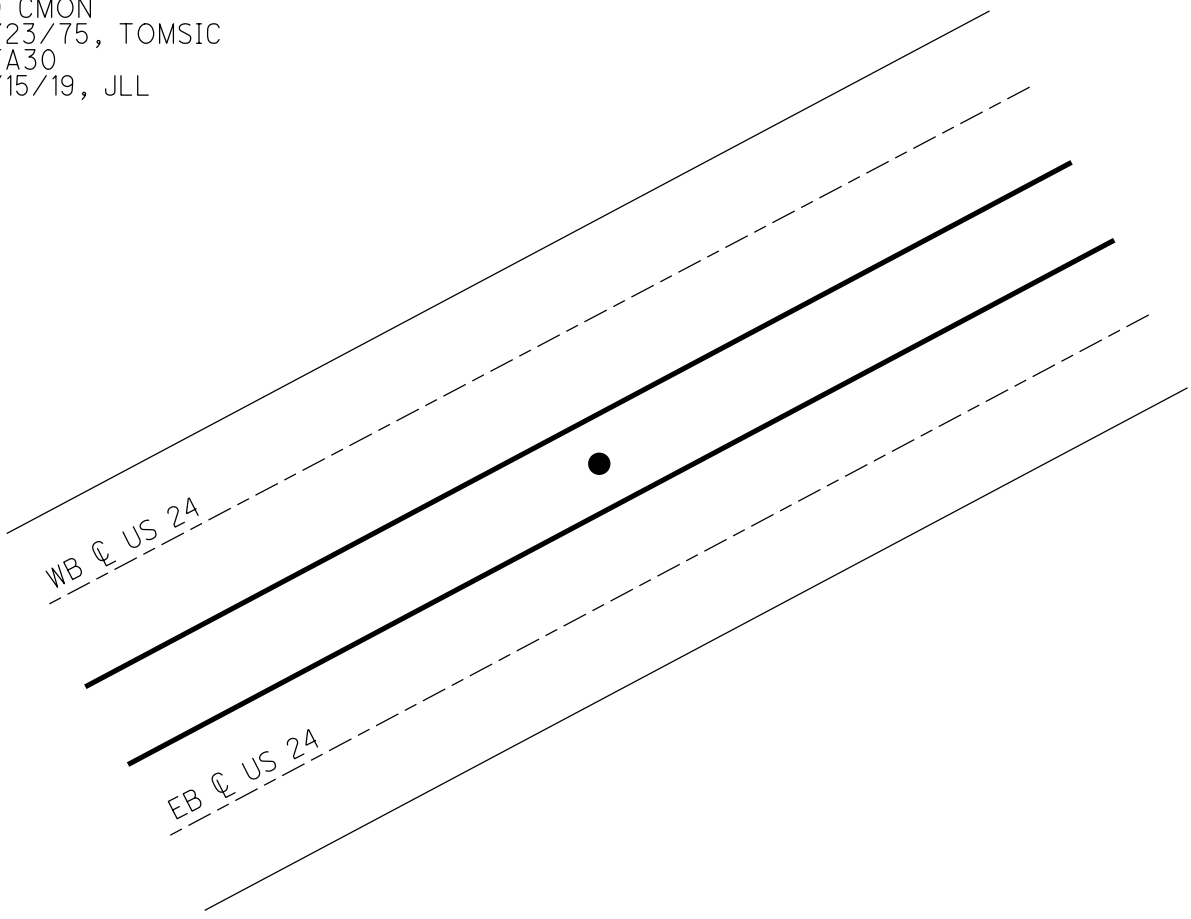

PERSONNEL	TITLE	PERSONNEL	TITLE
Tomsik			
Neuser			
Granata			

COUNTY HEN DATE JULY 23, 1975
 S. R. 24 WEATHER _____
 SEC. _____ TEMP. _____

DESCRIPTION _____ LEFT _____ CENTER LINE _____ RIGHT _____ JOB NO. _____

