

O.D.O.T. DISTRICT 2 SURVEY OFFICE (USE ONLY)

PERSONNEL

REFERENCE NO. 4

SHEET 7 OF 29

NOTES LEU

DATE 8/15/19

ROUTE US 24

H.C. \_\_\_\_\_

WEATHER \_\_\_\_\_

COUNTY HENRY

R.C. \_\_\_\_\_

TEMP. \_\_\_\_\_

TOWNSHIP NAPOLEON

DWG BY NIESE

PID 95716

SECTION 30

T 5 N R 6 E

TYPE MONUMENT \_\_\_\_\_ CMON \_\_\_\_\_

ON SURFACE - ~~BELOW~~ \_\_\_\_\_ ON \_\_\_\_\_

OFFSET ☉ PAVEMENT \_\_\_\_\_ ON \_\_\_\_\_ LT : RT

\_\_\_\_\_ TO \_\_\_\_\_ EDGE PAVEMENT


STATION: 60+00

HORIZ.DATUM: NAD83(2011)


GEOID: 2012A

GRID: NORTHING: 623288.194

EASTING: 1499506.875

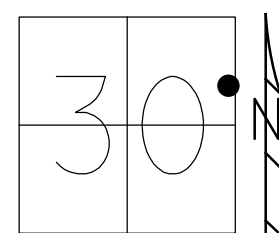

RECORD:  
STA. 61+06.61  
FD CMON  
7/24/75, TOMSIC  
STA60  
8/15/19, JLL

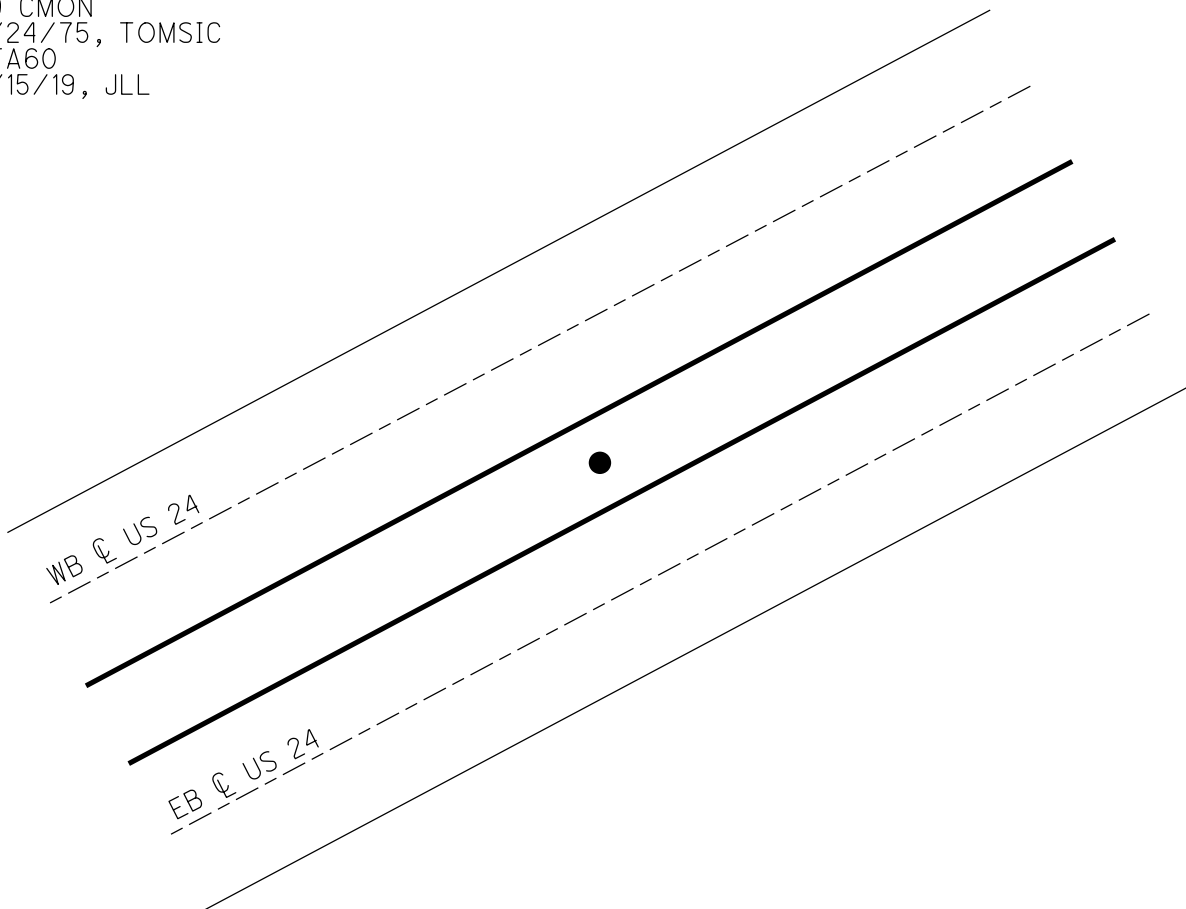

PERSONNEL	TITLE	PERSONNEL	TITLE
TOMASIC			
Wesley			
Brown			

COUNTY NEW DATE JULY 29, 1945  
 S. R. 24 WEATHER \_\_\_\_\_  
 SEC. \_\_\_\_\_ TEMP. \_\_\_\_\_

DESCRIPTION \_\_\_\_\_ LEFT \_\_\_\_\_ CENTER LINE \_\_\_\_\_ RIGHT \_\_\_\_\_ JOB NO. \_\_\_\_\_

