


PERSONNEL	TITLE	PERSONNEL	TITLE
TOMASIC			
Wesley			
Brace			

COUNTY NEW DATE JULY 29, 1945
 S. R. 24 WEATHER _____
 SEC. _____ TEMP. _____

DESCRIPTION _____ LEFT _____ CENTER LINE _____ RIGHT _____ JOB NO. _____

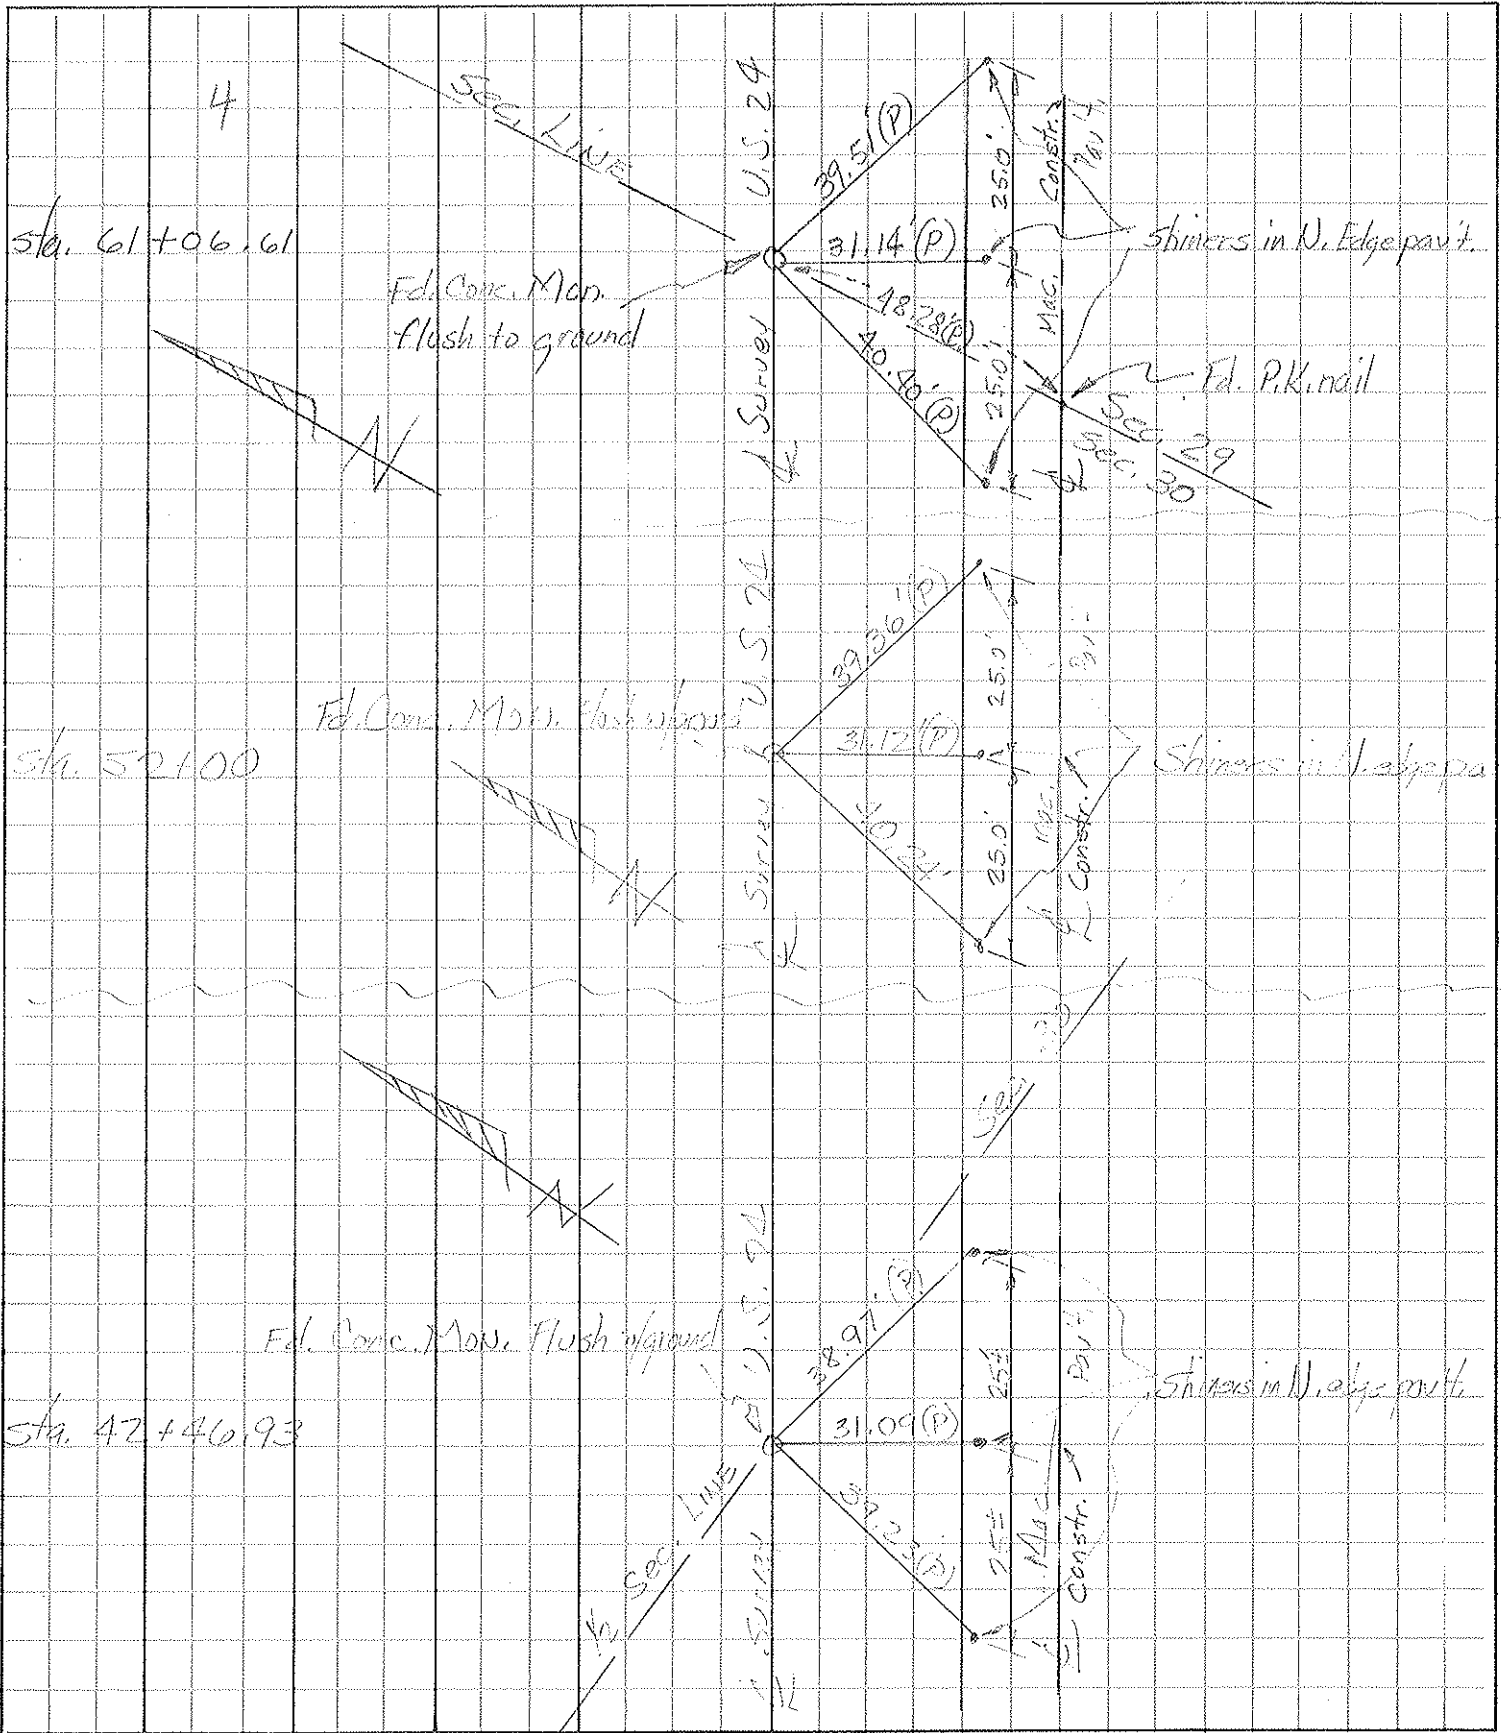

PERSONNEL	TITLE	PERSONNEL	TITLE	PERSONNEL	TITLE	PERSONNEL	TITLE
Loays							
Peschall							
Ruffer							
Wise							

COUNTY He DATE 12-14-54
 S. R. 24 WEATHER Cloudy
 SEC. Def. Co. Line to east TEMP. 36°
 DESCRIPTION Witnesses to Control Points JOB NO. _____

