

O.D.O.T. DISTRICT 2 SURVEY OFFICE (USE ONLY)

PERSONNEL

REFERENCE NO. 6

SHEET 15 OF 29

NOTES LEU

DATE 8/15/19

ROUTE US 24

H.C. _____

WEATHER _____

COUNTY HENRY

R.C. _____

TEMP. _____

TOWNSHIP NAPOLEON

DWG BY NIESE PID 95716

SECTION 20

T 5 N R 6 E

TYPE MONUMENT MONBOX

ON SURFACE - ~~BELOW~~ ON

OFFSET C PAVEMENT ON ~~LT~~ : ~~RT~~

- TO - EDGE PAVEMENT


STATION: 121+97

HORZ.DATUM: NAD83(2011)


GEOID: 2012A

GRID: NORTHING: 626329.122

EASTING: 1504906.673

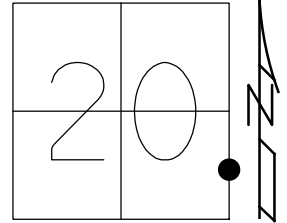

RECORD:
STA.121+67
FD MONBOX
PUNCHED HOLE
ON LID
12/3/75, TOMSIC
9/13/02, MB
FD MONBOX
MADE MARK ON LID
STA121
8/15/19, JLL

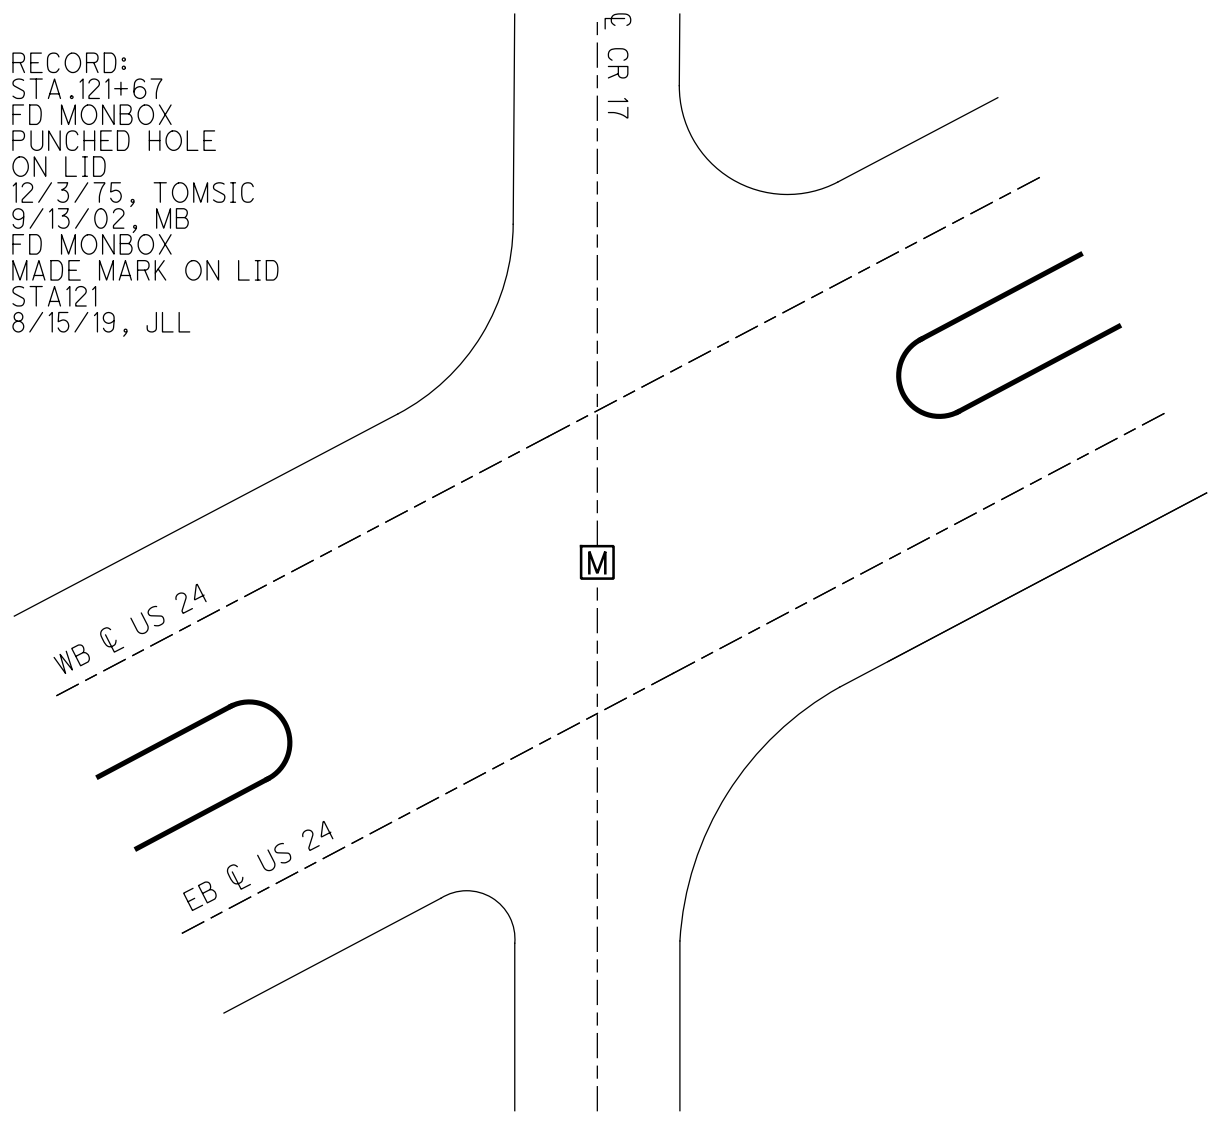

O.D.O.T. DISTRICT 2 SURVEY OFFICE

PERSONNEL _____

REFERENCE NO. 6

SHEET 3 OF 4

NOTES Barnhisel

H.C. Homan

R.C. Beaumont

DATE 9-13-02

WEATHER Sunny

TEMP. +65°

ROUTE U.S. 24

COUNTY Henry

TOWNSHIP Napolean


SECTION 20+21

T 5 N R 6 E

TYPE MONUMENT _____
 ON SURFACE - BELOW _____
 LEFT - & Pav't. - RIGHT _____
 TO RT EDGE PAVEMENT _____

"A"	"B"	"C"
J. Pin in mon box	P.K.	Bolt 3pk
surface	2" down	1" down
1' RT	on &	1' RT
10.2'	—	9.0'


S.L.M. mon. box 121+67

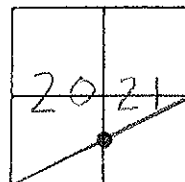

Record = mon box sta: 121+97.70
 on & survey of U.S. 24

Note: everything
 plumbed @ Box

Reset PK/washer
 11-13-02
 MB

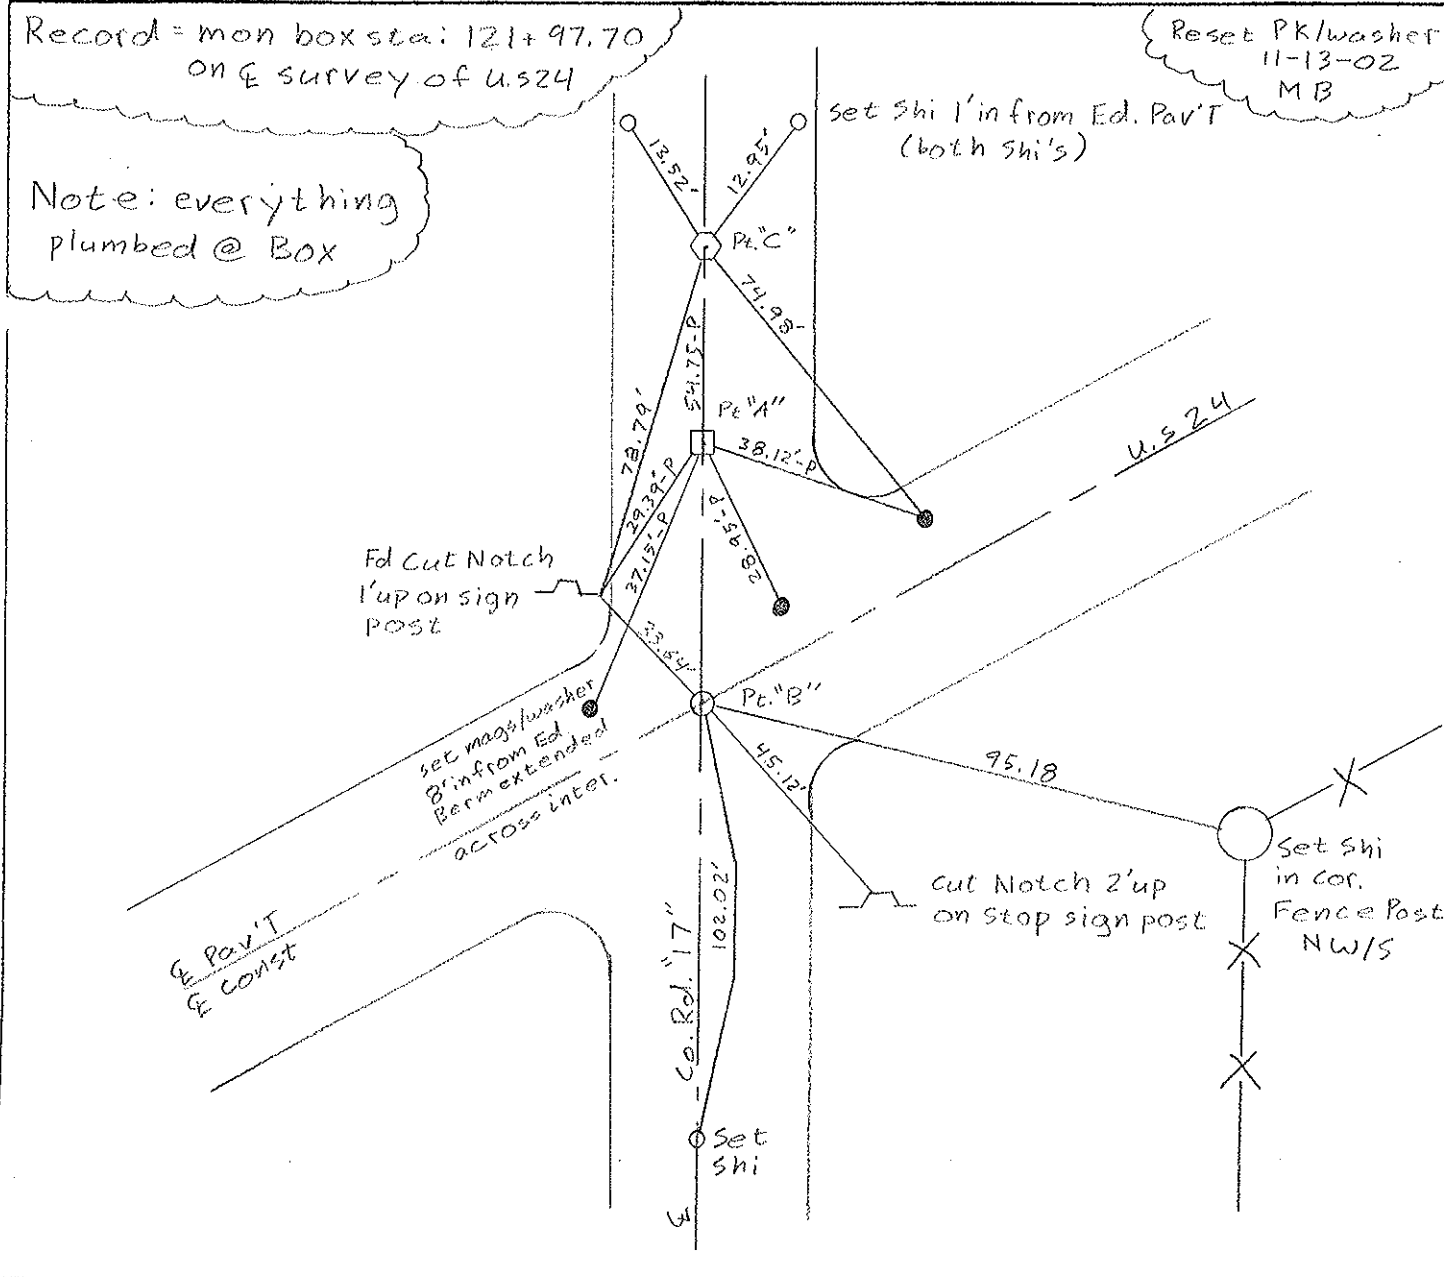

O.D.O.T. DISTRICT 2 SURVEY OFFICE

PERSONNEL

REFERENCE NO. 6

SHEET OF

NOTES BARNHISEL

H.C. VAN DUSEN

DATE 6-22-92

ROUTE U.S. 24

R.C. KUSZ

WEATHER Cloudy

COUNTY HENRY

BURNETT


TEMP. +65°

TOWNSHIP Napoleon

SECTION 20 & 21


T 5 N R 6 E

TYPE MONUMENT	"A" Lg RR SPK OVER MON. BOX	"B" P.K.	C Bolt Spk 1" down
ON SURFACE - BELOW	YES	YES	1" down
LEFT- & PAV'T. - RIGHT	1' RT	ON E	1' RT
TO RT EDGE PAVEMENT	10.2	—	9.0
S.L.M.	MON. BOX (RR SPK)	121+67	

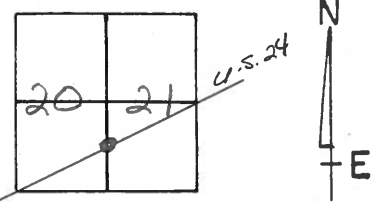

Record = MON. BOX STA. 121+97.70
ON E SURFACE OF U.S. 24

8-11-92
Set sm RR SPK
at PT. "B"
PT. "C" NOT COVERED
PT. "A" = MON. BOX
RAISED TO SURFACE

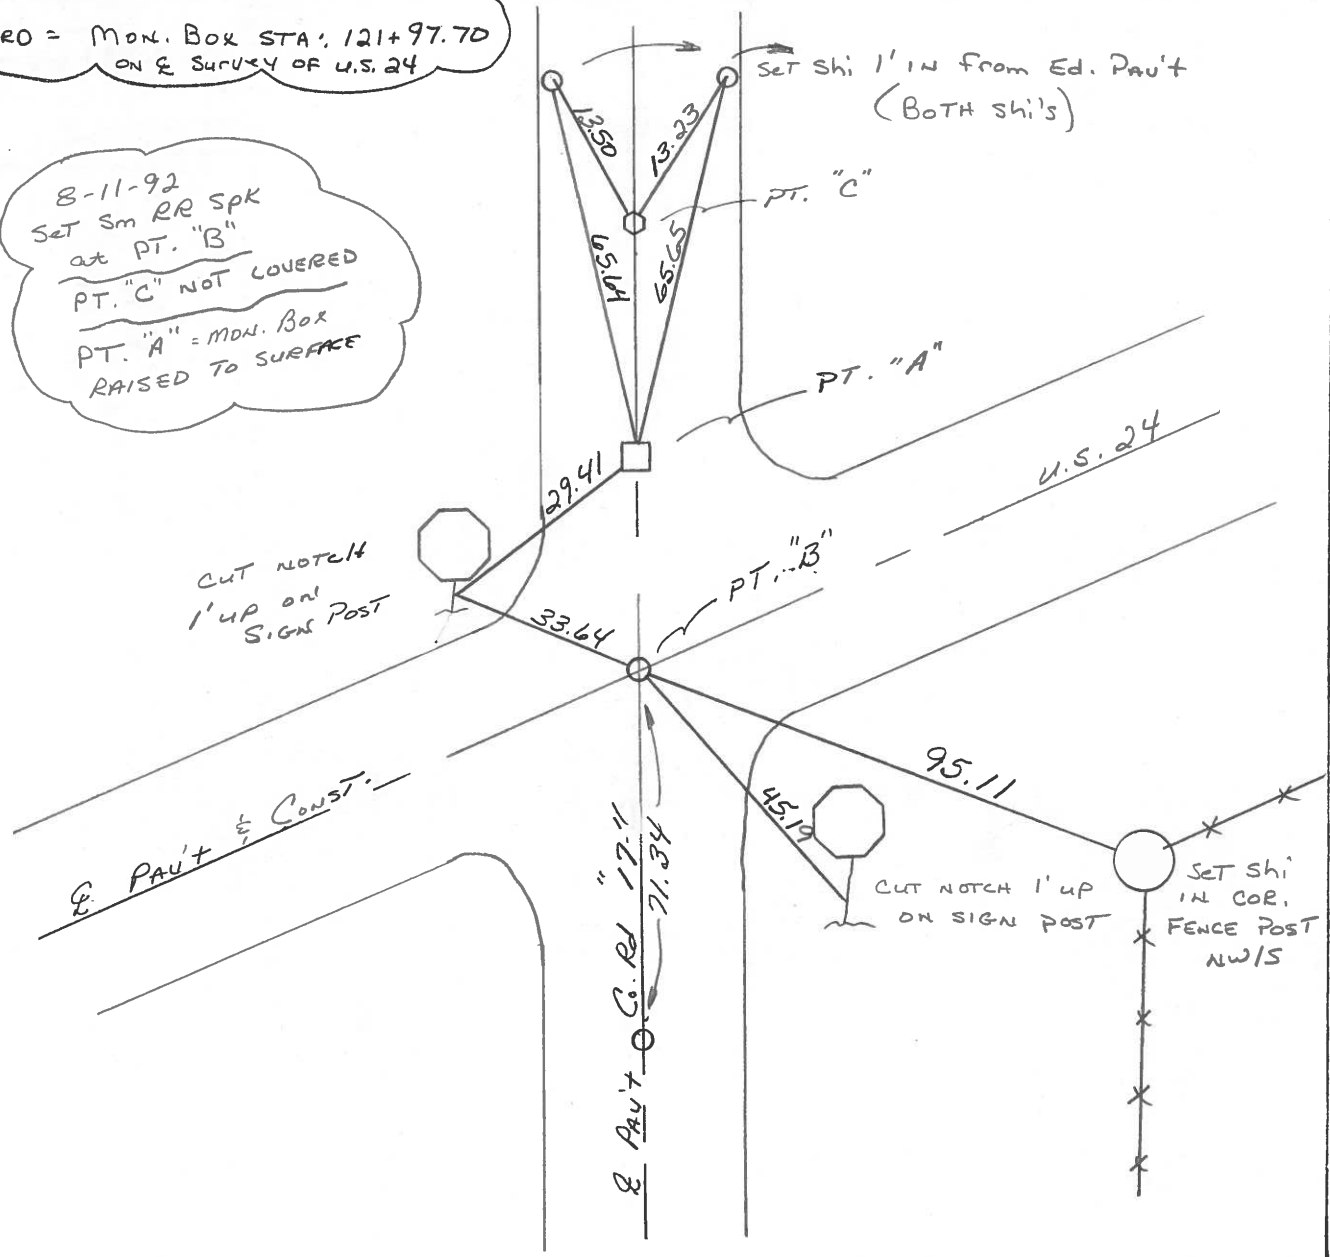

PERSONNEL	TITLE	PERSONNEL	TITLE	COUNTY	DATE
Tomsic				HEN.	DEC. 3, 1975
Neuser				U.S. 24	WEATHER Clear
Granata					TEMP. 35°
Knape					

DESCRIPTION LEFT CENTER LINE RIGHT JOB NO.

