

O.D.O.T. DISTRICT 2 SURVEY OFFICE (USE ONLY)

PERSONNEL

REFERENCE NO. 9

SHEET 24 OF 29

NOTES LEU

DATE 8/15/19

ROUTE US 24

H.C. _____

WEATHER _____

COUNTY HENRY

R.C. _____

TEMP. _____

TOWNSHIP NAPOLEON

DWG BY NIESE PID 95716

SECTION 22

T 5 N R 6 E

TYPE MONUMENT CMON

ON SURFACE - ~~BELOW~~ ON

OFFSET ☉ PAVEMENT ON ~~RT~~ : ~~RT~~

- TO - EDGE PAVEMENT


STATION: 200+94.39

HORZ. DATUM: NAD83(2011)


GEOID: 2012A

GRID: NORTHING: 630289.992

EASTING: 1511733.954

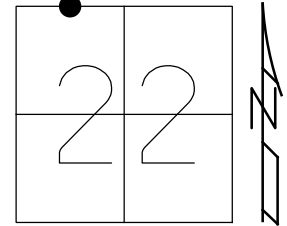

RECORD:
STA. 200+92.42
FD CMON
12/5/75, TOMSIC
FD CMON
STA 201
8/15/19, JLL

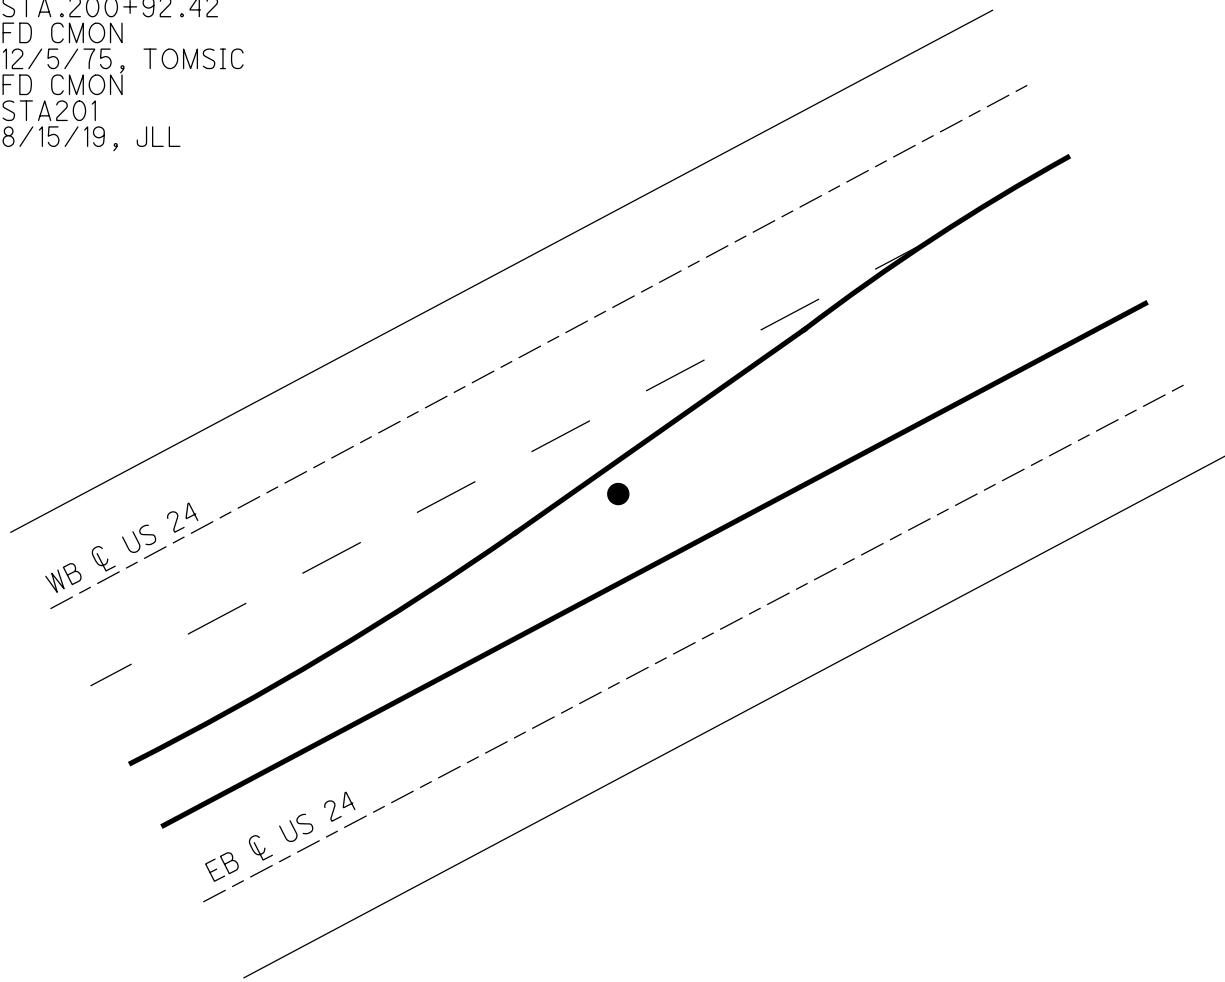

PERSONNEL	TITLE	PERSONNEL	TITLE	COUNTY	<u>HEN.</u>	DATE	<u>Dec. 5, 1975</u>
<u>Tomsic</u>				S. R.	<u>U.S. 24</u>	WEATHER	<u>Cloudy</u>
<u>Neuser</u>				SEC.		TEMP.	<u>45°</u>
<u>Granata</u>							
<u>Knape</u>							

DESCRIPTION _____ LEFT _____ CENTER LINE _____ RIGHT _____ JOB NO. _____

