

O.D.O.T. DISTRICT 2 SURVEY OFFICE (USE ONLY)

PERSONNEL

REFERENCE NO. 10

SHEET 26 OF 33

NOTES TOMSIK

DATE 12/10/75

ROUTE US 24

H.C. NEUSER

WEATHER CLEAR

COUNTY HENRY

R.C. GRANATA

TEMP. 25°

TOWNSHIP NAPOLEON

DWG BY NIESE PID _____

SECTION 15

T 5 N R 6 E

TYPE MONUMENT CMON

ON SURFACE - ~~BELOW~~ ON

OFFSET Q PAVEMENT ON LT : RT

- TO - EDGE PAVEMENT


STATION: 215+39.68

HORZ.DATUM: _____


GEOID: _____

GRID: NORTHING: _____

EASTING: _____

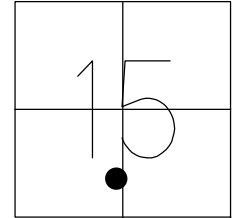

RECORD:
FD CMON
12/10/75, TOMSIK

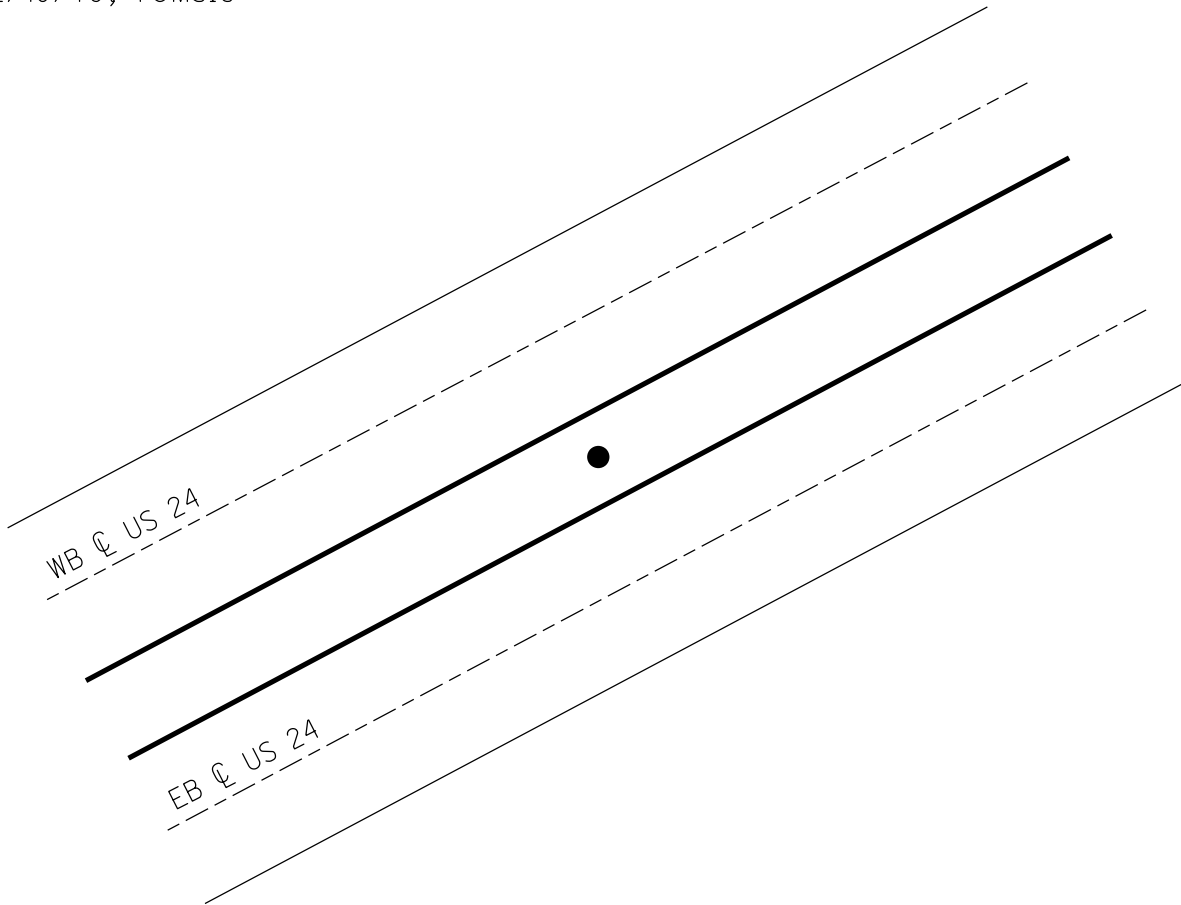

PERSONNEL	TITLE	PERSONNEL	TITLE
Tomsic			
Neuser			
Granata			

COUNTY HEN. DATE Dec. 10, 1975

S. R. U.S. 24 WEATHER clear

SEC. _____ TEMP. 25°

DESCRIPTION _____ LEFT _____ CENTER LINE _____ RIGHT _____ JOB NO. _____

