


O.D.O.T. DISTRICT 2 SURVEY OFFICE (USE ONLY)


PERSONNEL _____ REFERENCE NO. 10 B SHEET 27 OF 29
 NOTES LEU DATE 9/16/19 ROUTE US 24
 H.C. _____ WEATHER _____ COUNTY HENRY
 R.C. _____ TEMP. _____ TOWNSHIP NAPOLEON
 _____ SECTION 15
 DWG BY NIESE PID 95716 T 5 N R 6 E

TYPE MONUMENT CMON
 ON SURFACE - ~~BELOW~~ ON
 OFFSET \odot PAVEMENT ON ~~RT~~ : ~~RT~~
 TO EDGE PAVEMENT
 STATION: 224+99.22

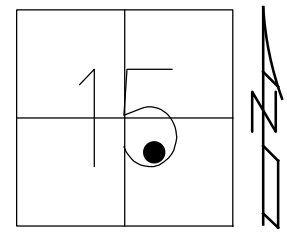

HORZ.DATUM: NAD83(2011) GEOID: 2012A
 GRID: NORTHING: 631821.823 EASTING: 1513585.051

RECORD: P.T.
 STA.225+02.46
 FD CMON
 12/10/75, TOMSIC
 STA 224+99.22
 P.I. STA 203+75.24
 $\Delta = 14^{\circ}13'35''$ LT
 DC = $0^{\circ}19'59''$
 R = 17,197.10'
 T = 2,146.05'
 L = 4,270.03'
 E = 133.39'
 STA224
 9/16/19, JLL

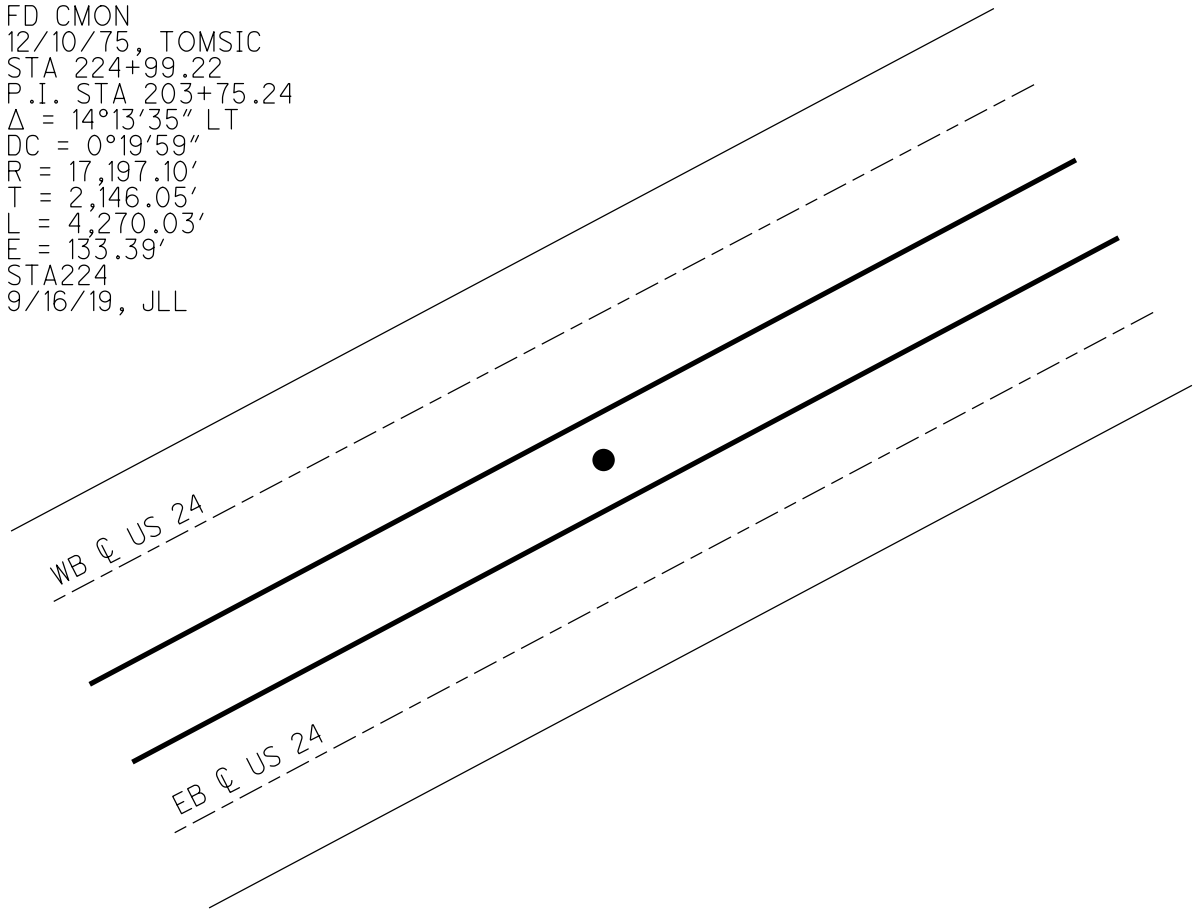

PERSONNEL	TITLE	PERSONNEL	TITLE
Tomsic			
Neuser			
Granata			

COUNTY HEN. DATE Dec. 10, 1975
 S. R. U.S. 24 WEATHER clear
 SEC. _____ TEMP. 25°

DESCRIPTION _____ LEFT _____ CENTER LINE _____ RIGHT _____ JOB NO. _____

