


O.D.O.T. DISTRICT 2 SURVEY OFFICE (USE ONLY)


PERSONNEL _____ REFERENCE NO. 11 SHEET 29 OF 29
NOTES LEU DATE 9/16/19 ROUTE US 24
H.C. _____ WEATHER _____ COUNTY HENRY
R.C. _____ TEMP. _____ TOWNSHIP NAPOLEON
DWG BY NIESE PID 95716 SECTION 15
T 5 N R 6 E

TYPE MONUMENT CMON
ON SURFACE - ~~BELOW~~ ON
OFFSET \varnothing PAVEMENT ON ~~LT~~ : ~~RT~~
- TO - EDGE PAVEMENT
STATION: 240+00

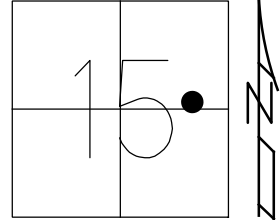

HORIZ.DATUM: NAD83(2011) GEOID: 2012A
GRID: NORTHING: 632857.016 EASTING: 1514671.575

RECORD:
STA.239+33.50
FD CMON
12/10/75, TOMSIC
FD CMON
STA240
9/16/19, JLL

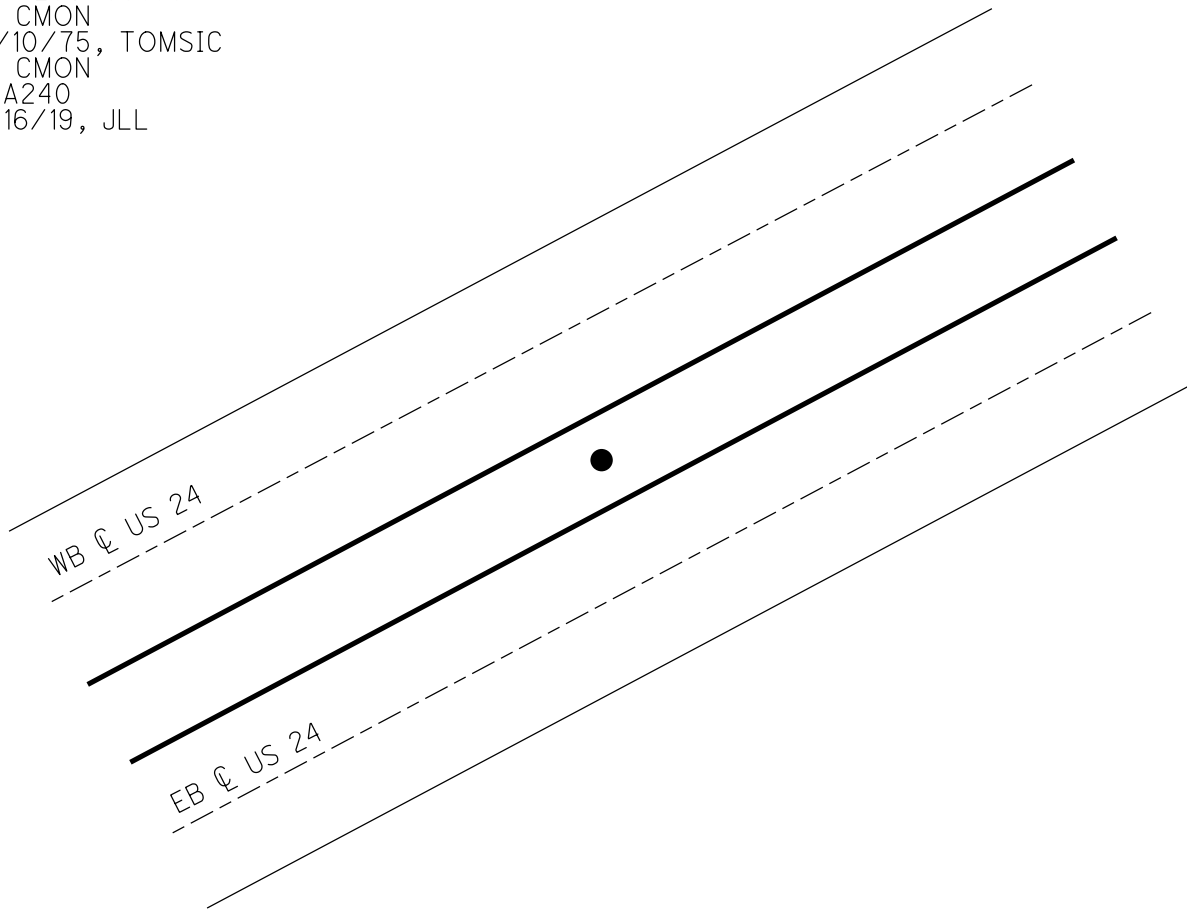

PERSONNEL	TITLE	PERSONNEL	TITLE
Tomsic			
Neuser			
Granata			

COUNTY HEN. DATE Dec. 10, 1975
 S. R. U.S. 24 WEATHER clear
 SEC. _____ TEMP. 25°

DESCRIPTION _____ LEFT _____ CENTER LINE _____ RIGHT _____ JOB NO. _____

