

O.D.O.T. DISTRICT 2 SURVEY OFFICE (USE ONLY)

PERSONNEL

REFERENCE NO. 13

SHEET 33 OF 33

NOTES TOMSIK

DATE 12/10/75

ROUTE US 24

H.C. NEUSER

WEATHER CLEAR

COUNTY HENRY

R.C. GRANATA

TEMP. 38°

TOWNSHIP NAPOLEON

DWG BY NIESE PID _____

SECTION 14

T 5 N R 6 E

TYPE MONUMENT CMON

ON SURFACE - ~~BELOW~~ ON

OFFSET Q PAVEMENT ON LT : RT

- TO - EDGE PAVEMENT


STATION: 263+52.50

HORZ.DATUM: _____

GEOID: _____


GRID: NORTHING: _____

EASTING: _____

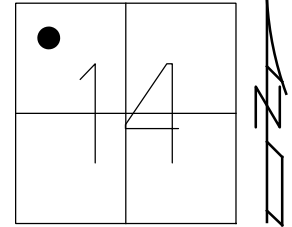

RECORD:
FD CMON
BETWEEN 4TH
AND 5TH PIERS
12/10/75, TOMSIK

NOTE:
US 6 STA 594+28.65

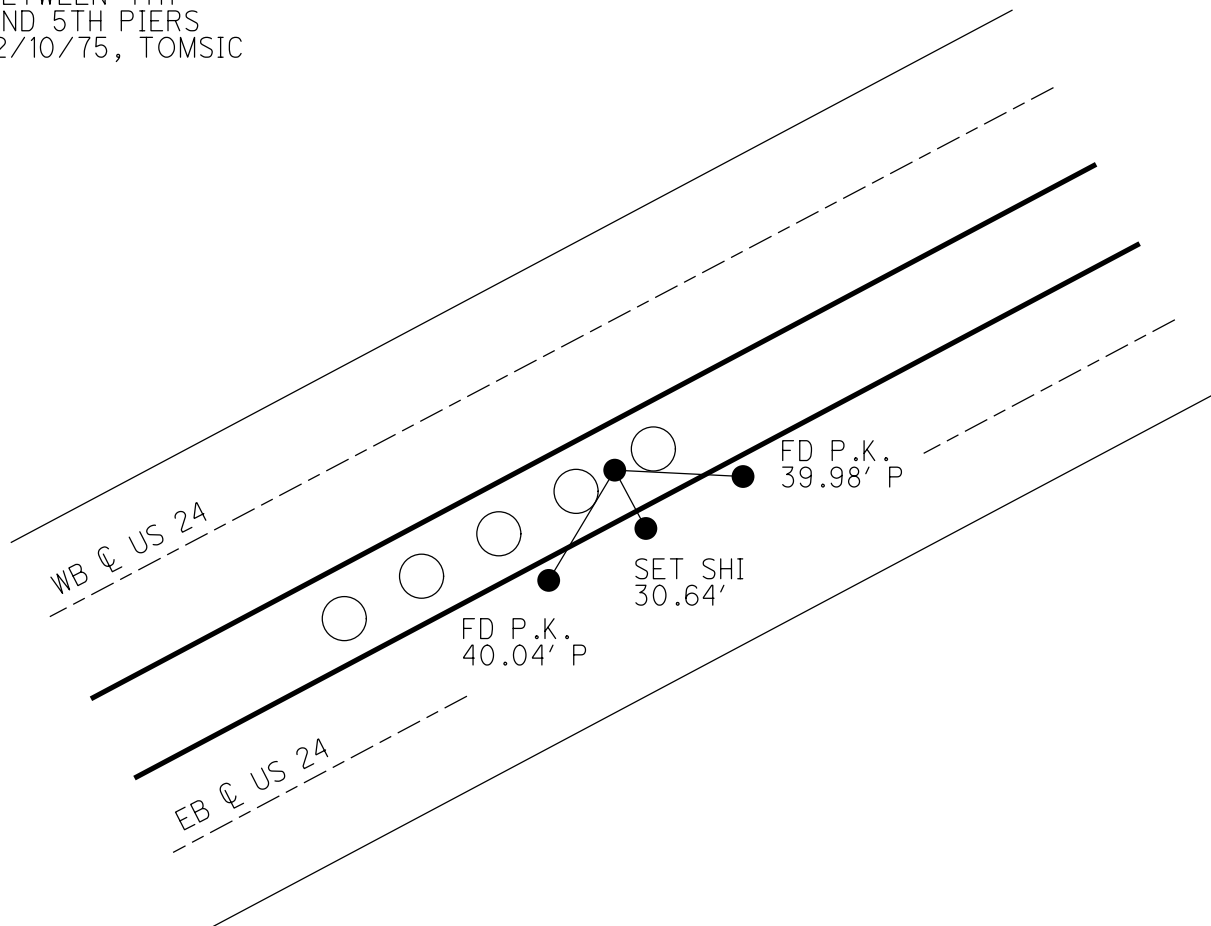

PERSONNEL	TITLE	PERSONNEL	TITLE
Tomsic			
Neuser			
Granata			

COUNTY HEN. DATE Dec. 10, 1975

S. R. U.S. 24 WEATHER P. Cloudy

SEC. _____ TEMP. 38°

DESCRIPTION _____ LEFT _____ CENTER LINE _____ RIGHT _____ JOB NO. _____

