

O.D.O.T. DISTRICT 2 SURVEY OFFICE (USE ONLY)

PERSONNEL _____

REFERENCE NO. 15

SHEET 4 OF 47

NOTES SIMON

DATE 4/23/93

ROUTE US 24

H.C. LOEHRKE

WEATHER SUNNY

COUNTY HENRY

R.C. CORDES

TEMP. 65°

TOWNSHIP LIBERTY

SECTION 2

DWG BY NIESE PID _____

T 5 N R 7 E

TYPE MONUMENT SM.R.R.SPIKE

ON SURFACE - ~~BELOW~~ ON


OFFSET ☉ PAVEMENT ON LT : RT

11.8' TO LT EDGE PAVEMENT


STATION: 623+03

HORZ.DATUM: _____ GEOID: _____

GRID: NORTHING: _____ EASTING: _____

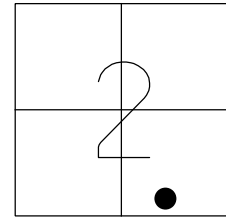

RECORD: P.T.
 STA 829+79.76
 FD SM.R.R.SPIKE
 4/23/93, CL
 SET P.K./WASHER
 7/8/93, CL

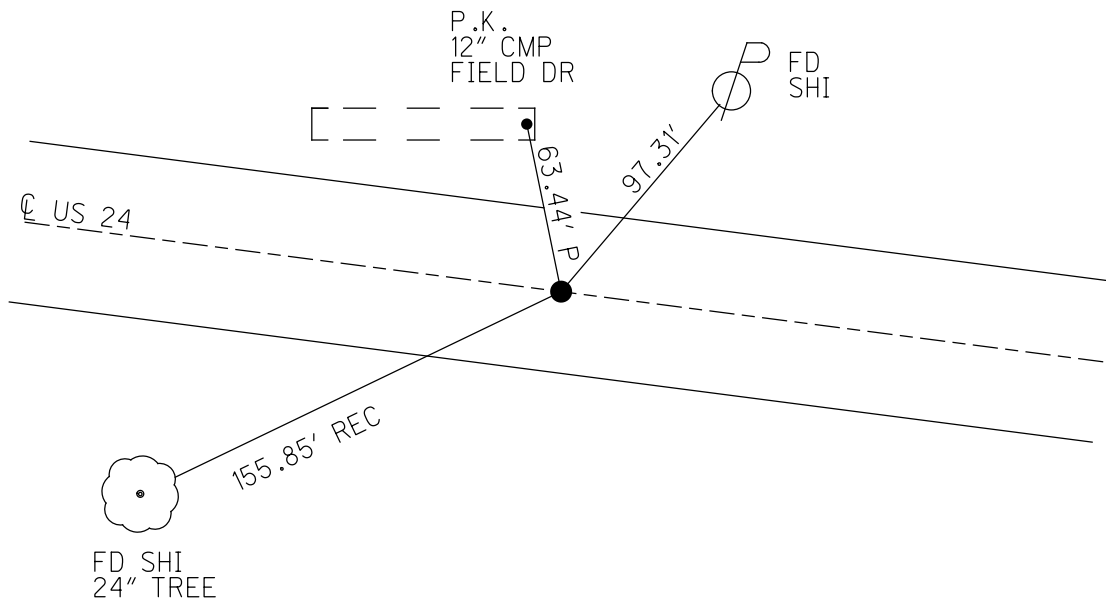

O.D.O.T. DISTRICT 2 SURVEY OFFICE

PERSONNEL _____

REFERENCE NO. 15

SHEET 3 OF 40

NOTES Simon

H.C. Lochert

R.C. Corpus

DATE 4-23-93

WEATHER Sunny

TEMP. 65°

ROUTE U.S. 24

COUNTY Henry

TOWNSHIP Liberty

SECTION 2

T. 5 N. R. 7 E.


TYPE MONUMENT Small R.R. Spike

ON SURFACE ~~BELOW~~ yes

~~LEFT - & PAV'T. - RIGHT~~ yes


11.8 TO Left EDGE PAVEMENT

S.L.M. 623703 11.80

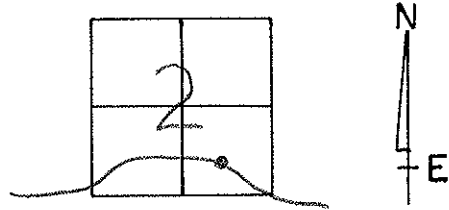

RESET PK 4 WASHER
 7-8-93
 C.L.

Res.

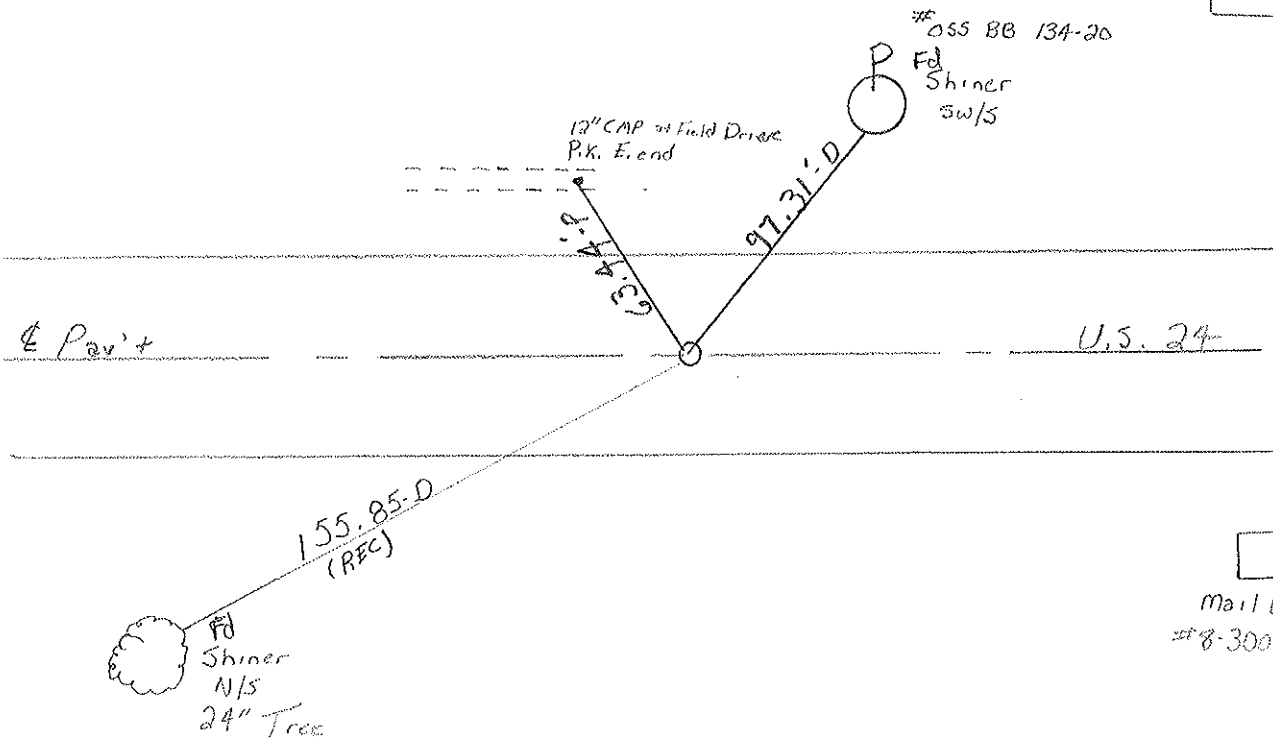

P.T. Sta. 829 + 79.76 Rec.

County HENRY S.R.-U.S. 24

Township LIBERTY

Section 2

T5N, R7E

Personnel HOFFMAN

Loehrke


Householder

(15)

Date 6-1-81


Weather CLEAR

Temp. +80°

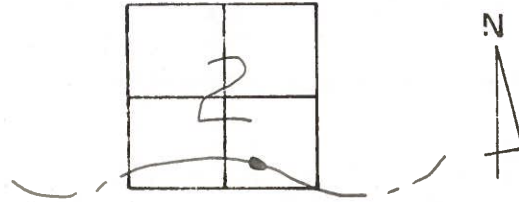

Fd. P.K. 2" BELOW SURFACE-PROJECT STA. ± 819 + 94.4
 @ CTR. of PAVT.
 SET SMALL R.R. SPK. 9-2-81
 SwH


RES

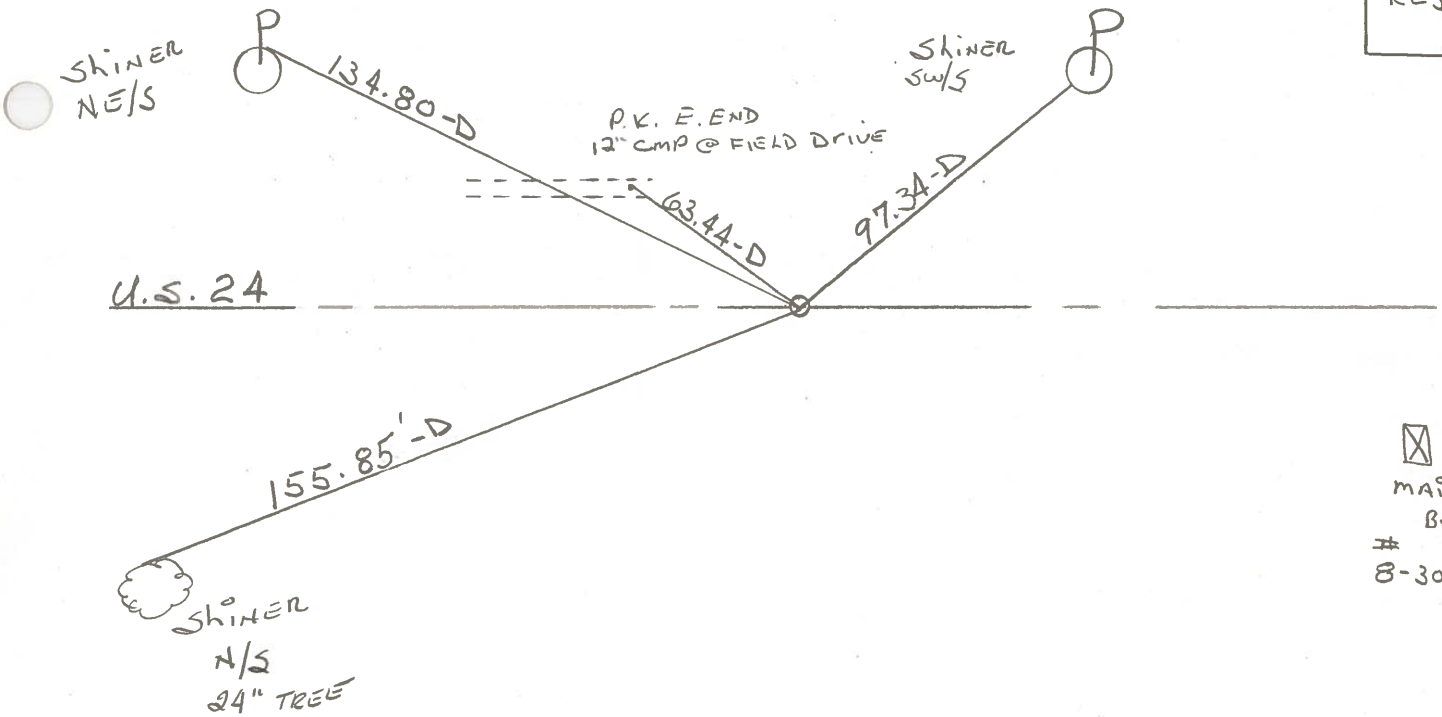

P.T. STA. 829 + 79.76 REC.

PERSONNEL	TITLE	PERSONNEL	TITLE	COUNTY	DATE
Tomsic				HEN.	JUNE 18, 1975
Neuser				S. R. 24	WEATHER
Granata				SEC. LIBERTY TWP.	TEMP.

DESCRIPTION WEST OF S.R. 109 LEFT CENTER LINE RIGHT JOB NO.

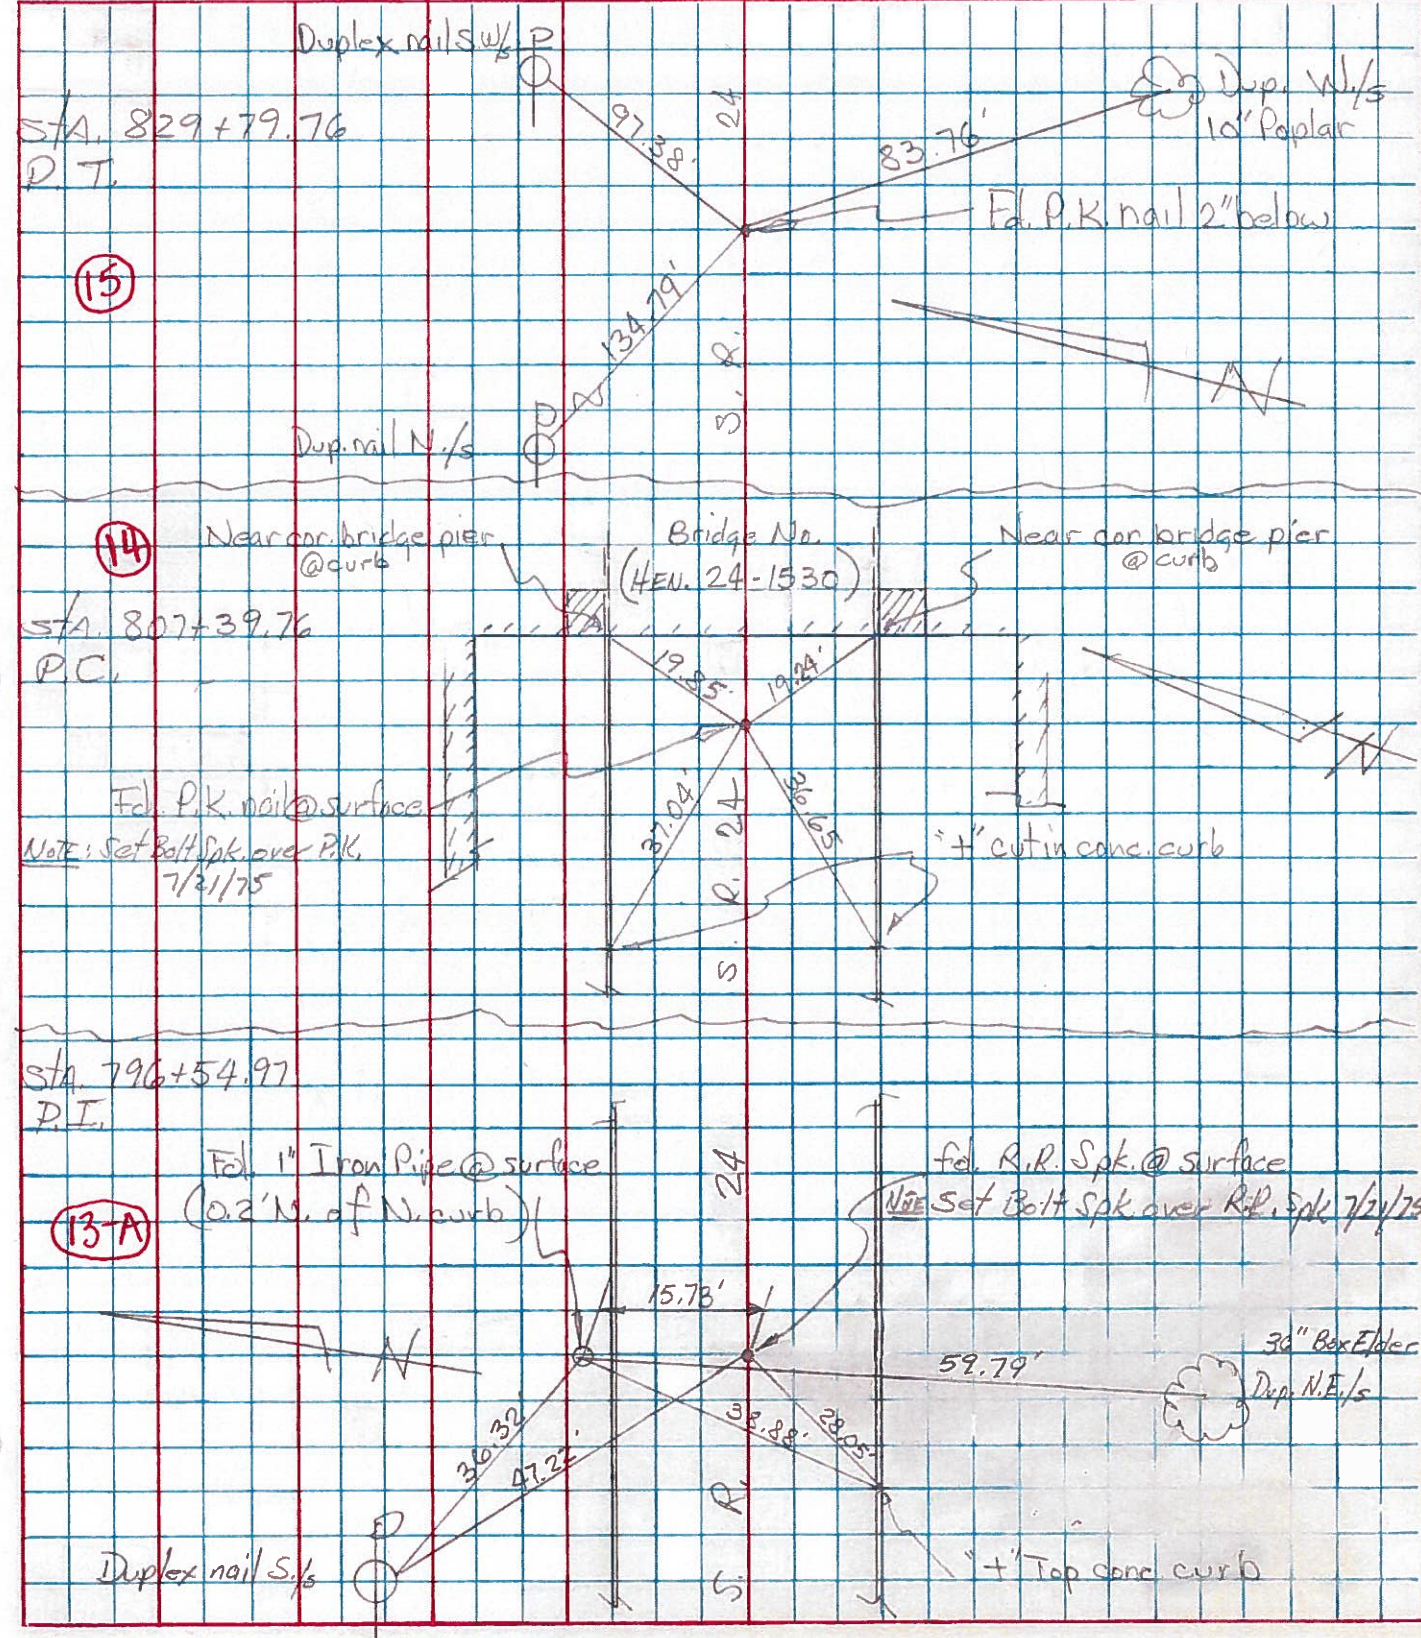

PERSONNEL	TITLE	PERSONNEL	TITLE	COUNTY	DATE
Beach				Henry	Apr. 59
Rutter				US-24	
Knape				11.22	
Delventhal					

DESCRIPTION Const. LEFT CENTER LINE RIGHT JOB NO. _____

