

O.D.O.T. DISTRICT 2 SURVEY OFFICE (USE ONLY)

PERSONNEL _____

REFERENCE NO. 16

SHEET 5 OF 47

NOTES SIMON

DATE 4/23/93

ROUTE US 24

H.C. LOEHRKE

WEATHER SUNNY

COUNTY HENRY

R.C. CORDES

TEMP. 66°

TOWNSHIP LIBERTY

DWG BY NIESE PID _____

SECTION 2

T 5 N R 7 E

TYPE MONUMENT SM.R.R.SPIKE

ON SURFACE - ~~BELOW~~ ON


OFFSET CL PAVEMENT 0.3' ~~LT~~ : RT

11.9' TO RT EDGE PAVEMENT


STATION: 627+75

HORIZ.DATUM: _____ GEOID: _____

GRID: NORTHING: _____ EASTING: _____

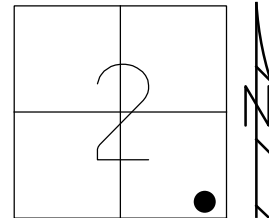

RECORD: P.C.
 STA 834+51.96
 FD SM.R.R.SPIKE
 4/23/93, CL
 SET P.K./WASHER
 7/13/93, CL

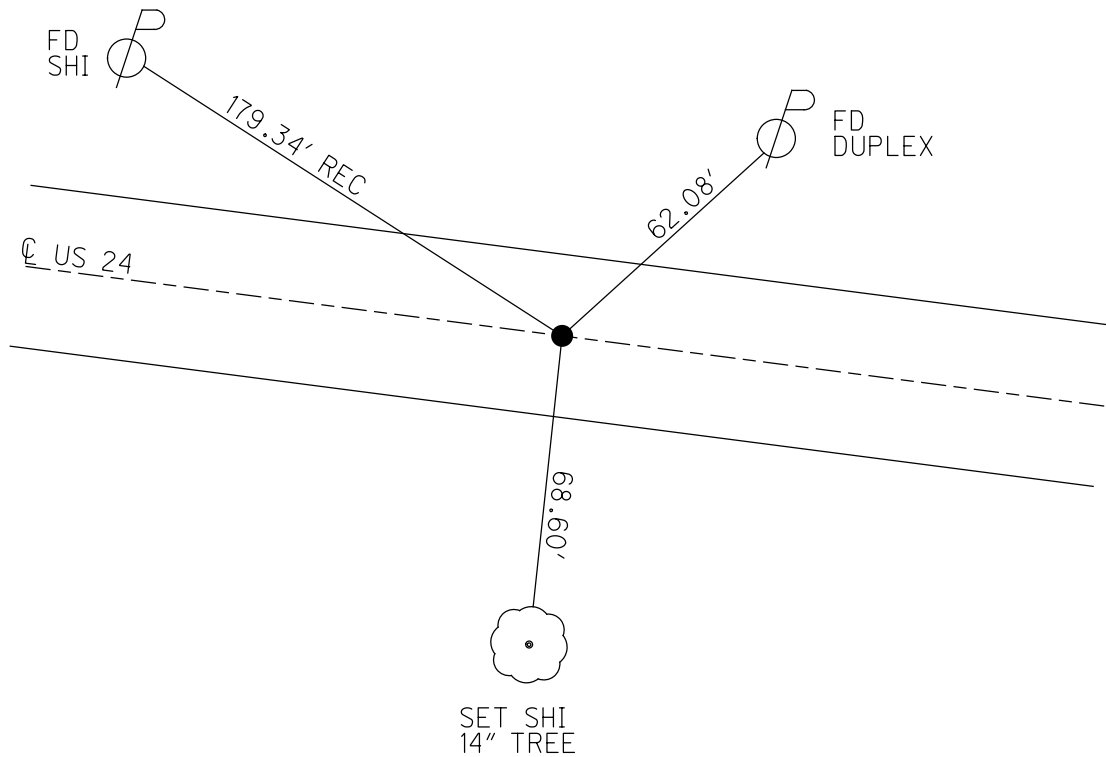

O.D.O.T. DISTRICT 2 SURVEY OFFICE

PERSONNEL

REFERENCE NO. 16

SHEET 4 OF 40

NOTES Simon

H.C. Loehrke

R.C. Cordes

DATE 4-23-93

WEATHER Sunny

TEMP. 66

ROUTE U.S. 24

COUNTY Henry

TOWNSHIP Liberty

SECTION 2

T. 5 N. R. 7 E.


TYPE MONUMENT Small R.B. Spike

ON SURFACE - ~~BELOW~~ yes


~~LEFT -~~ PAV'T. - RIGHT yes - .3'

11.9 TO Right EDGE PAVEMENT

S.L.M. 627 + 75 11.90

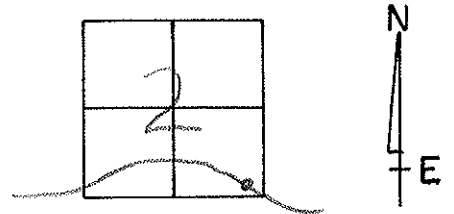

Reset PK + WASHER
7-13-93
m.B.

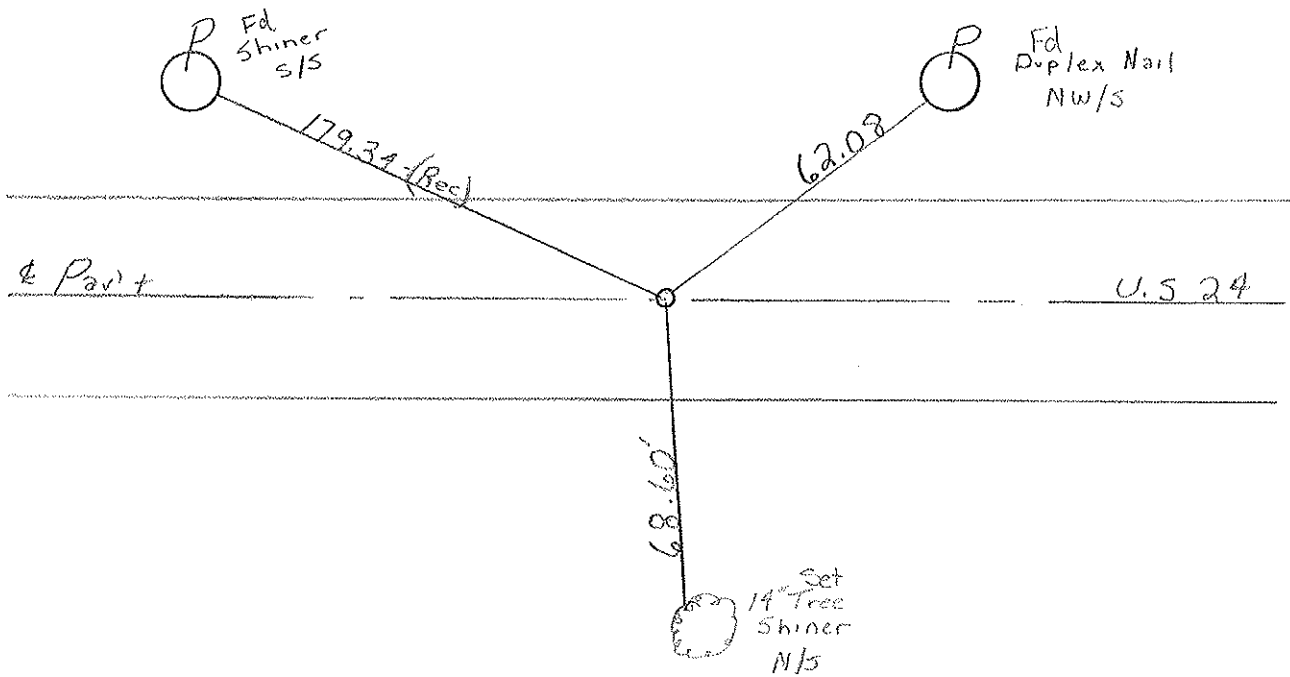

P.C. Sta. 834 + 51.96 Rec.

County Henry S.R.-U.S. 24

Date 6-2-81

Township LIBERTY

Weather OVERCAST

Section 2

Temp. +65°


T5N, R7E

Personnel HOFFMAN

Loehrke

Householder

(16)

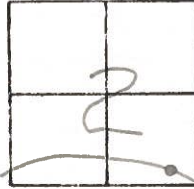


Fd. P.K. 2" Below Surface
0.30 S. of CTR. of PAUT.

PROJECT STA. ± 824 + 65

14.8 To S. EP.

14.9 To N. EP.

SET SMALL R.R. SPK. 9-21-81
SW.H

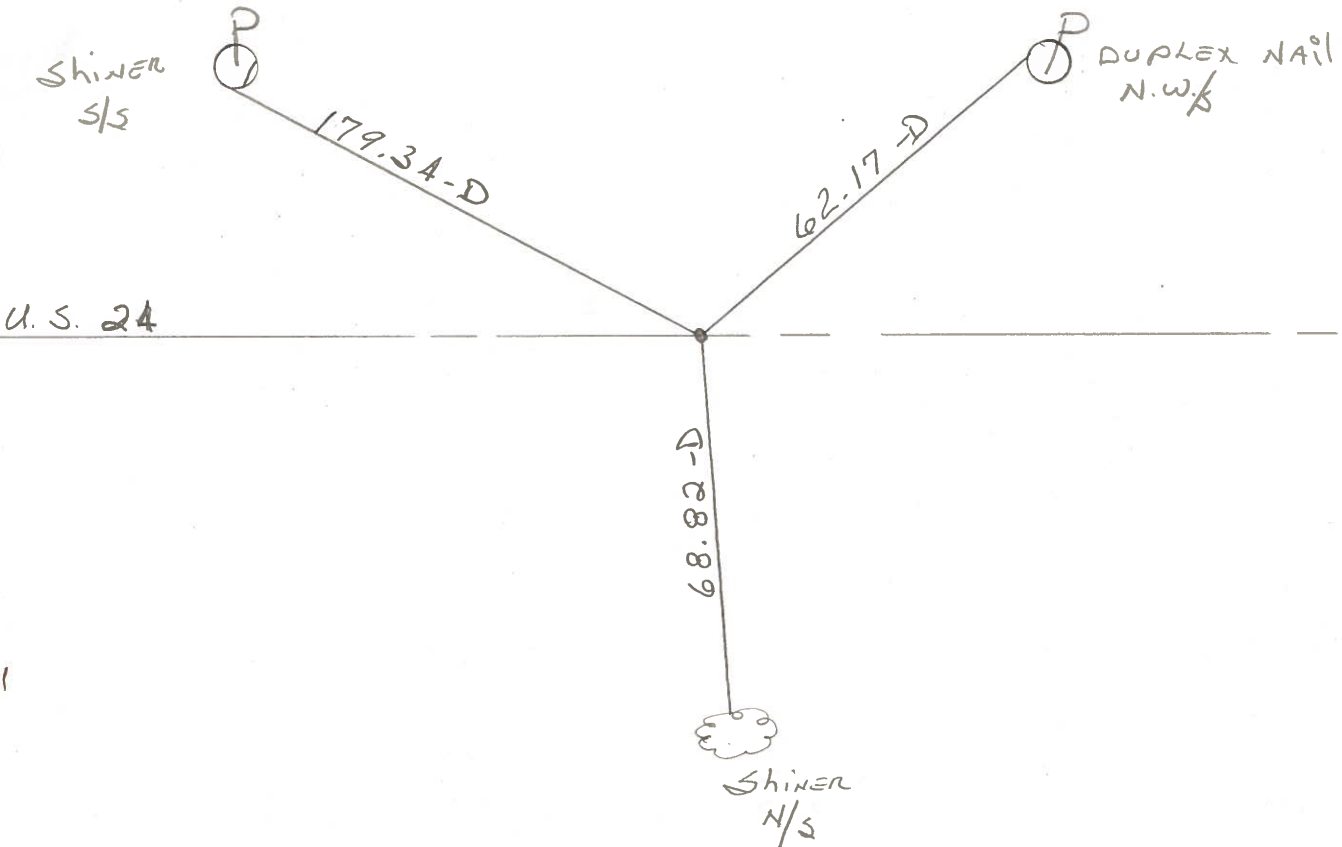

P.C. STA 824 + 51.96 REC.


PERSONNEL	TITLE	PERSONNEL	TITLE
Tomsic			
Neuser			
Granata			

COUNTY HEN. DATE JUNE 18, 1975

S. R. 24 WEATHER _____

SEC. LIBERTY TWP. TEMP. _____

DESCRIPTION WEST OF S.R. 109 JOB NO. _____

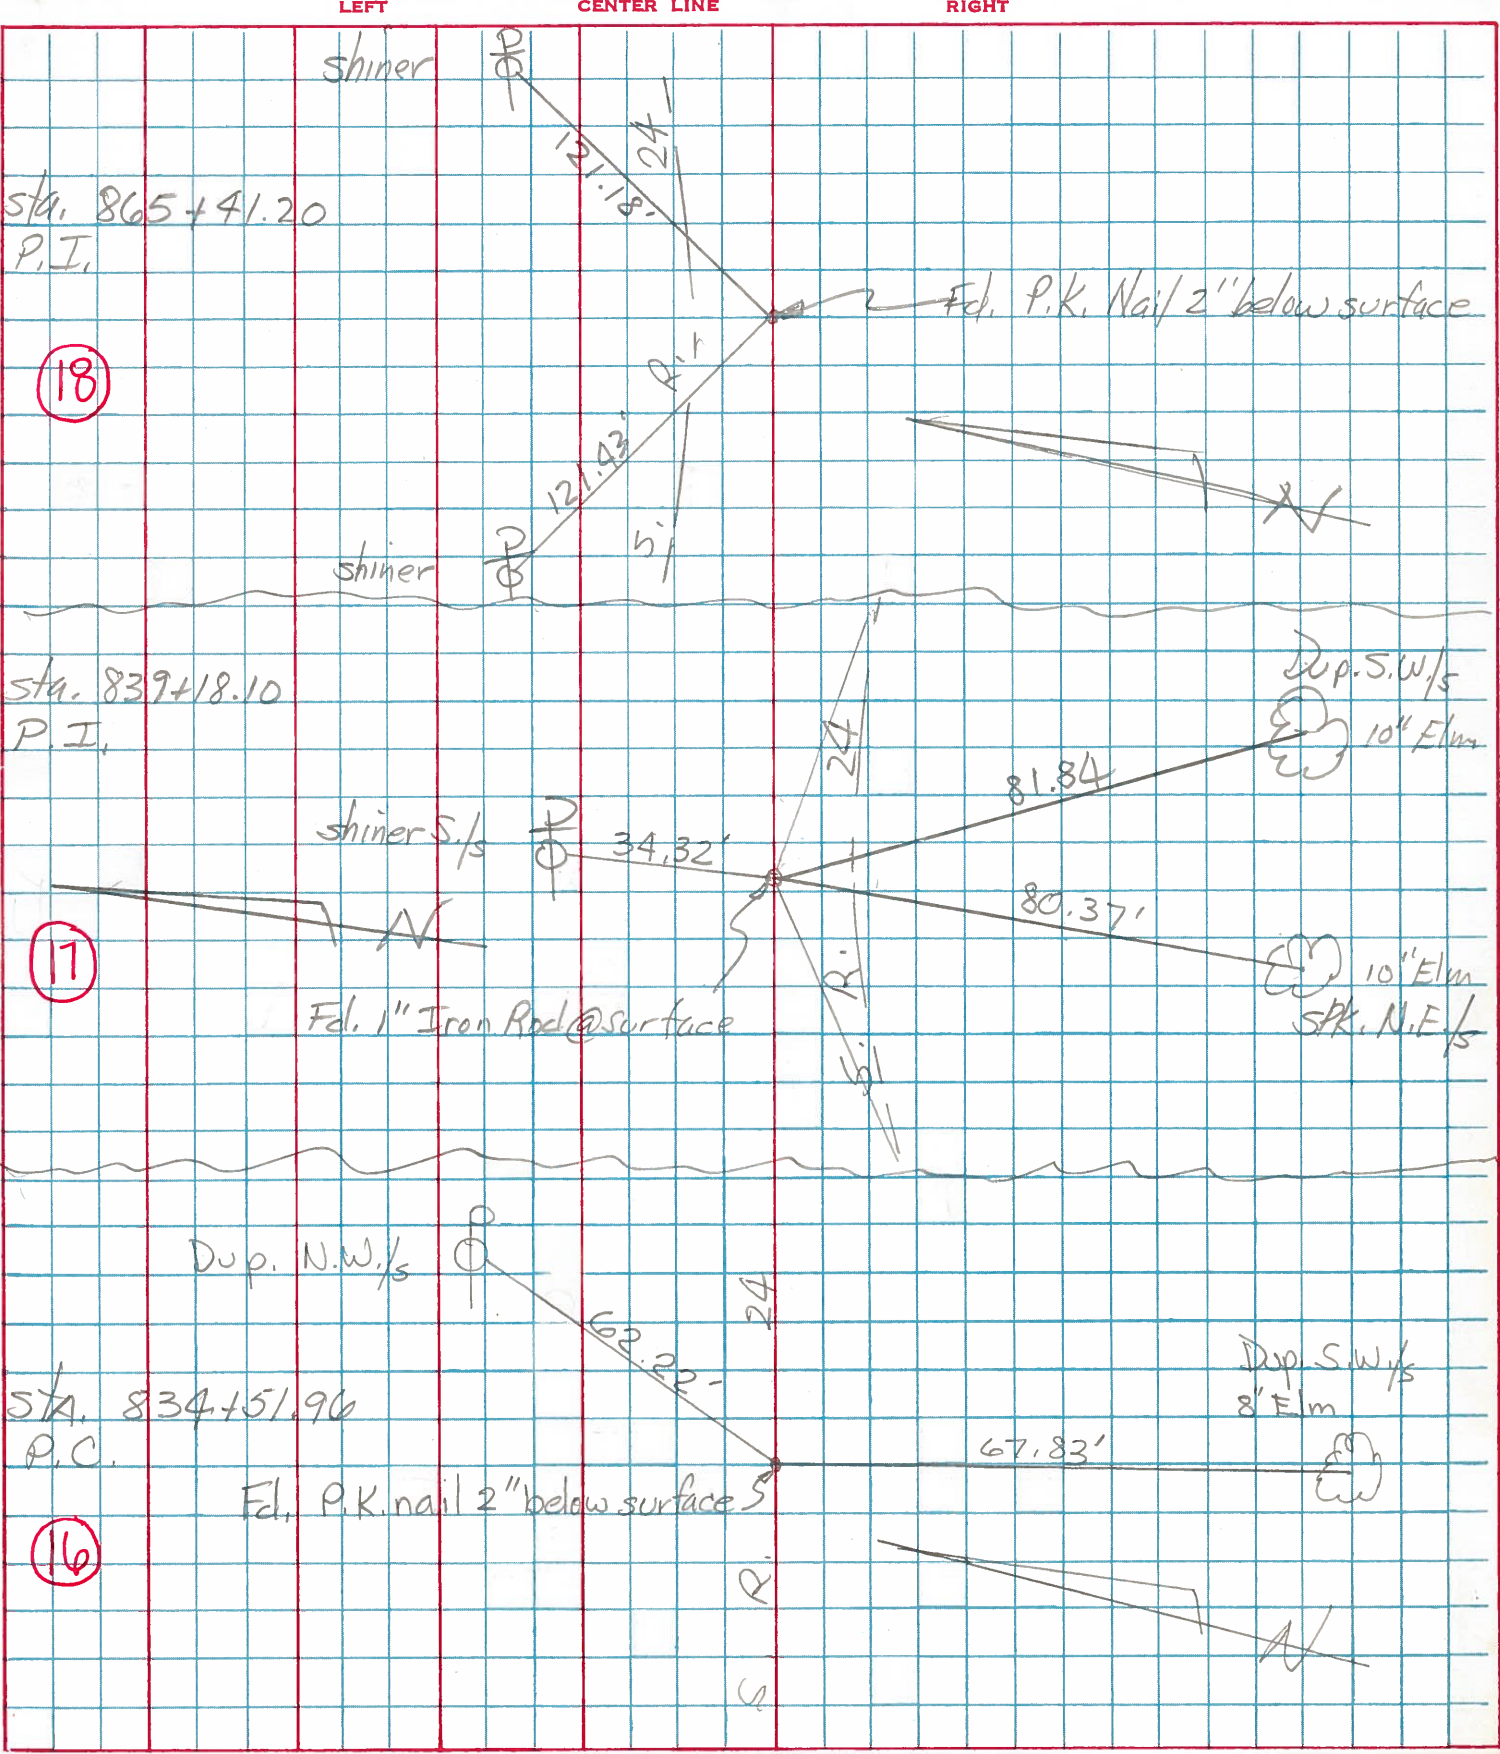

PERSONNEL	TITLE	PERSONNEL	TITLE	COUNTY	Henry	DATE	Apr. 59
Beach				S. R.	US-74	WEATHER	
Rutter				SEC.	11.22	TEMP.	
Knappe							
Delventhal							

DESCRIPTION ε Constr. LEFT CENTER LINE RIGHT JOB NO. _____

