

O.D.O.T. DISTRICT 2 SURVEY OFFICE (USE ONLY)

PERSONNEL

REFERENCE NO. 17

SHEET 6 OF 47

NOTES SIMON

DATE 4/23/93

ROUTE US 24

H.C. LOEHRKE

WEATHER SUNNY

COUNTY HENRY

R.C. CORDES

TEMP. 65°

TOWNSHIP LIBERTY

SECTION 2

DWG BY NIESE PID \_\_\_\_\_

T 5 N R 7 E

TYPE MONUMENT 1" IPIN

~~ON SURFACE~~ - BELOW 3"


OFFSET Q PAVEMENT 14.2' LT : RT

2.4' LT TO LT EDGE PAVEMENT


STATION: 632+41

HORZ. DATUM: \_\_\_\_\_ GEOID: \_\_\_\_\_

GRID: NORTHING: \_\_\_\_\_ EASTING: \_\_\_\_\_

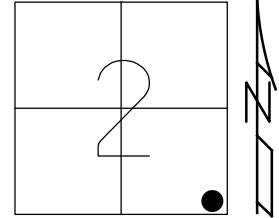

RECORD: P.I.  
 STA 839+18.10  
 FD 1" IPIN  
 4/23/93, CL  
 SET P.K./WASHER  
 7/13/93, CL

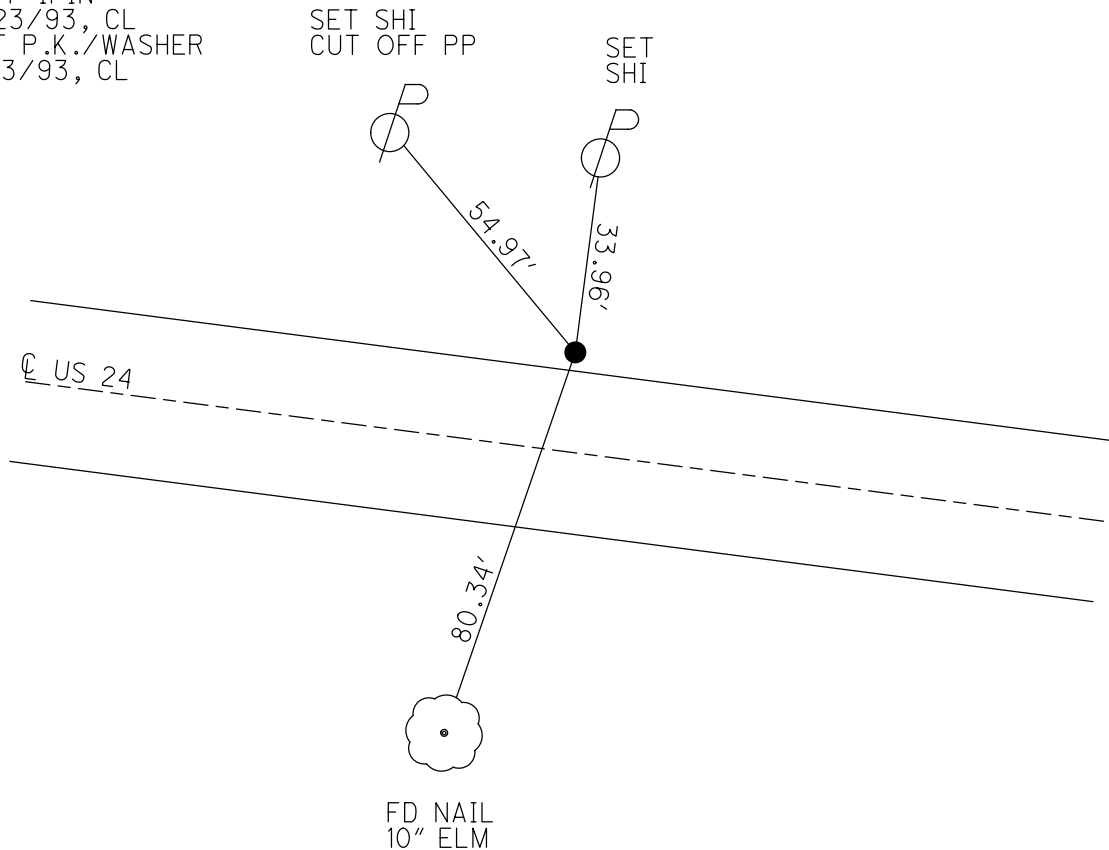

# O.D.O.T. DISTRICT 2 SURVEY OFFICE

PERSONNEL

REFERENCE NO. 17 SHEET 5 OF 40

NOTES Simon

H.C. Loebker

R.C. Cordes

DATE 4-23-93

WEATHER Sunny

TEMP. 65

ROUTE U.S. 24

COUNTY Henry

TOWNSHIP Liberty

SECTION 2

T 5 N R 7 E


TYPE MONUMENT Iron Bar - 1"

~~ON~~ SURFACE - BELOW yes 3"


LEFT - ☉ PAV'T. - RIGHT 14.2

2.4 <sup>ft. off</sup> TO Left EDGE - PAVEMENT

S.L.M. 632+41 11.98

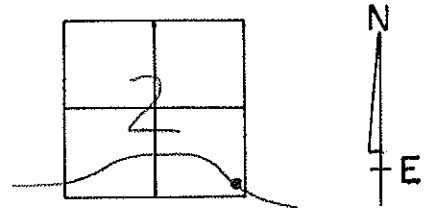

RESET PK & W/CHUCK  
 7-13-93  
 MB

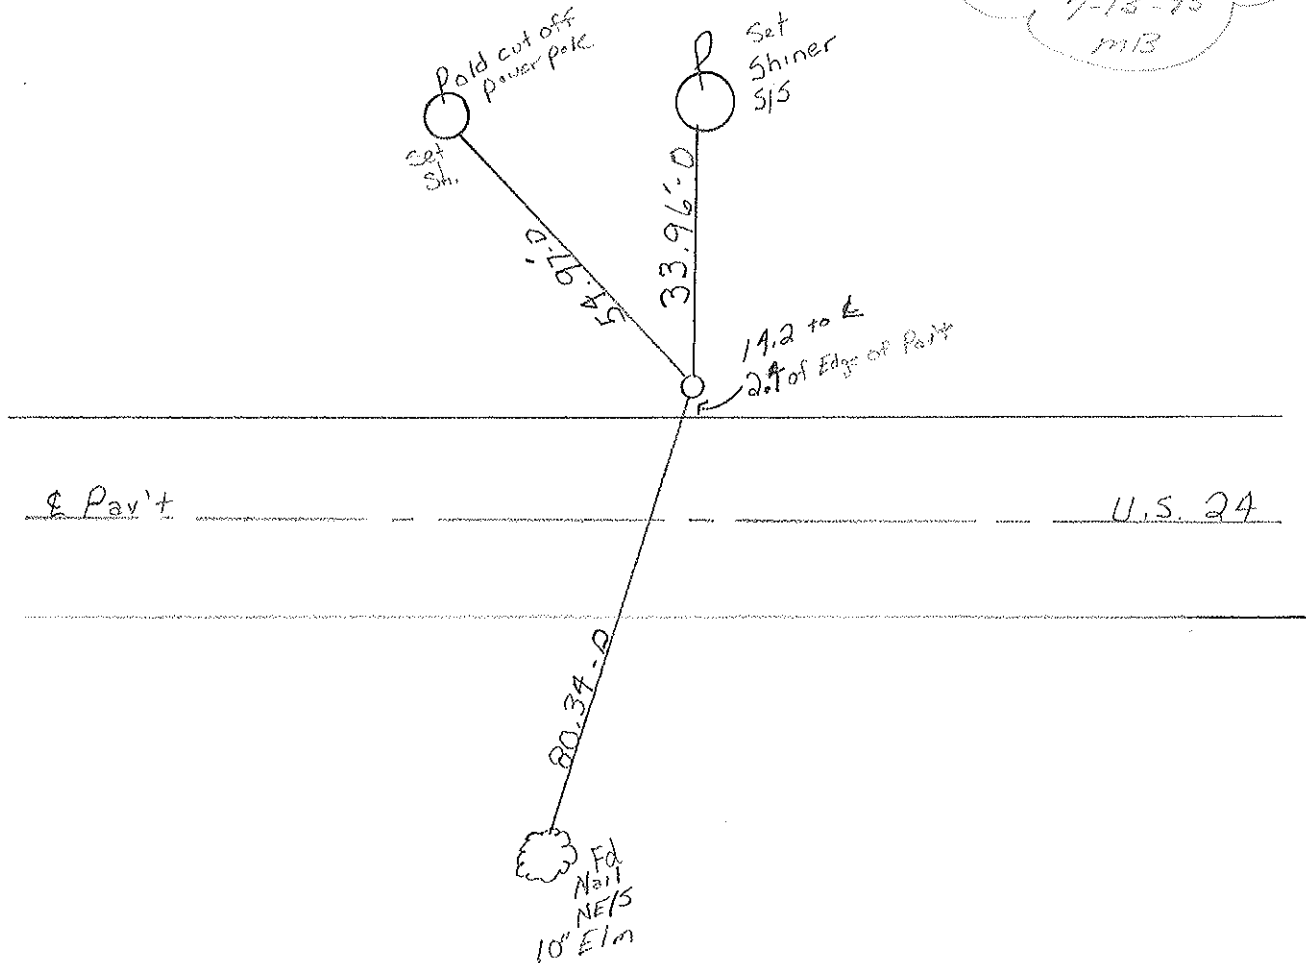

P.I. STA. 839+18.10 Rec.

County HENRY S.R. - U.S. 24

Date 6-2-81

Township LIBERTY

Weather OVERCAST

Section 2

Temp. + 65°


T5N, R7E

Personnel Hoffman

Loehrke

Householder

(17)

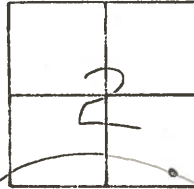


Fd. IRON BAR - 1" - @ SURFACE  
2.2' N. of N.E.P.

PROJECT STA. ± 829+32

0.75' S. of N.E.P @ BERM  
14.3 N. of & PAUT.

DID NOT RESET  
SHOULD DIG UP WHEN NEEDED

9-3-81  
SWH

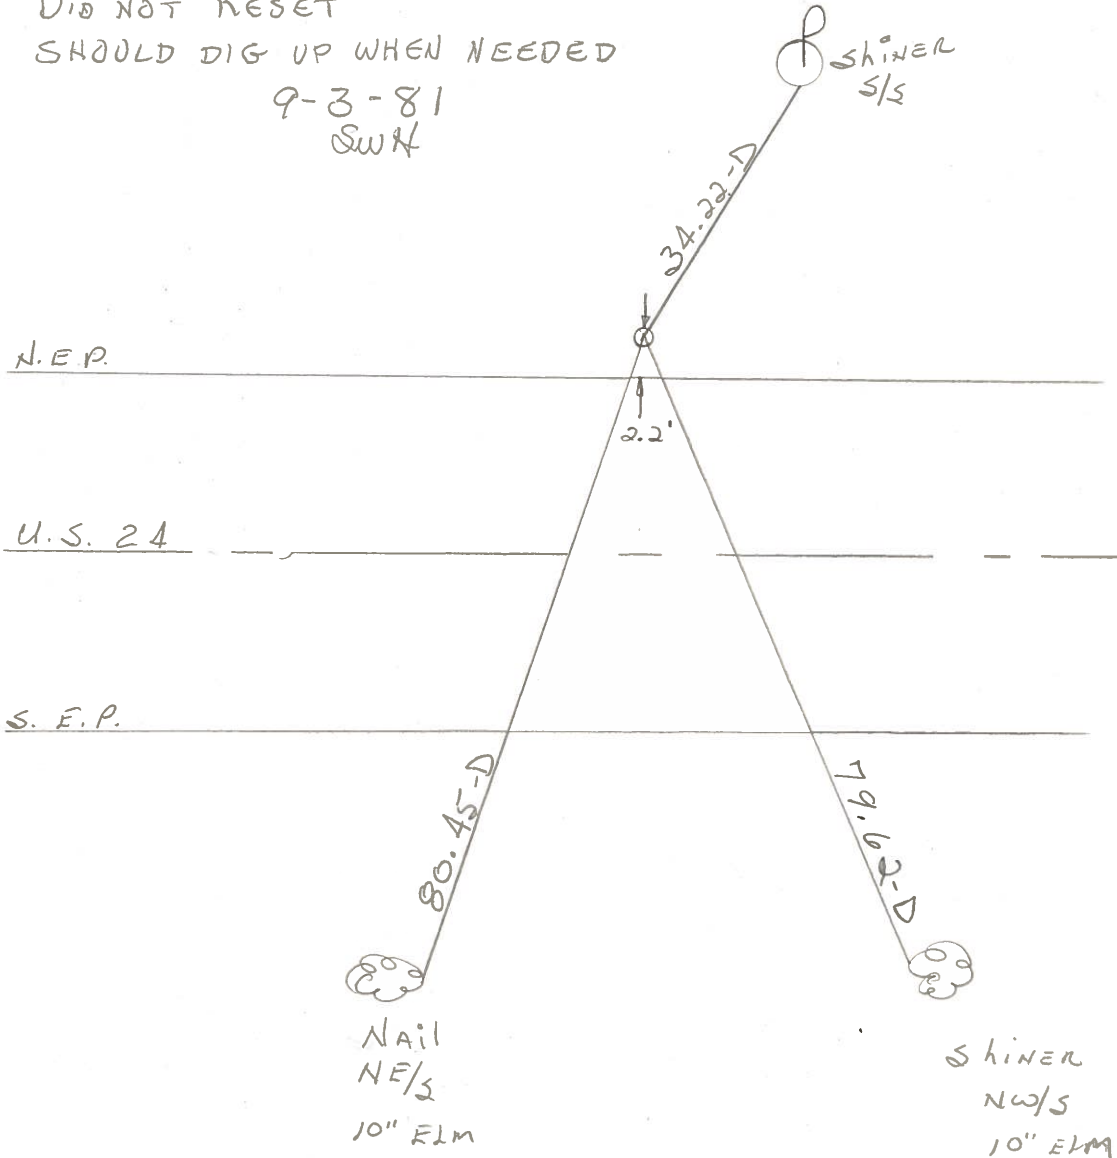


P.I. STA. 839+18.10 REC.

PERSONNEL	TITLE	PERSONNEL	TITLE
Tomsic			
Neuser			
Granata			

COUNTY HEN. DATE JUNE 18, 1975  
 S. R. 24 WEATHER \_\_\_\_\_  
 SEC. LIBERTY TWP. TEMP. \_\_\_\_\_

DESCRIPTION WEST OF S.R. 109 JOB NO. \_\_\_\_\_

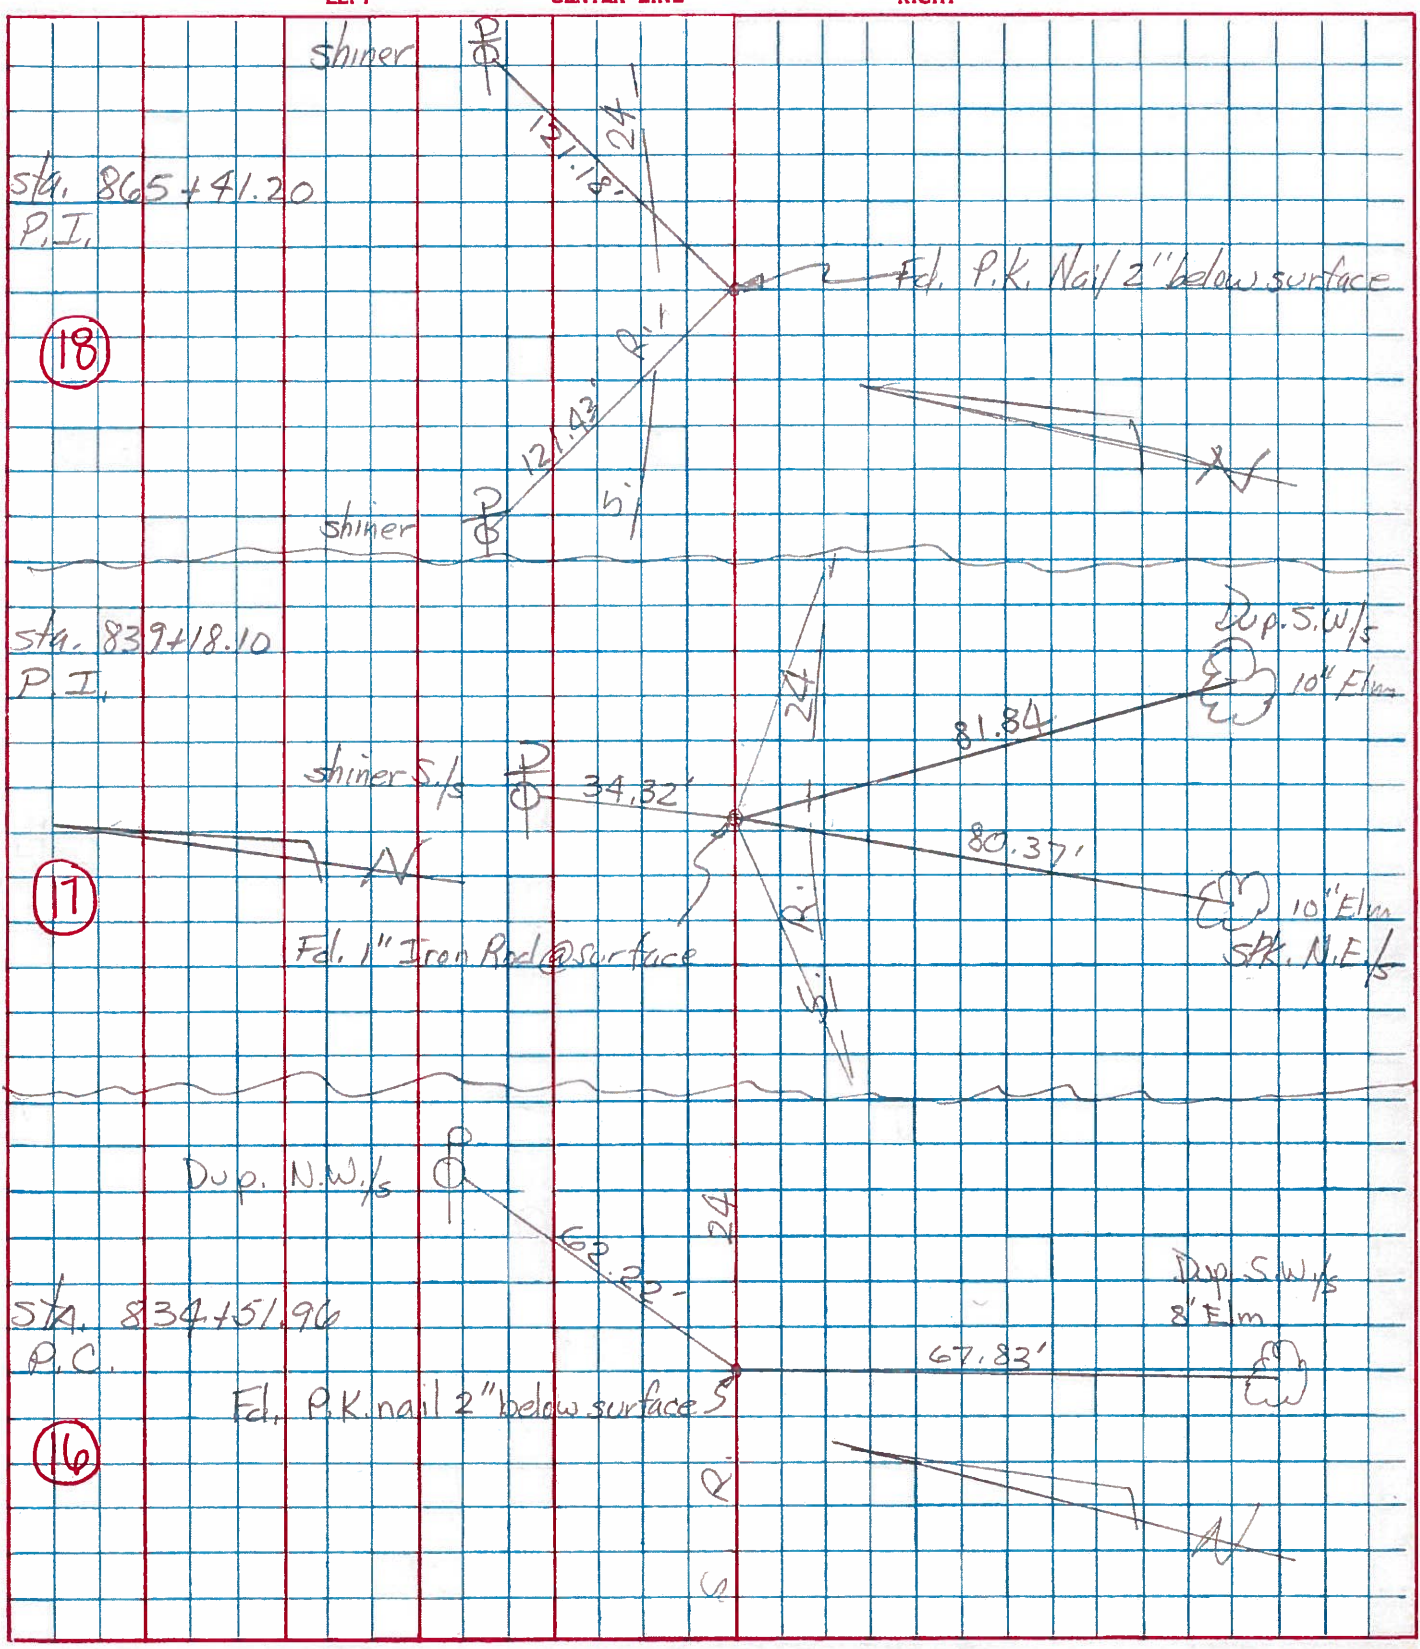



PERSONNEL Beach TITLE \_\_\_\_\_ PERSONNEL Rutter TITLE \_\_\_\_\_ COUNTY Henry DATE Apr. 59  
 PERSONNEL Knape TITLE \_\_\_\_\_ PERSONNEL Delventhal TITLE \_\_\_\_\_ S. R. US-74 WEATHER \_\_\_\_\_  
 SEC. 11.22 TEMP. \_\_\_\_\_

DESCRIPTION Constr. LEFT \_\_\_\_\_ CENTER LINE \_\_\_\_\_ RIGHT \_\_\_\_\_ JOB NO. \_\_\_\_\_

