


O.D.O.T. DISTRICT 2 SURVEY OFFICE (USE ONLY)

PERSONNEL _____ REFERENCE NO. 20 C SHEET 5 OF 40
 NOTES NUHFER DATE 7/14/08 ROUTE US 24
 H.C. HUSS WEATHER SUNNY COUNTY HENRY
 R.C. MOSER TEMP. 75° TOWNSHIP LIBERTY
 _____ SECTION 12
 _____ T 5 N R 7 E


TYPE MONUMENT P.K.NAIL
 ON SURFACE - ~~BELOW~~ ON _____
 LEFT - ☉ PAV'T - ~~RIGHT~~ 1.2'
 - TO - EDGE PAVEMENT
 S.L.M. 668+03
 Grid: Northing: _____ Easting: _____

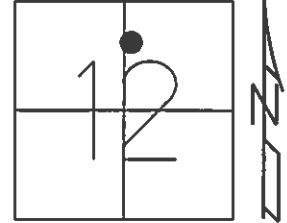

FD SM.R.R.SPIKE
 5/26/93, C.L.

RESET P.K./WASHER
 7/13/93, MB

FD P.K.NAIL
 7/11/08, RN

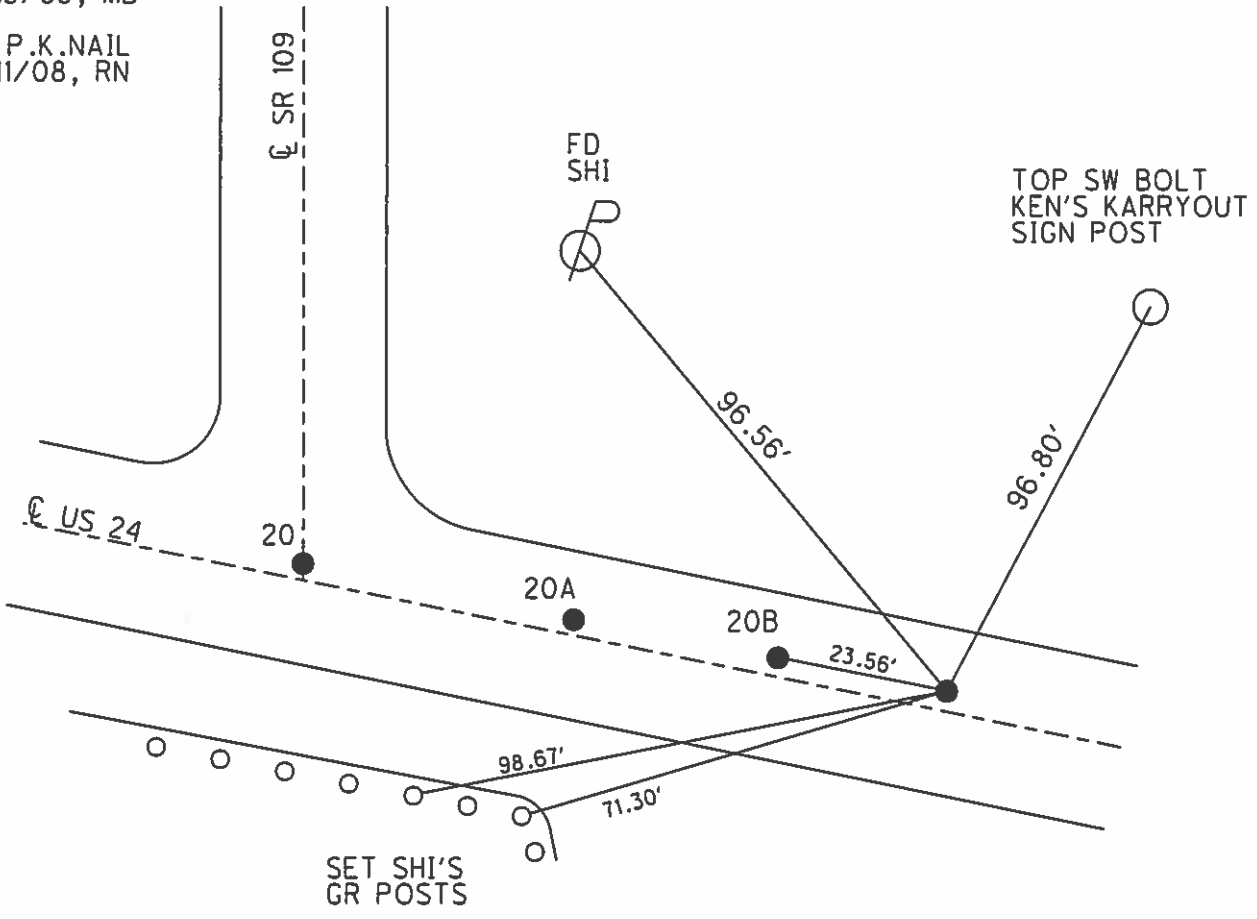

O.D.O.T. DISTRICT 2 SURVEY OFFICE

PERSONNEL _____

REFERENCE NO. 20

SHEET 8 OF 40

NOTES LOG#HRK6

H.C. BARDHISEL

DATE 5-26-93

ROUTE U.S. 24

R.C. CANTER BURY

WEATHER Clear

COUNTY Henry

Newell

TEMP. +50

TOWNSHIP Liberty

SECTION 12-Fractional

T 5 N R 7 E


TYPE MONUMENT Sm R.R. Spikes

ON SURFACE - BELOW Yes - ALL

LEFT- & PAV'T. - RIGHT Yes, ALL

TO EDGE PAVEMENT


S.L.M. PA- 667+00 12.63

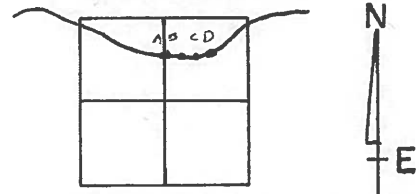

The Cedars

Reset PK'S + WASHERS
7-13-93
MIB

Meter's Carryout

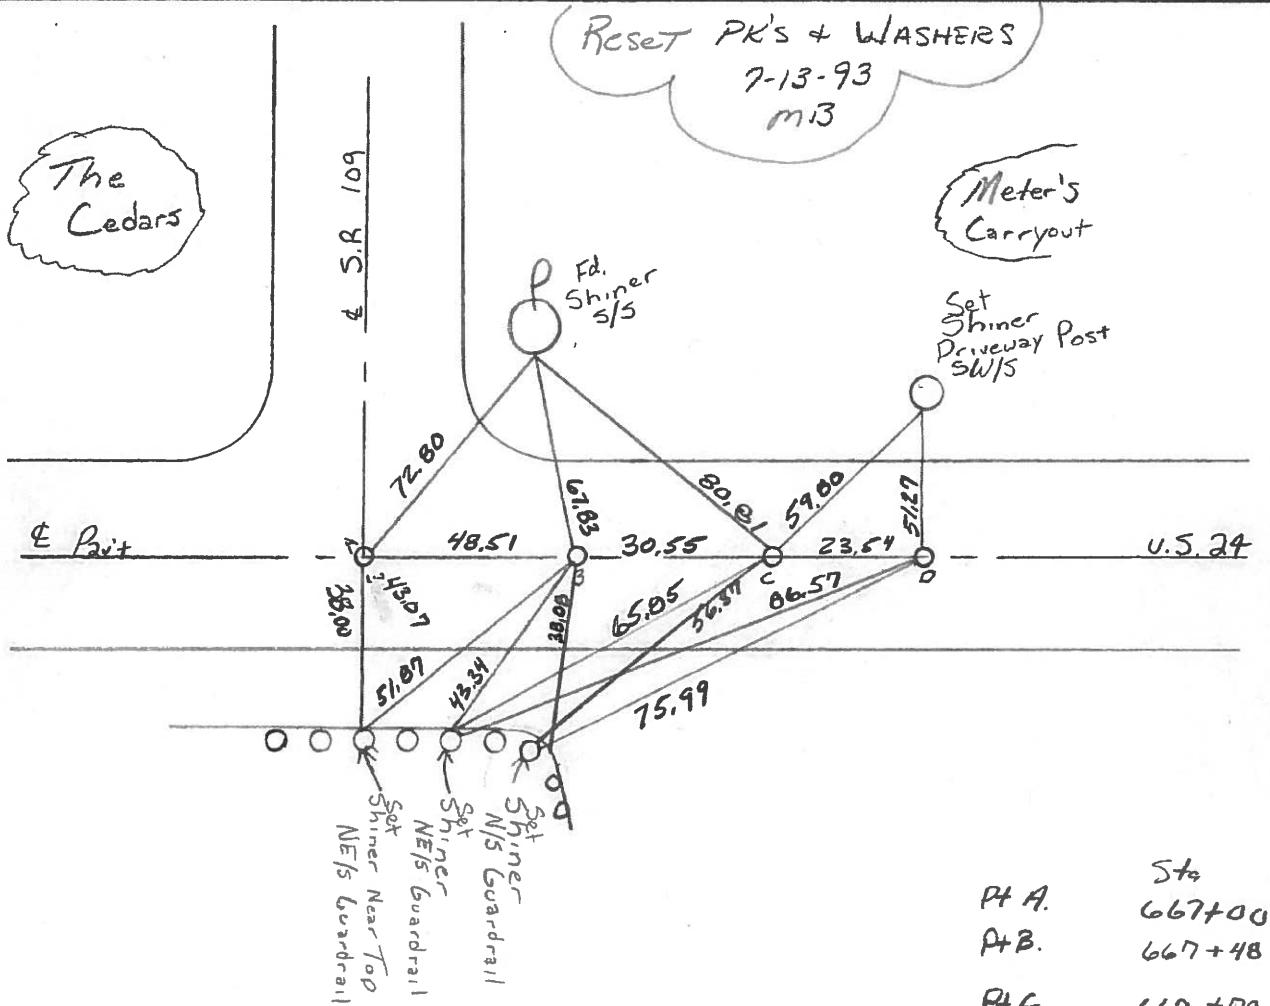

Pt A.	Sta
	667+00
Pt B.	667+48
Pt C	667+79
Pt D	668+03

Pt "B" = P.C. Sta. 874+19.40 Rec.

County Henry S.R. - U.S. 24

Date 6-2-81

Township Liberty


Weather OVERCAST

Section 12 - FRACTIONAL

Temp. +65°

T5N, R7E

Personnel HOFFMAN

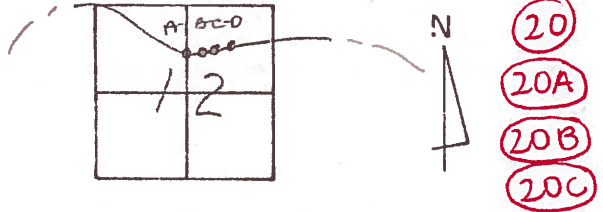

#15

Householder
Loehrke


PT. "A" Fd. small R.R. SPIK. 3" Below surface 0.65' N. of ϕ

PT. "B" Fd. P.K. 3" Below surface — PROJECT STA \pm 864+35

PT. "C" Fd. 1/2" IRON PIPE 1" Below surface 0.60' S. of ϕ

PT. "D" Fd. R.R. SPIK 3" Below surface 0.85' S. of ϕ

SET SMALL R.R. SPIKS @ ALL POINTS
9-1-81 - SWH

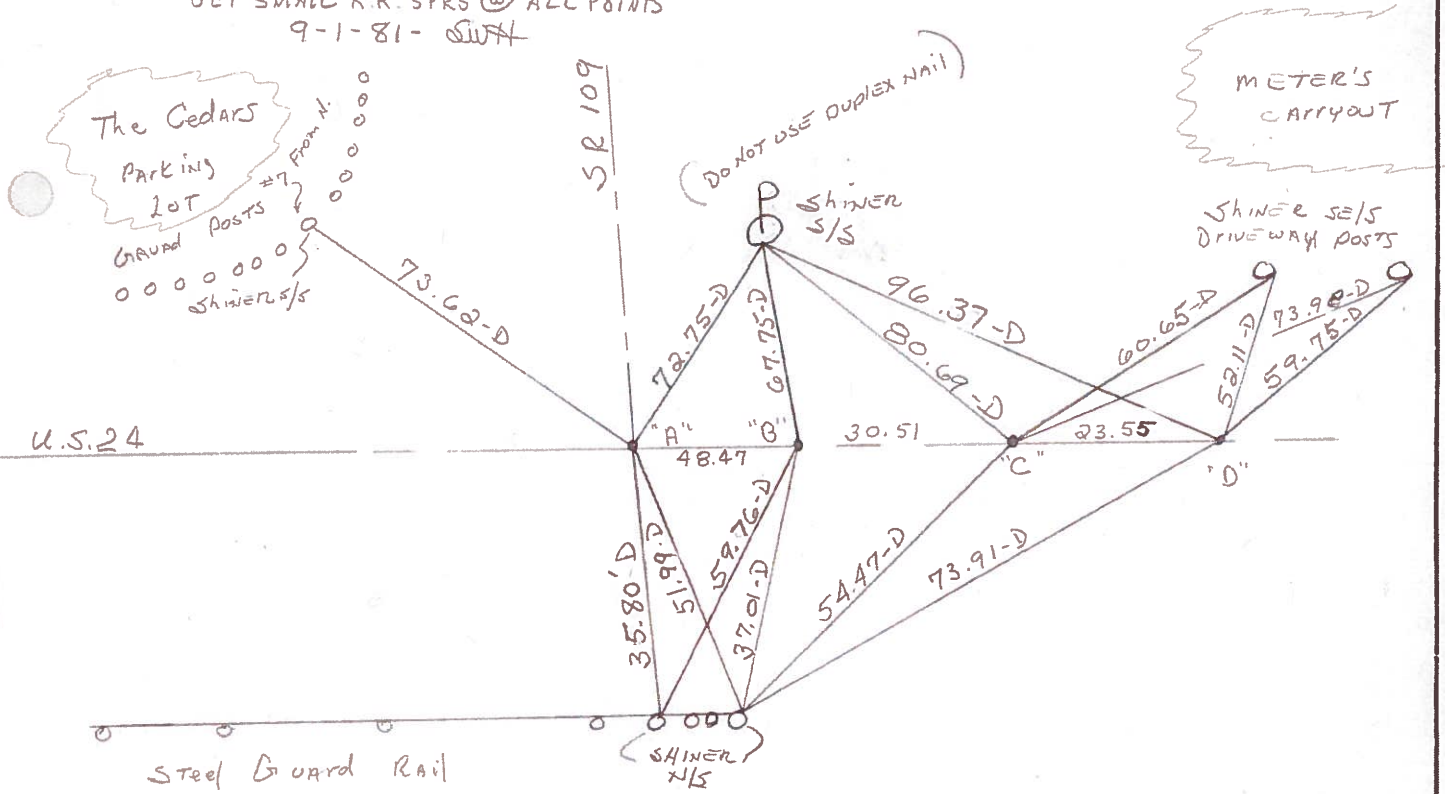

PT. "B" = P.C. STA. 874+19.40 REC.

PERSONNEL TITLE PERSONNEL TITLE COUNTY HEN. DATE JUNE 24, 1975
Tomsic _____
Neuser _____
Granata _____
 S. R. 24 WEATHER _____
 SEC. LIBERTY TWP TEMP. _____

DESCRIPTION WEST OF S.R. 109 JOB NO. _____
 LEFT CENTER LINE RIGHT

