


O.D.O.T. DISTRICT 2 SURVEY OFFICE (USE ONLY)

PERSONNEL _____ REFERENCE NO. 22 A SHEET 8 OF 40
 NOTES NUHFER DATE 7/14/08 ROUTE US 24
 H.C. HUSS WEATHER SUNNY COUNTY HENRY
 R.C. MOSER TEMP. 75° TOWNSHIP LIBERTY
 _____ SECTION 12
 _____ T 5 N R 7 E

TYPE MONUMENT SM.R.R.SPIKE
 ON SURFACE - ~~BELOW~~ ON
 LEFT - ☉ PAV'T - RIGHT ON
 _____ TO _____ EDGE PAVEMENT
 S.L.M. 672+56
 Grid: Northing: _____ Easting: _____

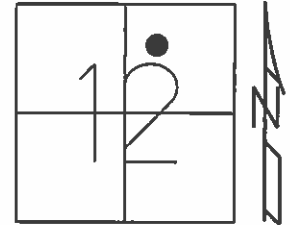


RECORD: P.T
 STA.879+65.46

FD SM.R.R.SPIKE
 5/26/93, C.L.

RESET P.K./WASHER
 8/9/93, C.L.

D.N.F. P.K./WASHER
 OR SM.R.R.SPIKE.
 NEED TO RESET.
 7/11/08, RN

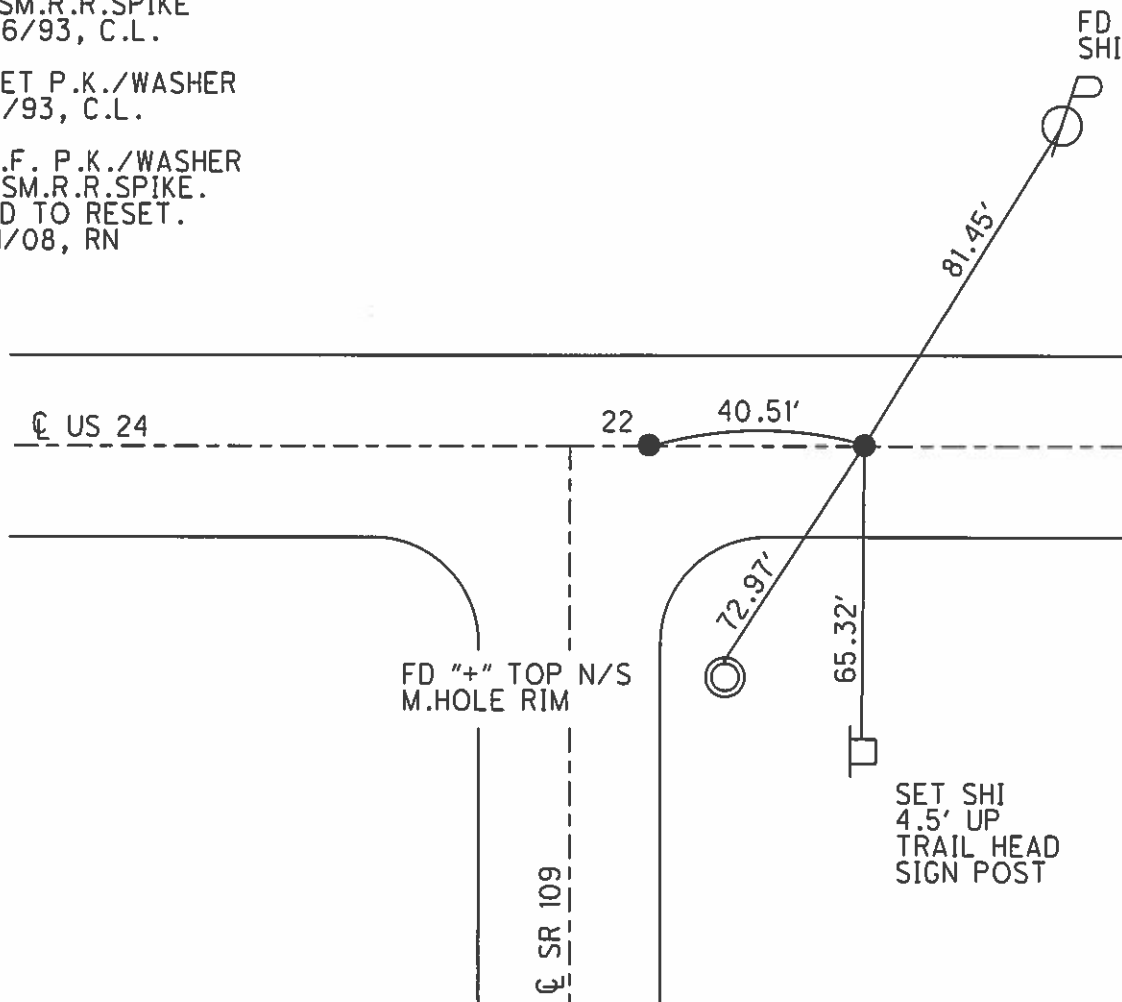

O.D.O.T. DISTRICT 2 SURVEY OFFICE

PERSONNEL

REFERENCE NO. 22

SHEET 10 OF 40

NOTES LOEHRKE

H.C. BARNSIDE

R.C. CANTERBURY

Newell

DATE 5-26-93

WEATHER CLEAR

TEMP. +55

ROUTE U.S. 24

COUNTY Henry

TOWNSHIP Liberty

SECTION 12-Fractional

T 5 N R 7 E


TYPE MONUMENT 5m. R.R. Spike

ON SURFACE - ~~BEEOW~~ Yes


LEFT- & PAV'T. - RIGHT Yes

TO EDGE PAVEMENT

S.L.M. 672+56 12.74

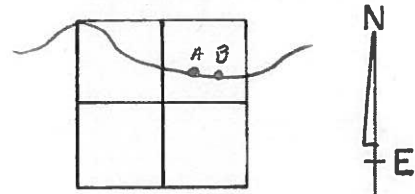

Pt "A" PK + Washer on E & Reset P.K and washers
 Pt "B" ^{sm.} R.R Spike & 8-9-93
 CL

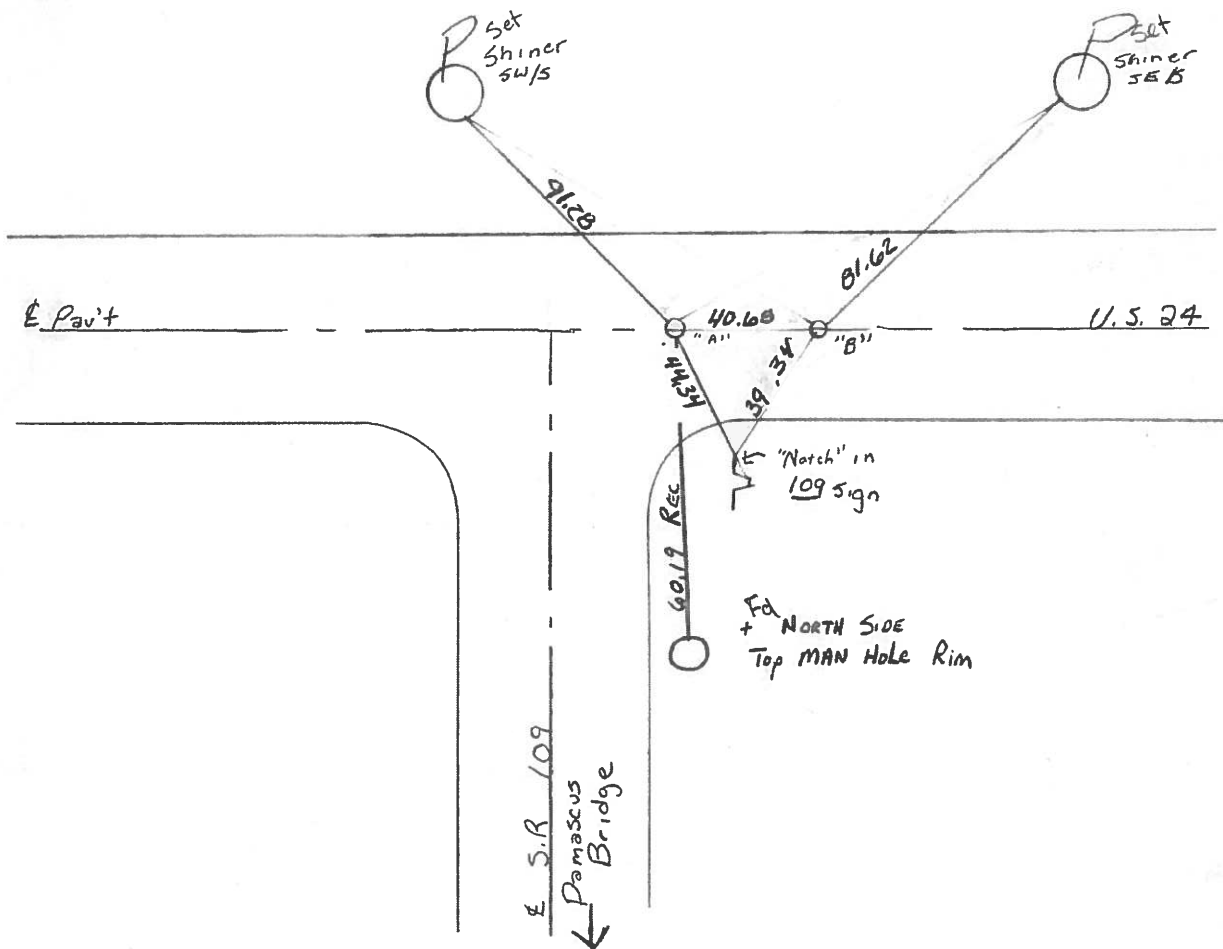

Pt "B" P.T Sta. 879+65.46 Rec

O.D.O.T. DISTRICT 2 SURVEY OFFICE

SHEET 10 OF

County HENRY S.R.-U.S. 24

Date 6-2-81

Township LIBERTY

Weather OVERCAST

Section 12 - FRACTIONAL

Temp. + 70°

T5N, R7E


Personnel Hoffman

Loehrke


Householder

22

22A

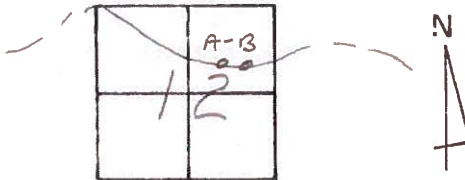

PT. "A" Fd. P.K. @ SURFACE / 20.4' TO N. EDGE PAVT SET P.K. P WASHER
 9-1-81 SWN
 PT. "B" Fd. P.K. 3" Below SURFACE / 27.3' TO N. EDGE PAVT. SET SMALL R.R. SPK.
 ON E PROJECT STA. ± 869+79

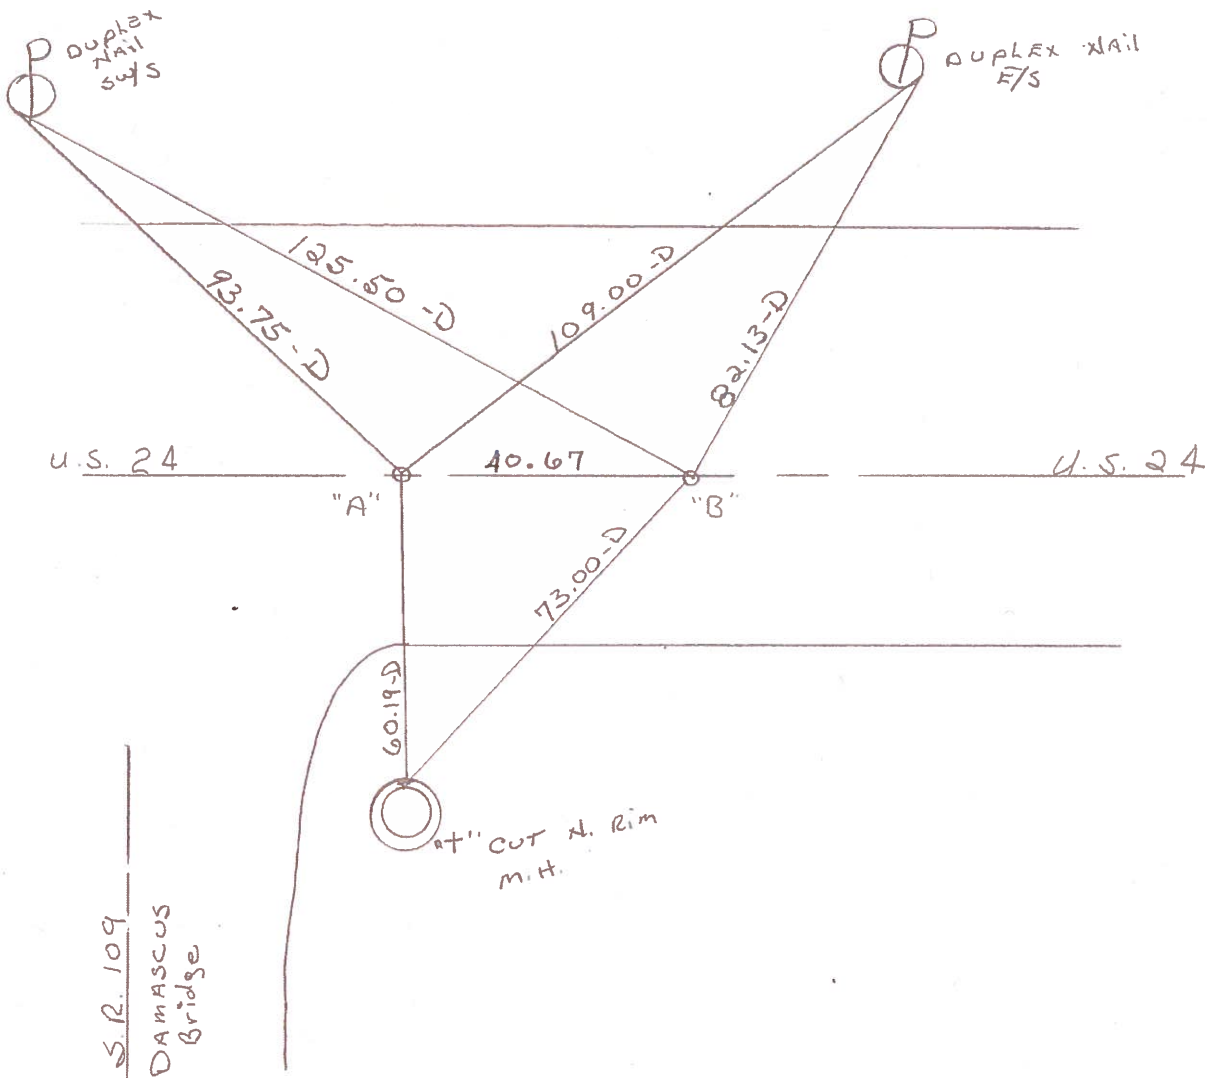


pt. "B" P.T. STA. 879+65.46 REC.


PERSONNEL	TITLE	PERSONNEL	TITLE
Tomsic			
Neuser			
Granata			

COUNTY HEN. DATE JUNE 26, 1975
 S. R. 24 WEATHER _____
 SEC. _____ TEMP. _____

DESCRIPTION _____ LEFT _____ CENTER LINE _____ RIGHT _____ JOB NO. _____

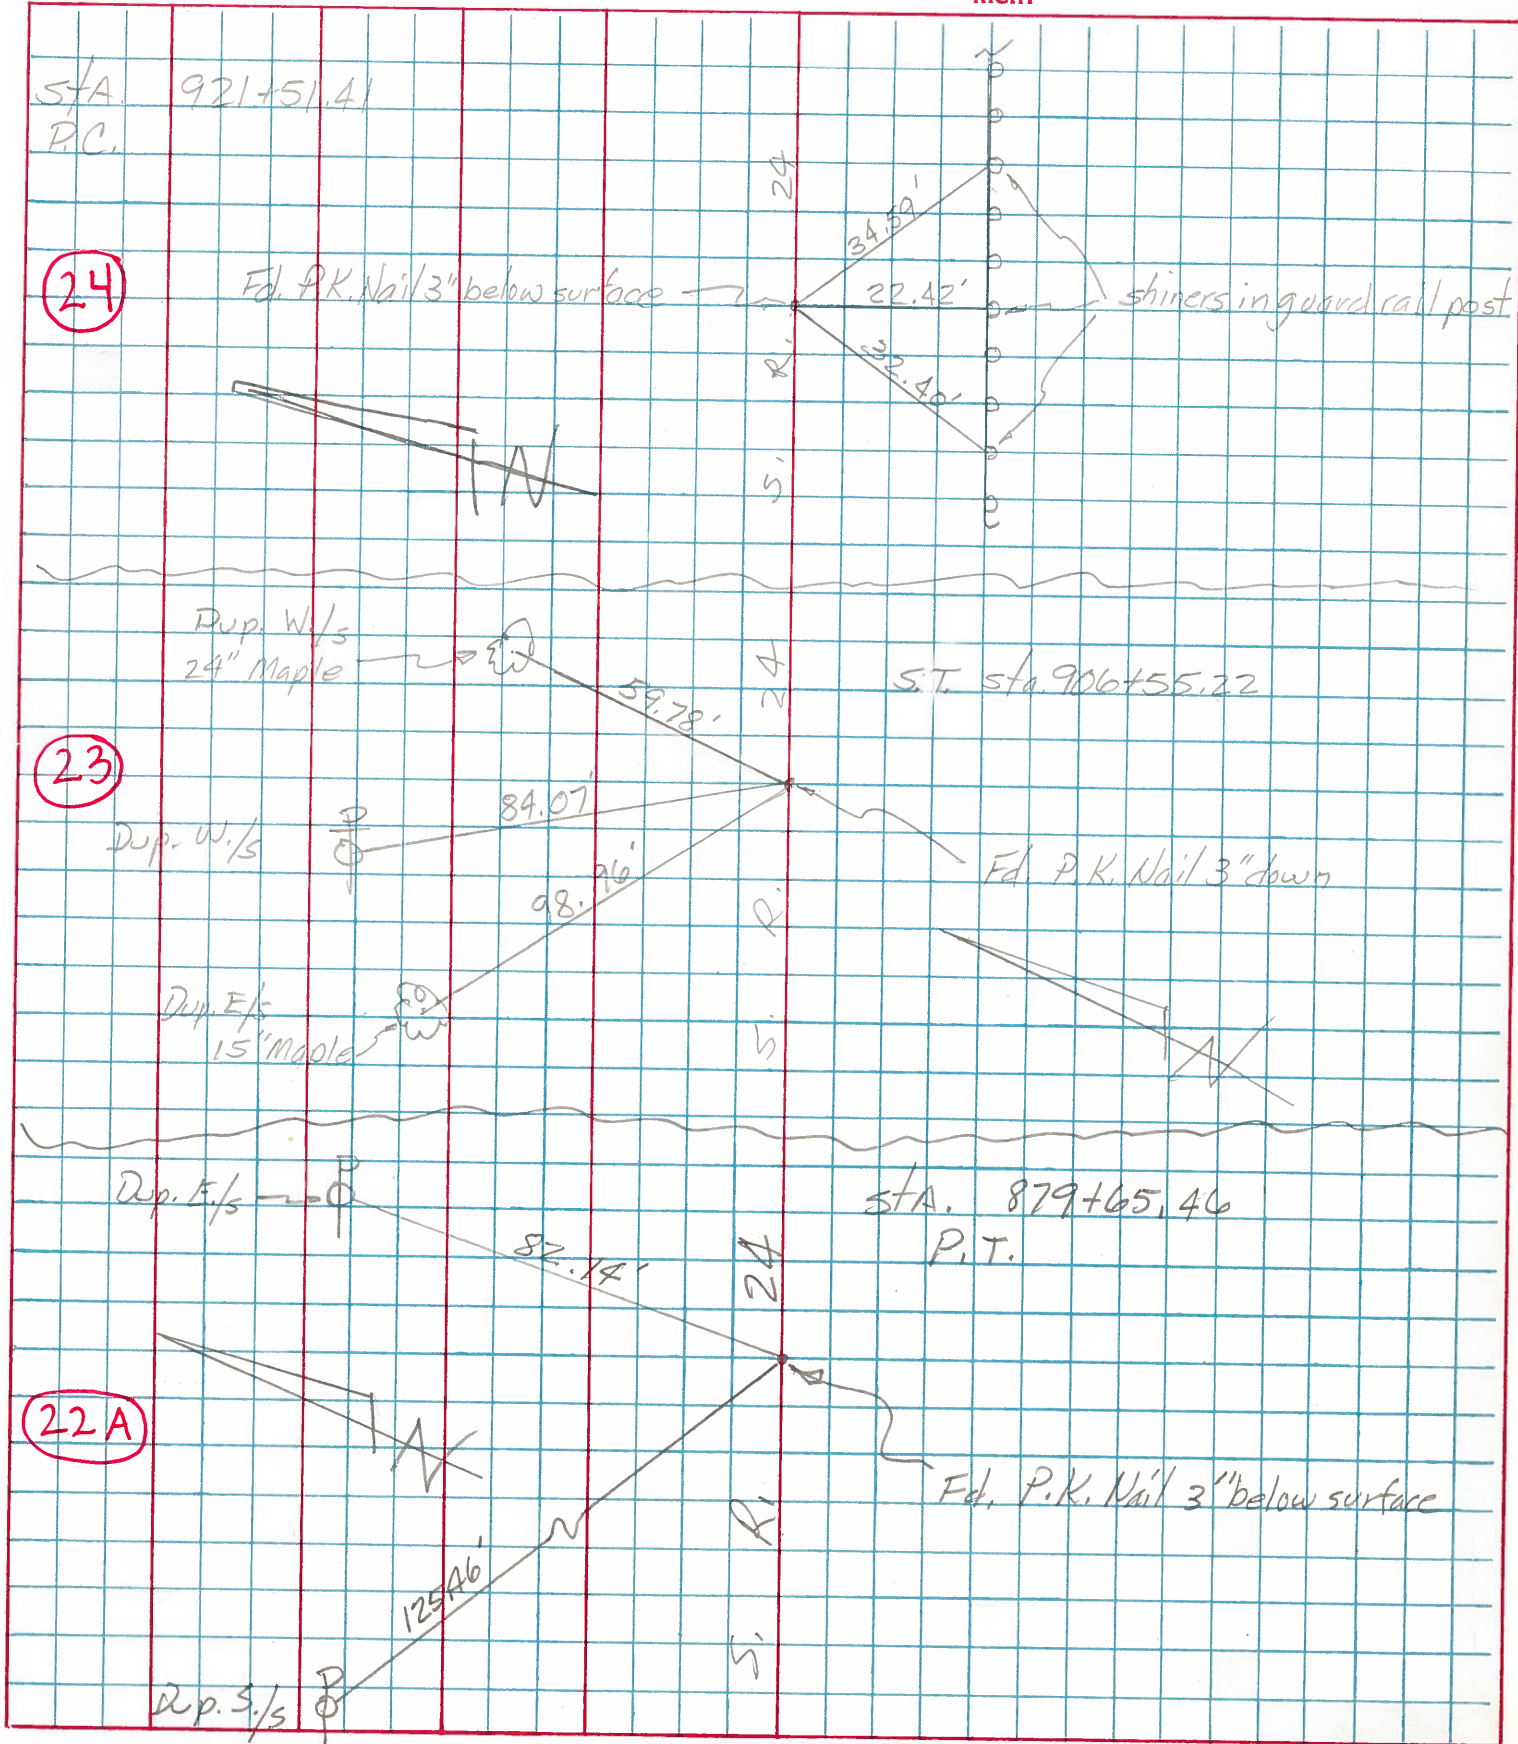

PERSONNEL	TITLE	PERSONNEL	TITLE	COUNTY	Henry	DATE	Apr '59
Beach				S. R.	US-24	WEATHER	
Rutter				SEC.	11.22	TEMP.	
Knape				DESCRIPTION	Const.		
Delventhal				LEFT	CENTER LINE	RIGHT	JOB NO.

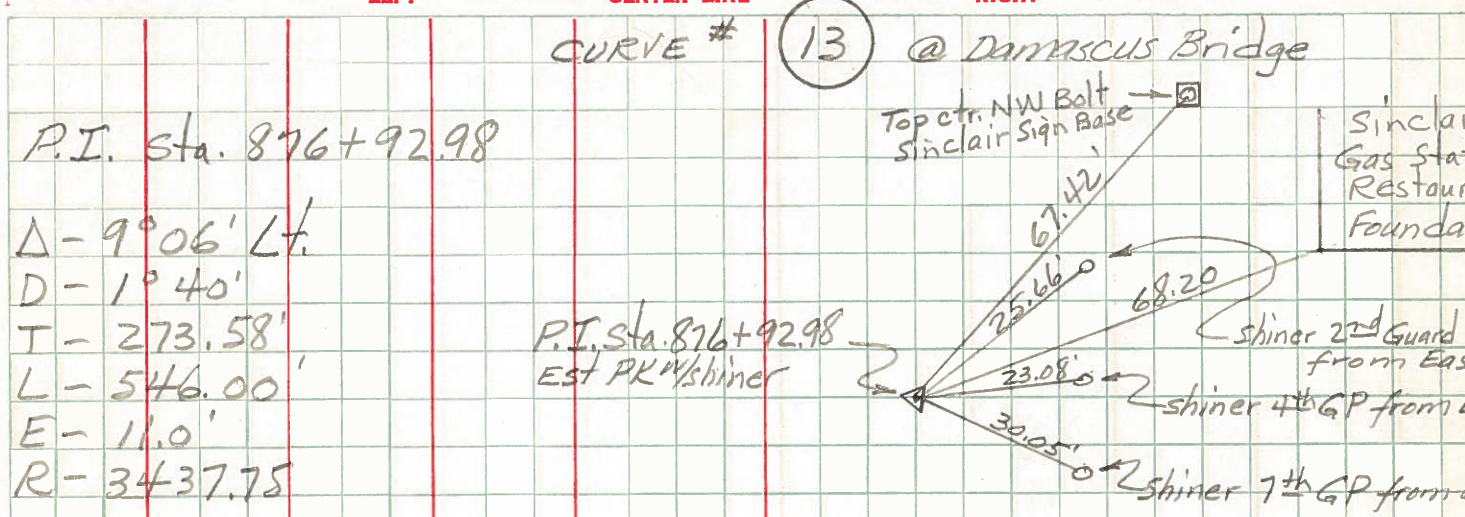

Δ - 9° 06' Lt.
 D - 1° 40'
 T - 273.58'
 L - 546.00'
 E - 11.0'
 R - 3437.75

P.C. Sta 874+19.40
 P.T. Sta. 879+65.40

