
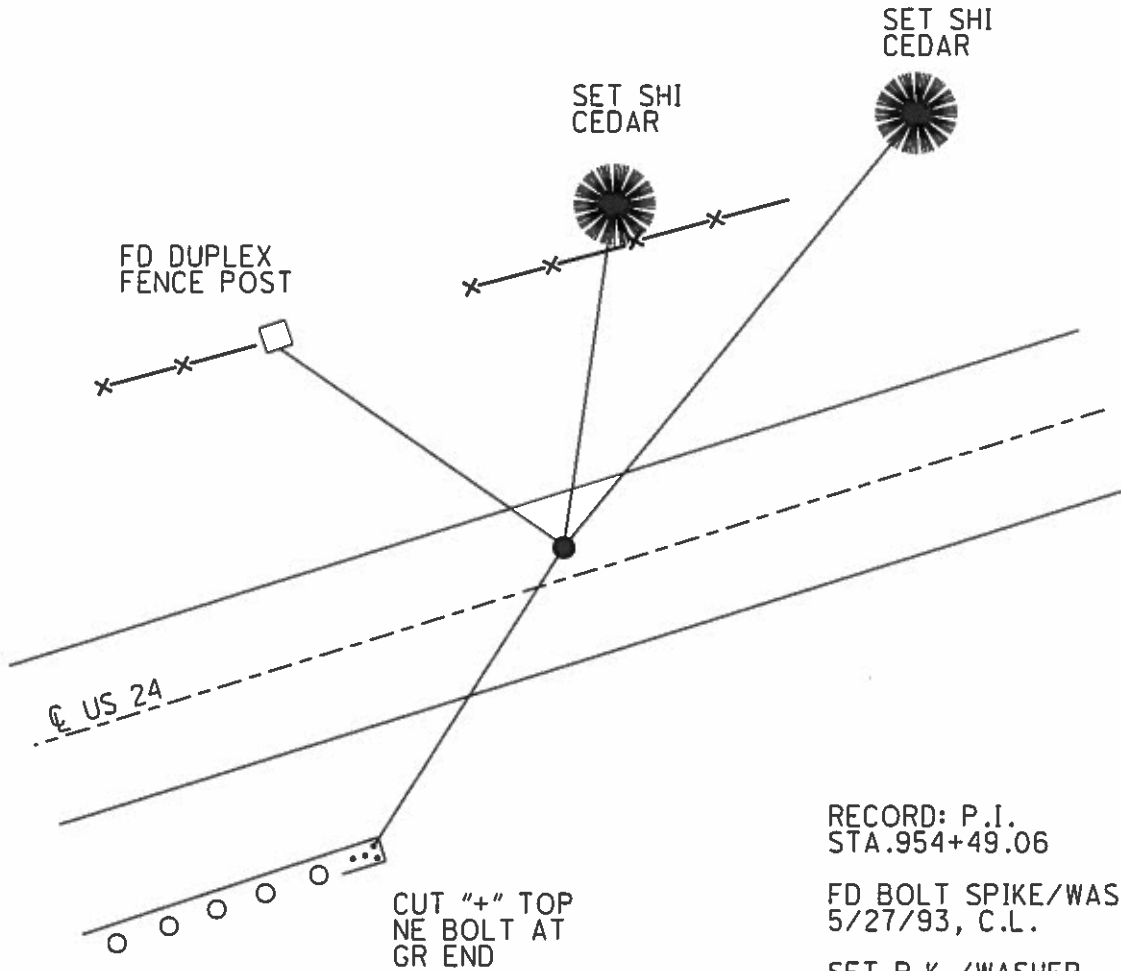


O.D.O.T. DISTRICT 2 SURVEY OFFICE (USE ONLY)

PERSONNEL	REFERENCE NO.	<u>28</u>	SHEET	<u>14</u>	OF	<u>40</u>
NOTES	DATE	<u>7/14/08</u>	ROUTE	<u>US 24</u>		
H.C. <u>HUSS</u>	WEATHER	<u>SUNNY</u>	COUNTY	<u>HENRY</u>		
R.C. <u>MOSER</u>	TEMP.	<u>75°</u>	TOWNSHIP	<u>WASHINGTON</u>		
			SECTION	<u>6</u>		
				<u>T 5 N</u>	<u>R 8 E</u>	

TYPE MONUMENT P.K.SHANK  
 ON SURFACE - ~~BELOW~~ ON \_\_\_\_\_  
 LEFT - ☉ PAV'T - ~~RIGHT~~ 3.5'  
8.6' TO LT EDGE PAVEMENT  
 S.L.M. 747+91  
 Grid: Northing: \_\_\_\_\_ Easting: \_\_\_\_\_

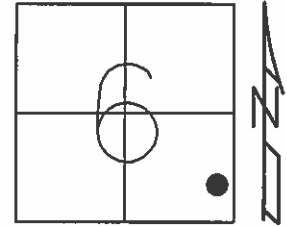

RECORD: P.I.  
 STA.954+49.06  
 FD BOLT SPIKE/WASHER  
 5/27/93, C.L.  
 SET P.K./WASHER  
 8/12/93, C.L.  
 FD P.K.SHANK  
 7/14/08, RN

# O.D.O.T. DISTRICT 2 SURVEY OFFICE

PERSONNEL

REFERENCE NO. 28

SHEET 16 OF 40

NOTES LOEHRKE

H.C. BARNHISEL

R.C. CANTERBURY

Newell

DATE 5-27-93

WEATHER Nice

TEMP. +50

Set P.K./WASHER  
8-12-93

ROUTE U.S. 24

COUNTY Henry

TOWNSHIP Washington

SECTION 6

T. 5 NR. 8 E



TYPE MONUMENT Bolt Spike / WASHER

ON SURFACE - BELOW Yes

LEFT-~~X~~ PAV'T. - RIGHT 3.2

B.B. TO Lt EDGE PAVEMENT

S.L.M. 747+91 14.16

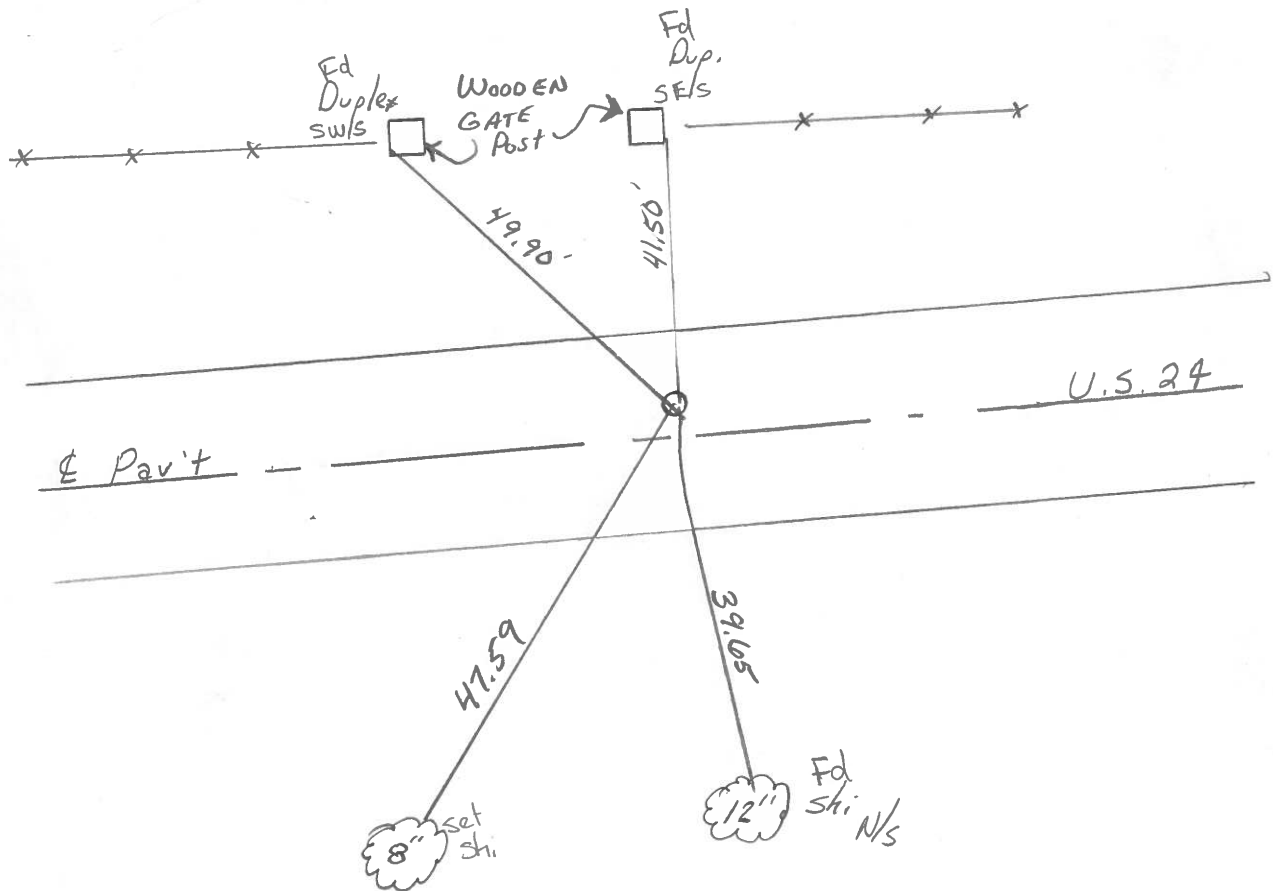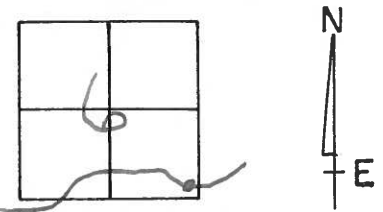

P.I. STA. 954 + 49.06 Rec.

O.D.O.T. DISTRICT 2 SURVEY OFFICE

SHEET 16 OF

County HENRY S.R.-U.S. 24

Date 6-2-81

Township WASHINGTON

Weather OVERCAST

Section 6

Temp. +78°


T5N, R8E

Personnel HOFFMAN

Loehrke

HOFFMAN


28

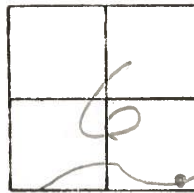

Fd. P.K. 3" Below surface  
 11.6' TO N. Edge PAUT  
 18.7' TO S. Edge PAUT  
 3.2' N. OF  $\Phi$

PROJECT STA.  $\pm$  944+62


SET 3" BOAT SPR./WASHER  
 9-17-81  
 SWH

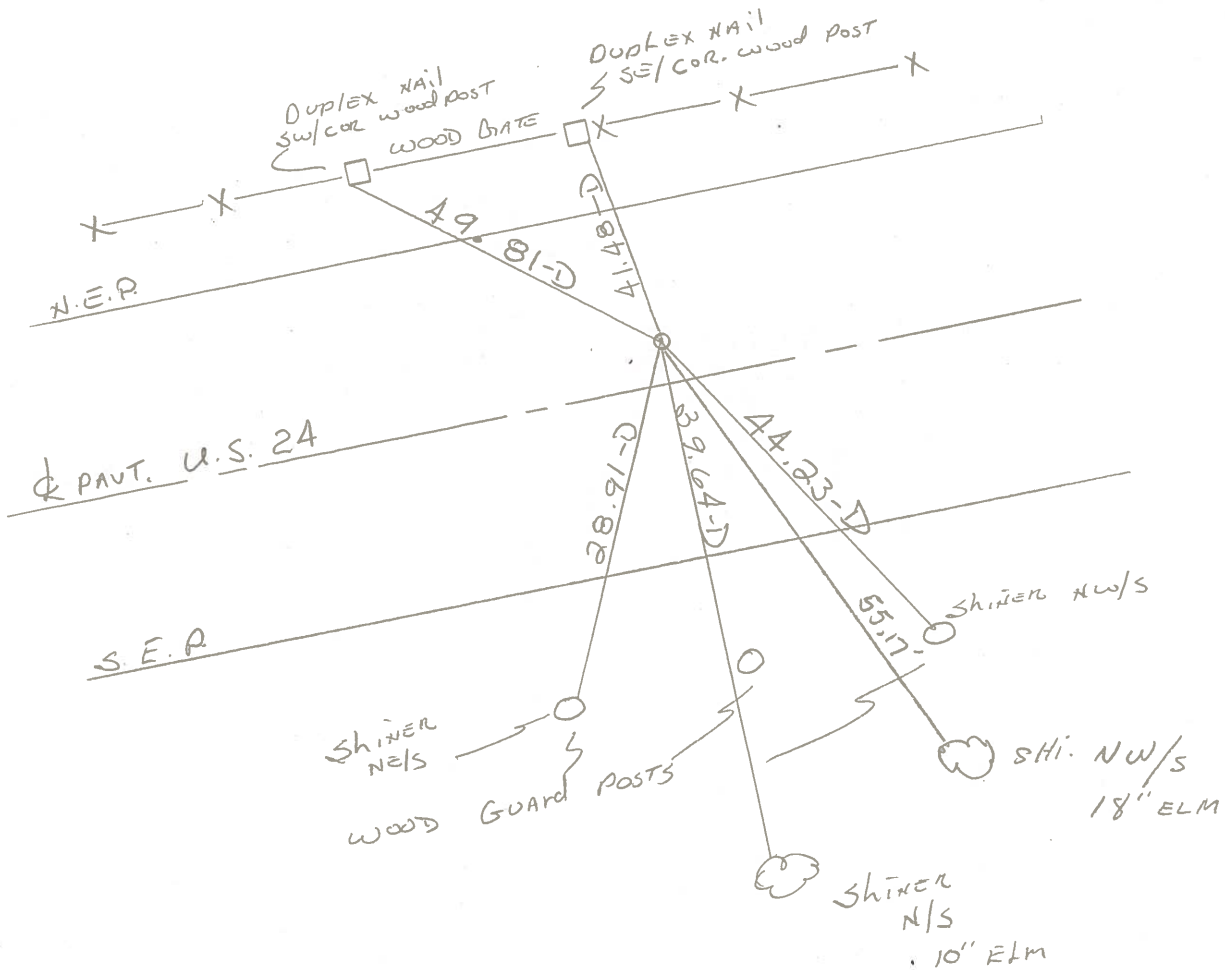

P.I. STA 954+49.06 REC.

PERSONNEL	TITLE	PERSONNEL	TITLE	COUNTY	DATE	WEATHER	TEMP.
Tomsic				HEN.	JUNE 27, 1975		
Granata				S. R. 24			
				SEC.			

DESCRIPTION \_\_\_\_\_ LEFT \_\_\_\_\_ CENTER LINE \_\_\_\_\_ RIGHT \_\_\_\_\_ JOB NO. \_\_\_\_\_

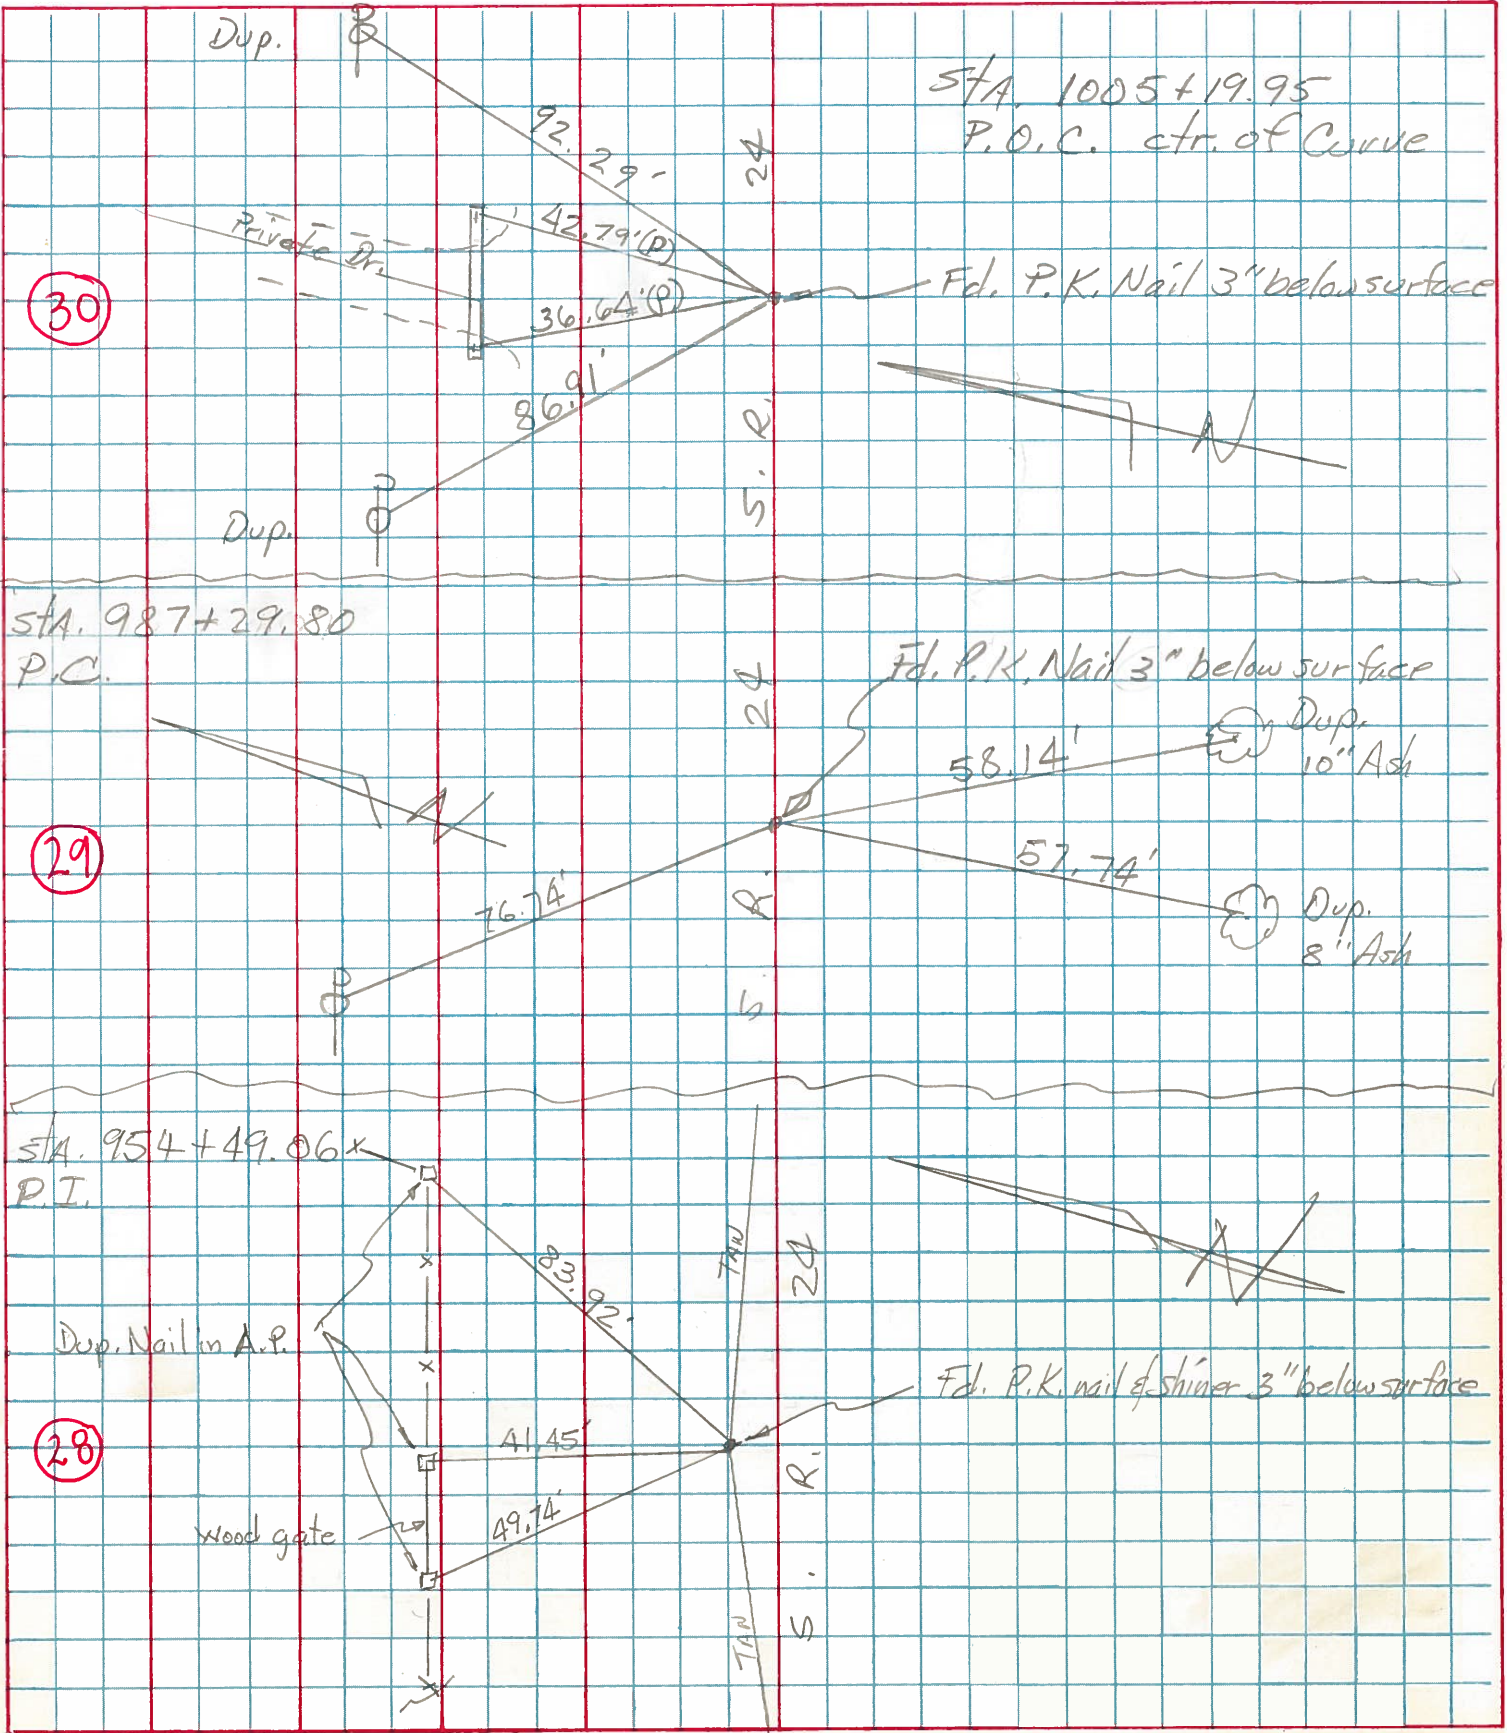



PERSONNEL TITLE PERSONNEL TITLE

Silvester

COUNTY \_\_\_\_\_

DATE \_\_\_\_\_

S. R. 45 24

WEATHER \_\_\_\_\_

SEC. \_\_\_\_\_

TEMP. \_\_\_\_\_

DESCRIPTION *Curve Data & witness ties*

LEFT

CENTER LINE

RIGHT

JOB NO. \_\_\_\_\_

LEFT		CENTER LINE	RIGHT
		CURVE #	16
P.I. Sta	954+		
P.C. Sta	951+24.07		Iron fence Post N.N.W. 41.08
P.T. Sta	957+79.03	P.I. wit	Shiner Elm Tree S. 63.08
A =	20 N' R+	"	15' Poplar S.E. 55.10
Dc =	0° 30'		
T =	324.99		
L =	655.00		
R =	17188.8		
E =	3.12		
		P.C. wit	Iron fence Post W. 6.45
			Shiner in P.P. e N.W. 4.93
			Iron fence Post N.E. 51.35
		J. wit	Shiner in P.P. e N.W. 4.68
			Shiner in 8' E. N. S. 8.82
			" " " " 6.80.59