


O.D.O.T. DISTRICT 2 SURVEY OFFICE (USE ONLY)


PERSONNEL \_\_\_\_\_ REFERENCE NO. 38 SHEET 25 OF 40  
 NOTES NUHFER DATE 7/14/08 ROUTE US 24  
 H.C. HUSS WEATHER SUNNY COUNTY HENRY  
 R.C. MOSER TEMP. 75° TOWNSHIP WASHINGTON  
 \_\_\_\_\_ SECTION 4  
 \_\_\_\_\_ T 5 N R 8 E

TYPE MONUMENT P.K./WASHER  
 ON SURFACE - ~~BELOW~~ ON \_\_\_\_\_  
 LEFT - ☉ PAV'T - ~~RIGHT~~ 0.3'  
12.3' TO RT EDGE PAVEMENT  
 S.L.M. 861+68

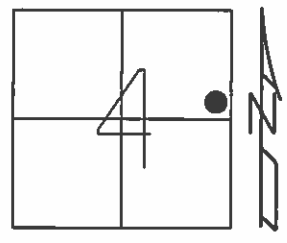

Grid: Northing: \_\_\_\_\_ Easting: \_\_\_\_\_

RECORD: S.T.  
 STA.1068+26.99  
 FD SM.R.R.SPIKE  
 5/27/93, C.L.  
 SET P.K./WASHER  
 7/8/93, C.L.  
 FD P.K./WASHER  
 7/11/08, RN

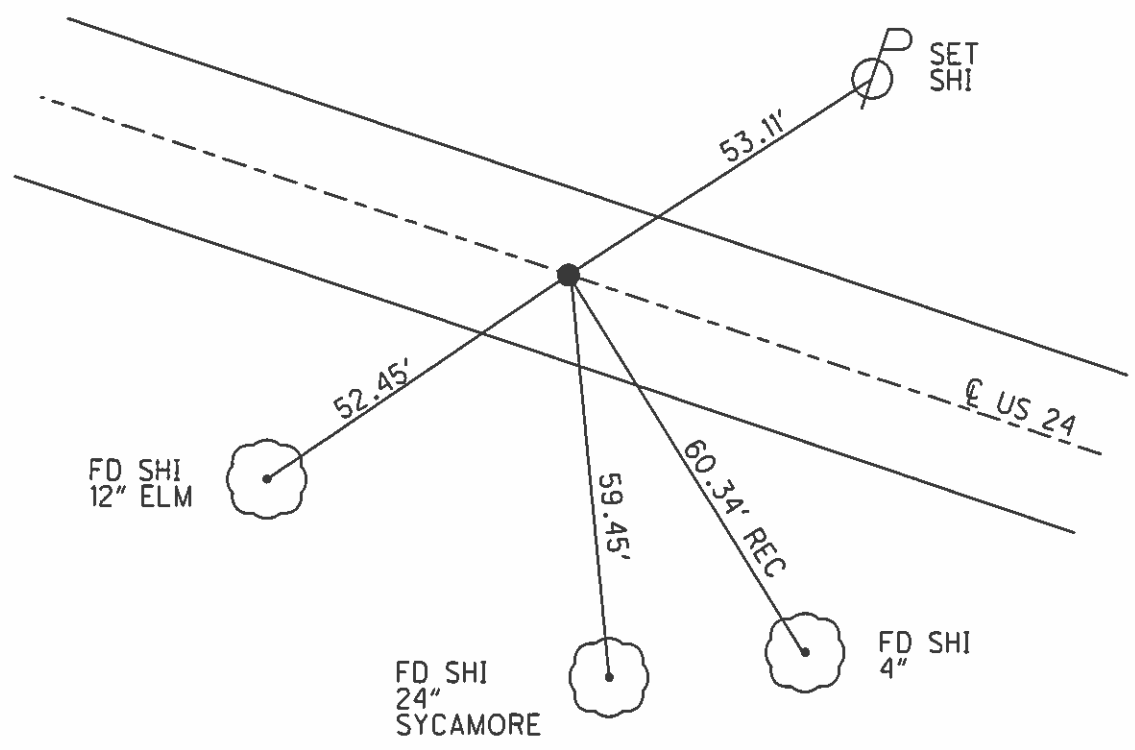

O.D.O.T. DISTRICT 2 SURVEY OFFICE

PERSONNEL

REFERENCE NO. 38

SHEET 26 OF 40

NOTES LOEHRKE

H.C. BARNHISEL

DATE 5-27-93

ROUTE U.S. 24

R.C. CANTERBURY

WEATHER Pt Cloudy

COUNTY Henry

Newell

TEMP. +62

TOWNSHIP Washington

SECTION 4

T 5 N R 8 E

TYPE MONUMENT Sm. RR Spk Set P.K./WASHER

ON SURFACE - ~~BELOW~~ yes



7-8-93

~~LEFT - C~~ PAV'T. - ~~RIGHT~~ yes

C.I.

12.3 TO RT EDGE PAVEMENT

S.L.M. 89 + 68 16.32

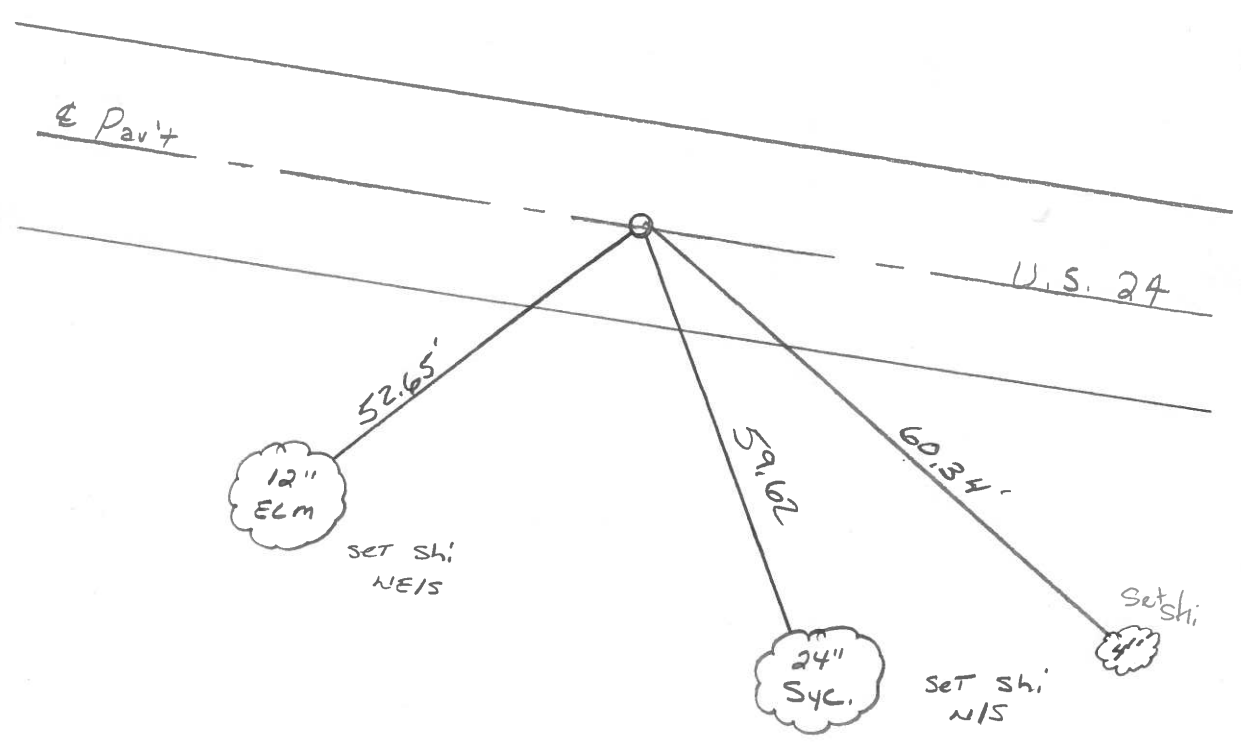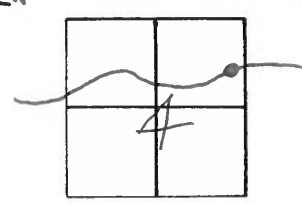

S.T. STA. 1068 + 26.99 Rec.

O.D.O.T. DISTRICT 2 SURVEY OFFICE

SHEET 26 OF

County HENRY S.R. -U.S. 24

Date 6-3-81

Township WASHINGTON

Weather Cloudy

Section 4

Temp. +78°


T5N, R8E

Personnel HOFFMAN

Loehrke

Householder

38

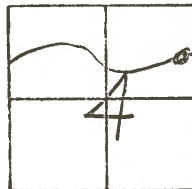


N

Fd. P.K. 3" Below Surface  
@ CTR of PAVT

PROJECT STA. ± 1058 + 41


SET SMALL R.R. SPK. 9-17-81 SWH

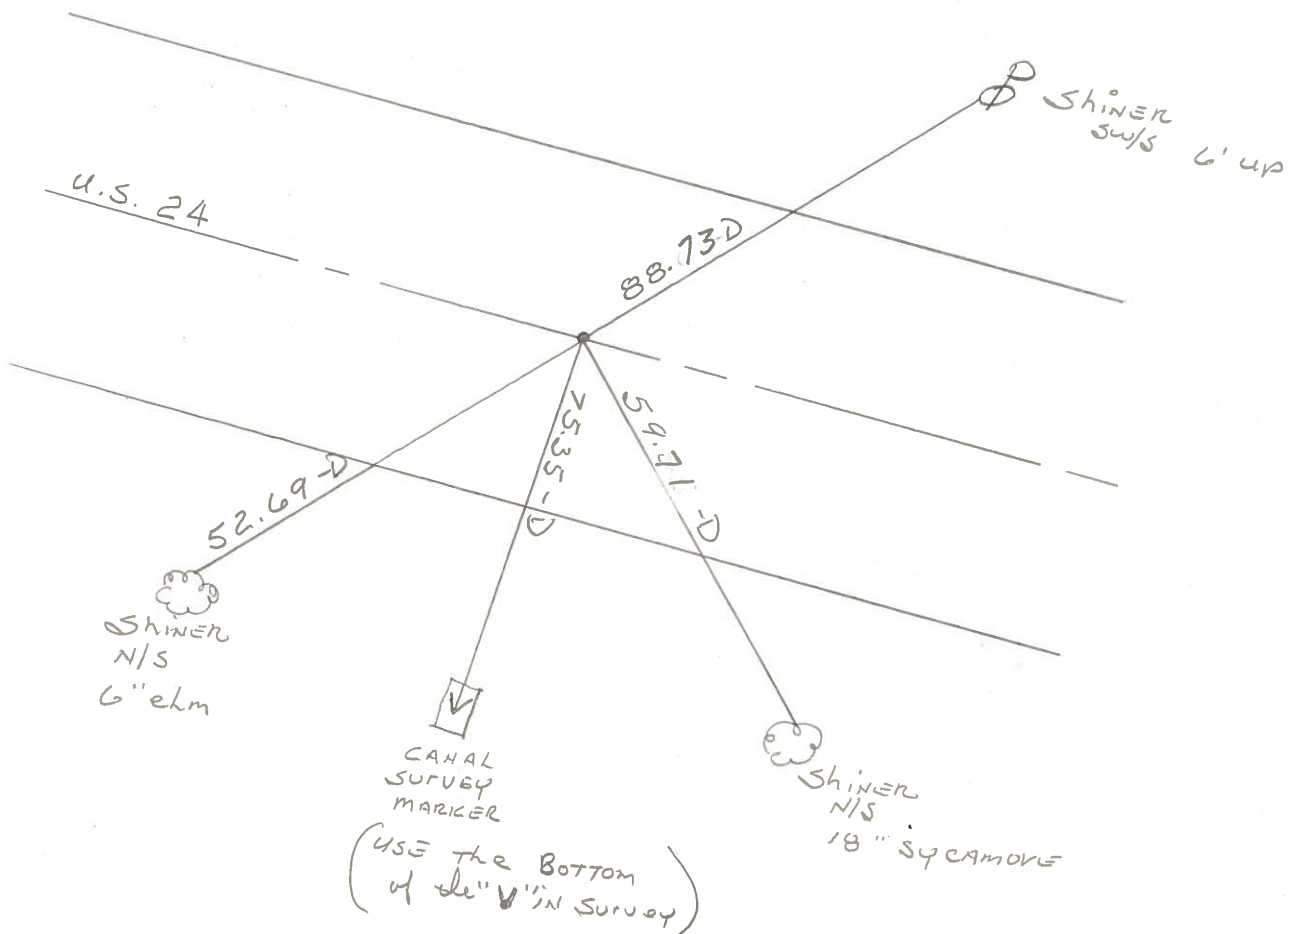

CAHAL SURVEY MARKER  
(USE THE BOTTOM of the 'V' in Survey)

S.T. STA. 1068+26.99 REC.

PERSONNEL	TITLE	PERSONNEL	TITLE	COUNTY	DATE	WEATHER	TEMP.
<u>Tom, S.K.</u>				<u>HEN.</u>	<u>July 6, 1975</u>		
<u>Neuser</u>				<u>24</u>			
<u>Granata</u>							

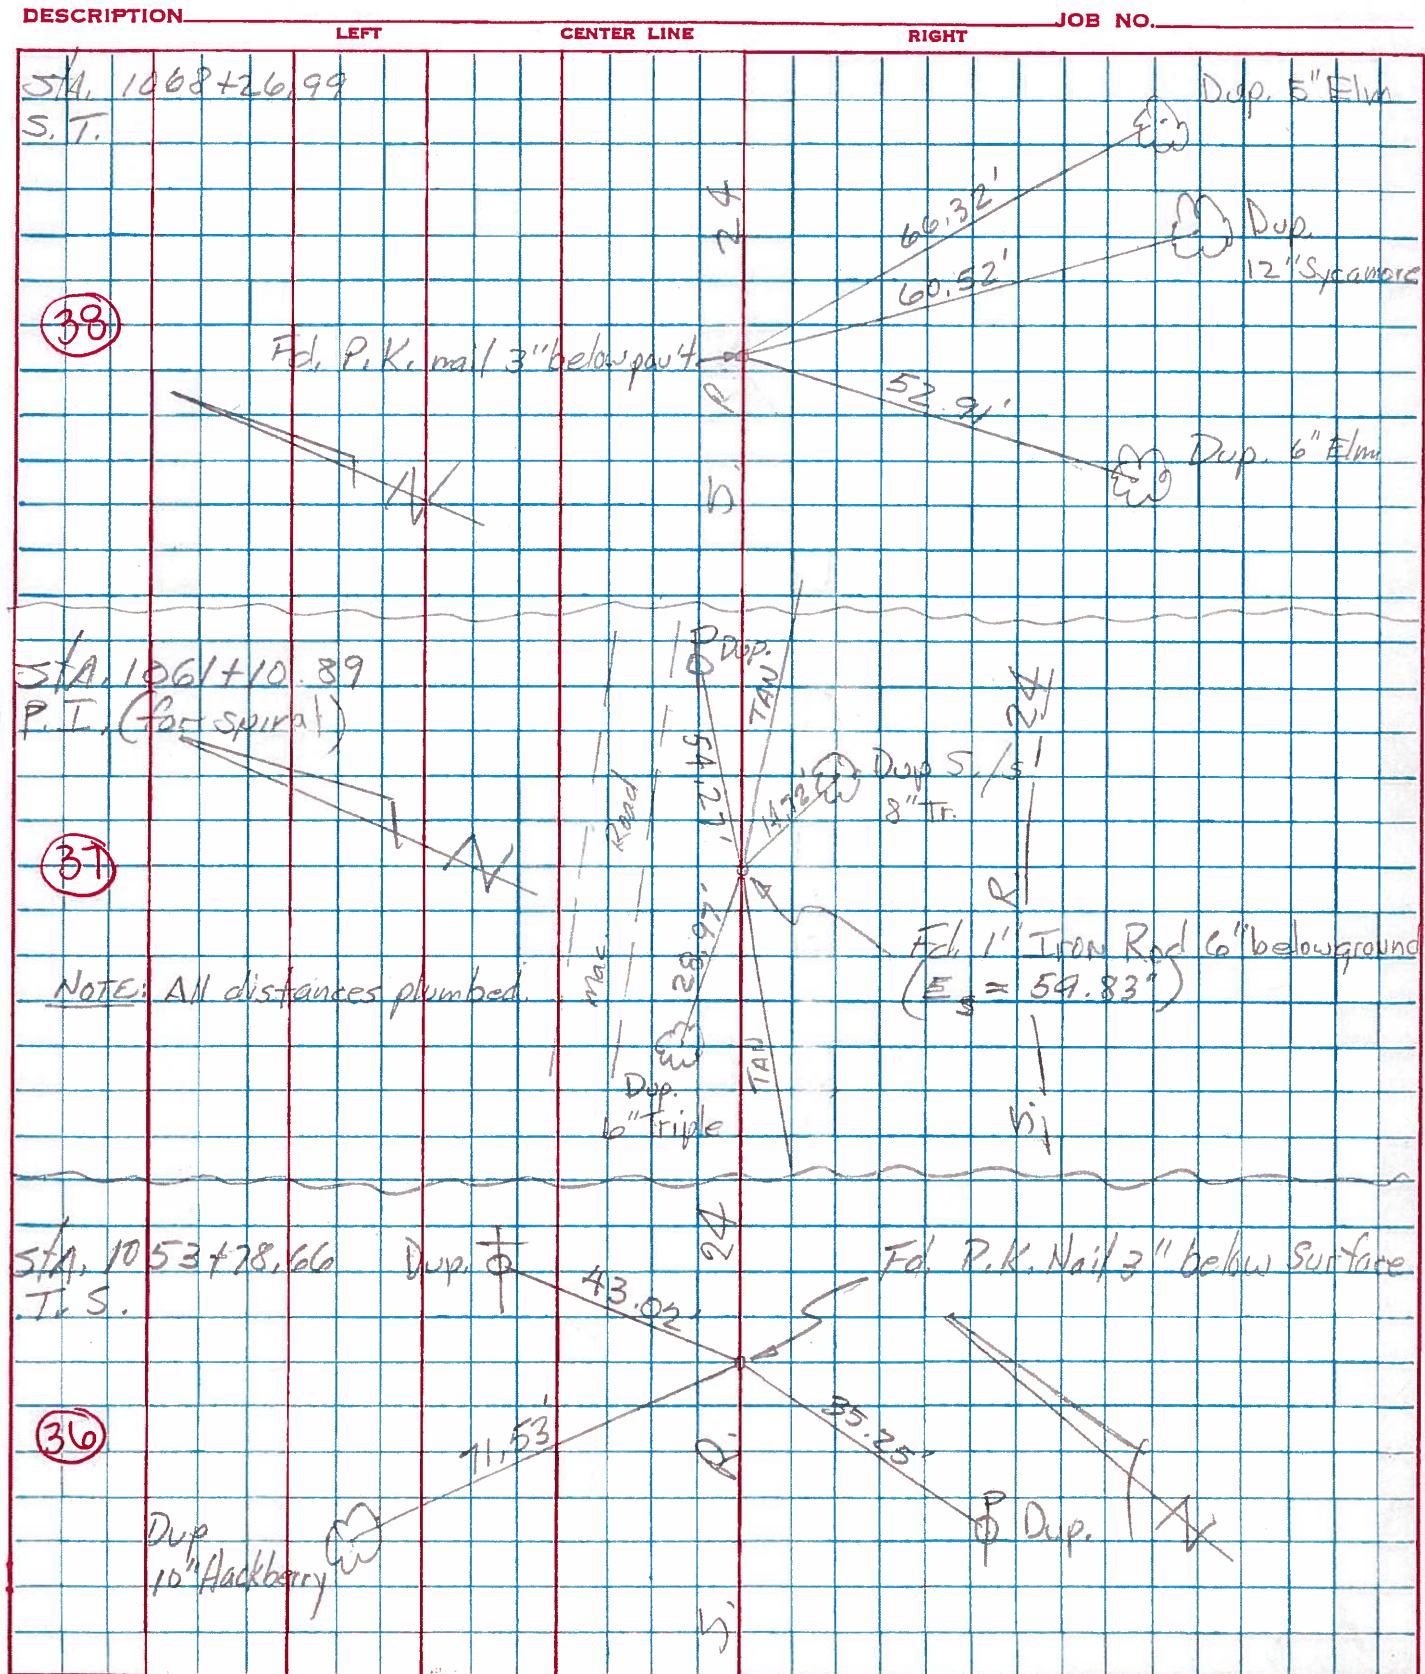



PERSONNEL	TITLE	PERSONNEL	TITLE	COUNTY	DATE	WEATHER	TEMP.
Beach				Henry	1 May 59		
Ruffer				US-24			
Knape							
Delventhal				11.22			

DESCRIPTION ± constr. JOB NO. \_\_\_\_\_

