

O.D.O.T. DISTRICT 2 SURVEY OFFICE (USE ONLY)

PERSONNEL _____ REFERENCE NO. 46 SHEET 33 OF 40

NOTES HUSS DATE 7/28/08 ROUTE US 24
H.C. MOSER WEATHER CLEAR COUNTY HENRY
R.C. CANTERBURY TEMP. 80° TOWNSHIP WASHINGTON
SECTION 1
T 5 N R 8 E

TYPE MONUMENT P.K./WASHER


ON SURFACE - ~~BELOW~~ ON _____

LEFT - ☉ PAV'T - RIGHT ON _____

11.5' TO RT EDGE PAVEMENT

S.L.M. 974+70


Grid: Northing: _____ Easting: _____

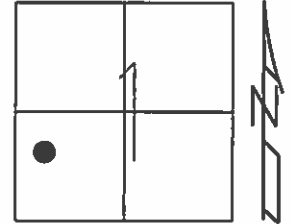

RECORD: P.T.
STA. 1181+35.45

FD SM.R.R.SPIKE
5/27/93, C.L.

SET P.K./WASHER
9/17/93, C.L.

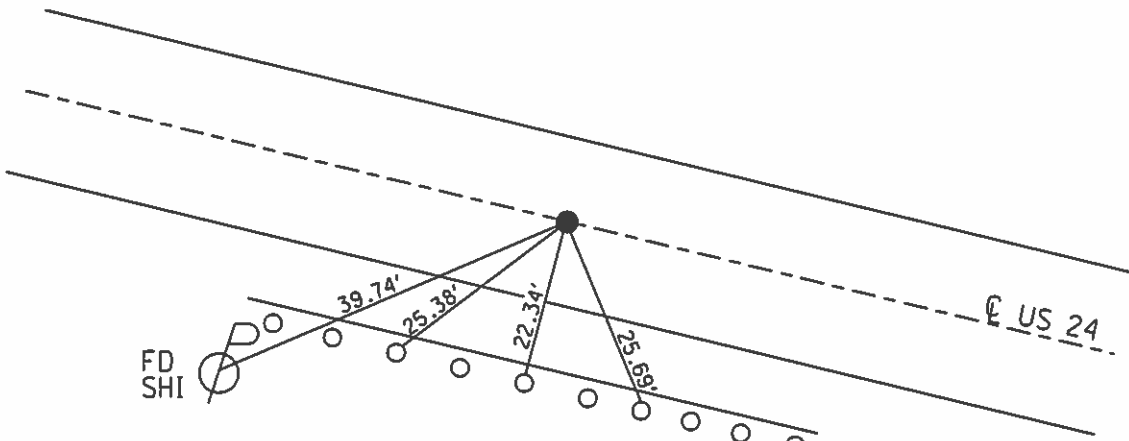

SET SHI'S
IN GR.POSTS

O.D.O.T. DISTRICT 2 SURVEY OFFICE

PERSONNEL

REFERENCE NO. 46

SHEET 32 OF 40

NOTES LOEHRKE

H.C. ROMETO

DATE 5-27-93

ROUTE U.S. 24

R.C. CANTERBURY

WEATHER Cloudy

COUNTY Henry

BARNHISEL

TEMP. +72

TOWNSHIP Washington

Set P.K./WASHER

SECTION 1

9-17-93

T 5 N R 8 E

CL



TYPE MONUMENT Sm. R.R. Spike

ON SURFACE - BELOW Yes

LEFT - ~~C~~ PAV'T. - RIGHT 0.6

N/2 TO R/4 EDGE PAVEMENT

S.L.M. 974+ 70 18.46

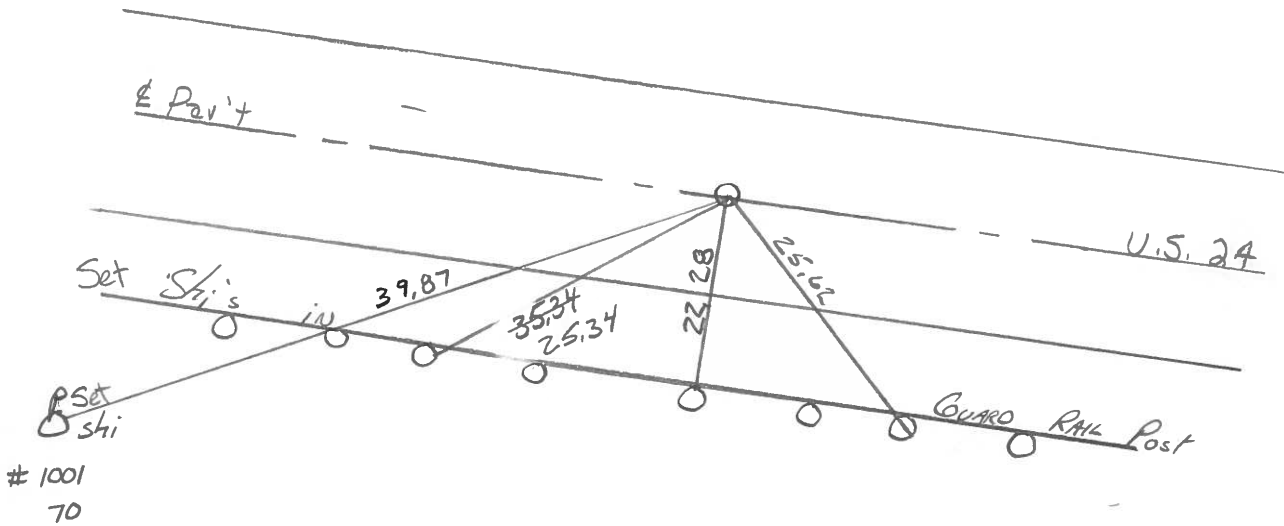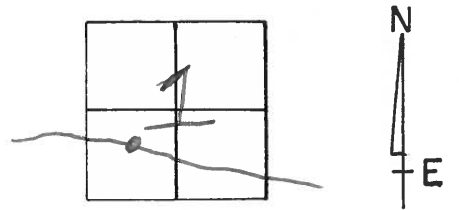

P.T. STA. 1181+35.45 Rec.

County HENRY S.R.-U.S. 24

Date 6-4-81

Township WASHINGTON

Weather clear

Section 1

Temp. +80°


T5N, R8E

Personnel HOFFMAN

Loehrke

Householder

46

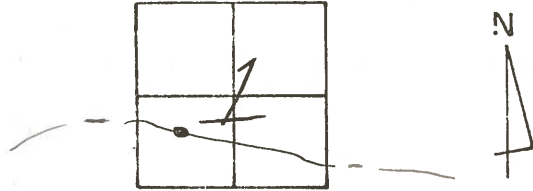

Fd. P.K. Nail 3" below surface @ ctr. of PAVT.

PROJECT STA. ± 1171+49

.60 S. of E

SET SMALL R.R. SPR.


15.6 TO N.E.P.

9-21-81

14.2 TO S.E.P.

SWK

Shiner 3/5

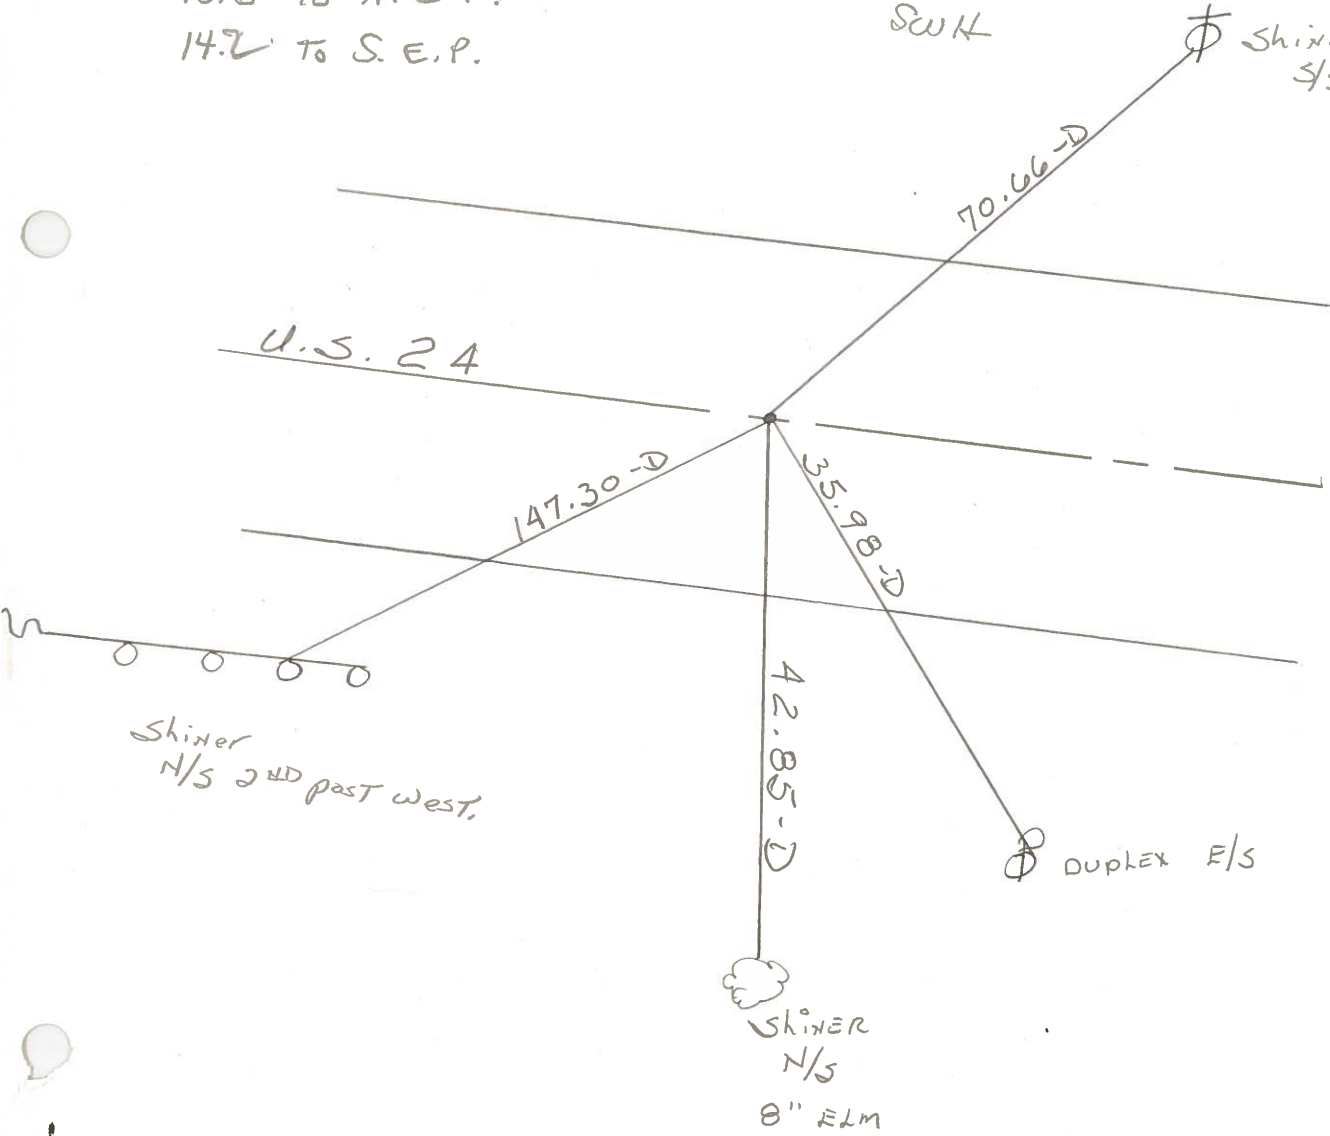

U.S. 24

147.30-D

42.85-D

Shiner N/S 2nd past west

Shiner N/S 8" ELM

P.T. STA. 1181+35.45 REC.


PERSONNEL	TITLE	PERSONNEL	TITLE
Tomsic			
Neuser			
Granata			
Curtis			

COUNTY HEN. DATE JULY 14, 1975

S. R. 24 WEATHER

SEC. TEMP.

DESCRIPTION LEFT CENTER LINE RIGHT JOB NO.

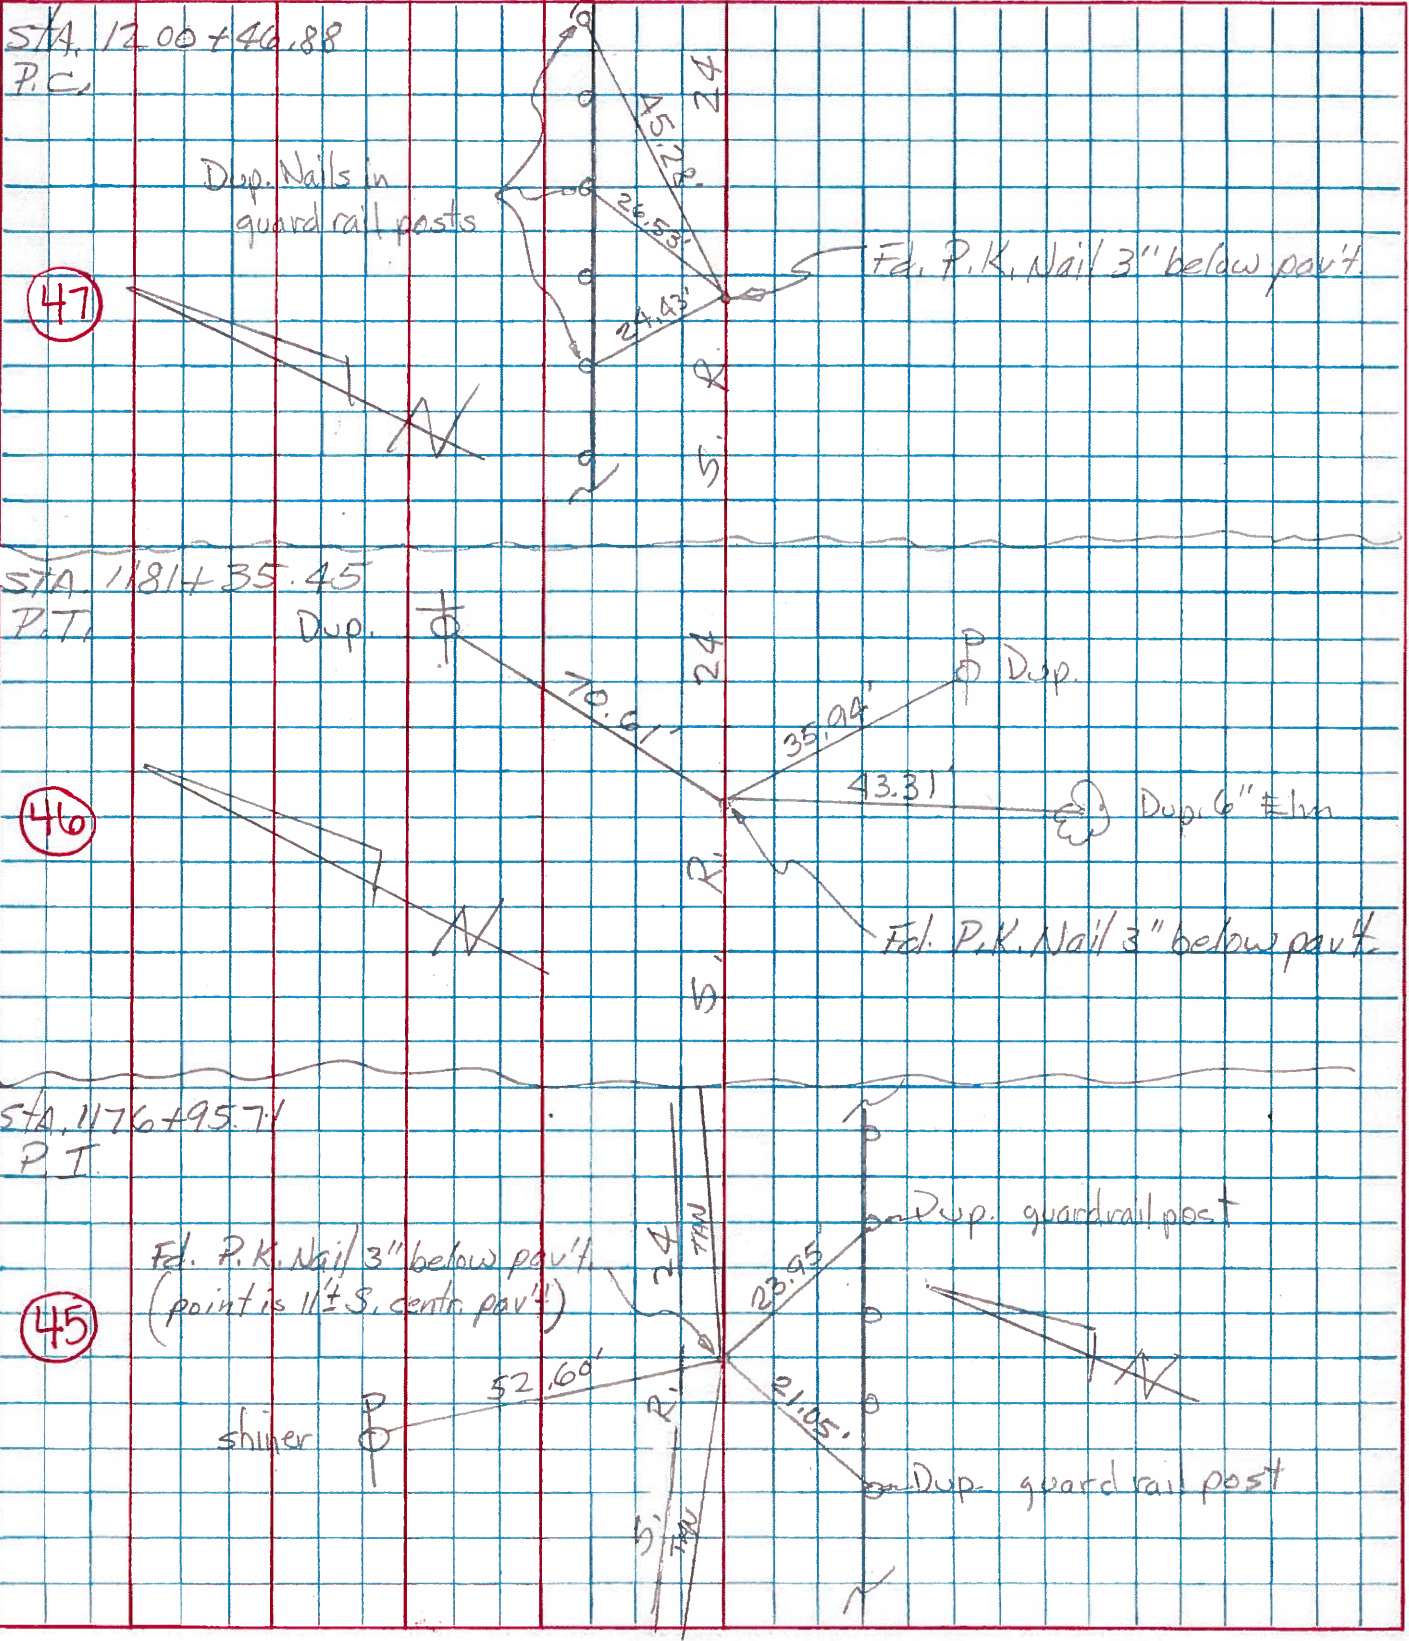

PERSONNEL TITLE PERSONNEL TITLE

Silvester

COUNTY *Henry*

DATE _____

S. R. *24*

WEATHER _____

SEC. _____

TEMP. _____

DESCRIPTION *Curve Data of witness ties*

LEFT

CENTER LINE

RIGHT

JOB NO. _____

CURVE #

25

P.H. Sta. 1176 + 95.71

P.G. Sta. 1172 + 55.45

P.T. Sta. 1181 + 35.45

A = 424' ±

Dc = 0° 30'

T = 440.26

L = 880.00

R = 11,459.16

E = 8.75

P.L. wit

Shiner in P. Pole N.W. 52.67

Shiner in T. Pole N. 77.57

Shiner in 15" Elm N.N.E. 72.80

P.G. wit

Shiner in P. Pole N.W. 90.27

" " 12" Elm N. 69.41

" " " " N.E. 79.44

P.T. wit

Shiner in 10" Elm S.S.W. 40.12

Shiner in 12" Elm S.S.E. 52.17