


O.D.O.T. DISTRICT 2 SURVEY OFFICE (USE ONLY)

PERSONNEL _____ REFERENCE NO. 47 SHEET 34 OF 40
 NOTES HUSS DATE 7/28/08 ROUTE US 24
 H.C. MOSER WEATHER CLEAR COUNTY HENRY
 R.C. CANTERBURY TEMP. 80° TOWNSHIP WASHINGTON
 _____ SECTION 1
 _____ T 5 N R 8 E

TYPE MONUMENT P.K./WASHER
 ON SURFACE - ~~BELOW~~ ON _____
 LEFT - ☉ PAV'T - ~~RIGHT~~ 9.3'
3.0' TO LT EDGE PAVEMENT
 S.L.M. 988+79

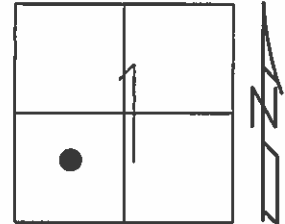


Grid: Northing: _____ Easting: _____

SOURCE UNKNOWN

FD P.K.SHANK
 6/1/93, C.L.

SET P.K./WASHER
 9/17/93, C.L.

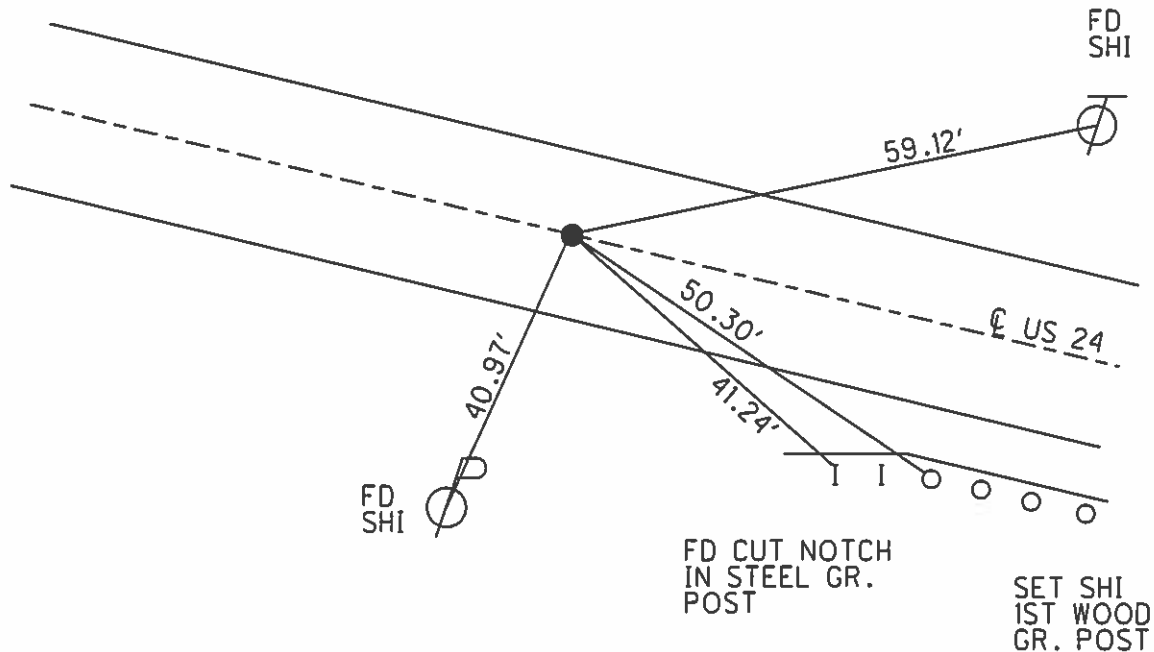

O.D.O.T. DISTRICT 2 SURVEY OFFICE

PERSONNEL

REFERENCE NO. 47

SHEET 32A OF 40

NOTES LOEHKE

H.C. ROMETO

R.C. CANTERBURY

BARNHISEL

DATE 6-1-93

WEATHER Clear

TEMP. +58

Reset P.K./WASHER
9-17-93

ROUTE U.S. 24

COUNTY HENRY

TOWNSHIP WASHINGTON

SECTION 1

T. S N. R & E


TYPE MONUMENT P.K. Shank

ON SURFACE - BELOW Yes


LEFT - ☐ PAV'T. - RIGHT 9.3

S.C. TO Lt EDGE PAVEMENT

S.L.M. 988+79 18.73

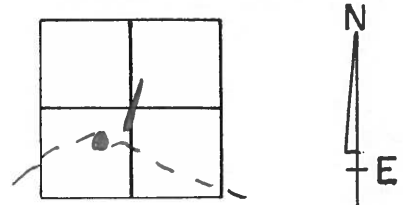

Source Unknown

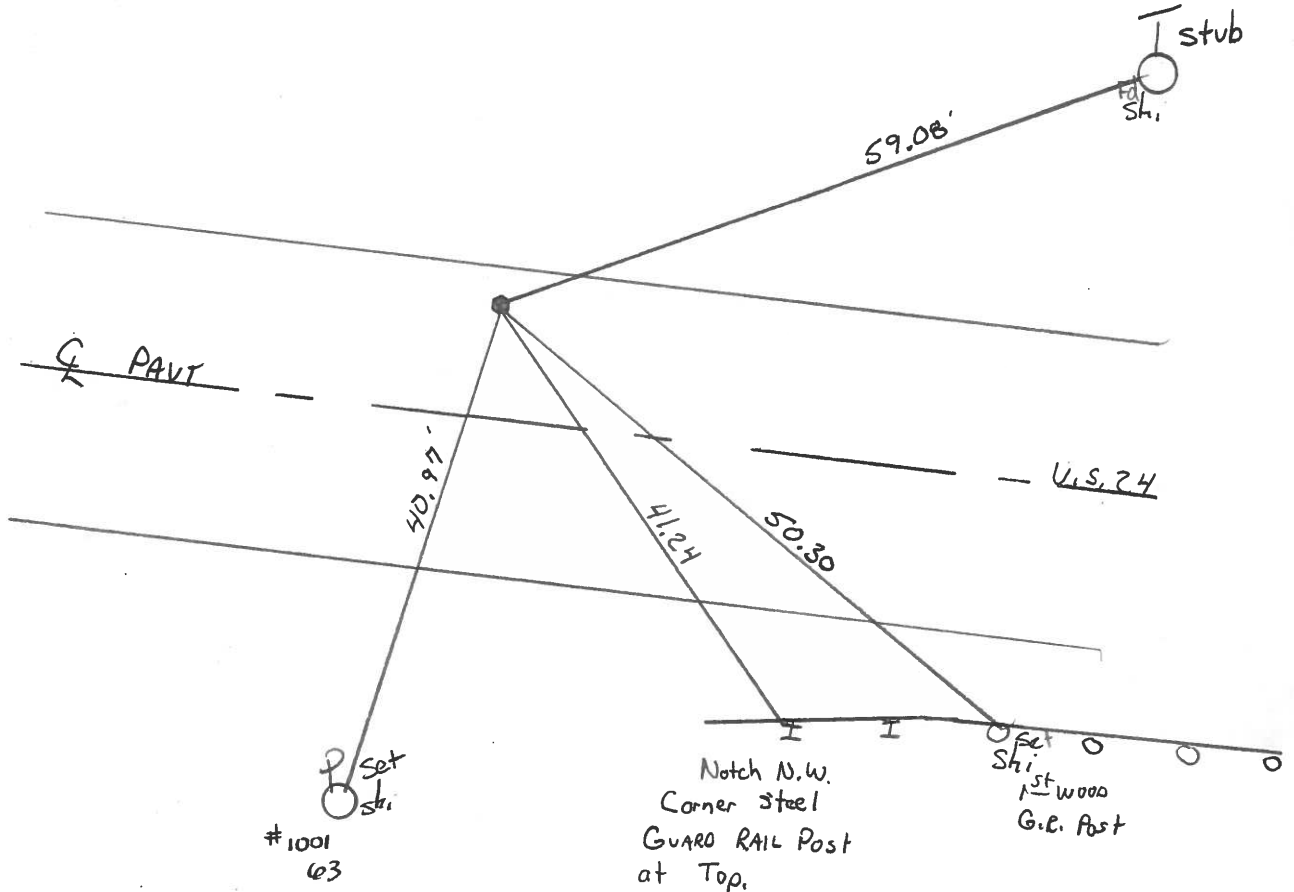

O.D.O.T. DISTRICT 2 SURVEY OFFICE

SHEET 32 A OF

County HENRY S.R.-U.S. 24

Date 6-8-81

Township Washington

Weather Cloudy

Section 4

Temp. +80°


T5N, R8E

Personnel HOFFMAN


Loehrke

Householder

47

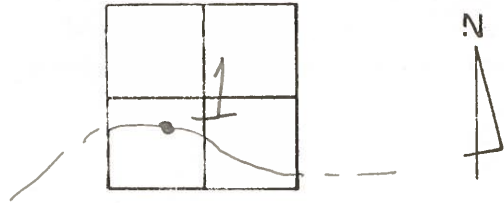

Fd. P.K. @ SURFACE PROJECT STA. ± 1186 + 54
 IN CTR. of ^{white} \perp ; FOR AERIAL PHOTOGRAPHY SOURCE UNKNOWN
 6.0' TO N. EDGE PAUT
 24.0' TO S. EDGE PAUT
 8.95 N. OF \perp SET P.K./WASHER 9-21-81
 SWK

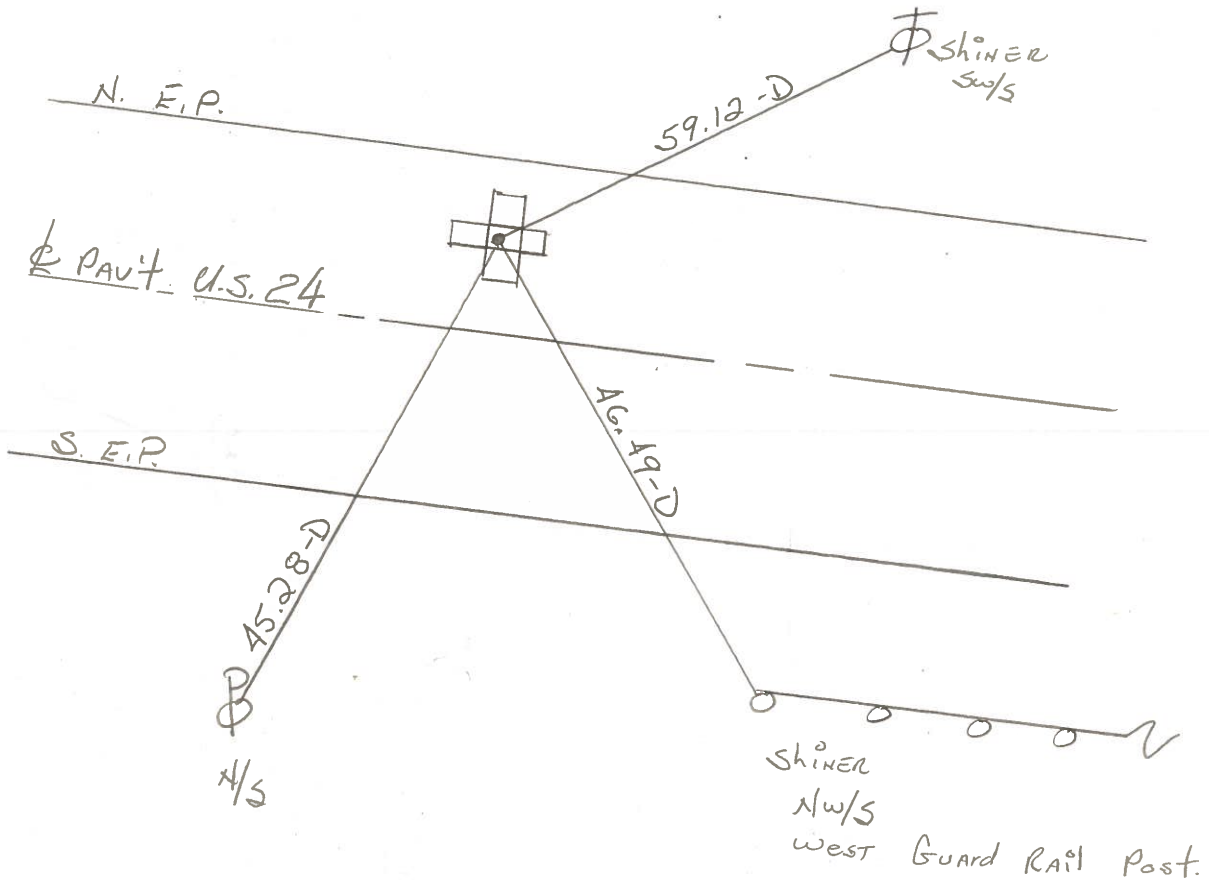

P.C. STA. 1200 + 46.88 - REC.

PERSONNEL	TITLE	PERSONNEL	TITLE	COUNTY	DATE
TOMASIC				HEN.	JULY 14, 1975
Neuser				S. R.	24
Granata				SEC.	
Curtis				WEATHER	
				TEMP.	

DESCRIPTION	LEFT	CENTER LINE	RIGHT	JOB NO.
-------------	------	-------------	-------	---------

