


O.D.O.T. DISTRICT 2 SURVEY OFFICE (USE ONLY)

PERSONNEL _____ REFERENCE NO. 50 SHEET 38 OF 40
 NOTES HUSS DATE 7/28/08 ROUTE US 24
 H.C. MOSER WEATHER FAIR COUNTY HENRY
 R.C. CANTERBURY TEMP. 80° TOWNSHIP WASHINGTON
 _____ SECTION 1
 _____ T 5 N R 8 E

TYPE MONUMENT P.K./WASHER
 ON SURFACE - ~~BELOW~~ ON
 LEFT - Q PAV'T - RIGHT ON
11.9' TO LT EDGE PAVEMENT
 S.L.M. 1004+39

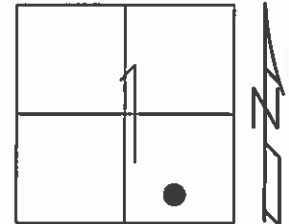


Grid: Northing: - Easting: -

RECORD: P.T.
 STA. 1211+01.88

FD SM.R.R.SPIKE
 6/1/93, C.L.

SET P.K./WASHER
 9/17/93, C.L.

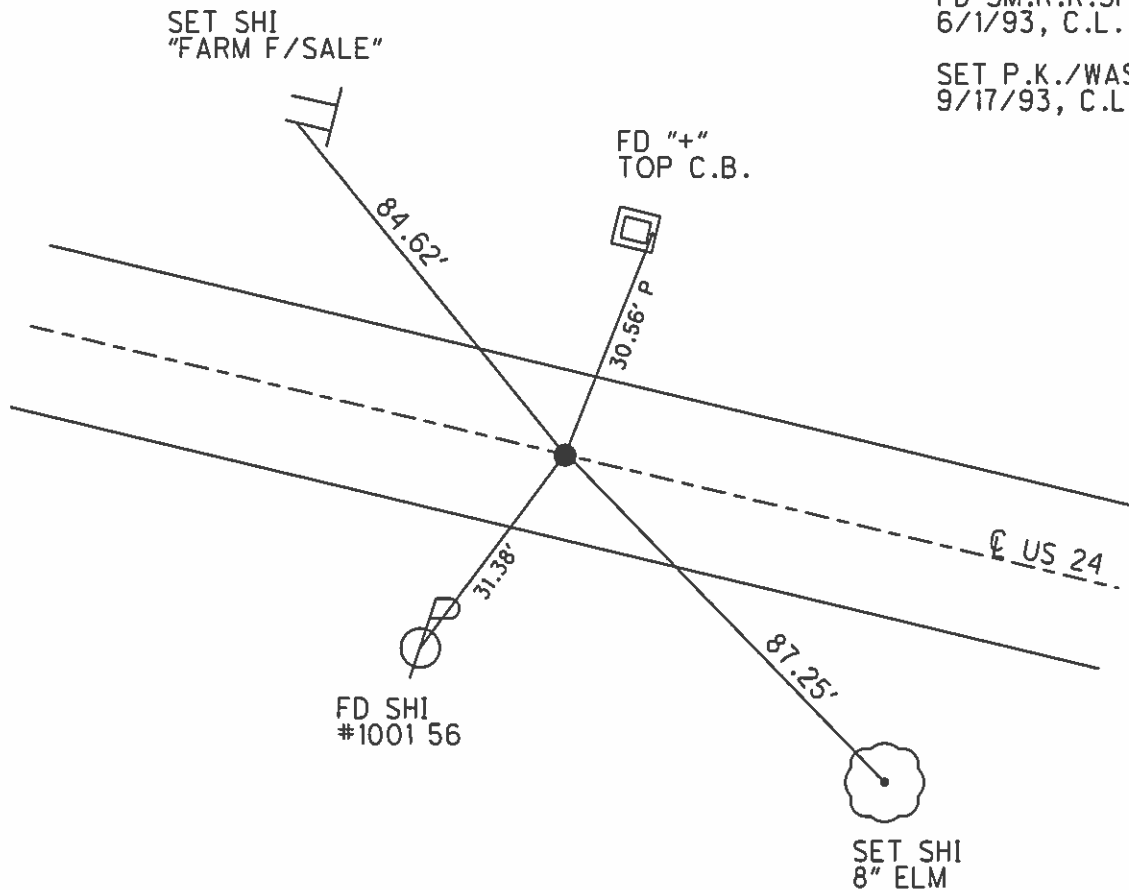

O.D.O.T. DISTRICT 2 SURVEY OFFICE

PERSONNEL

REFERENCE NO. 50

SHEET 35 OF 40

NOTES LOEHRKE

H.C. ROMERO

DATE 6-1-93

ROUTE U.S. 24

R.C. CANTERBURY

WEATHER Clear

COUNTY Henry

BARN HISEL

TEMP. +60
Set P.K./WASHER
9-17-93

TOWNSHIP Washington

SECTION 1

T 5 N R 8 E



TYPE MONUMENT Sm. R.R. Spike

ON SURFACE - ~~BELOW~~ Yes

LEFT-~~C~~ PAV'T. - RIGHT 0.3

TO Lt EDGE PAVEMENT

S.L.M. 1004+39 19.62

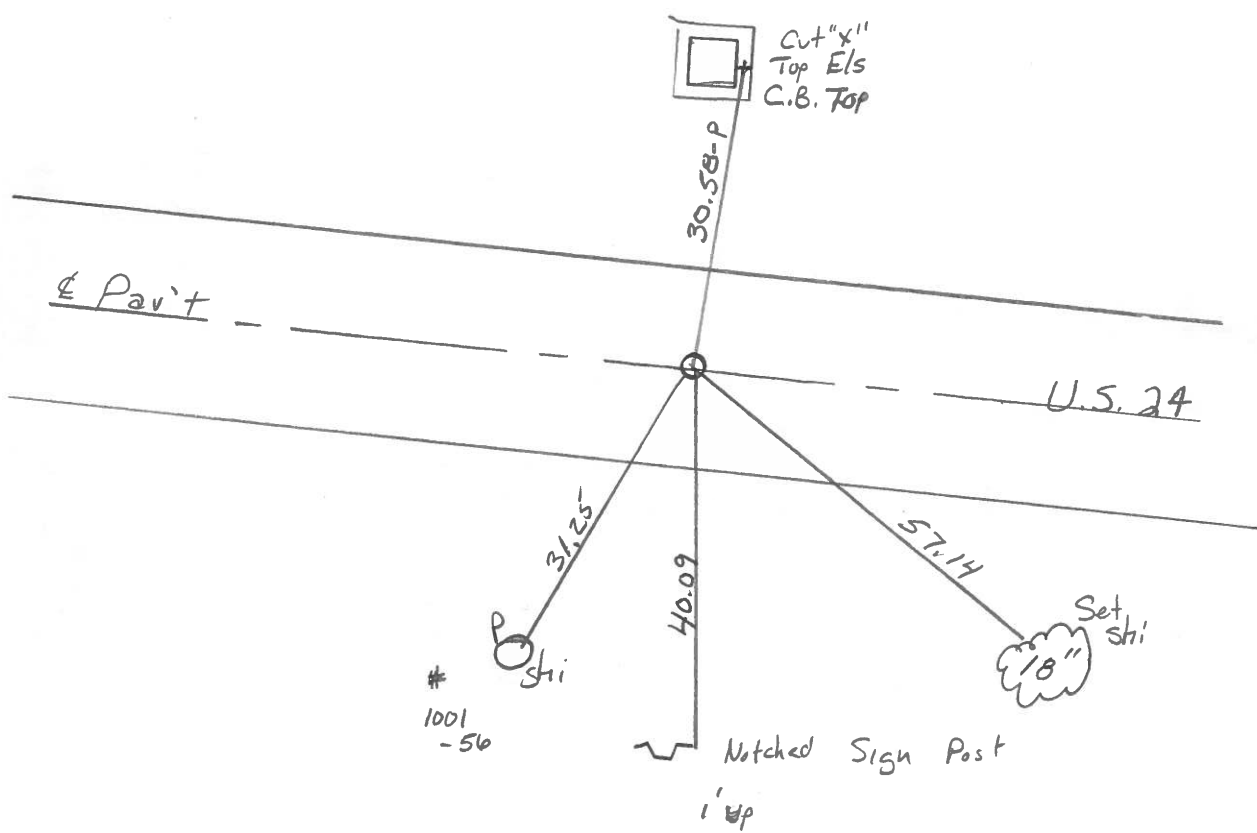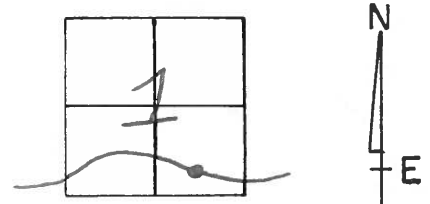

P.T. STA. 1211+01.88 Rec.

O.D.O.T. DISTRICT 2 SURVEY OFFICE

SHEET 35 OF

County HENRY S.R.-U.S. 24

Date 6-9-81

Township WASHINGTON

Weather clear

Section 1

Temp. +70°


T5N, R8E

Personnel HOFFMAN

Loehrke

Householder

(50)

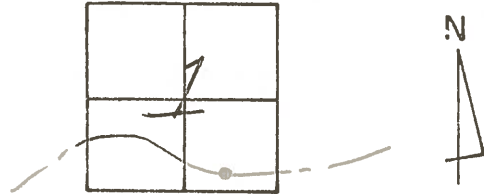

Fd. P. K. 3" Below Surface
@ ctr. of pavt.

PROJECT STA ± 1201 + 16

14.7 To N.E.P.


SET SMALL RR. SAK.

0.5. N of E

9-21-81

13.6 S. E.P.

SWH

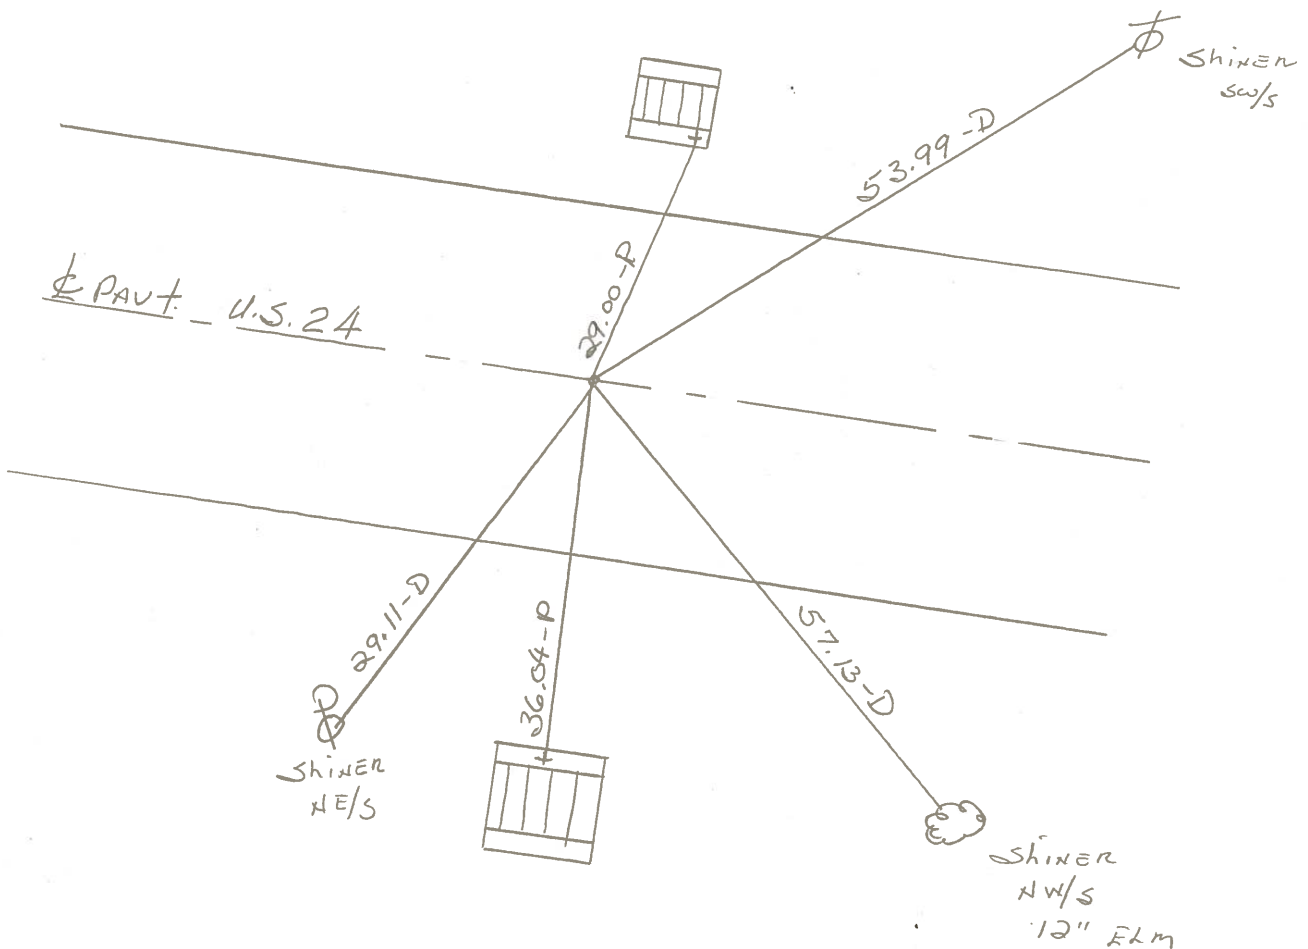

P. T. STA. 1211.01.88 - REC.

PERSONNEL	TITLE	PERSONNEL	TITLE
Tamsic			
Neuser			
Grana fa			
Curtis			

COUNTY HEN.

DATE JULY 16, 1975

S. R. 24

WEATHER

SEC.

TEMP.


DESCRIPTION

LEFT

CENTER LINE

RIGHT

JOB NO.

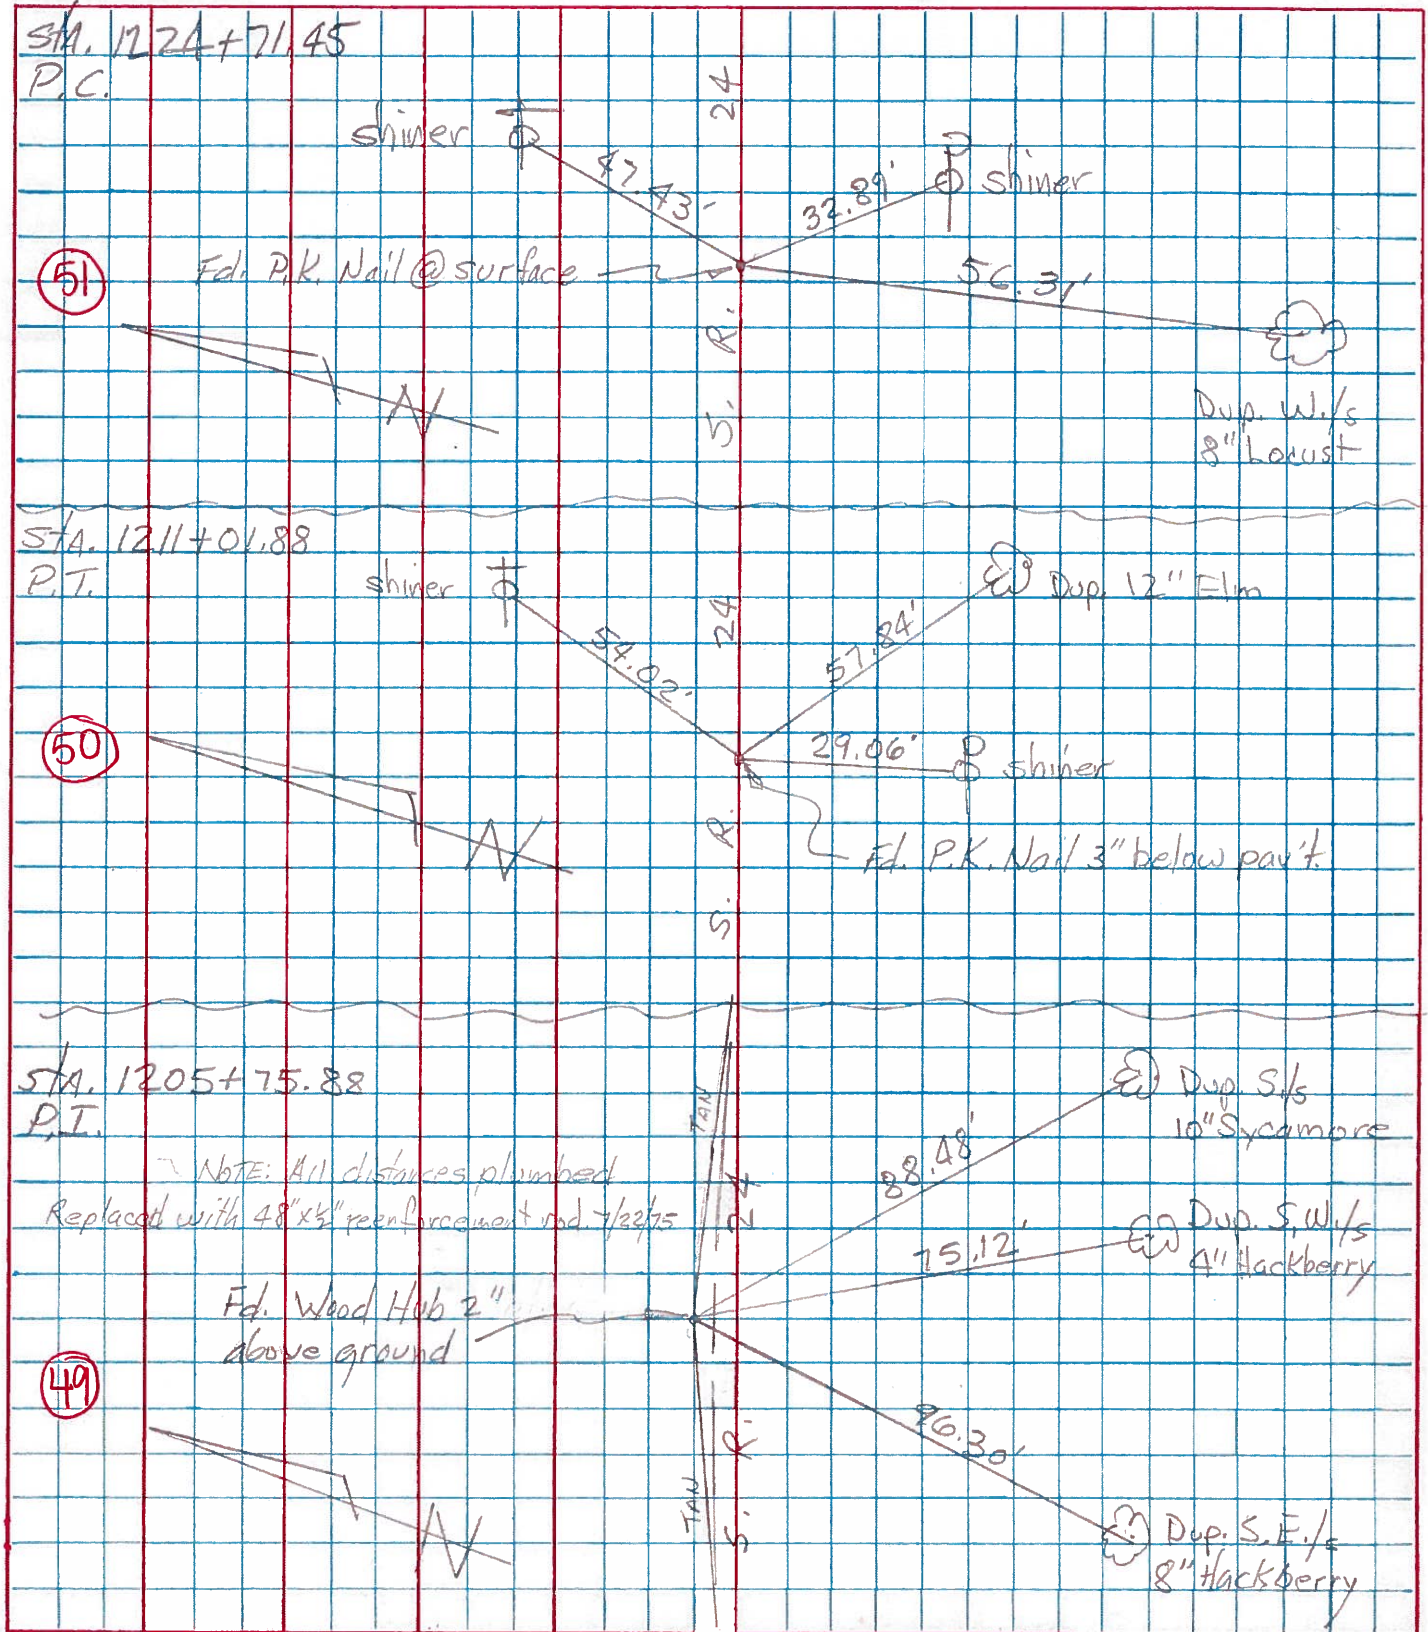

PERSONNEL TITLE PERSONNEL TITLE

Silvestro

COUNTY *Henry*

DATE _____

S. R. *24*

WEATHER _____

SEC. _____

TEMP. _____

DESCRIPTION *Curve Data of witness ties*

LEFT

CENTER LINE

RIGHT

JOB NO. _____

CURVE #

26

PI. Sta. *1205+75.83*

PG. Sta. *1200+46.88*

PT. Sta. *1211+01.88*

A = *10°33' R*

Dc = *100*

T = *529.00*

L = *1055.0*

R = *5729.58*

E = *24.22*

PI. wit

Shiner in 6" Elm S.W. 96.20

" " 8" " S.S.W. 73.40

Shiner in P.Pole S.S.E. 78.10

PG. wit

Shiner in P.Pole W.S.W. 96.3

Shiner in T.Pole N.W. 50.96

Shiner in 15" Ash S.S.W. 57.30

PT. wit

Shiner in T.Pole E.N.E. 54.10

" " P.Pole S.S.W. 29.05

" " 12" Elm S.S.E. 57.23