

PERSONNEL	TITLE	PERSONNEL	TITLE

COUNTY Henry DATE April 1998
 U.S. 6 - (24 Bypass) WEATHER
 SEC. 11.41 to 16.68 TEMP.


DESCRIPTION RAMP "A" JOB NO.
 LEFT CENTER LINE RIGHT

FD 843+79.79 = 25+718.96	MON BOX	NOTE: FOR Sheets 1, 2, 3 & 3; ALSO See Survey FILE - Resurface - 1998 & see plan! HEN-6-18.287 ON FILE AS: HEN-6-11.36.998 020 2178
FD 847+35.00 25+827.23	MON BOX	
US WB 6		
FD 834+22.19 = 25+427.08	MON BOX	
DNF 830+85.18	in DITCH.	
US WB 24		
FD 504+17.66 = 15+36.73	MON BOX	
DNF 510+84.48		
FD 517+37.66 = 15+769.64	MON BOX	3m North E US
FD 519+83.11 = 15+844.45	MON BOX	3m North E US 24
DNF 525+10.52 = 16+005.20	MON BOX	
FD 532+27.28 = 16+223.67	MON BOX	3m North E ADP
W.B US #6 24+185 LT RR 1.5" L 24+154 RT RR 1.5" L		


PERSONNEL	TITLE	PERSONNEL	TITLE	COUNTY	DATE
		Loehrke		HENRY	April 1998
		CONDES		U.S. S.R. 6 - (24 BYPASS)	WEATHER
				SEC. 11.41 to 16.68	TEMP.
DESCRIPTION	EB US 24			JOB NO.	

LEFT	CENTER LINE	RIGHT
------	-------------	-------

FD	509+64.59		
FD	509+64.59 = 15+534.01	✓	MON BOX EB 24
FD	521+75.12 = 15+902.98	✓	MON BOX " "
FD	535+24.62 = 16+314.30		MON BOX ✓ E CONST 24
FD	557 ^{E US 24 D} +66.67 = 16+996.16		MON BOX (IN MEDIAN)
FD	560+66.50 = 17+089.07	✓	MON BOX Yell. Line
FD	567+49.83 = 17+297.35	✓	MON BOX / WB 567+64.76
F	571+96.60 = 17+433.52	✓	MON BOX (E US 24)
FD	580+53.68 = 17+1694.76		MON BOX (PROJECT)

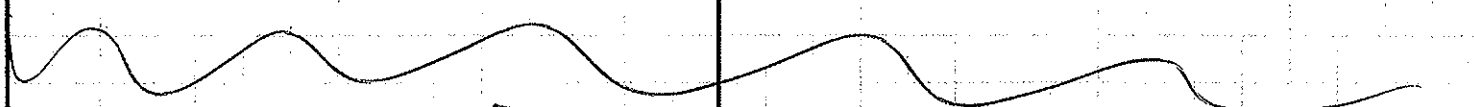

FD	657+60.87 = 20+043.91		RAMP A & D MON BOX (IN CONC. MEDIAN)
FD	653+43.28 = 79+966.63		MON BOX (CONC. MEDIAN HEAVY UP PIV ? ABLE)

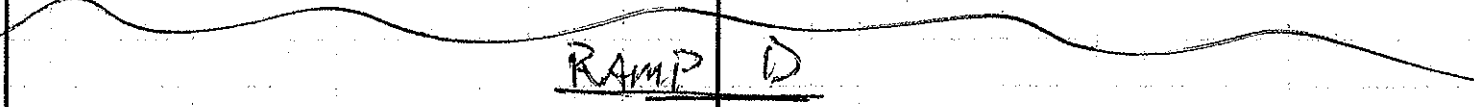

FD	660+25.83 = 20+124.67		MON BOX CONC. MEDIAN RT EDGE RAMP
FD	664+25.00 = 20+246.34		MON BOX RT EDGE RAMP

PERSONNEL _____ TITLE _____ PERSONNEL Loehrke TITLE _____ COUNTY Henry DATE April 1998
 _____ _____ PERSONNEL CORDES TITLE _____ US S.R. 6 - (241 BYPASS) WEATHER _____
 _____ _____ _____ _____ SEC. 11.41 to 16.68 TEMP. _____

DESCRIPTION MAIN LINE & near (MEDIAN) JOB NO. _____
 LEFT CENTER LINE RIGHT

	ENGLISH	METRIC	
FD	608 + 23.75 =	18 + 538.957	CONC MON
FD	648 + 23.73 =	18 + 758.272	CONC MON
DNF	641 + 45 =	19 + 551.396	
FD	670 + 79.98	20 + 445.98	MON FD, BUT DISTURBED
FD	680 + 10.40	20 + 729.57	CONC MON
DNF	684 + 58.34 =	20 + 866.10	
FD	694 + 04.6 =	21 + 154.52	MON BOX
DNF	705 + 46.7 =	21 + 502.674	
FD	723 + 45.8 =	22 + 050.99	MON CONC
DNF	731 + 89.9 =	22 + 308.28	CONC MON - OVERHEAD THERE
FD	759 + 07 =	23 + 136.45	MON BOX
FD	763 + 57.53 =	23 + 273.78	CONC MON
FD	786 + 10.80 =	23 + 960.57	CONC MON
FD	790 + 36.1 =	24 + 090.20	CONC MON
FD	812 + 55.10 =	24 + 766.55	MON BOX
FD	822 + 76.41 =	25 + 077.85	MON BOX / & EB LANE
FD	830 + 85.18 =	25 + 324.76	CONC MON

619 + 48.56 = 18 + 881.95
 CONC MON. FD

502.674