

ODOT. D

STEVE H.

37 OF

County HENRY S.R. -11

PLEASE LOOK FOR

Township WASHINGTON

METAL ROD SET

Section 1

7-24-75

T5N, R8E

SEE NEXT SHEET

Personnel HOFFMAN


Loehrke

Householder

C.A.T.

Fd. Hub 4" Below Ground
7' ± S. of S. Edge of PAVT
of old road

Project STA ± 12 21+77

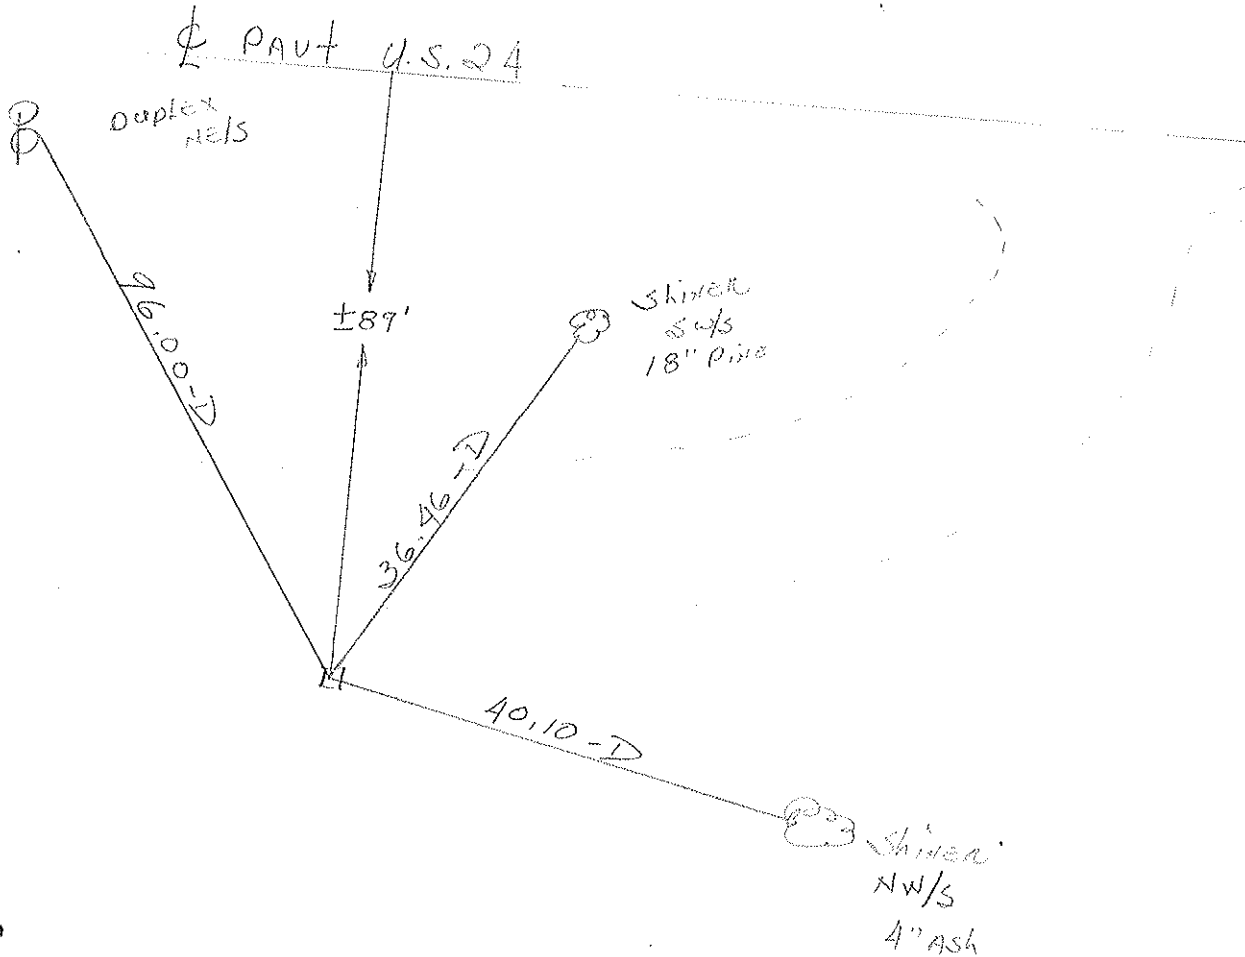

PERSONNEL	TITLE	PERSONNEL	TITLE
Tomasic			
Newer			
Gianola			
Curtis			

COUNTY HENRY DATE July 18 1975
 S. R. 24 WEATHER _____
 SEC. _____ TEMP. _____

DESCRIPTION _____ LEFT _____ CENTER LINE _____ RIGHT _____ JOB NO. _____

