

O.D.O.T. DISTRICT 2 SURVEY OFFICE (USE ONLY)

PERSONNEL

REFERENCE NO. 14

SHEET 3 OF 4

NOTES MILLER

DATE 6/6/19

ROUTE SR 34

H.C. LEU

WEATHER CLOUDY

COUNTY HENRY

R.C. MILLER

TEMP. 63°

TOWNSHIP RIDGEVILLE

SECTION 27

DWG BY MILLER

PID 107059

T 6 N R 5 E

TYPE MONUMENT MAG/WASHER

ON SURFACE - BELOW ON

OFFSET \odot PAVEMENT 3.6' ~~LT~~ : RT

7' TO RT EDGE PAVEMENT


STATION: 202+29.69

HORZ.DATUM: NAD83 2011


GEOID: 2012A

GRID: NORTHING: 651834.615

EASTING: 1482419.975

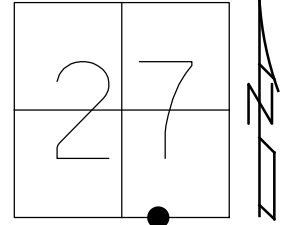

RECORD:
 FD SM.R.R.SPIKE
 5/31/05, DCH
 SET MAG/WASHER
 7/12/05, JH
 FD MAG/WASHER
 REF14
 5/16/19, DCH
 FD MAG/WASHER
 REF14
 6/6/19, JLL

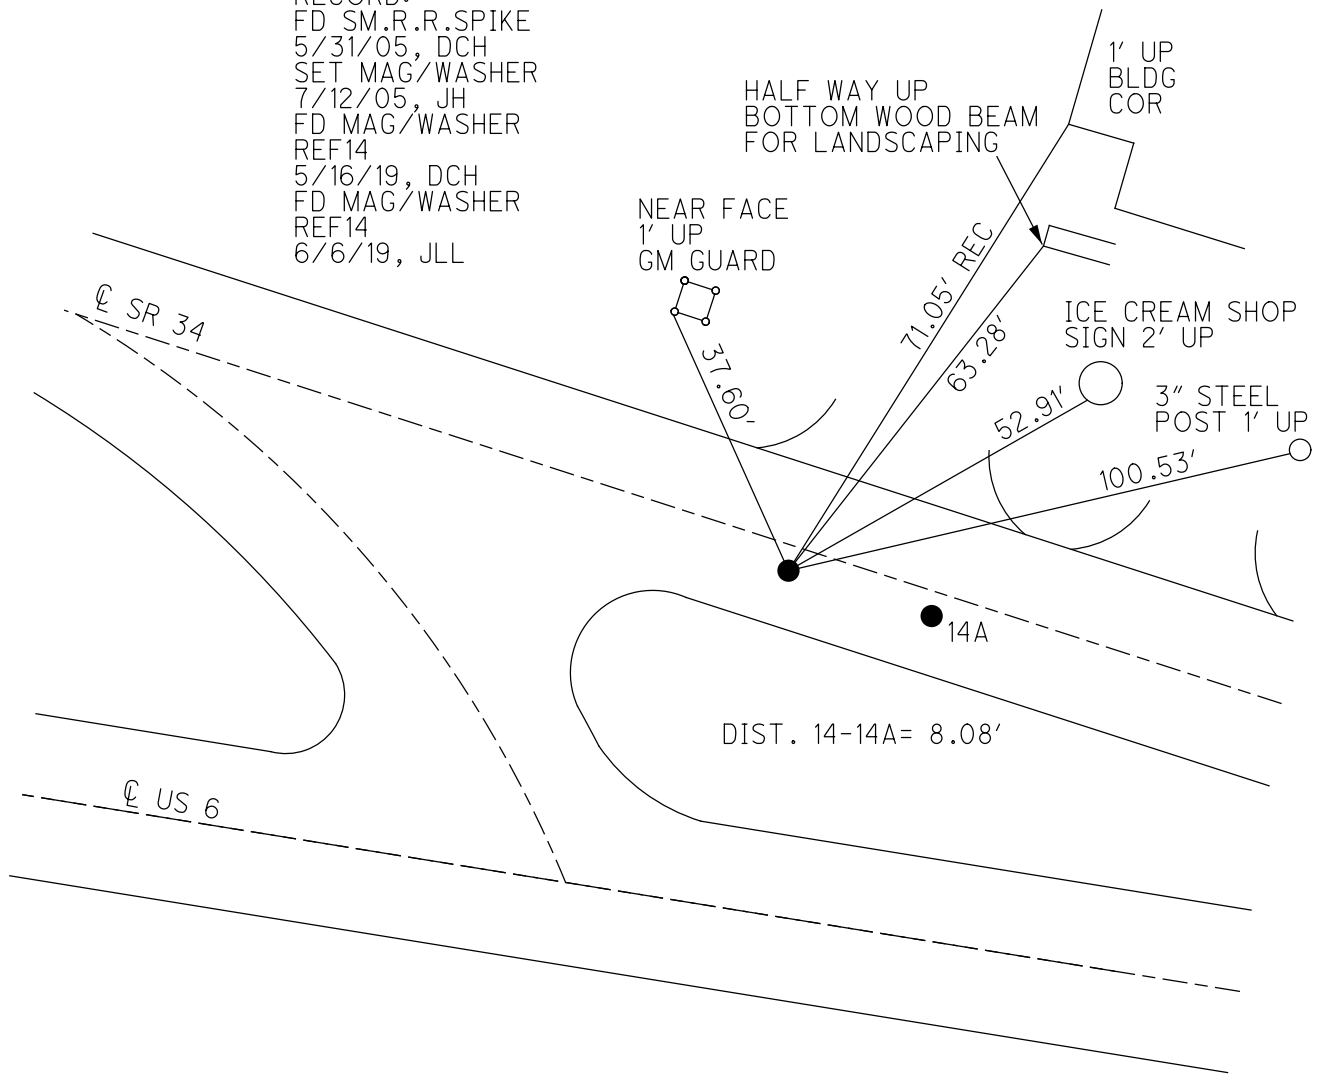


DIST. 14-14A = 8.08'

O.D.O.T. DISTRICT 2 SURVEY OFFICE (USE ONLY)


PERSONNEL	REFERENCE NO.	<u>14</u>	SHEET	<u>17</u>	OF	<u>18</u>
NOTES	CARSON	DATE	<u>5/16/17</u>	ROUTE	<u>SR 34</u>	
H.C.	HOMAN	WEATHER	<u>CLOUDY</u>	COUNTY	<u>HENRY</u>	
R.C.	POORE	TEMP.	<u>63°</u>	TOWNSHIP	<u>RIDGEVILLE</u>	
	<u>RHOADES</u>			SECTION	<u>27</u>	
				T	<u>6</u>	N
				R	<u>5</u>	E

TYPE MONUMENT MAG/WASHER
 ON SURFACE - ~~BELOW~~ ON
~~LEFT~~ - ℄ PAV'T - RIGHT 3.6'
7' TO RT BERM
 S.L.M. 202+29.69

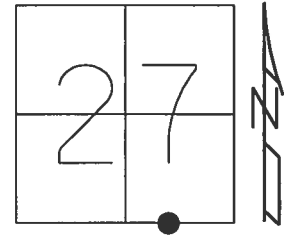

Grid: Northing: 651834.671 Easting: 1482419.998

RECORD:
 FD SM.R.R.SPIKE
 5/31/05, DCH
 SET MAG/WASHER
 7/12/05, JH
 FD MAG/WASHER
 REF14

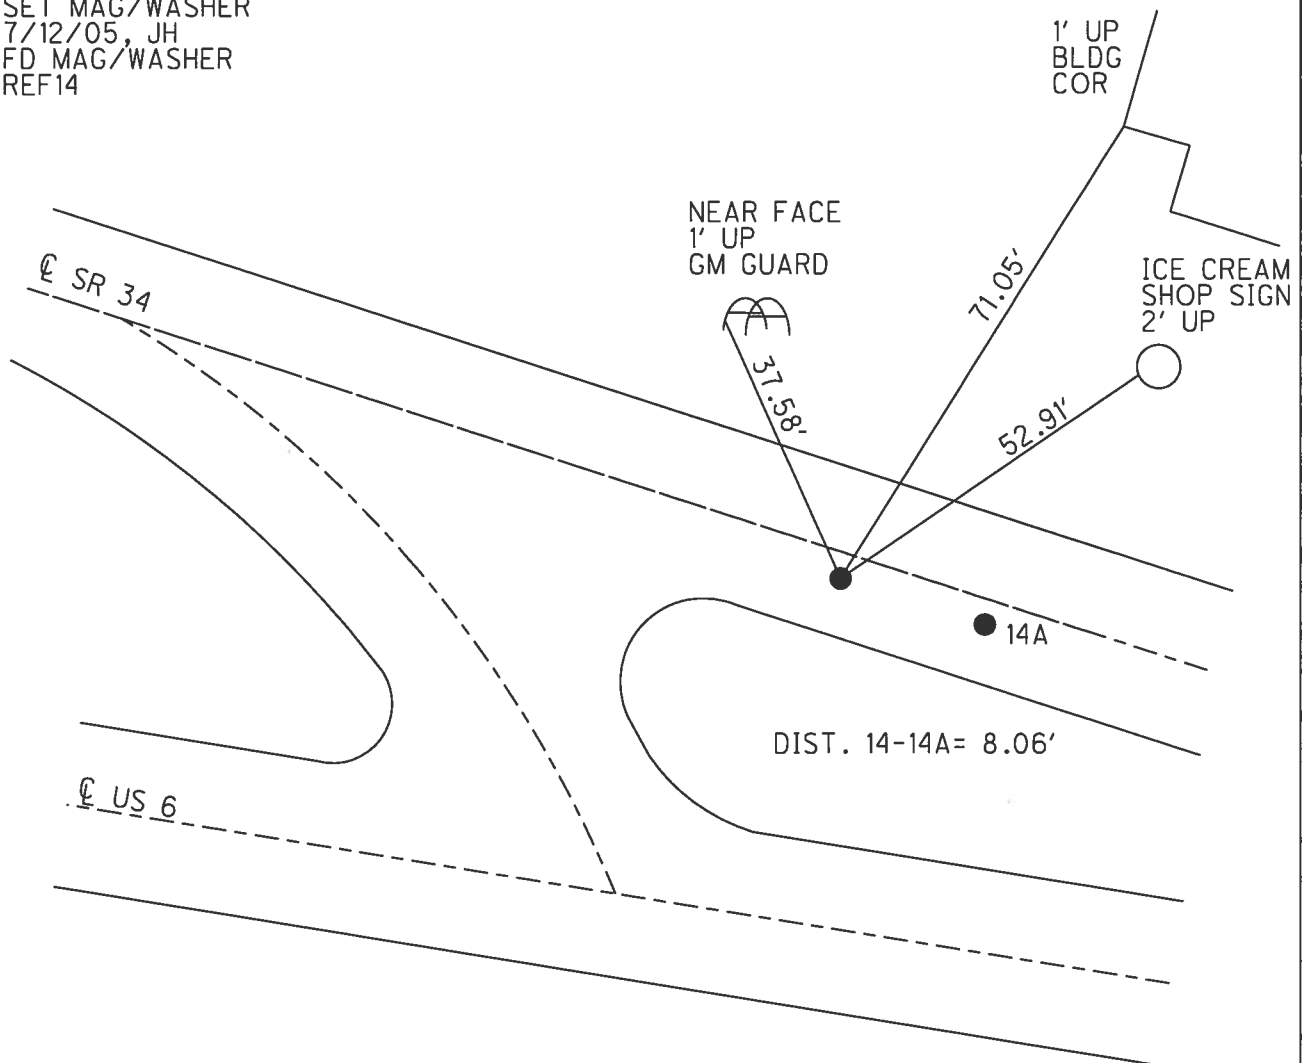

O.D.O.T. DISTRICT 2 SURVEY OFFICE

PERSONNEL

REFERENCE NO. 14

SHEET 18 OF 18

NOTES HOMAN

DATE 5-31-05

ROUTE 34

H.C. HUSS

WEATHER SUNNY

COUNTY HENRY

R.C. HOMAN

TEMP. 65°

TOWNSHIP RIDGEVILLE

SECTION 27

T 6 N R 5 E


TYPE MONUMENT A SM RR SPK; B PK/WA

~~ON SURFACE~~ - BELOW A & B 0.762m


~~LEFT - C PAVT - RIGHT~~ A&B 1.097m

1.28 TO LT EDGE PAVEMENT

S.L.M. 202+53 - 202+61

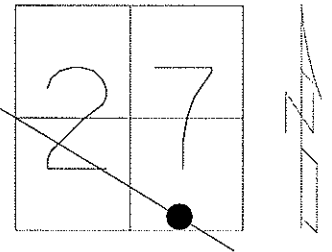

SET BOTH MAGS AND WASHERS
JH 7-12-05

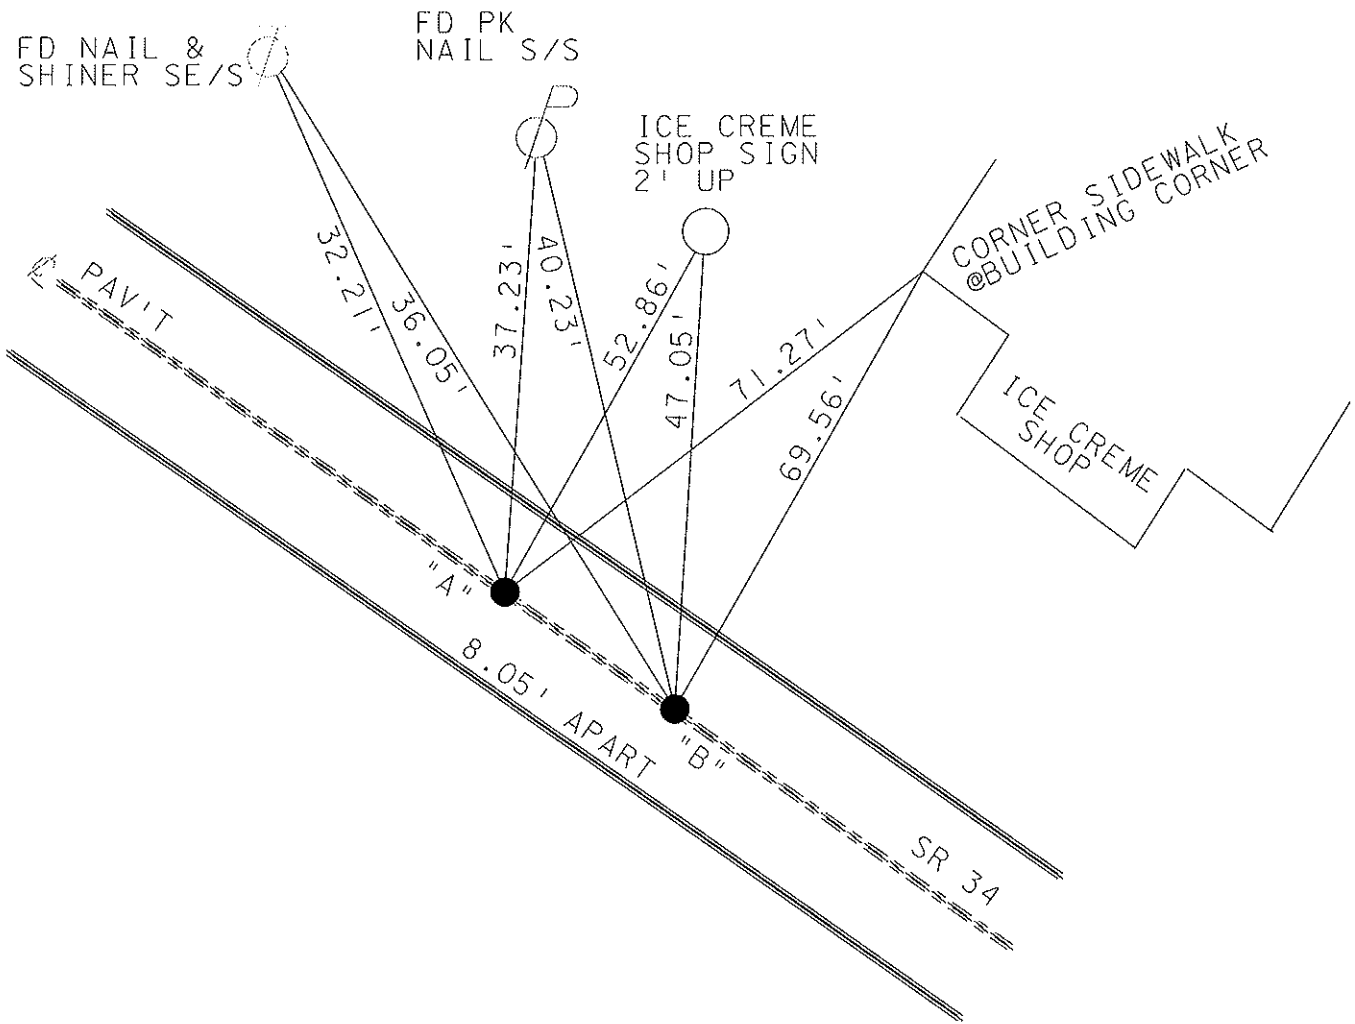

O.D.O.T. DISTRICT 2 SURVEY OFFICE

PERSONNEL

REFERENCE NO. 14

SHEET 18 OF 18

NOTES CORDES

H.C. LOENKE

R.C. CORDES

DATE 4-14-97

WEATHER SUN

TEMP. +12°C

ROUTE 34



COUNTY HENRY

TOWNSHIP RIDGEVILLE

SECTION 27

T & N R S E

TYPE MONUMENT "A" FD RR S/PK "B" FD RR S/PK
~~ON SURFACE~~ - BELOW "A" 0.762m "B" 0.762m
~~NEAR FACE~~ - RIGHT "A" & "B" 1.097m RT
 1.280 TO LT EDGE PAVEMENT "A" & "B"
 S.L.M. 6+10.8

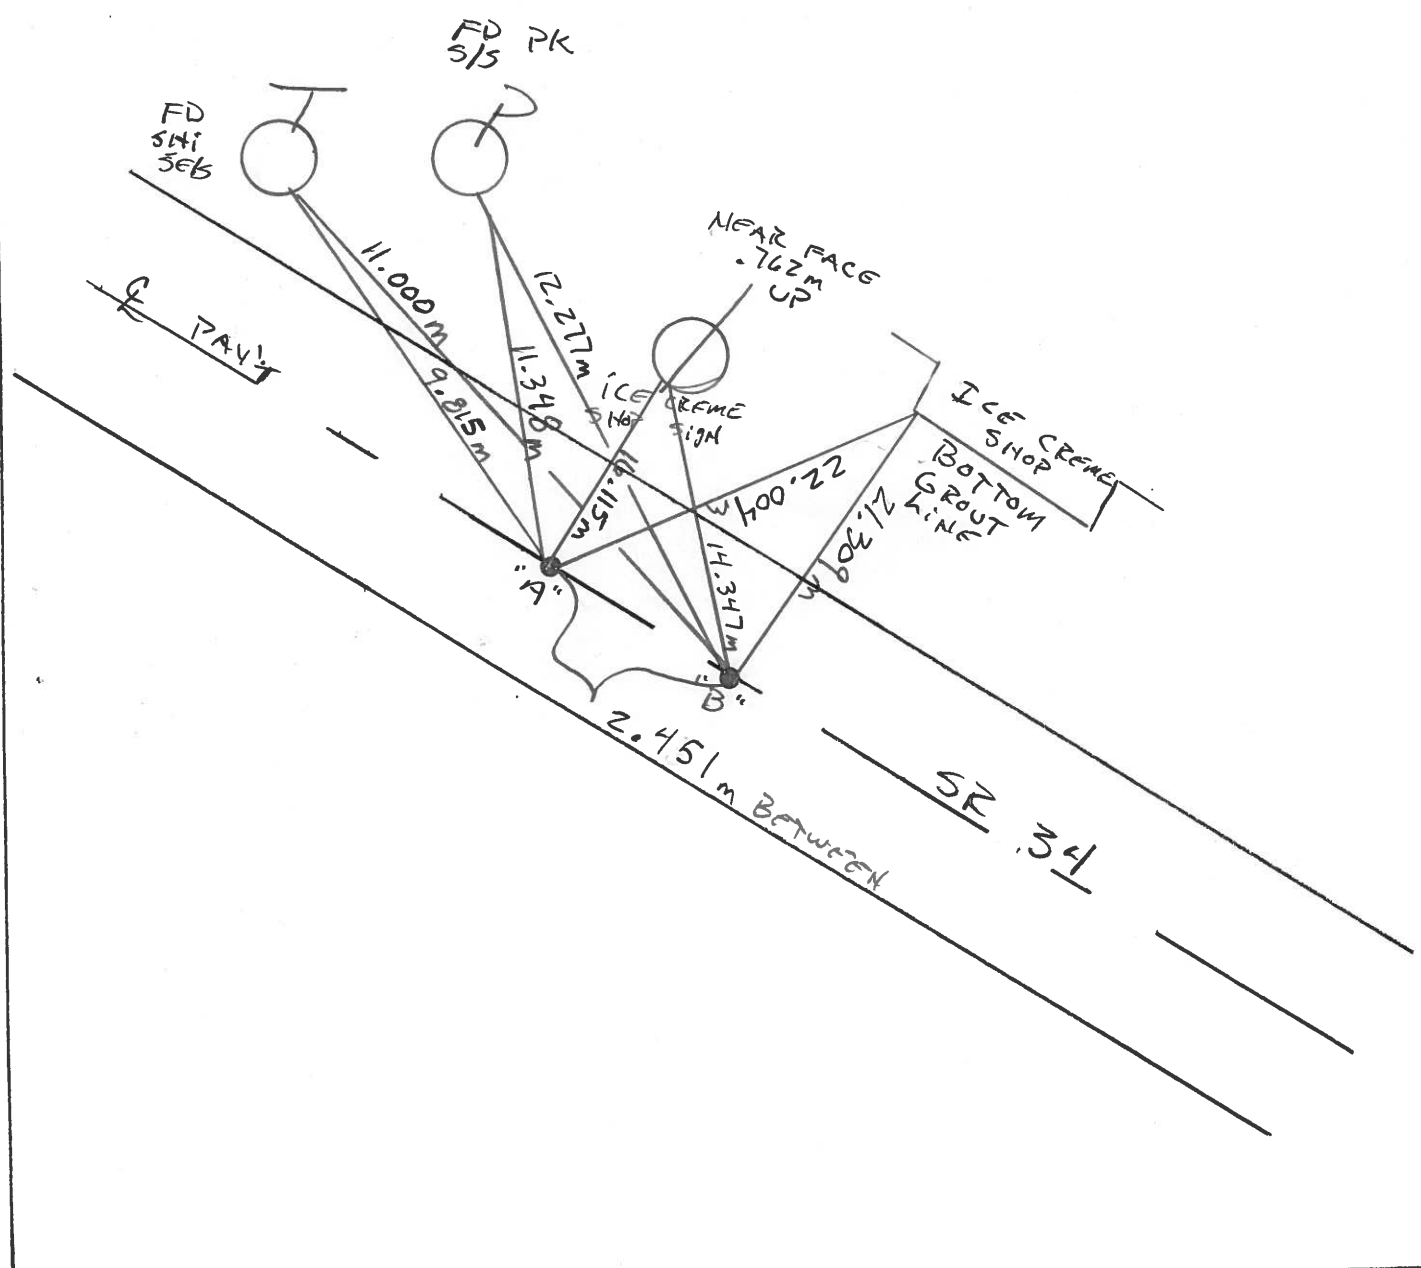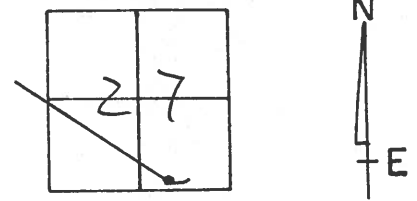

PERSONNEL TITLE PERSONNEL TITLE

Stone

COUNTY Henry

DATE 14 June 78

±

S. R. #34

WEATHER Clear

Crew


SEC. 0.00

TEMP. 74°

DESCRIPTION

References to Control Points
LEFT CENTER LINE RIGHT

JOB NO. 023810

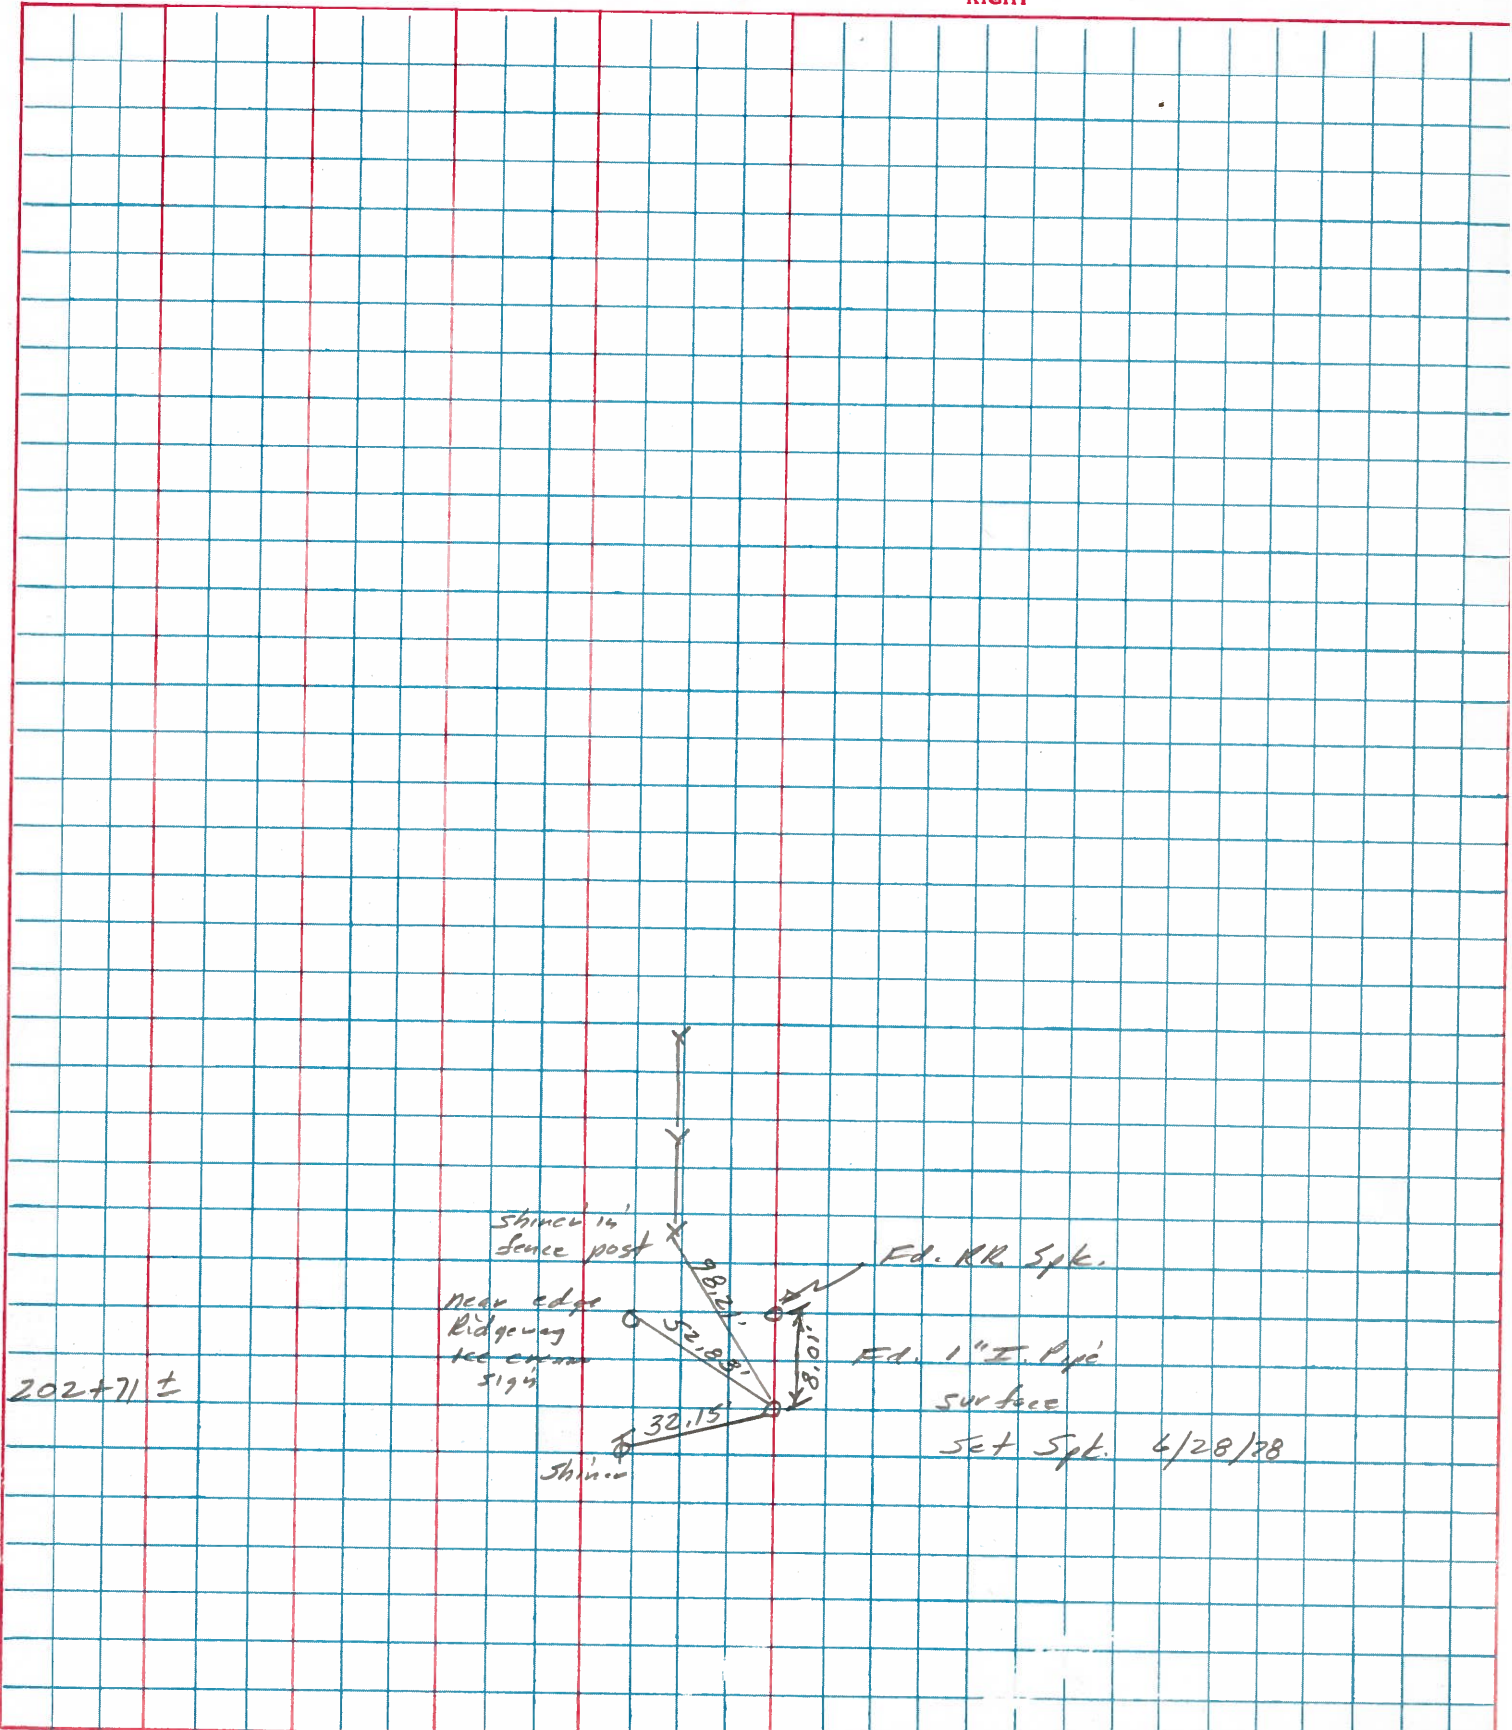

202+71 ±

PERSONNEL TITLE PERSONNEL TITLE

Red Beach
W. Knape

COUNTY HENRY

DATE 24 June 75

S. R. 34

WEATHER



SEC. 27 Ridgeway

TEMP.

DESCRIPTION

CONTROL POINTS

JOB NO.

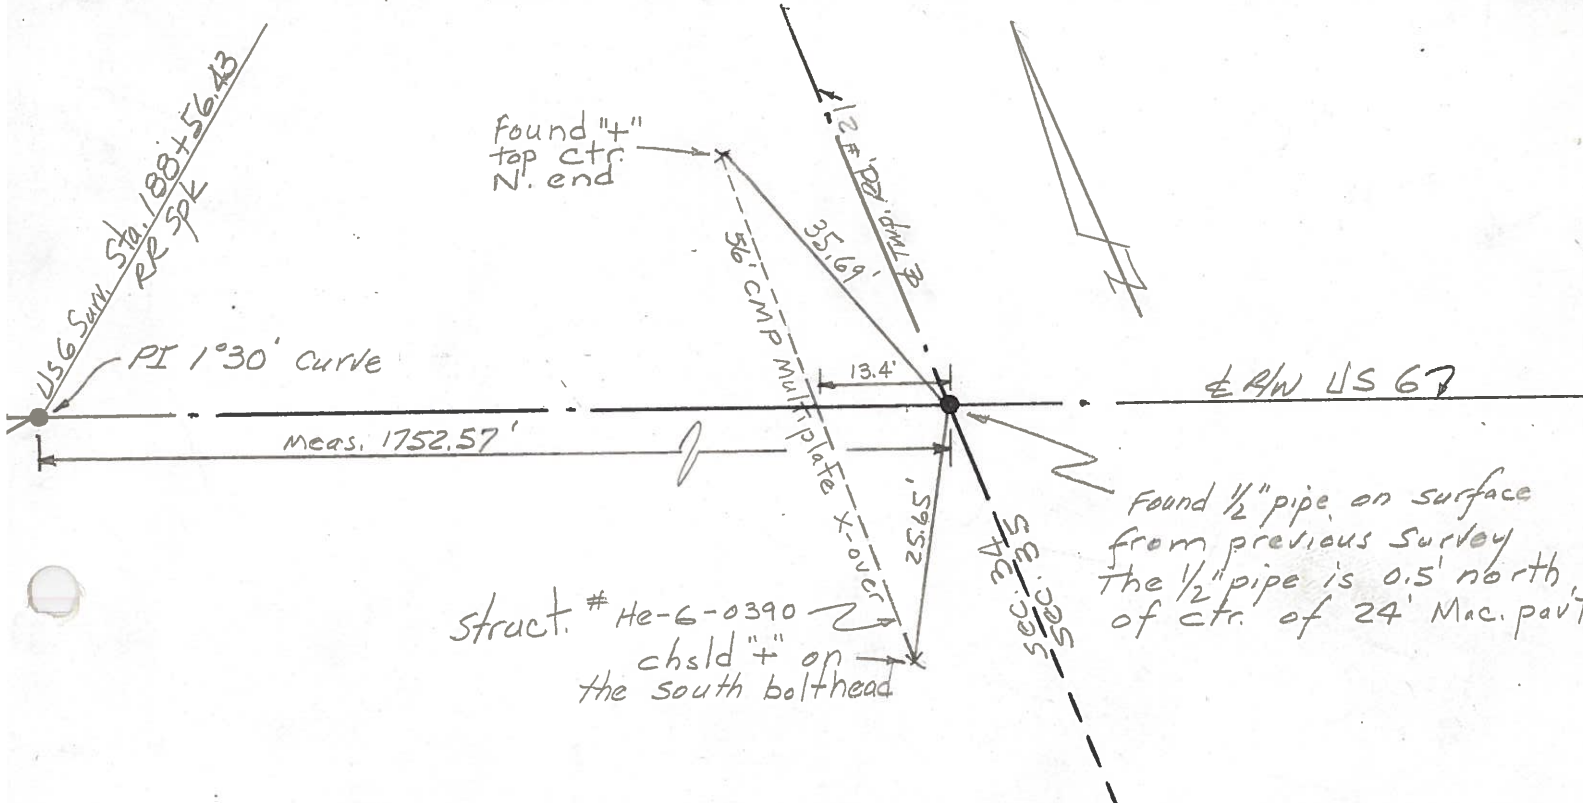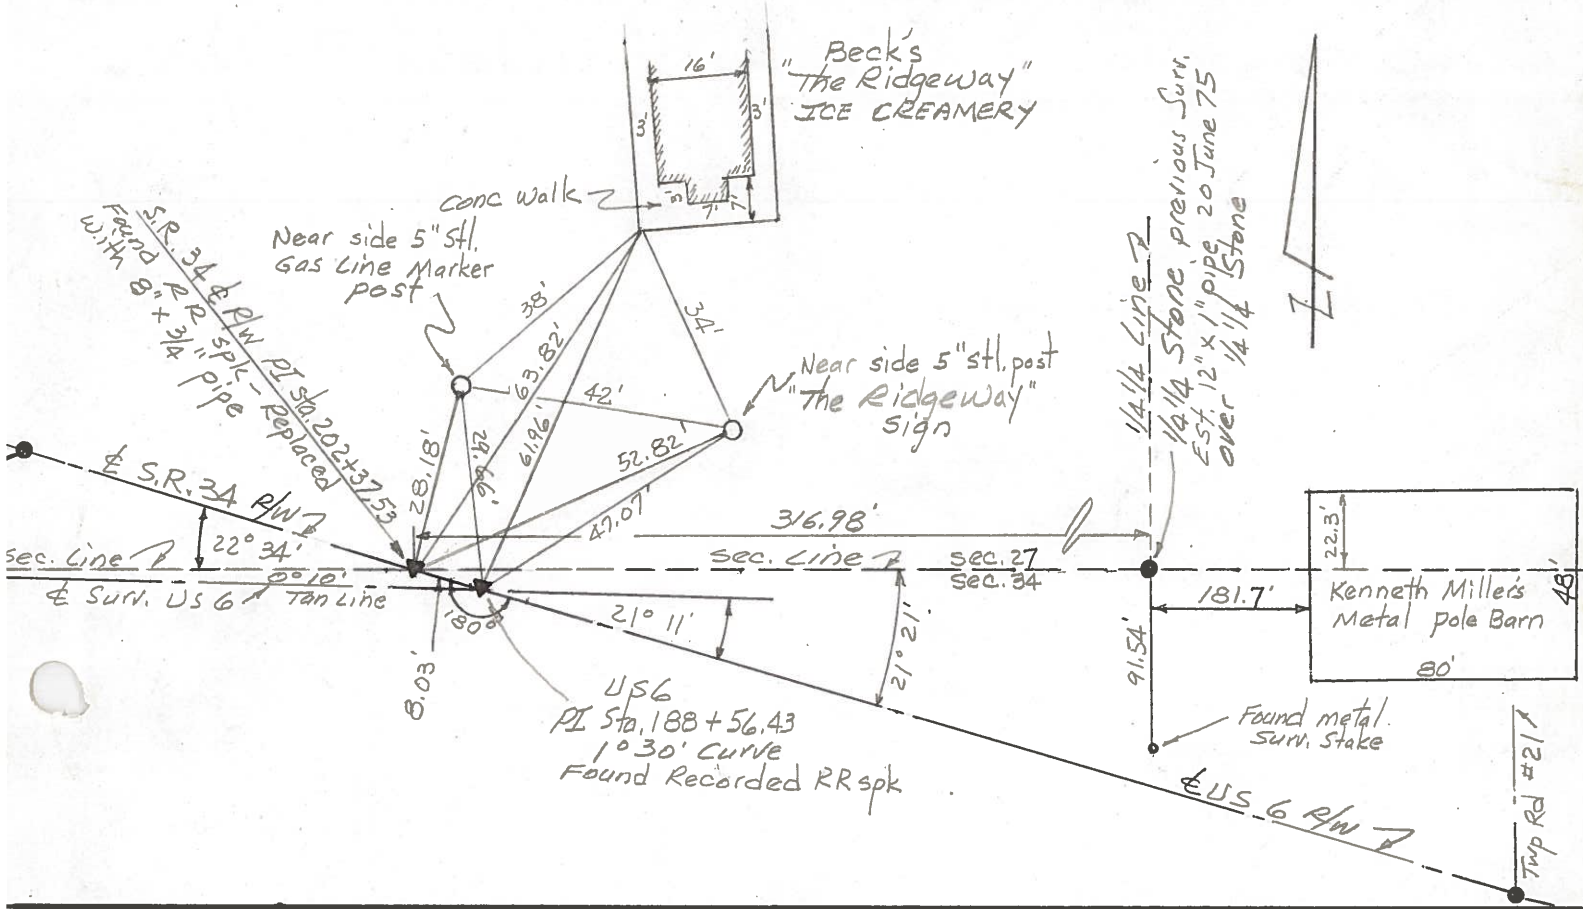

PERSONNEL TITLE PERSONNEL TITLE
 Red Beach
 W. Knappe

COUNTY HENRY DATE June 1975
 S. R. 34 WEATHER
 SEC. Ridgville Twp. TEMP.

DESCRIPTION SOUTH 1/2 Sec. 27 T-6-N R-5-E JOB NO.

