

PRIORITY NO. _____ PART _____ OF _____ SHEET 1 OF 3

COUNTY Henry ROUTE SR 65 SECTION 8.02

BEGIN LOG (SLM) 8.02 TERMINII SR 281 ^{E of} 423+50 ^{USE SLM FROM PREVIOUS 1984}
_{Resurfacing job.}

END LOG (SLM) 14.07 TERMINII USR 6

TOTAL LENGTH 6.05 MILES

MUNICIPALITY McClure BEGIN LOG (SLM) 13.52 END LOG (SLM) 14.07

MUNICIPALITY _____ BEGIN LOG (SLM) _____ END LOG (SLM) _____

PROPOSED WORK:
PAVEMENT 1/2" 404 SHOULDER 1 1/2" 404, 6 17 (1/2)

OTHER _____

EXISTING DATA:

^{= 0/0 of white lines}
SLM 423+04 TO _____; PAV'T WIDTH 19.4 (type 404), SHLD WIDTH 2.6 RT (type 404)
SLM 475+32 TO at mm 9; PAV'T WIDTH 20.3 (type 404), SHLD WIDTH 2.6 RT (type 404)
SLM 528+13 TO at mm 10; PAV'T WIDTH 20.2 (type 404), SHLD WIDTH 2.6 RT (type 404)
SLM 581+36 TO at mm 11; PAV'T WIDTH 20.3 (type 404), SHLD WIDTH 2.6 RT (type 404)
SLM 634+50 TO at mm 12; PAV'T WIDTH 20.0 (type 404), SHLD WIDTH 2.6 RT (type 404)
SLM 689+16 TO at mm 13; PAV'T WIDTH 19.2 (type 404), SHLD WIDTH 2.6 RT (type 404)
SLM 725+56 TO IN TOWN; PAV'T WIDTH 31.0 (type 404), SHLD WIDTH _____ (type _____)
SLM 727+65 TO _____; PAV'T WIDTH 38.5 (type 404), SHLD WIDTH _____ (type _____)
SLM 734+12 TO _____; PAV'T WIDTH 44.8 (type 404), SHLD WIDTH _____ (type _____)
SLM _____ TO _____; PAV'T WIDTH _____ (type _____), SHLD WIDTH _____ (type _____)

STRUCTURES:

STR. NO. HEN 65 1205, WIDTH 32.5, LENGTH 17.6, PROP. WORK _____
STR. NO. HEN 65 1371, WIDTH 30.0, LENGTH 52.5, PROP. WORK _____
STR. NO. _____, WIDTH _____, LENGTH _____, PROP. WORK _____
STR. NO. _____, WIDTH _____, LENGTH _____, PROP. WORK _____
STR. NO. _____, WIDTH _____, LENGTH _____, PROP. WORK _____
STR. NO. _____, WIDTH _____, LENGTH _____, PROP. WORK _____

RAILROAD CROSSING:

NAME NONE STATION _____ NO. TRACKS _____ LENGTH ALONG C L _____ ft (no work)
NAME _____ STATION _____ NO. TRACKS _____ LENGTH ALONG C L _____ ft
NAME _____ STATION _____ NO. TRACKS _____ LENGTH ALONG C L _____ ft


MISCELLANEOUS:

NO. RAISED PAVEMENT MARKERS; EDGE OF PAVEMENT 12 6, CENTERLINE 378
NO. MAILBOX APPROACHES _____, MAILBOX SUPPORTS _____

REMARKS: BEGIN at const. joint south of SR 281; joint sta. = 423+04

McClure Corp sign = 714+43; BEGIN STRAIGHT CORB, Right side 1" below point to 2" above
Point Bureau Rt. 728+30 ±

LEFT SIDE HAS OLD SANDSTONE EXPOSED IN SOME PLACES - BURIED 9" IN PAV.
CONDITION, BEGIN SAME PLACE ±.

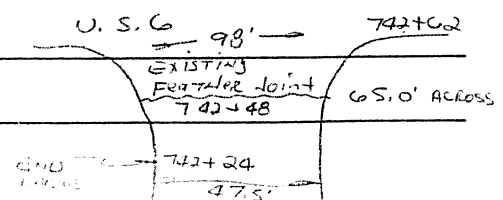

1990 TWO-LANE RESURFACING PROGRAM

SHEET 2 OF 3

APPROACHES (INTERSECTIONS & DRIVES)

COUNTY HEXLEY

ROUTE SR ~~281~~ 65

SECTION 9.02-14.07

L = Prop Pav't Depth (in.) x 10; W = Width @ Mouth; W-1 = Width @ Throat

[illegible]

SECTION 10-601

R = Raise F = Feather

[illegible]