


O.D.O.T. DISTRICT 2 SURVEY OFFICE (USE ONLY)


PERSONNEL _____ REFERENCE NO. 24 A SHEET 28 OF 42
 NOTES BARNHISEL DATE 10/7/02 ROUTE SR 65
 H.C. CANTERBURY WEATHER SUNNY COUNTY HENRY
 R.C. BARNHISEL TEMP. 59° TOWNSHIP RICHFIELD
 _____ SECTION 4
 _____ T 4 N R 8 E

TYPE MONUMENT MONBOX
 ON SURFACE - ~~BELOW~~ ON _____
 LEFT - ℄ PAV'T - ~~RIGHT~~ 2.3'
10.5' TO LT EDGE PAVEMENT
 S.L.M. 633+34

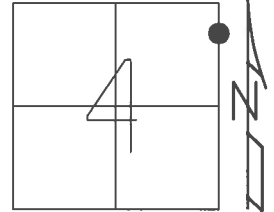

GRID: NORTHING: 613428.506 EASTING: 1572695.037


RECORD:
 FD MONBOX
 REFA24
 7/11/12, MC
 FD MONBOX
 5/12/17, JFO
 FD ASPHALT
 COVERED MONBOX
 9/26/17, JFO

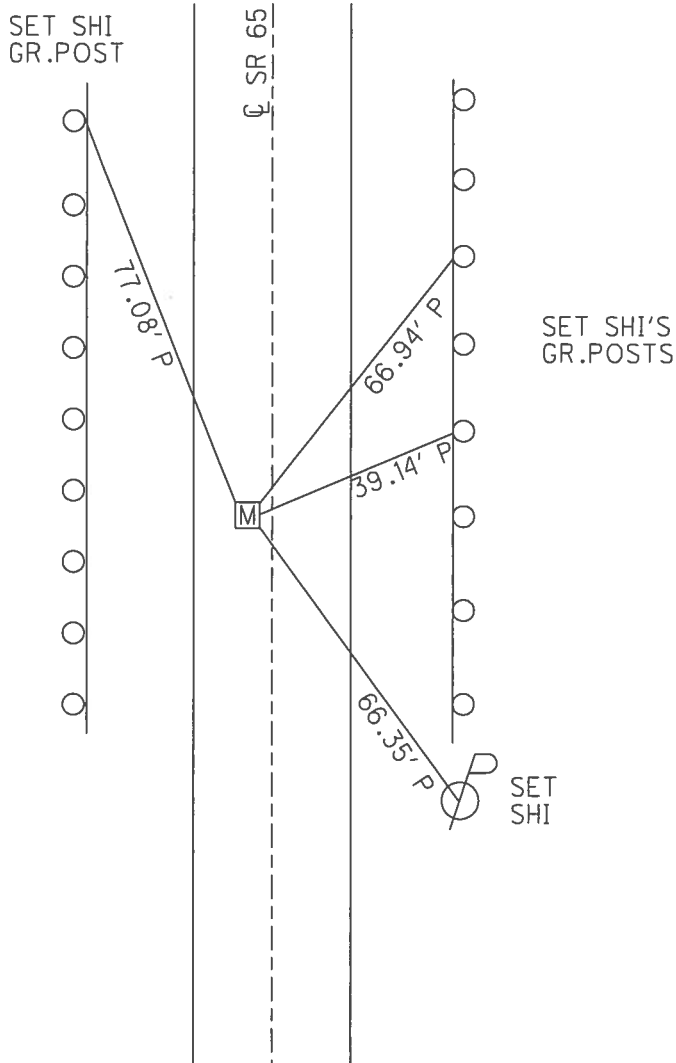


O.D.O.T. DISTRICT 2 SURVEY OFFICE (USE ONLY)

PERSONNEL	REFERENCE NO. <u>24 A</u>	SHEET <u>28</u> OF <u>42</u>
NOTES <u>BARNHEISEL</u>	DATE <u>10/7/02</u>	ROUTE <u>SR 65</u>
H.C. <u>CANTERBURY</u>	WEATHER <u>SUNNY</u>	COUNTY <u>HENRY</u>
R.C. <u>BARNHEISEL</u>	TEMP. <u>59°</u>	TOWNSHIP <u>RICHFIELD</u>
		SECTION <u>4</u>
		T <u>4</u> N R <u>8</u> E

TYPE MONUMENT MON.BOX
 ON SURFACE - ~~BELOW~~ ON
 LEFT - CL PAV'T - ~~RIGHT~~ 2.3'
10.5' TO LT EDGE PAVEMENT
 S.L.M. 633+34

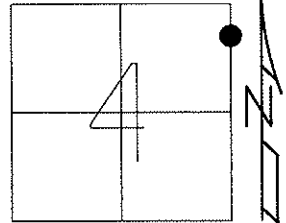

Grid: Northing: 613428.506 Easting: 1572695.037

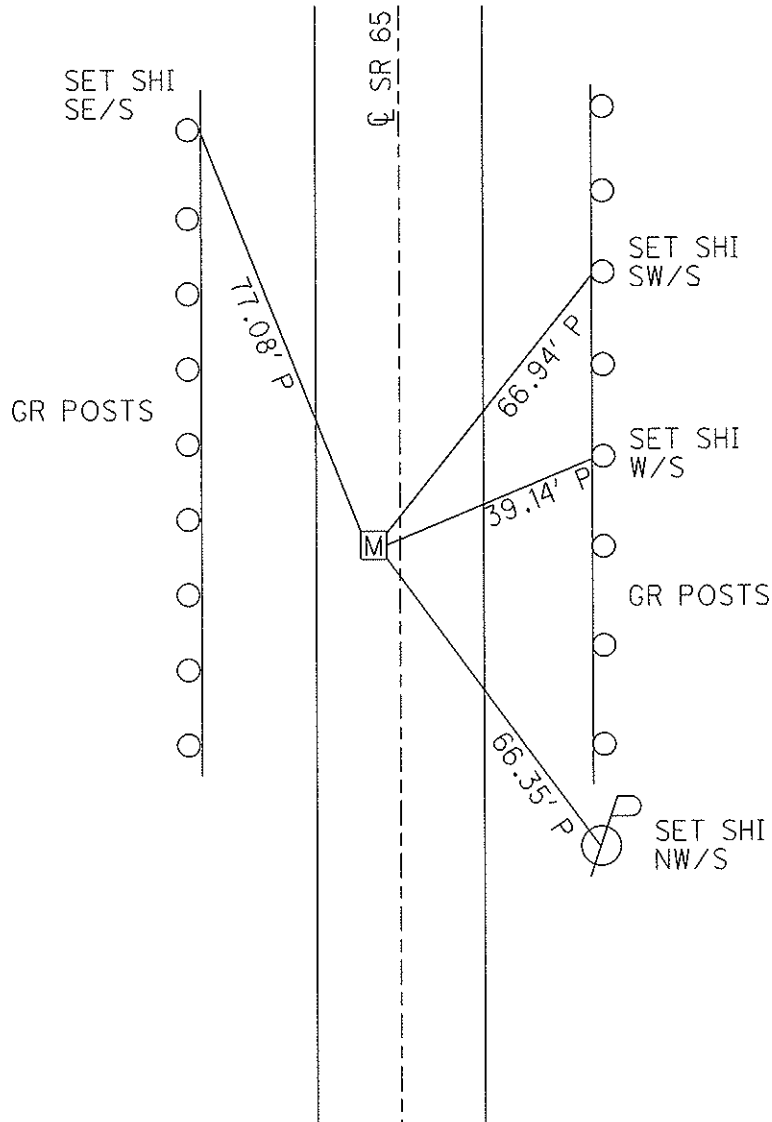

GPS, REFA24
7/11/12

GPS, FINA24
3/15/13

O.D.O.T. DISTRICT 2 SURVEY OFFICE

PERSONNEL _____

REFERENCE NO. 24-A

SHEET 26 OF 29

NOTES BARNHISEL RC

H.C. CANTERBURY

R.C. _____

DATE 10-07-02

WEATHER SUNNY

TEMP. +59°

ROUTE 65

COUNTY HENRY

TOWNSHIP Richfield

SECTION 4

T 4 N R 8 E



TYPE MONUMENT I. Pin in Mon. Box

ON SURFACE - ~~BELOW~~ YES

LEFT - 0 PAV'T. - ~~RIGHT~~ 2.3'

10.5' TO LT. EDGE PAVEMENT

S.L.M. 633+34

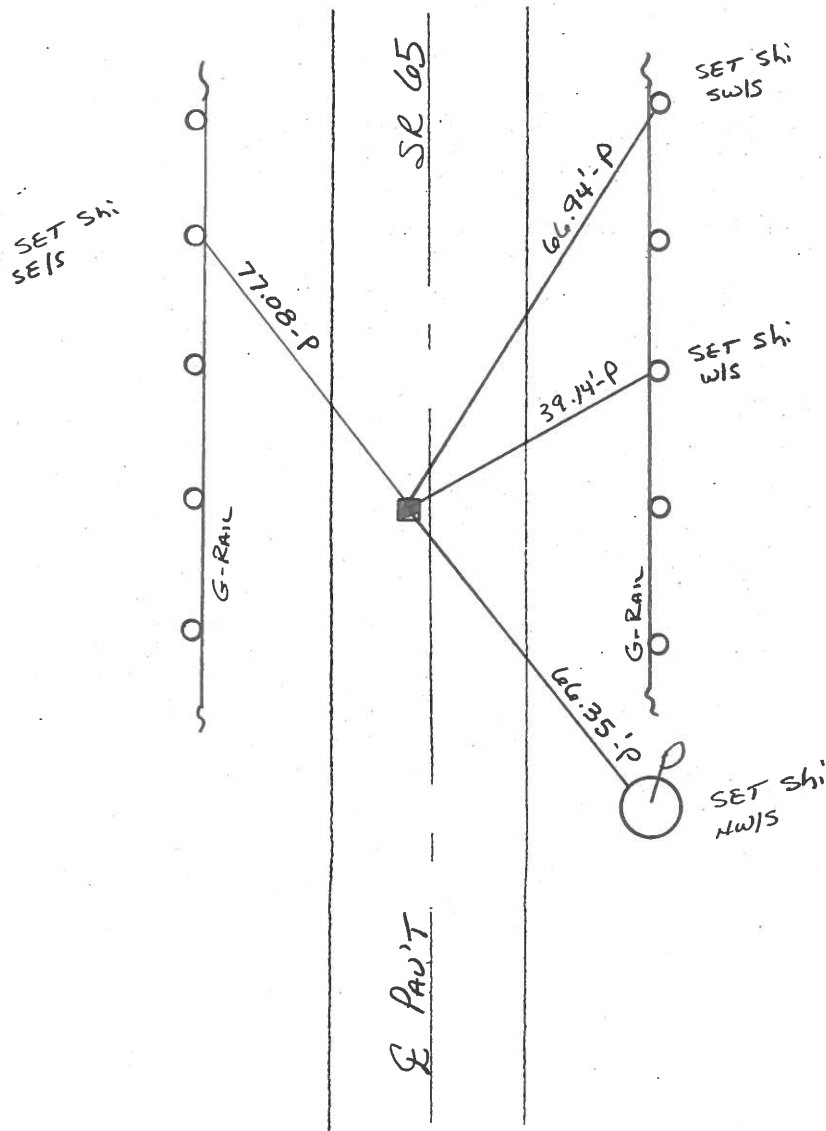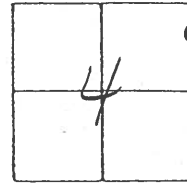

24-A

10-07-02

SUNNY
+59°

MB □ RC
MC HC

633+34
I. PIN IN HOW BOX
2.3' LT E 10.5' LT EC

