



O.D.O.T. DISTRICT 2 SURVEY OFFICE (USE ONLY)

PERSONNEL _____ REFERENCE NO. 28 B SHEET 35 OF 42
 NOTES HUSS DATE 6/22/95 ROUTE SR 65
 H.C. HUSS WEATHER CLEAR COUNTY HENRY
 R.C. CANTERBURY TEMP. +74° F TOWNSHIP DAMASCUS
 _____ SECTION 28
 _____ T 5 N R 8 E

TYPE MONUMENT _____ PK NAIL SHANK
 ON SURFACE - ~~BELOW~~ _____ ON _____
 LEFT - Q PAV'T - ~~RIGHT~~ _____ 3.9'
19.0' TO LT EDGE PAVEMENT
 S.L.M. _____ 735+88.31

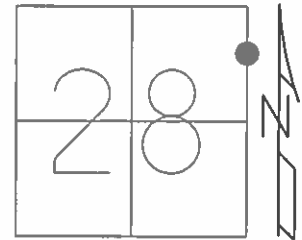

Grid: Northing: 623670.581 Easting: 1572891.488

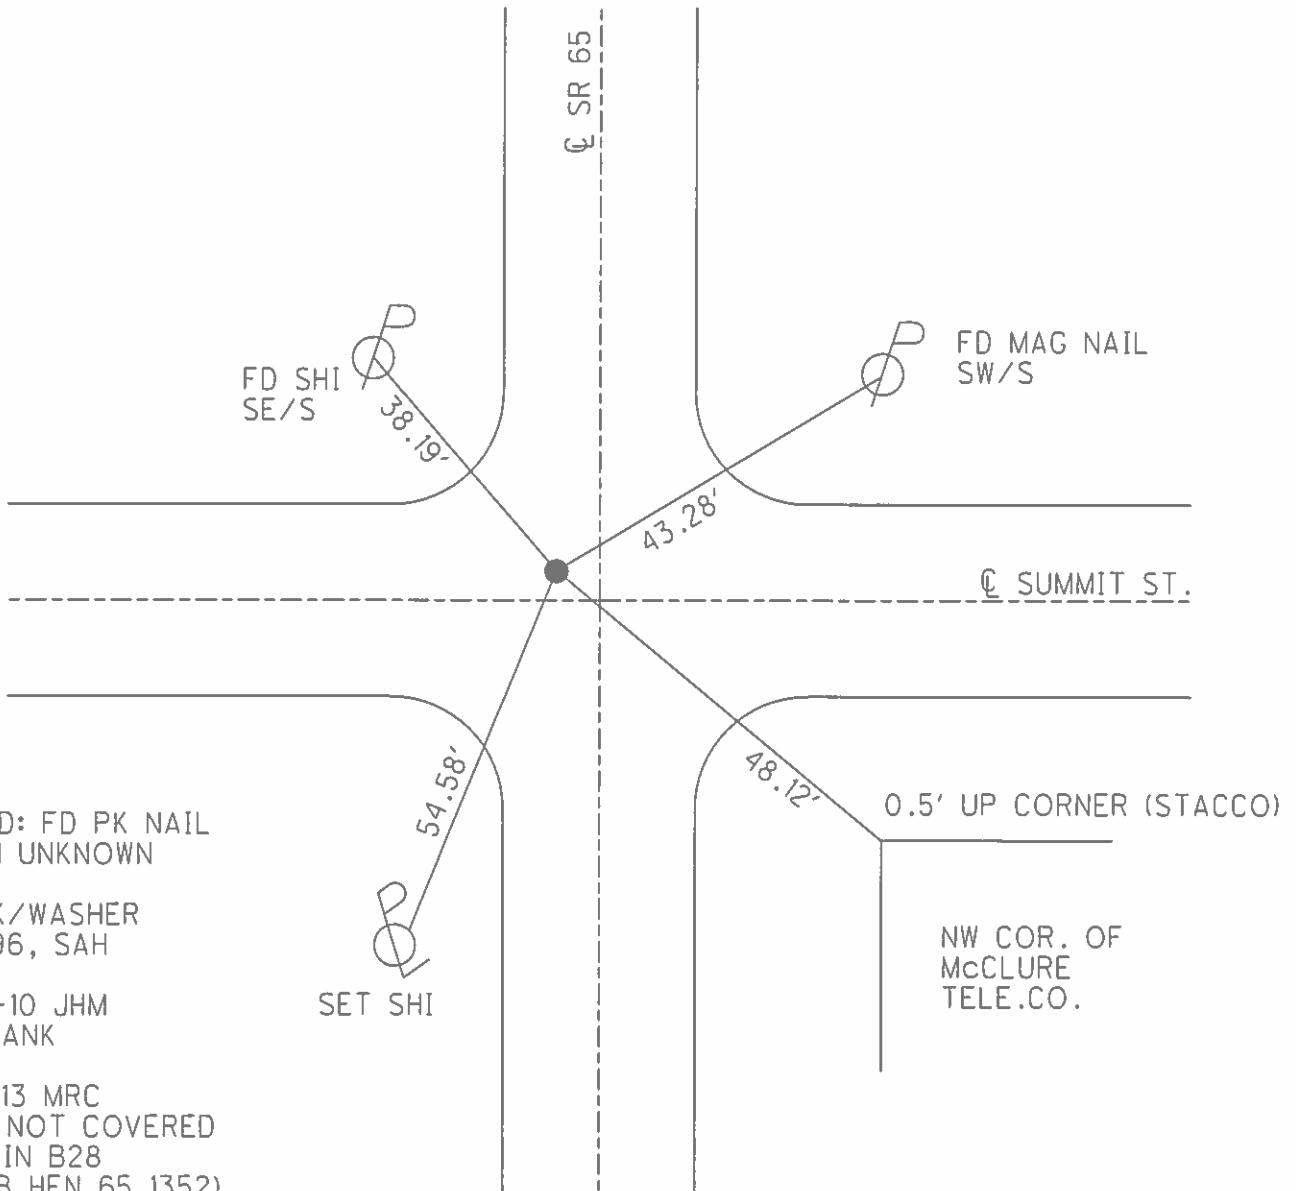

RECORD: FD PK NAIL
 ORIGIN UNKNOWN

SET PK/WASHER
 10/8/96, SAH

09-29-10 JHM
 FD. SHANK

03-15-13 MRC
 POINT NOT COVERED
 GPS, FIN B28
 (IN JOB HEN 65 1352)

O.D.O.T. DISTRICT 2 SURVEY OFFICE

PERSONNEL

REFERENCE NO. 28-B

SHEET 3 OF 4

NOTES STEVE HUSS

H.C. BOB VANOWEN

R.C. KEVIN MOSER

DATE 10-22-95

WEATHER CLEAR

TEMP. +91°F

ROUTE 65

COUNTY HENRY

TOWNSHIP DAMASCUS

SECTION 28

T5 N R 8 E


TYPE MONUMENT PK NAIL

ON SURFACE - BELOW YES

LEFT - C PAV'T. - RIGHT 5.2'

19.0' TO LT. EDGE PAVEMENT

S.L.M. 235+95

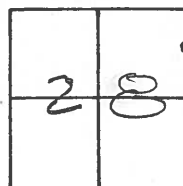

RECORD:
FO PK NAIL ORIGIN UNKNOWN

SET PK/WASHER
10-08-96
SAA

