



O.D.O.T. DISTRICT 2 SURVEY OFFICE (USE ONLY)

PERSONNEL \_\_\_\_\_ REFERENCE NO. 34 A SHEET 2 OF 24  
 NOTES HELDMAN DATE 4-26-2017 ROUTE SR 65  
 H.C. LEU WEATHER SUNNY/WINDY COUNTY HENRY  
 R.C. HELDMAN TEMP. 81° TOWNSHIP DAMASCUS  
 \_\_\_\_\_ SECTION 10  
 \_\_\_\_\_ T 5 N R 8 E

TYPE MONUMENT MAG/WASHER  
 ON SURFACE - ~~BELOW~~ ON  
 LEFT - ☉ PAV'T - ~~RIGHT~~ 2.9'  
6.9' TO LT EDGE PAVEMENT  
 S.L.M. 922+59.67  
 Grid: Northing: 640270.202 Easting: 1575158.012

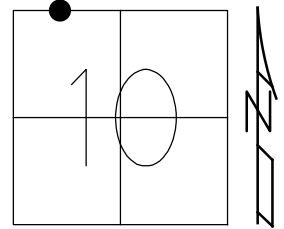

RECORD: P.I.  
 DATA FROM 1924 PLAN  
 STA. 20+50  
 $\Delta = 4^{\circ}-53'-00''$   
 $D = 0^{\circ}-45'-00''$   
 $T = 328.48'$   
 $R = 7705.62$   
 $L = 656.75'$   
 $E = 7.0'$   
 $P.I. = 4^{\circ}53' RT$   
 MEAS. 1974  
 FD P.K./WASHER  
 4/14/03, MB  
 SET MAG/WASHER  
 05/19/03, MC  
 FD MAG/WASHER  
 REFA34  
 2/16/16, DCH  
 SET MAG/WASHER  
 10/4/17, JLL

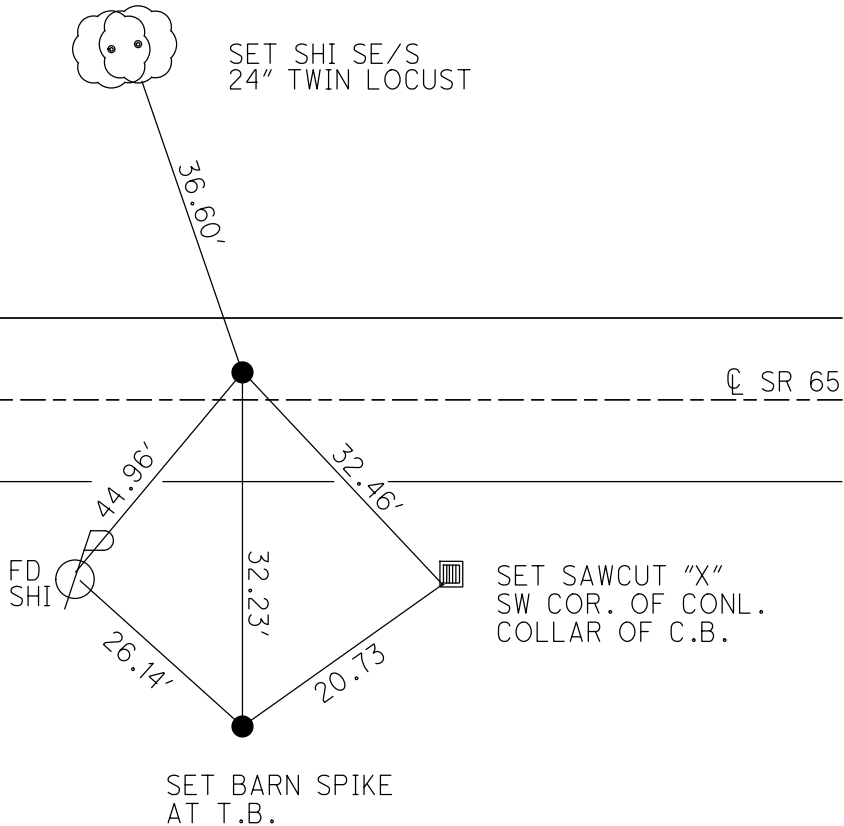

O.D.O.T. DISTRICT 2 SURVEY OFFICE

PERSONNEL

REFERENCE NO. 34-A

SHEET 7 OF 26

NOTES Ryall

H.C. BARNHISEL - DRAWING

DATE 04/14/03

ROUTE 65

R.C. GLASS

WEATHER SUNNY

COUNTY HENRY

TEMP. +56°

TOWNSHIP DAMACUS

SECTION 10

T 5 N R 8 E


TYPE MONUMENT PK & WASHER

ON SURFACE - BELOW yes

LEFT - & PAV'T. - RIGHT 3.4'

6.9' TO LT. EDGE PAVEMENT

S.L.M. 922+09

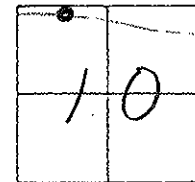

RECORDS: DATA FROM 1924 PLAN

P.I. STA. = 20+50

A = 4° 53' 00"

D = 0° 45' 00"

T = 328.48'

R = 7705.62

L = 656.75'


E = 7.0'

PI = 4° 53' RT MEAS. 1974

RESET MAG NAIL & WASHER

05/19/03

MC

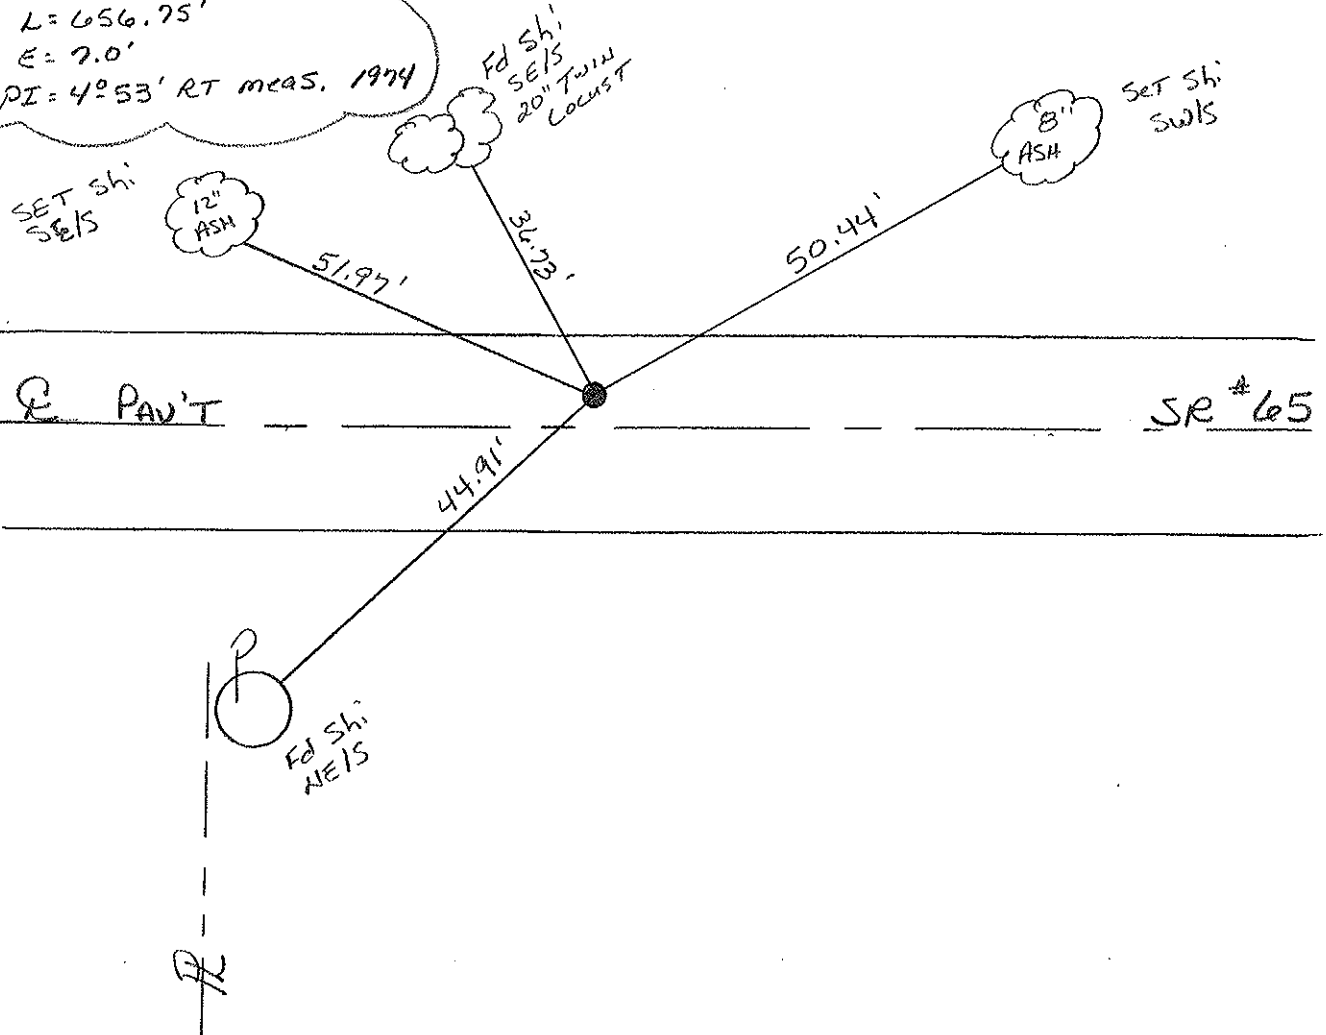

# O.D.O.T. DISTRICT 2 SURVEY OFFICE

PERSONNEL \_\_\_\_\_

REFERENCE NO. 34-A

SHEET \_\_\_\_\_ OF \_\_\_\_\_

NOTES LONG

H.C. VANDUSEN

R.C. BARNHISEL

DATE 9-20-91

WEATHER CLEAR

TEMP. 56°

ROUTE SR 65

COUNTY HENRY

TOWNSHIP DAMASCUS

SECTION 10

T 5 N R 8 E



TYPE MONUMENT PK/WASHER

ON SURFACE - BELOW YES

LEFT- & PAV'T. - RIGHT 3.0'

5.7' TO LT EDGE PAVEMENT

S.L.M. 923+20

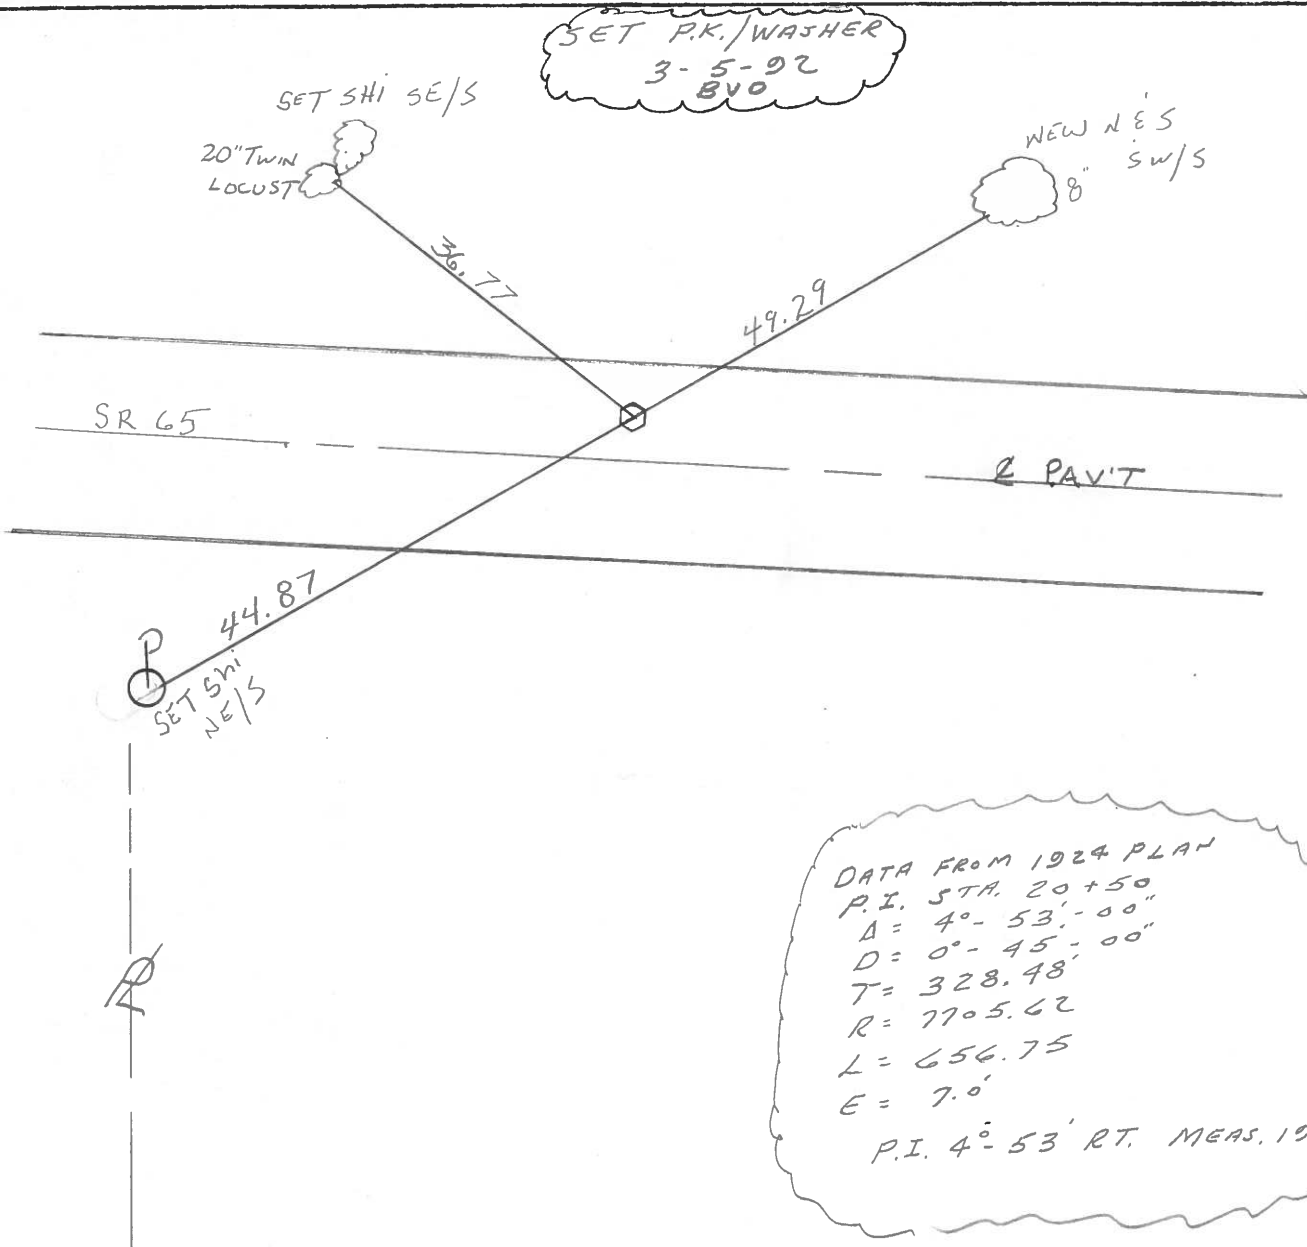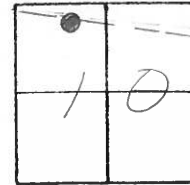

SET P.K./WASHER  
 3-5-92  
 BVO

DATA FROM 1924 PLAN  
 P.I. STA. 20+50  
 $\Delta = 4^{\circ} - 53' - 00''$   
 $D = 0^{\circ} - 45' - 00''$   
 $T = 328.48'$   
 $R = 7705.62'$   
 $L = 656.75'$   
 $E = 7.0'$   
 P.I.  $4^{\circ} - 53'$  RT. MEAS. 1974

County HENRY S.R. 65

Date 2-2-84

Township DAMASCUS

Weather Clear

Section 10

Temp. +30°

T5N, R8E


Personnel HOFFMAN

LOEHMKE H.C.

HOUSEHOLDER R.C.

BARNHISEL

#34-A

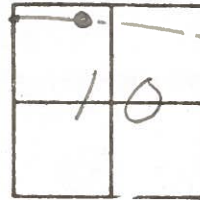

Fd small R.R. SPK 1 1/2" Below Surface

SLM 922+62


3.0' Lt. of  $\phi$  part

5.7' TO Lt. EP.

SET PK/WASHER

9-17-84

S.W.H.

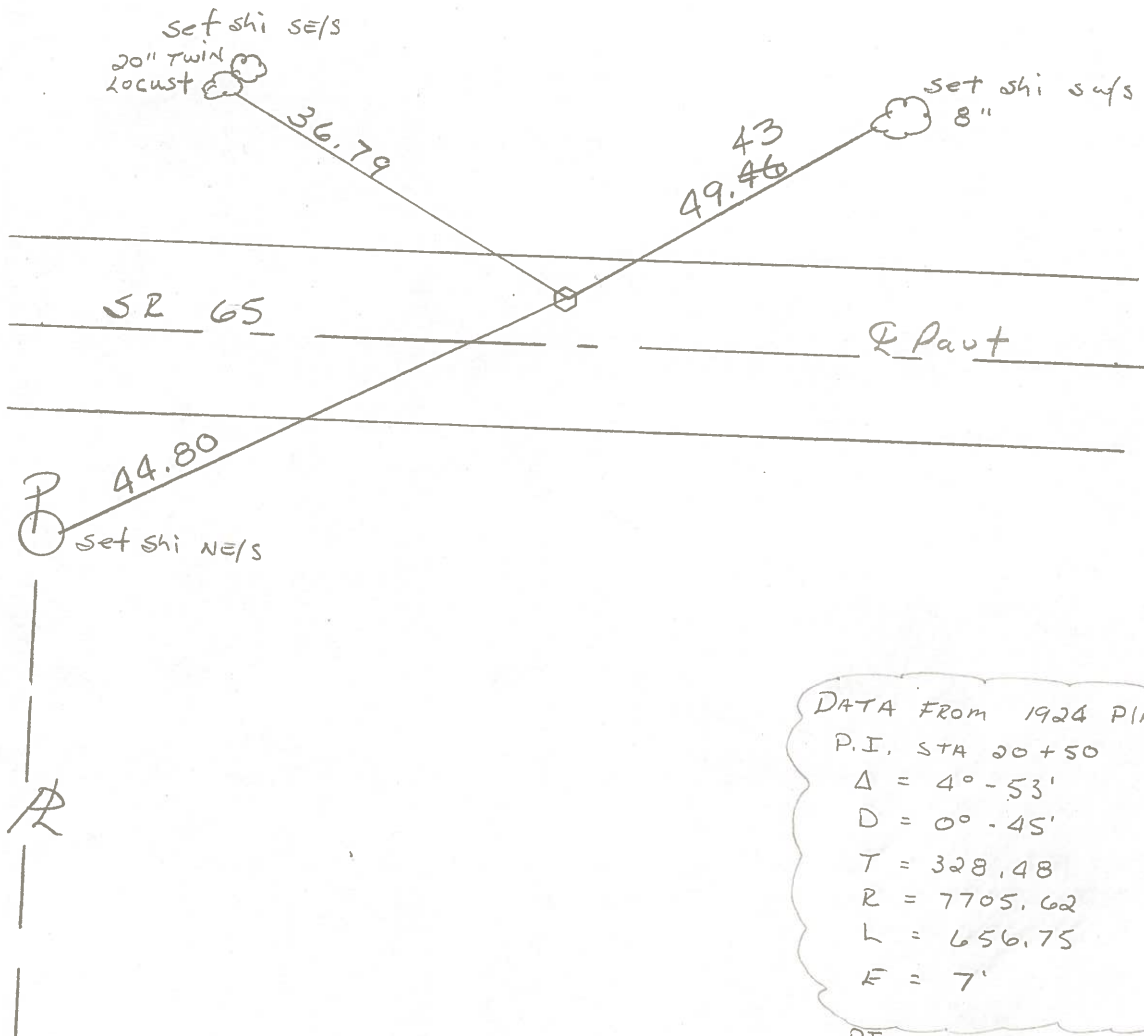

DATA FROM 1924 PLAN  
 P.I. STA 20+50  
 $\Delta = 4^\circ - 53'$   
 $D = 0^\circ - 45'$   
 $T = 328.48$   
 $R = 7705.62$   
 $L = 656.75$   
 $E = 7'$

P.I.  
 $\Delta = 4^\circ - 53' RT. (MEAS 1979)$

SEE S.R. 110 FOR INTER.  
S.R. 110 & S.P. 65

SHEET NO. \_\_\_\_\_

PERSONNEL	TITLE	PERSONNEL	TITLE	COUNTY	DATE
BURNSIDE				HENRY	3-5-74
SMITH				S. R. 65	WEATHER CLEAR
BOWERS				SEC. _____	TEMP. +46°
MEAD					

DESCRIPTION & PLW CONTROL TIES \_\_\_\_\_ JOB NO. \_\_\_\_\_

