


O.D.O.T. DISTRICT 2 SURVEY OFFICE (USE ONLY)

PERSONNEL _____ REFERENCE NO. 36 PC SHEET 10 OF 27
 NOTES MILLER DATE 3/29/24 ROUTE SR 65
 H.C. MILLER WEATHER SUNNY COUNTY HENRY
 R.C. NIESE TEMP. 43° TOWNSHIP DAMASCUS
 DWG BY RHOADES PID 119500 SECTION 11
 T 5 N R 8 E

TYPE MONUMENT MAG/WASHER
 ON SURFACE - ~~BELOW~~ ON
 OFFSET \varnothing PAVEMENT _____ LT : RT
 _____ TO _____ EDGE PAVEMENT
 STATION: _____

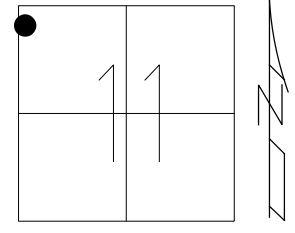


HORIZ. DATUM: NAD83 2011 GEOID: NAVD88 2018
 GRID: NORTHING: _____ EASTING: _____

HEN LDP
 N: 497226.879
 E: 213344.976

RECORD:
 SET MAG/WASHER
 REF36PC
 3/29/24, JAM

TOP SE
 BOLT

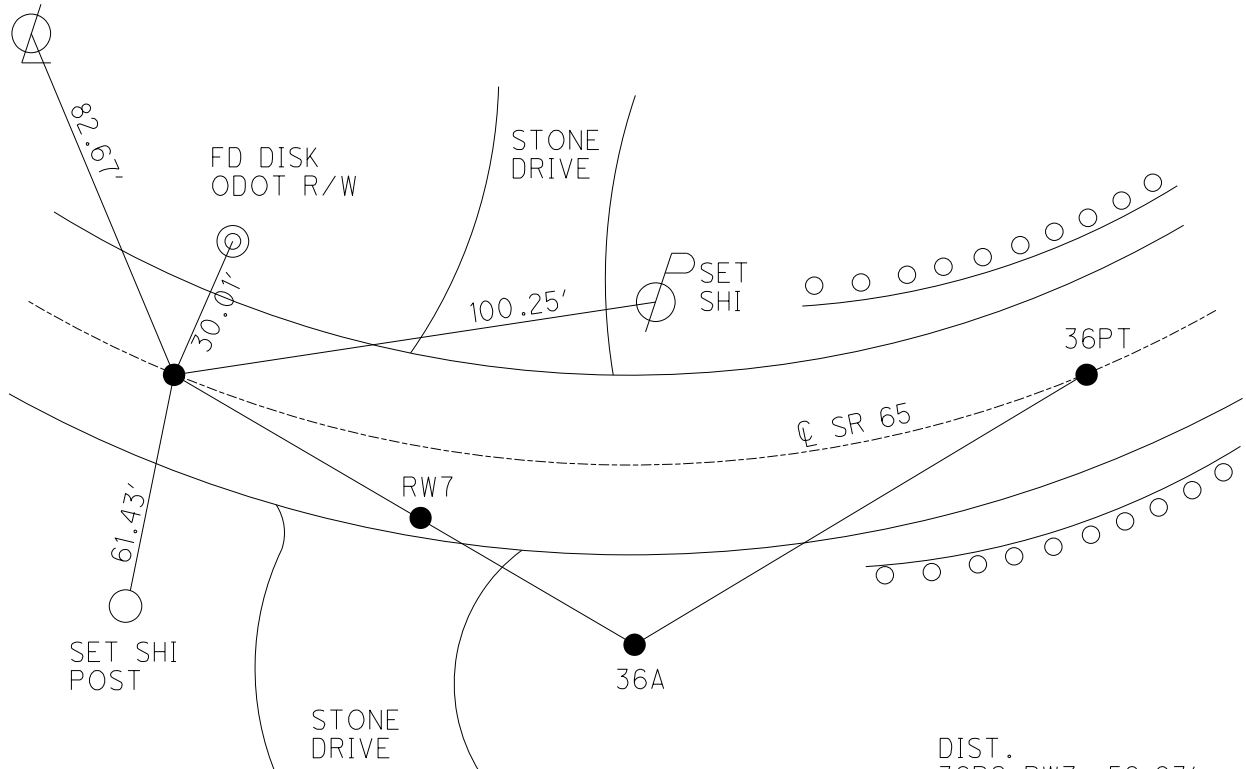

DIST.
 36PC-RW7= 59.93'
 RW7-36PT= 126.76'