

O.D.O.T. DISTRICT 2 SURVEY OFFICE (USE ONLY)

PERSONNEL

REFERENCE NO. RW7

SHEET 11 OF 27

NOTES MILLER

DATE 3/29/24

ROUTE SR 65

H.C. MILLER

WEATHER SUNNY

COUNTY HENRY

R.C. NIESE

TEMP. 43°

TOWNSHIP DAMASCUS

SECTION 11

DWG BY RHOADES

PID 119500

T 5 N R 8 E

TYPE MONUMENT MAG/WASHER

ON SURFACE - ~~BELOW~~ ON

OFFSET \odot PAVEMENT _____ LT : RT

_____ TO _____ EDGE PAVEMENT


STATION: _____

HORIZ.DATUM: NAD83 2011

GEOID: NAVD88 2018


GRID: NORTHING: _____

EASTING: _____

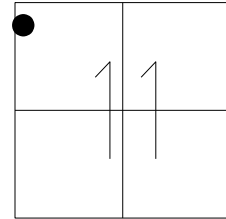

RECORD:
SET MAG NAIL
REFRW7
3/29/24, JAM

HEN LDP
N: 497223.262
E: 213404.861

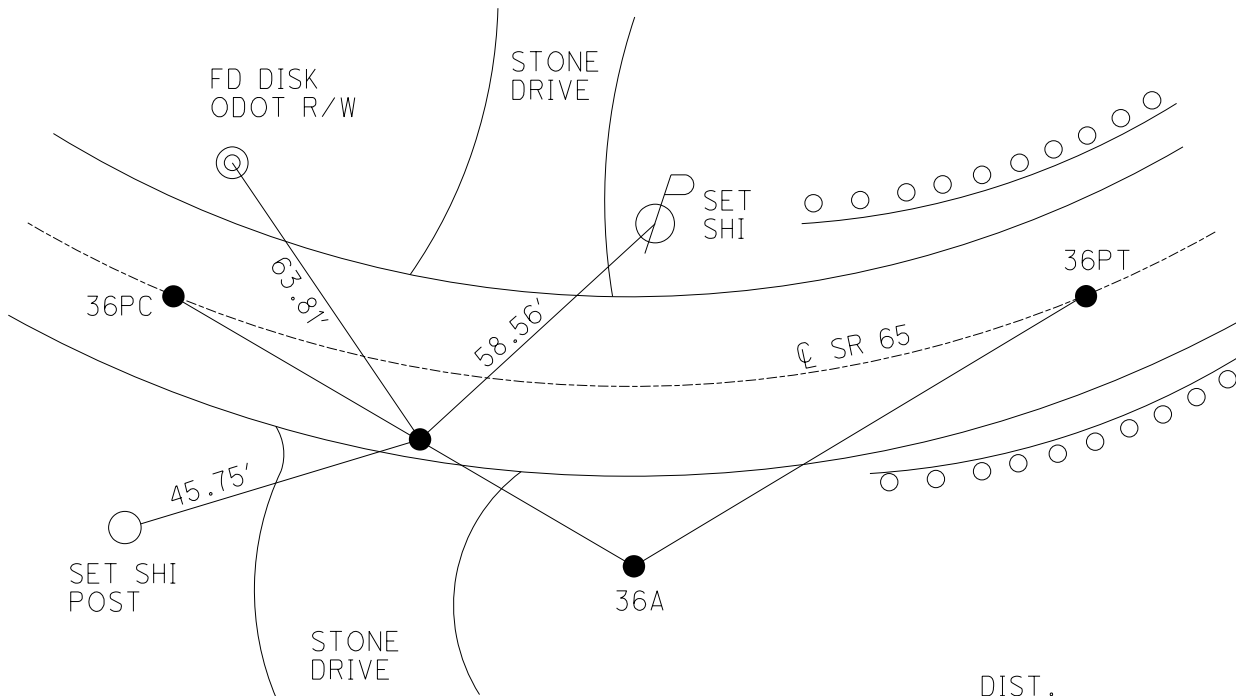

DIST.
36PC-RW7= 59.93'
RW7-36PT= 126.76'