

O.D.O.T. DISTRICT 2 SURVEY OFFICE (USE ONLY)

PERSONNEL \_\_\_\_\_ REFERENCE NO. 36 A SHEET 12 OF 27  
 NOTES MILLER DATE 5/2/23 ROUTE SR 65  
 H.C. MILLER WEATHER MIST COUNTY HENRY  
 R.C. RHOADES TEMP. 45° TOWNSHIP DAMASCUS  
 DWG BY RHOADES PID 119500 SECTION 11  
 T 5 N R 8 E

TYPE MONUMENT 3/4" IPIN

~~ON SURFACE~~ - BELOW 3"


OFFSET  $\odot$  PAVEMENT 28.2'  $\pm$  : RT

16' RT TO RT EDGE PAVEMENT

STATION: 961+80.86


HORZ.DATUM: NAD83 2011 GEOID: NAVD88 2018

GRID: NORTHING: 639967.093 EASTING: 1579057.626

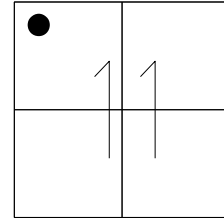

RECORD: P.I.  
 DATA FROM 1924 PLAN  
 STA. 59+76.8  
 $\Delta = 41^{\circ}30'$   
 $D = 22^{\circ}06' 00''$   
 $T = 98.31'$   
 $R = 259.48'$   
 $L = 187.94'$   
 $E = 18'$   
 FD 3/4" IPIN  
 2" BELOW  
 4/14/03, MB  
 FD 3/4" IPIN  
 3" BELOW  
 REFA36  
 2/16/16, DCH  
 FD 3/4" IPIN  
 2" DOWN  
 REFA36  
 11-8-21, JFO  
 FD 3/4" IPIN  
 REFA36  
 3/16/23, TDN  
 FD 3/4" IPIN  
 3" DOWN IN HOLE  
 REF36A  
 5/2/23, JAM

HEN LDP  
 N: 497209.619  
 E: 213441.849

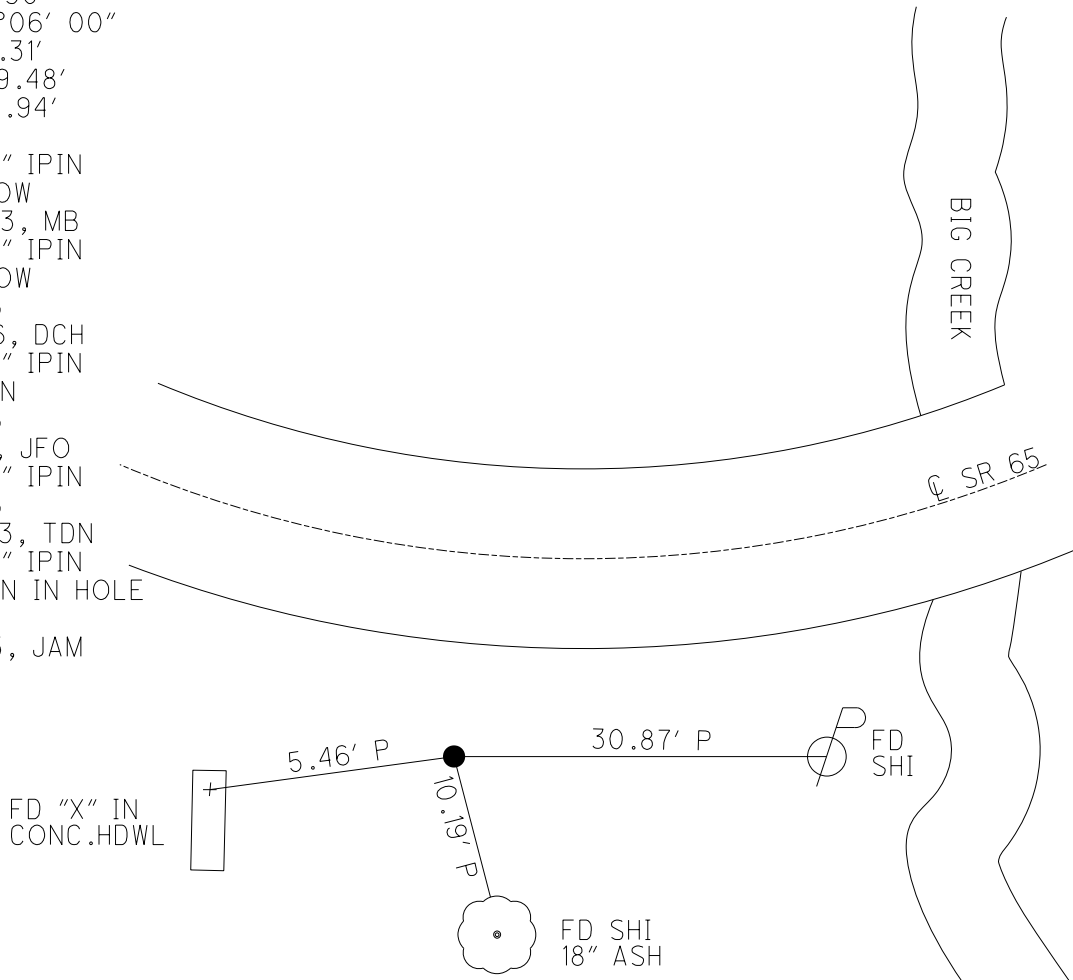

**O.D.O.T. DISTRICT 2 SURVEY OFFICE (USE ONLY)**

PERSONNEL

REFERENCE NO. 36 A

SHEET 10 OF 24

NOTES RHOADES

DATE 4/27/17

ROUTE SR 65

H.C. LEU

WEATHER CLOUDY

COUNTY HENRY

R.C. HELDMAN

TEMP. 67°

TOWNSHIP DAMASCUS

SECTION 11

DWG BY RHOADES

PID R/W

T 5 N R 8 E

TYPE MONUMENT 3/4" IPIN

~~ON SURFACE~~ - BELOW 3"

OFFSET  $\odot$  PAVEMENT 28.2' ~~LT~~ : RT

16' RT TO RT EDGE PAVEMENT


STATION: 961+80.86

HORZ. DATUM: NAD83 2011

GEOID: NAVD88 2018

GRID: NORTHING: 639967.093

EASTING: 1579057.626

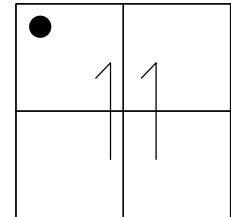

RECORD: P.I.

DATA FROM 1924 PLAN

STA. 59+76.8

= 41°30'

D = 22°06' 00"

T = 98.31'

R = 259.48'

L = 187.94'

E = 18'

FD 3/4" IPIN

2" BELOW

4/14/03, MB

FD 3/4" IPIN

3" BELOW

REFA36

2/16/16, DCH

FD 3/4" IPIN

2" DOWN


REFA36

11-8-21, JFO

FD 3/4" IPIN

REFA36


3/16/23, TDN

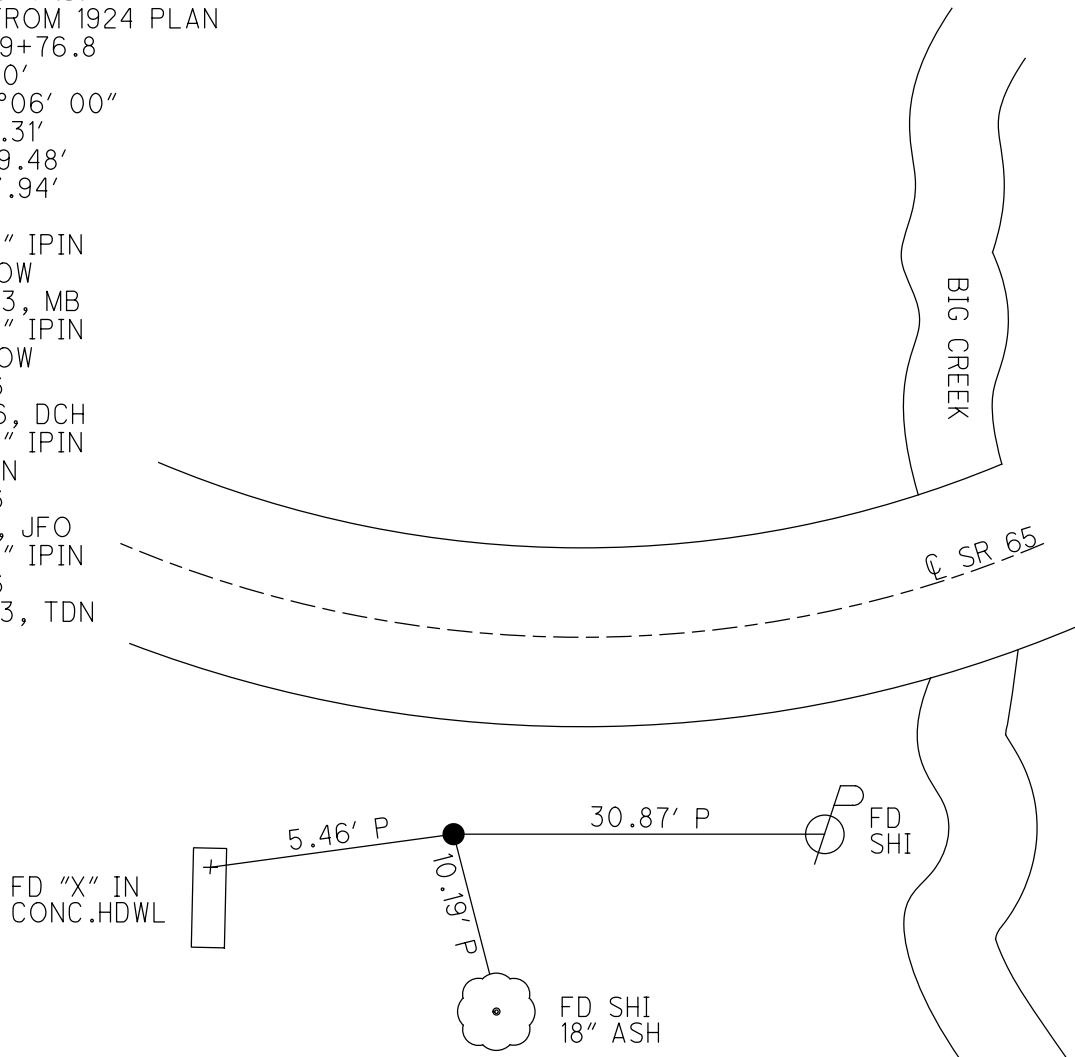


O.D.O.T. DISTRICT 2 SURVEY OFFICE (USE ONLY)

PERSONNEL \_\_\_\_\_ REFERENCE NO. 36 A SHEET 10 OF 24  
 NOTES RHOADES DATE 4-27-17 ROUTE SR 65  
 H.C. LEU WEATHER CLOUDY COUNTY HENRY  
 R.C. HELDMAN TEMP. 67° TOWNSHIP DAMACUS  
 SECTION 11  
 T 5 N R 8 E

TYPE MONUMENT 3/4" IPIN  
~~ON SURFACE~~ - BELOW 3"  
~~LEFT~~ - ℄ PAV'T - RIGHT 28.2'  
16' RT OF RT EDGE PAVEMENT  
 S.L.M. 961+80.86  
 Grid: Northing: 639967.125 Easting: 1579057.640

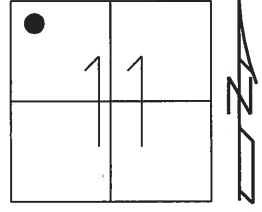

RECORD: P.I.  
 DATA FROM 1924 PLAN  
 STA. 59+76.8  
 $\Delta = 41^{\circ}30'$   
 $D = 22^{\circ}06' 00''$   
 $T = 98.31'$   
 $R = 259.48'$   
 $L = 187.94'$   
 $E = 18'$   
 FD 3/4" IPIN  
 2" BELOW  
 4/14/03, MB  
 FD 3/4" IPIN  
 3" BELOW  
 REFA36  
 2/16/16, DCH

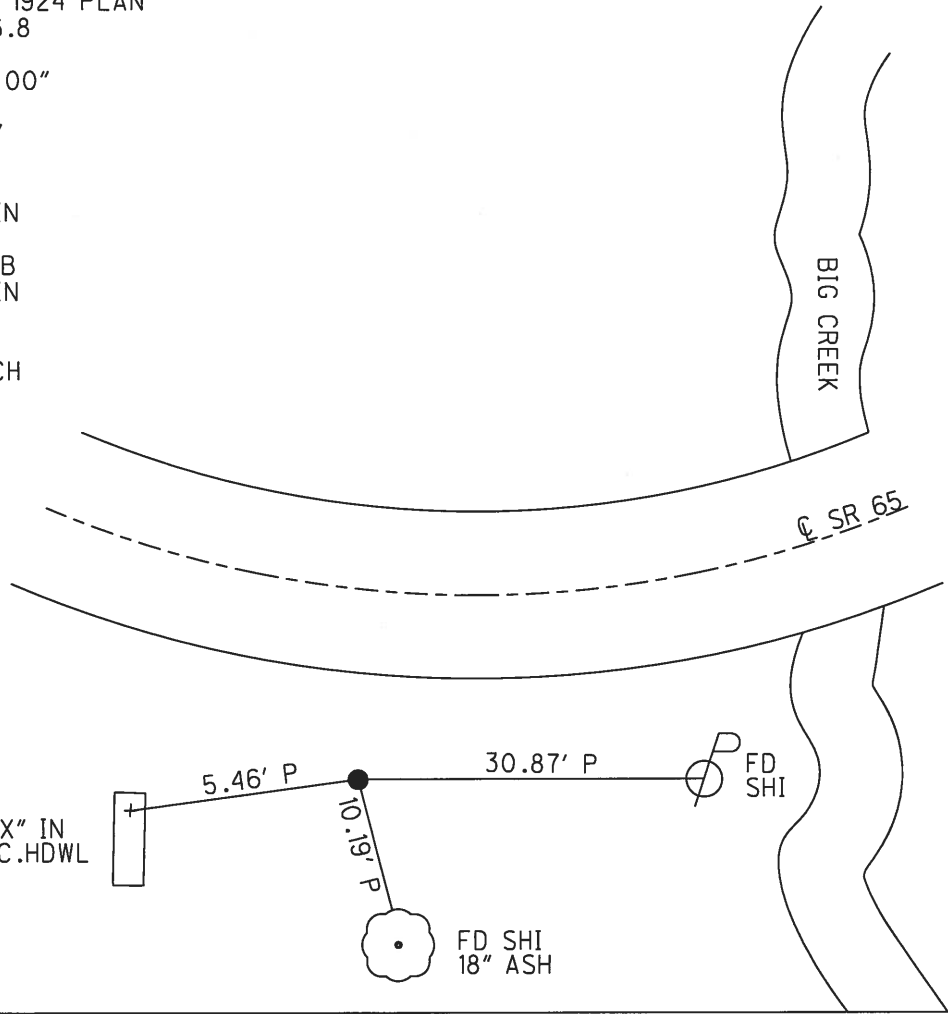

O.D.O.T. DISTRICT 2 SURVEY OFFICE

PERSONNEL \_\_\_\_\_

REFERENCE NO. 36-A

SHEET 14 OF 26

NOTES BARNHISEL - HC

H.C. \_\_\_\_\_

DATE 04/14/03

ROUTE 65

R.C. GLASS

WEATHER SUNNY

COUNTY HENRY

RYALL

TEMP. +56°

TOWNSHIP DAMACUS

SECTION 11

T 5 N R 8 E


TYPE MONUMENT 3/4" IRON ROD

ON SURFACE - BELOW 2"

LEFT - & PAV'T. - RIGHT 27.6'

16' RT TO DE RT EDGE PAVEMENT

S.L.M. 961+26

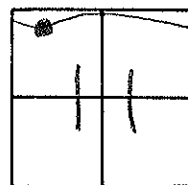

RECORD: DATA 1924 PLAN

PI STA: 59+76.8

A = 41°-30'


D = 22°-06'

T = 98.31'

R = 259.48'

L = 187.94'

E = 18'

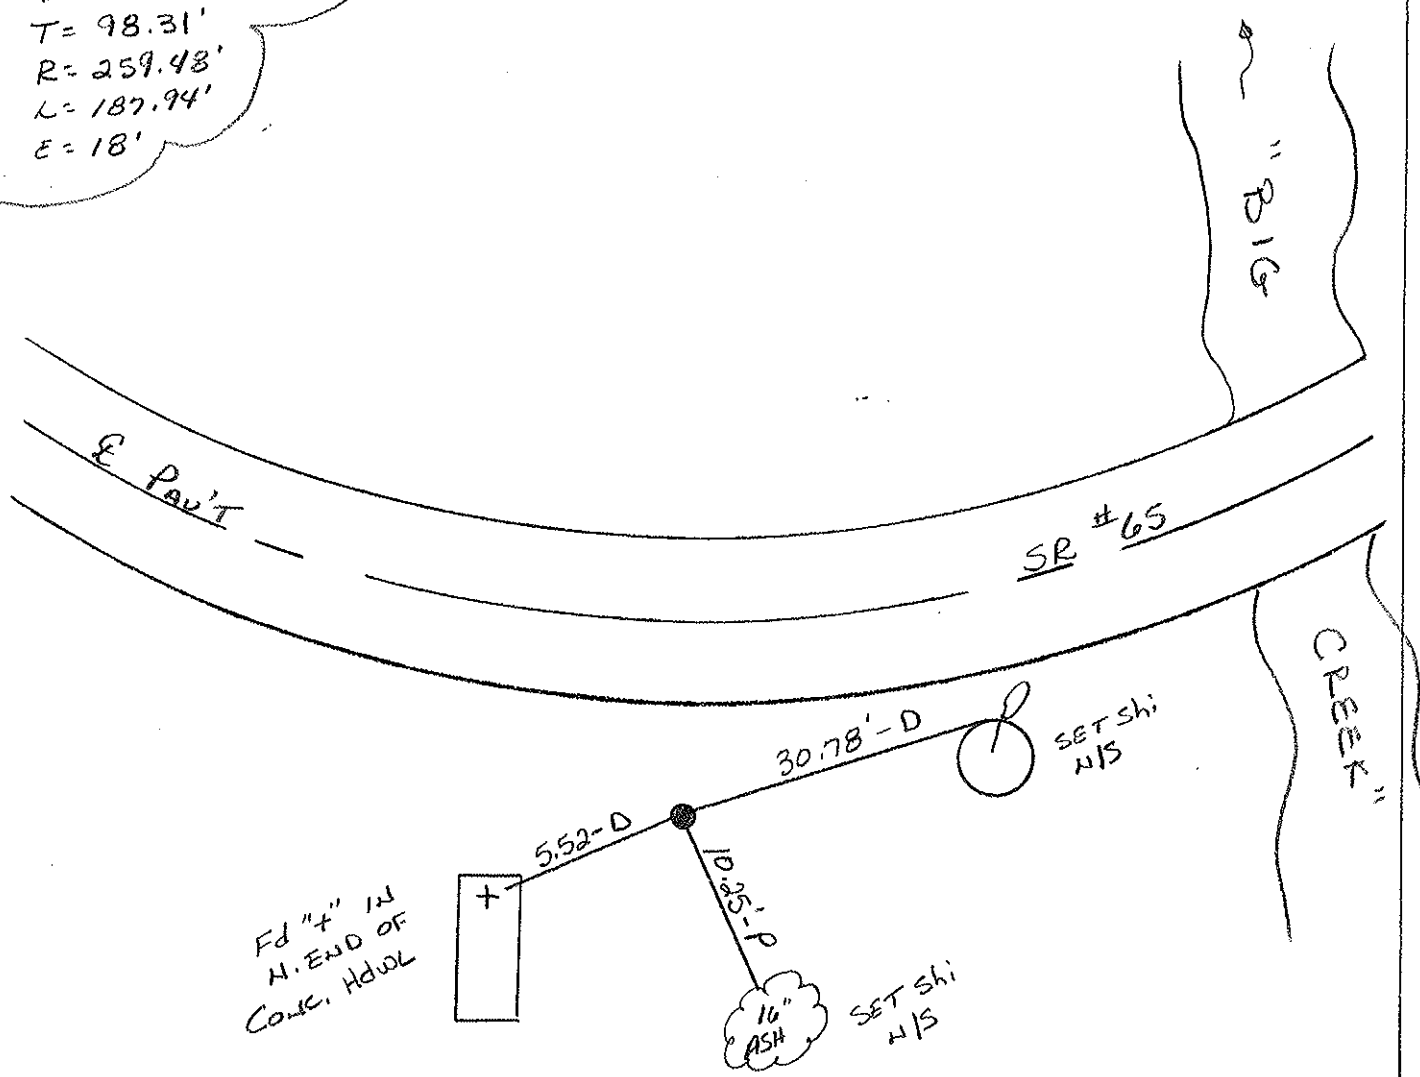

# O.D.O.T. DISTRICT 2 SURVEY OFFICE

PERSONNEL \_\_\_\_\_

REFERENCE NO. 36-A

SHEET \_\_\_\_\_ OF \_\_\_\_\_

NOTES Ripple

H.C. BARBOUR

R.C. Geyman

DATE 9-20-91

WEATHER clear

TEMP. +56°

ROUTE 65

COUNTY HENRY

TOWNSHIP DAMASCUS

SECTION 11

T 5 N R 8 E


TYPE MONUMENT 3/4" I-Rod

ON SURFACE - BELOW yes


LEFT - C PAV'T. - RIGHT 27.6

16.75 <sup>RT</sup> OF RT EDGE PAVEMENT

S.L.M. \_\_\_\_\_

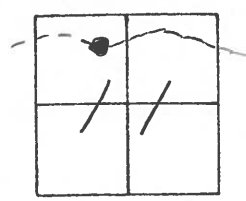

RECORD: CURVE DATA  
 1924 PLAN  
 P.I. STA: 59+76.8  
 $\Delta = 41^{\circ}-30'$   
 $D = 22^{\circ}-06'$   
 $T = 98.31$   
 $R = 259.48$   
 $L = 187.94$   
 $E = 18'$

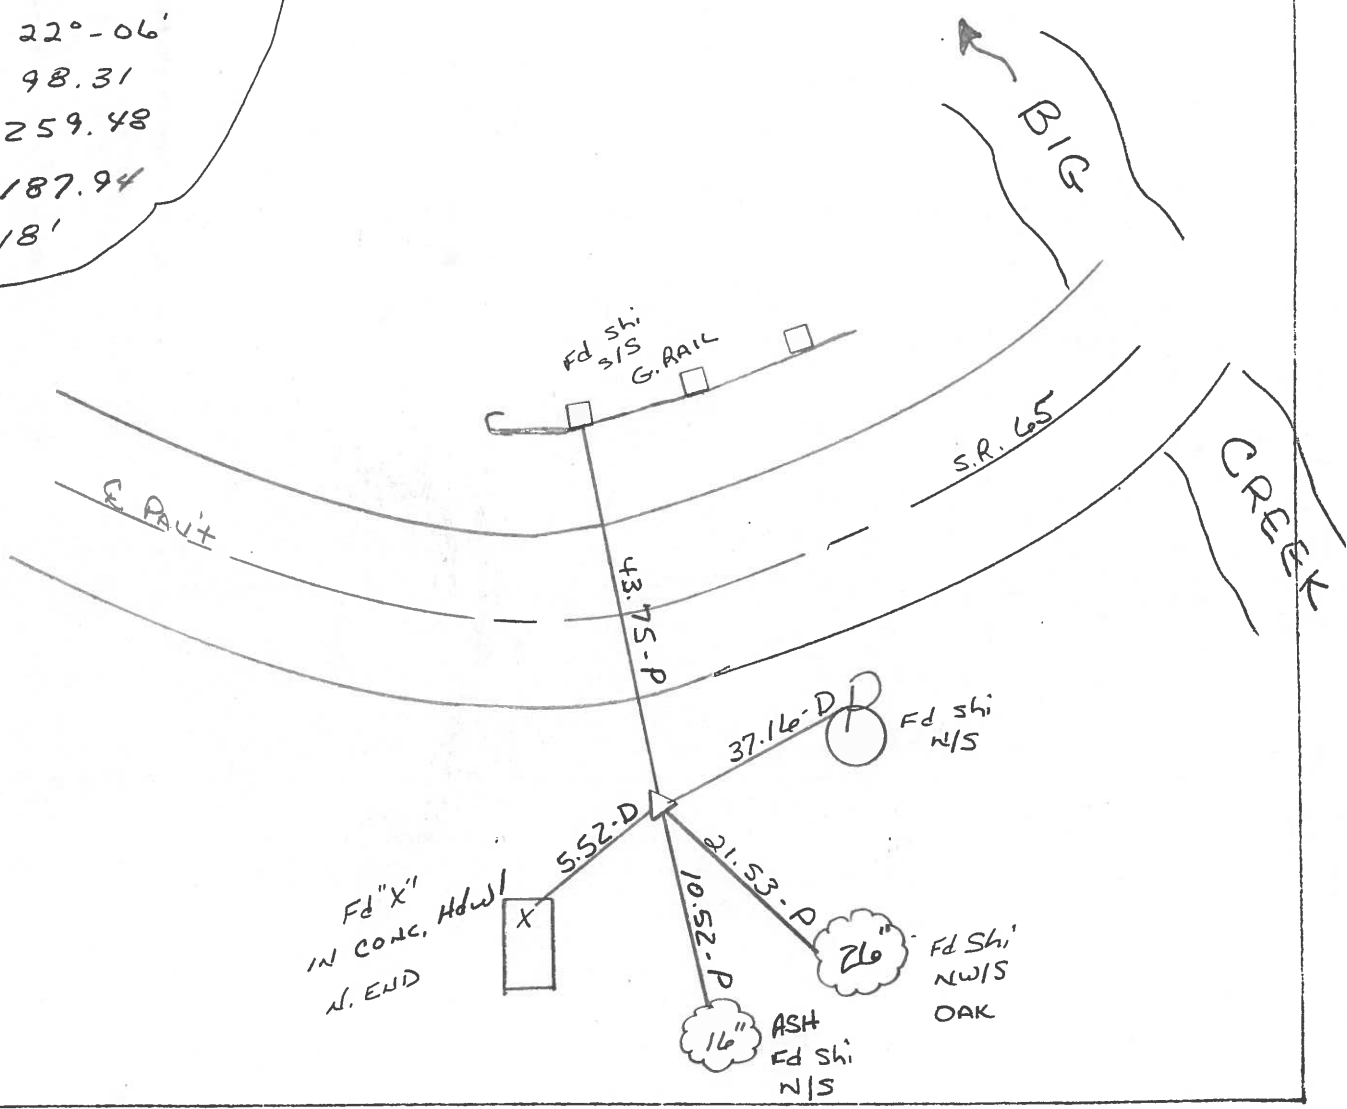

County HENRY S.R. 65

Date 7-19-82

Township DAMASCUS

Weather Humid

Section 11

Temp. +80°


TSN, R&E

Personnel Hoffman

Householder


Loehrke

36-A

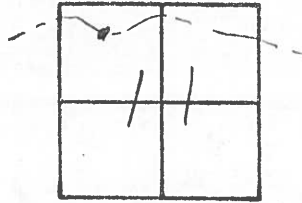

Fd 3/4" IRON ROD @ surface  
27.6 S of Paut  
16.7 S of S.E.P.

DID NOT CHECK THIS  
DATE.  
2-2-88 SW4

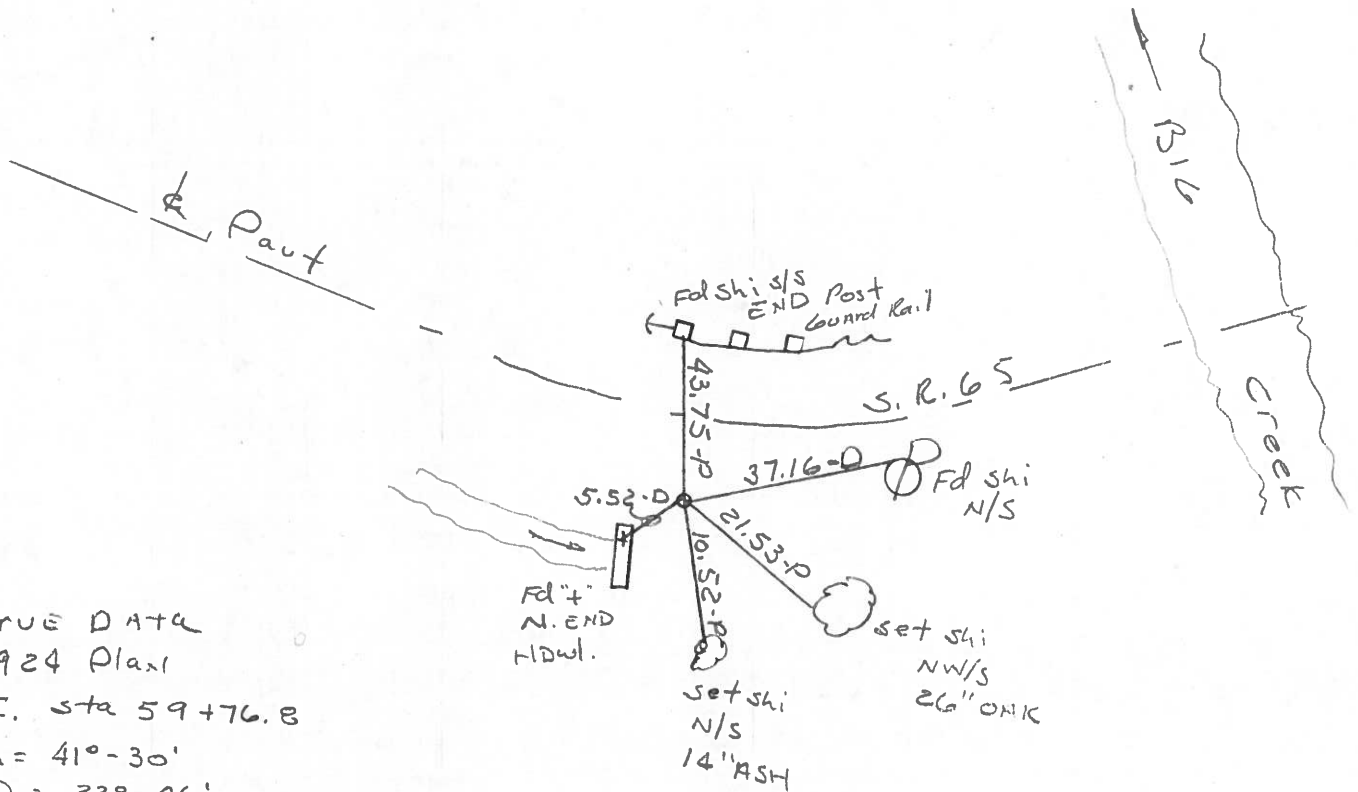

CURVE DATA  
1924 Plan  
P.I. sta 59+76.8  
 $\Delta = 41^\circ - 30'$   
 $D = 22^\circ - 06'$   
 $T = 98.31$   
 $R = 259.48$   
 $L = 187.94$   
 $E = 18'$



PERSONNEL TITLE PERSONNEL TITLE  
BURNSIDE \_\_\_\_\_  
SMITH \_\_\_\_\_  
BOWERS \_\_\_\_\_  
MEAD \_\_\_\_\_

COUNTY HENRY DATE 3-6-74  
 S. R. 65 WEATHER CLOUDY  
 SEC. \_\_\_\_\_ TEMP. +43°

DESCRIPTION ± RW CONTROL TIES JOB NO. \_\_\_\_\_

