


O.D.O.T. DISTRICT 2 SURVEY OFFICE (USE ONLY)

PERSONNEL \_\_\_\_\_ REFERENCE NO. 37 B SHEET 16 OF 27  
 NOTES MILLER DATE 5/2/23 ROUTE SR 65  
 H.C. MILLER WEATHER MIST COUNTY HENRY  
 R.C. RHOADES TEMP. 45° TOWNSHIP DAMASCUS  
 DWG BY RHOADES PID 119500 SECTION 11  
 T 5 N R 8 E

TYPE MONUMENT MAG/WASHER  
 ON SURFACE - ~~BELOW~~ ON  
 OFFSET  $\text{C}$  PAVEMENT 9.7' LT : ~~R~~  
ON TO LT EDGE PAVEMENT  
 STATION: 979+29.15

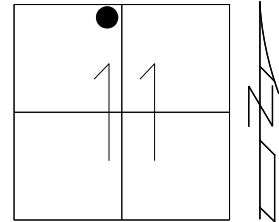

HORIZ.DATUM: NAD83 2011 GEOID: NAVD88 2018  
 GRID: NORTHING: 640289.631 EASTING: 1580746.616


RECORD: P.I.  
 DATA FROM 1924 PLAN  
 STA. 77+58.2  
 $\Delta = 16^\circ - 47'$   
 $\Delta = 16^\circ 14' 20''$   
 MEAS. 1974  
 $D = 10^\circ 21' 00''$   
 $T = 81.62'$   
 $R = 553.28'$   
 $L = 162.08'$   
 $E = 6'$

HEN LDP  
 N: 497563.074  
 E: 215124.736

SET MAG/WASHER  
 05/19/03, MC  
 FD P.K./WASHER  
 4/14/04, MB  
 FD MAG/WASHER  
 REFB37  
 2/16/16, DCH  
 SET MAG/WASHER  
 10-5-17, JLL  
 FD MAG/WASHER  
 REFB37  
 3/16/23,  
 5/2/23, JAM

SET SHI'S  
 GR POSTS

SET NOTCH  
 GR POST

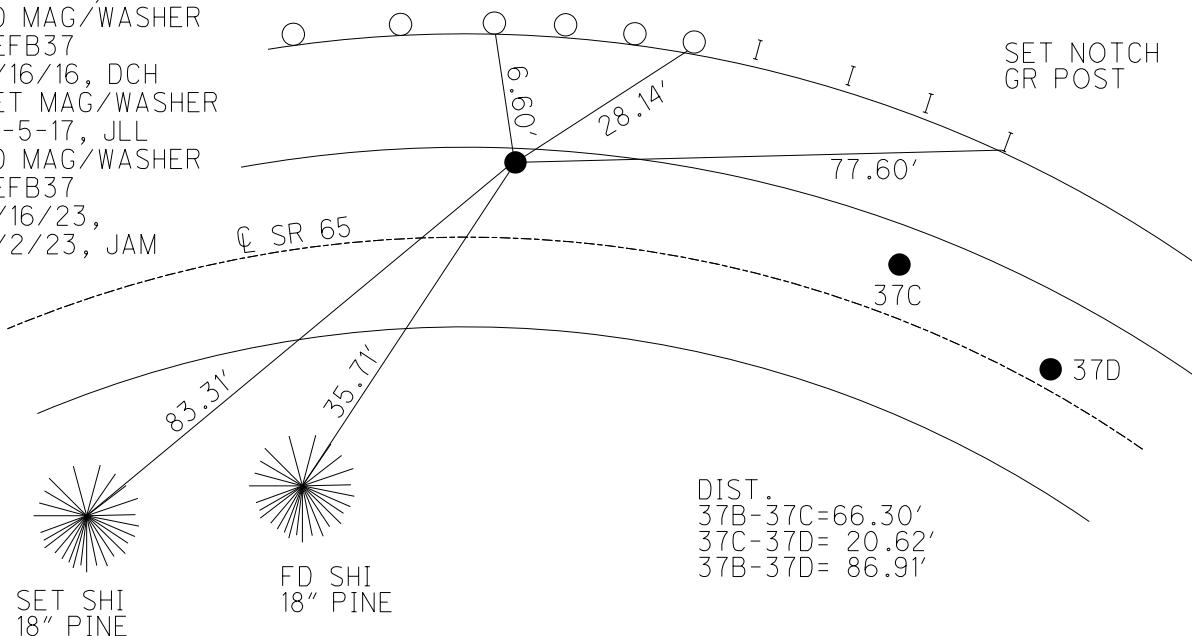

DIST.  
 37B-37C=66.30'  
 37C-37D= 20.62'  
 37B-37D= 86.91'

**O.D.O.T. DISTRICT 2 SURVEY OFFICE (USE ONLY)**

PERSONNEL

REFERENCE NO. 37 B

SHEET 13 OF 24

NOTES RHOADES

DATE 4/27/17

ROUTE SR 65

H.C. LEU

WEATHER CLOUDY

COUNTY HENRY

R.C. HELDMAN

TEMP. 67°

TOWNSHIP DAMASCUS

SECTION 11

DWG BY RHOADES PID R/W

T 5 N R 8 E

TYPE MONUMENT MAG/WASHER

ON SURFACE - ~~BELOW~~ ON

OFFSET Q PAVEMENT 9.7' LT : ~~RT~~

ON TO LT EDGE PAVEMENT


STATION: 979+29.15

HORZ. DATUM: NAD83 2011

GEOID: NAVD88 2018

GRID: NORTHING: 640289.631

EASTING: 1580746.616

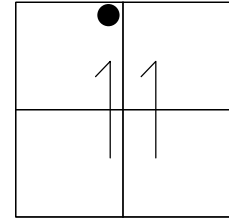


RECORD: P.I.  
 DATA FROM 1924 PLAN  
 STA. 77+58.2  
 $\Delta = 16^\circ - 47'$   
 $\Delta = 16^\circ 14' 20''$   
 MEAS. 1974  
 $D = 10^\circ 21' 00''$   
 $T = 81.62'$   
 $R = 553.28'$   
 $L = 162.08'$   
 $E = 6'$

DIST.  
 37B-37C=66.30'  
 37C-37D= 20.62'  
 37B-37D= 86.91'

SET MAG/WASHER  
 05/19/03, MC  
 FD P.K./WASHER  
 4/14/04, MB  
 FD MAG/WASHER  
 REFB37  
 2/16/16, DCH  
 SET MAG/WASHER  
 10-5-17, JLL  
 FD MAG/WASHER  
 REFB37  
 3/16/23, JAM

SET SHI'S  
 GR POSTS


SET NOTCH  
 GR POST

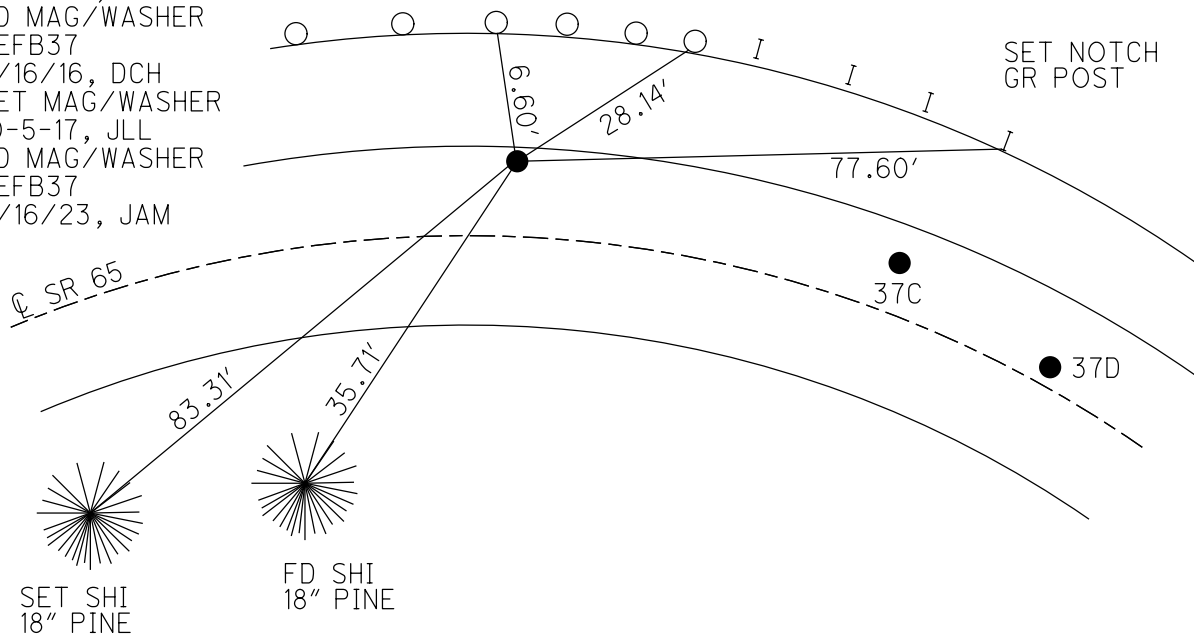

O.D.O.T. DISTRICT 2 SURVEY OFFICE (USE ONLY)


PERSONNEL \_\_\_\_\_ REFERENCE NO. 37 B SHEET 13 OF 24  
 NOTES RHOADES DATE 4-27-17 ROUTE SR 65  
 H.C. LEU WEATHER CLOUDY COUNTY HENRY  
 R.C. HELDMAN TEMP. 67° TOWNSHIP DAMACUS  
 SECTION 11  
 T 5 N R 8 E

TYPE MONUMENT MAG/WASHER  
 ON SURFACE - ~~BELOW~~ ON \_\_\_\_\_  
 LEFT - ℄ PAV'T - ~~RIGHT~~ 9.7'  
 ON ON LT EDGE PAVEMENT  
 S.L.M. 979+29.15  
 Grid: Northing: 640289.646 Easting: 1580746.629

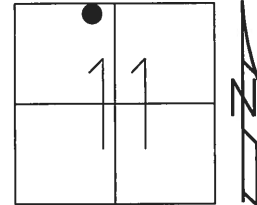

RECORD: P.I.  
 DATA FROM 1924 PLAN  
 STA. 77+58.2  
 $\Delta = 16^\circ - 47'$   
 $\Delta = 16^\circ 14' 20''$   
 MEAS. 1974  
 $D = 10^\circ 21' 00''$   
 $T = 81.62'$   
 $R = 553.28'$   
 $L = 162.08'$   
 $E = 6'$

DIST.  
 37B-37C=66.30'  
 37C-37D= 20.62'  
 37B-37D= 86.91'

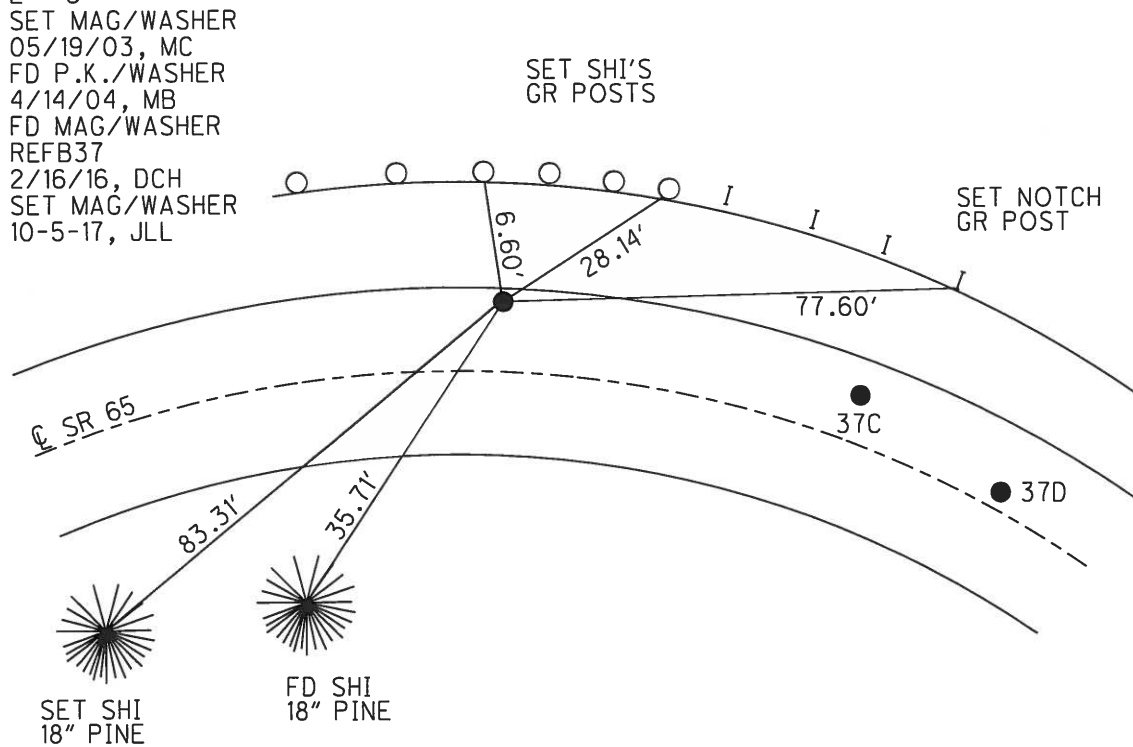

# O.D.O.T. DISTRICT 2 SURVEY OFFICE

PERSONNEL

REFERENCE NO. 37-B

SHEET 17 OF 26

NOTES BARNHISEL -H.C.

H.C. \_\_\_\_\_

R.C. GLASS

RYALL

DATE 4-14-04

WEATHER CLEAR

TEMP. +60°

ROUTE 65

COUNTY HENRY

TOWNSHIP DAMACUS

SECTION 11

T 5 N R 8 E


TYPE MONUMENT P.K. & WASHER

ON SURFACE - BELOW SURFACE

LEFT - CL PAV'T. - RIGHT 9.6'


ON TO LT. EDGE PAVEMENT

S.L.M. 978+66

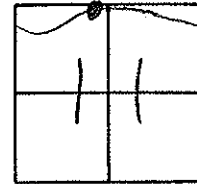

Record: DATA 1924 PLAN  
 PI STA: 77+58.2  
 $\Delta = 16^\circ 47'$  ( $16^\circ 14' 20''$  meas. 1924)  
 $D = 10^\circ 21'$   
 $T = 81.62'$   
 $R = 553.28'$   
 $L = 162.08'$   
 $E = 6'$

RESET MAG/WASHER  
 5-19-03  
 M.C.

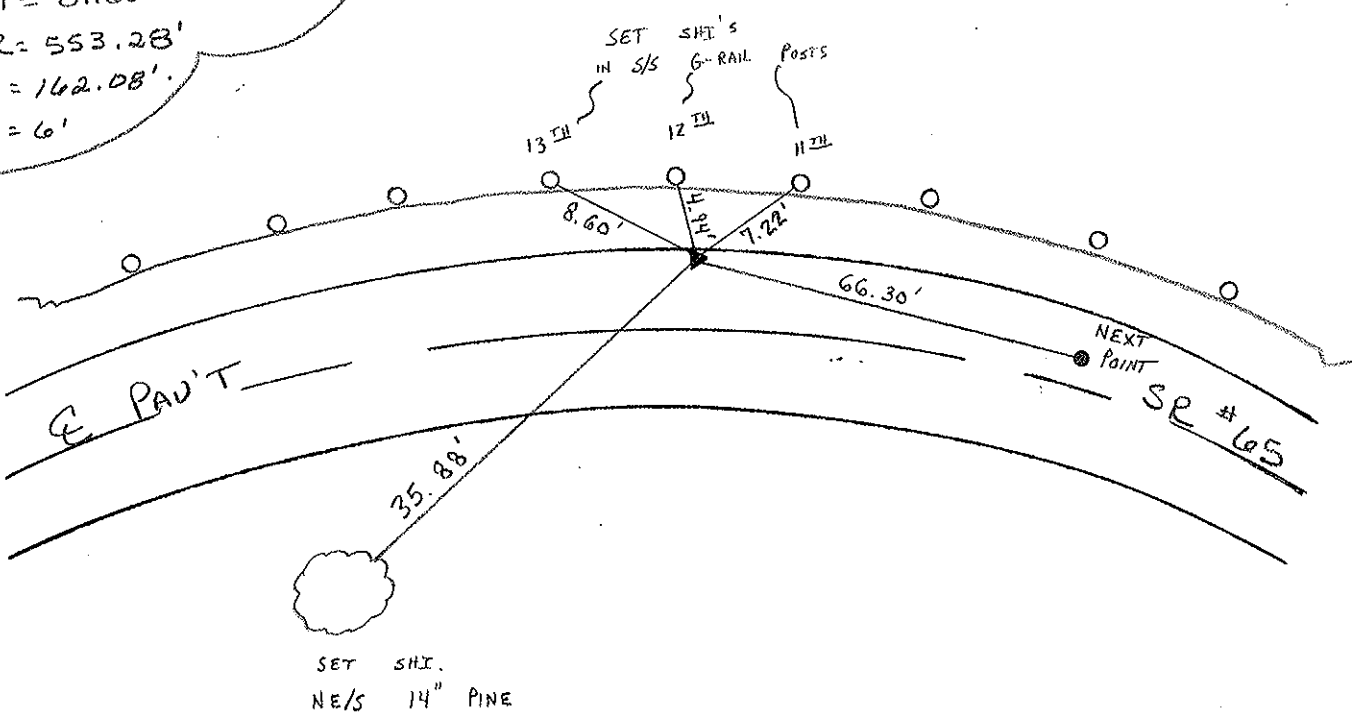

# O.D.O.T. DISTRICT 2 SURVEY OFFICE

PERSONNEL

REFERENCE NO. 37-A

SHEET      OF     

NOTES BARNHISEL

H.C. BARBOUR

R.C. Geyman

Ripple

DATE 9-20-92

WEATHER CLEAR

TEMP. +56°

ROUTE 65

COUNTY HENRY

TOWNSHIP DAMASCUS

SECTION 11

T 5 N R 8 E


TYPE MONUMENT P.K. & WASHER

ON SURFACE - BELOW yes

LEFT- & PAV'T. - RIGHT 9.6

ON TO LT EDGE PAVEMENT


S.L.M. 979+77

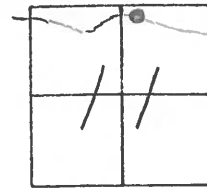

Set P.K. & Washer  
3-5-92  
MB

Record P.I.  
CURVE DATA 1924 PLAN  
STA: 77+58.2  
 $\Delta = 16^{\circ}-47'$  ( $16^{\circ}-14'-20''$  MEAS)<sup>1974</sup>  
D = 10'-21"  
T = 81.62'  
R = 553.28'  
L = 162.08'  
E = 6'

SET Shi's  
IN G. RAIL POSTS  
? S/S ?

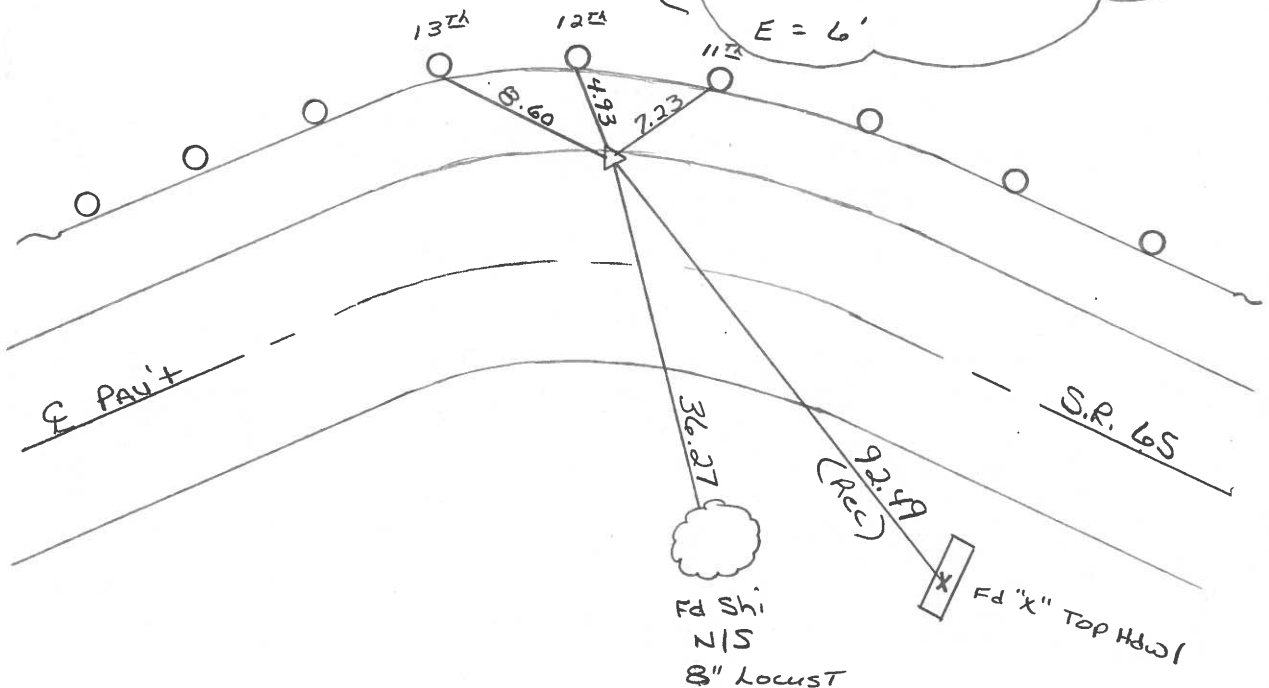

County Henry S.R. 65

Date 7-19-82

Township DAMASCUS

Weather Cloudy - Humid

Section 11

Temp. +80°


T5N, R0E

Personnel Hoffman

Householder

Loehrke


37-A

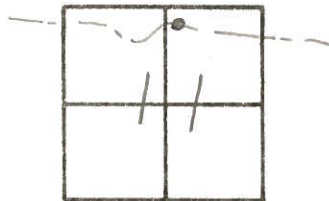

Fd R.E. spk 2" Below surface  
 9.8' N. of & Pavt  
 0.5' N. of N.E.P.

S.L.M. 979+33

SET PK/WASHER  
 9-17-84  
 S.W.H.

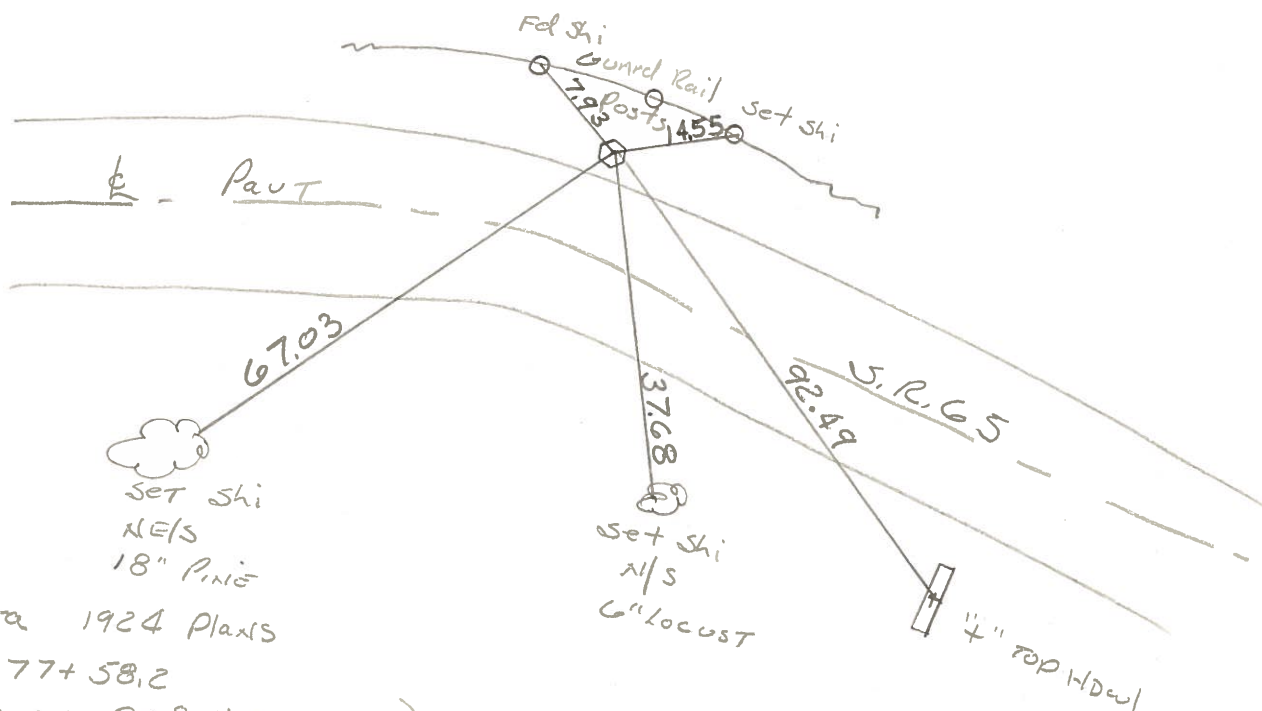

CURVE DATA 1924 Plants

P.I. Sta. 77+58.2

$\Delta = 16^\circ 47'$  ( $16^\circ 14' - 20'$  MEAS.)

D = 10'-21'

T = 81.62'

R = 553.28

L = 162.08

E = 6'



PERSONNEL	TITLE	PERSONNEL	TITLE	COUNTY	DATE
BURNSIDE				HENRY	3-6-74
SMITH				S. R. 65	WEATHER CLOUDY
BOWERS				SEC. _____	TEMP. +44°
MEAD					
DESCRIPTION	± PAV CONTROL TIES			JOB NO.	

