


O.D.O.T. DISTRICT 2 SURVEY OFFICE (USE ONLY)

PERSONNEL \_\_\_\_\_ REFERENCE NO. 37 C SHEET 14 OF 24  
 NOTES RHOADES DATE 4-27-17 ROUTE SR 65  
 H.C. LEU WEATHER CLOUDY COUNTY HENRY  
 R.C. HELDMAN TEMP. 67° TOWNSHIP DAMASCUS  
 \_\_\_\_\_ SECTION 11  
 \_\_\_\_\_ T 5 N R 8 E


TYPE MONUMENT P.K./WASHER  
~~ON SURFACE~~ - BELOW 2"  
 LEFT - ☉ PAV'T - RIGHT 3'  
6.5' TO LT EDGE PAVEMENT  
 S.L.M. 979+94.4

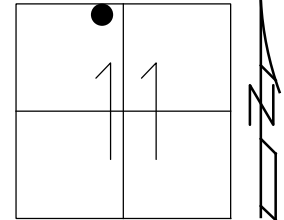

Grid: Northing: 640274.532 Easting: 1580811.181

RECORD:  
 ORIGIN UNKNOWN  
 SET MAG/WASHER  
 05/19/03, MC  
 FD P.K./WASHER  
 2" DOWN  
 REFC37  
 2/16/16, DCH  
 SET MAG/WASHER  
 10-5-17, JLL

DIST.  
 37B-37C=66.30'  
 37C-37D= 20.62'  
 37B-37D= 86.91'

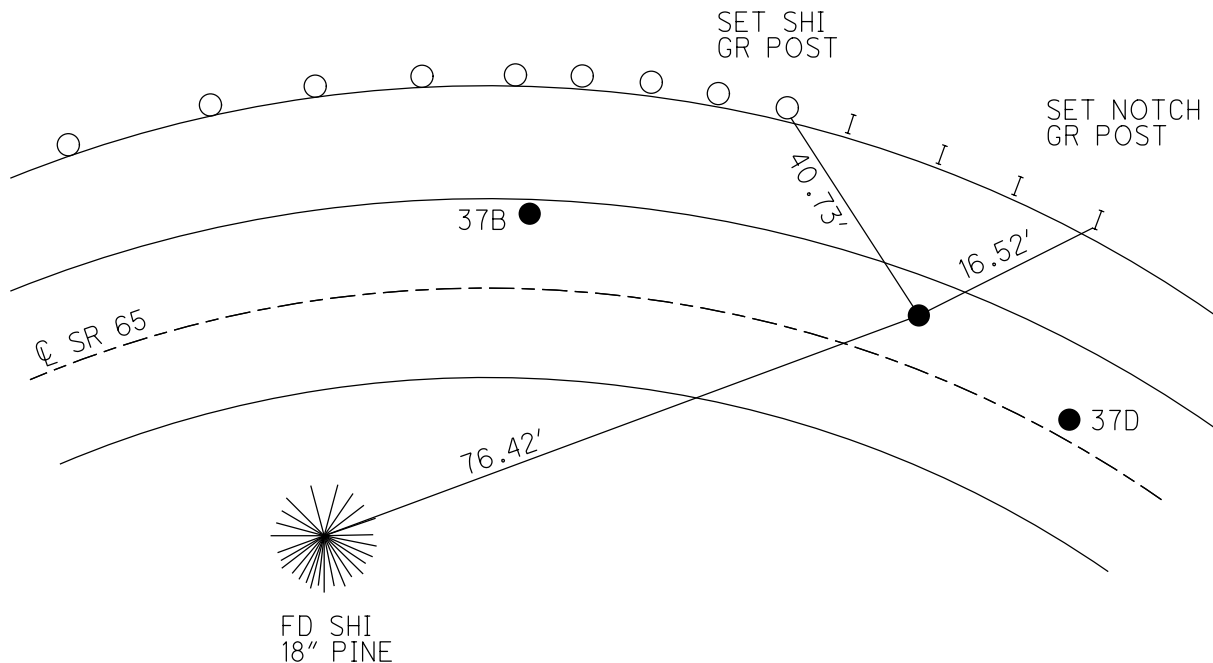

# O.D.O.T. DISTRICT 2 SURVEY OFFICE

PERSONNEL

REFERENCE NO. 37-E

SHEET 18 OF 28

NOTES BARNHISEL - H.C.

H.C. \_\_\_\_\_

DATE 4-14-03

ROUTE 65

R.C. GLASS

WEATHER CLEAR

COUNTY HENRY

RYALL


TEMP. + 60°

TOWNSHIP DAMACUS

SECTION 11


T 5 N R 8 E

"A"	"B"
TYPE MONUMENT <u>P.K./WASHER</u>	<u>LG. R.R. SPK.</u>
ON SURFACE - BELOW <u>SURFACE</u>	<u>3" DOWN</u>
LEFT- & PAV'T. - <u>RIGHT</u>	<u>2.8' LT.</u>
<u>1.6' LT.</u>	
<u>6.5' TO LT EDGE PAVEMENT</u>	<u>7.7' TO LT. E.O.P.</u>
S.L.M. <u>979+32</u>	<u>979+52</u>

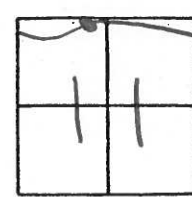

"ORIGIN UNKNOWN"

RESET MAG/WASHER @ BOTH POINTS  
 5-19-03  
 M.C.

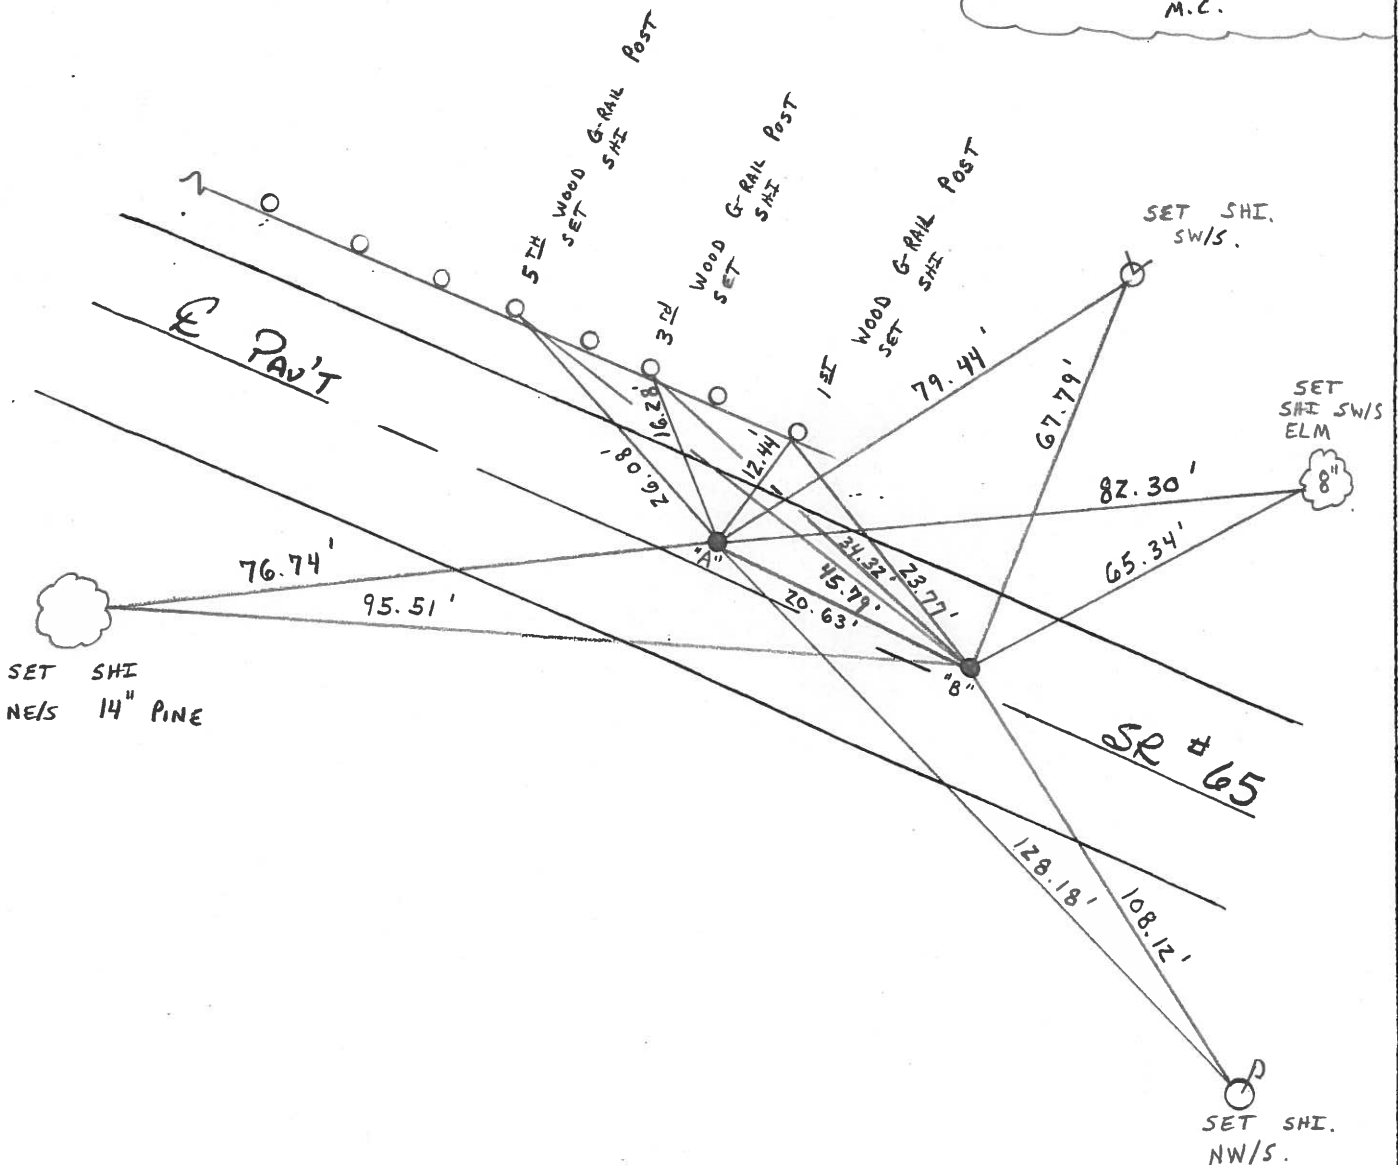

# O.D.O.T. DISTRICT 2 SURVEY OFFICE

PERSONNEL \_\_\_\_\_

REFERENCE NO. 37-B

SHEET \_\_\_\_\_ OF \_\_\_\_\_

NOTES VAN DUSEN

H.C. BARNHISEL

R.C. LONG

DATE 9-20-91

WEATHER CLEAR

TEMP. +56°F

ROUTE 65

COUNTY HENRY

TOWNSHIP DAMASCUS

SECTION \_\_\_\_\_

T \_\_\_\_\_ R \_\_\_\_\_

"A" & "B"

"A" = 37C

"B" = 37D


TYPE MONUMENT PK/WASHER

ON SURFACE - BELOW YES


LEFT- & PAV'T. - RIGHT 2.6 8.6

7.4 TO LT. EDGE PAVEMENT "B" 8.5 TO LT. E.F.

S.L.M. "A" 980+43 "B" 980+63

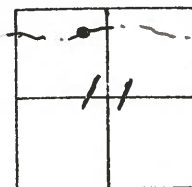

SET PK/WASHER  
 3-24-92  
 BVD  
 "ORIGIN UNKNOWN"

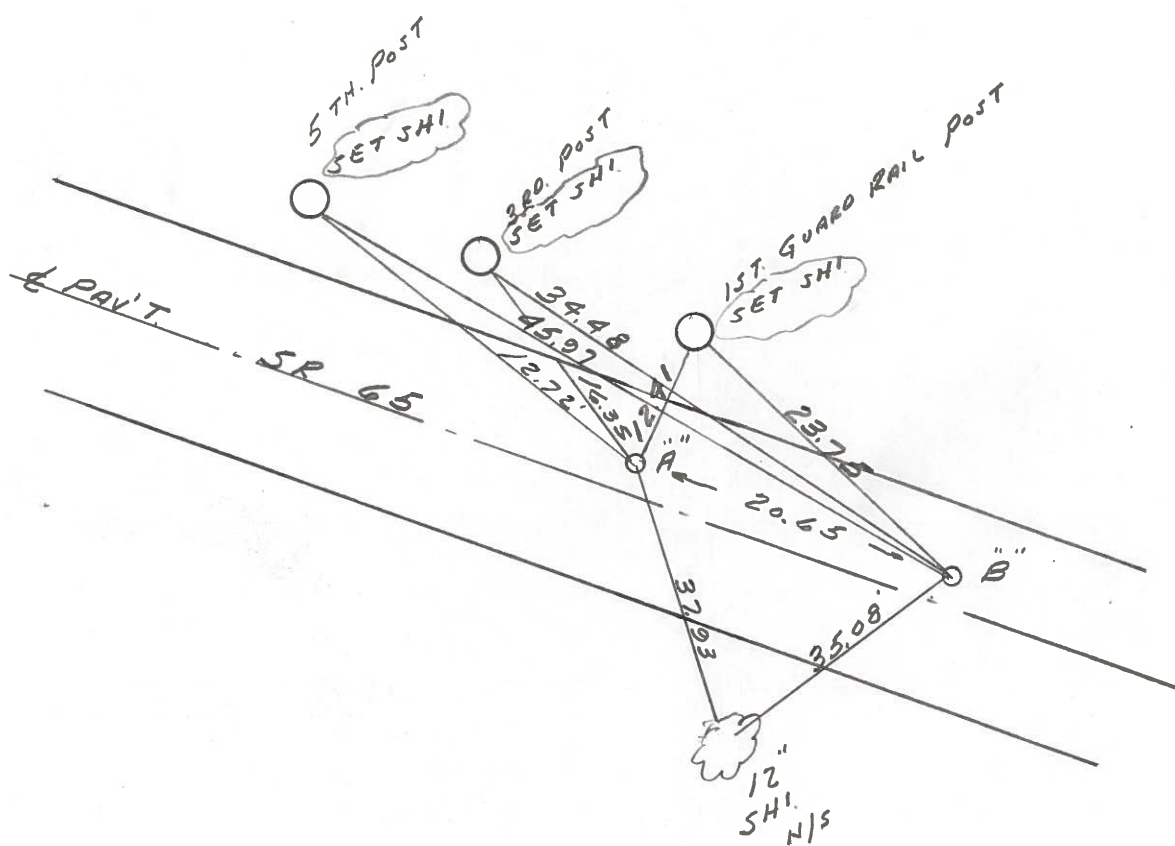

Q.D.O.T. DISTRICT 2 SURVEY OFFICE

SHEET \_\_\_\_\_ OF \_\_\_\_\_

County HENRY S.R. 65

Date 2-2-84

Township DAMASCUS

Weather Clear

Section 11

Temp. 35°

T5N, R8E

Personnel HOFFMAN


LOGHRUE H.C.

HOUSEHOLDER R.C.

BARNHISEL

"A" = 37C

"B" = 37D

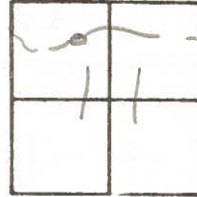

PT. "A" Fd R.R. SPK @ SURFACE ORIGIN UNKNOWN SLM 979 + 88


3.8' Lt. of & Paut

5.7' TO Lt. EP.

SET PK/WASHER

9-17-84

S.W.H.

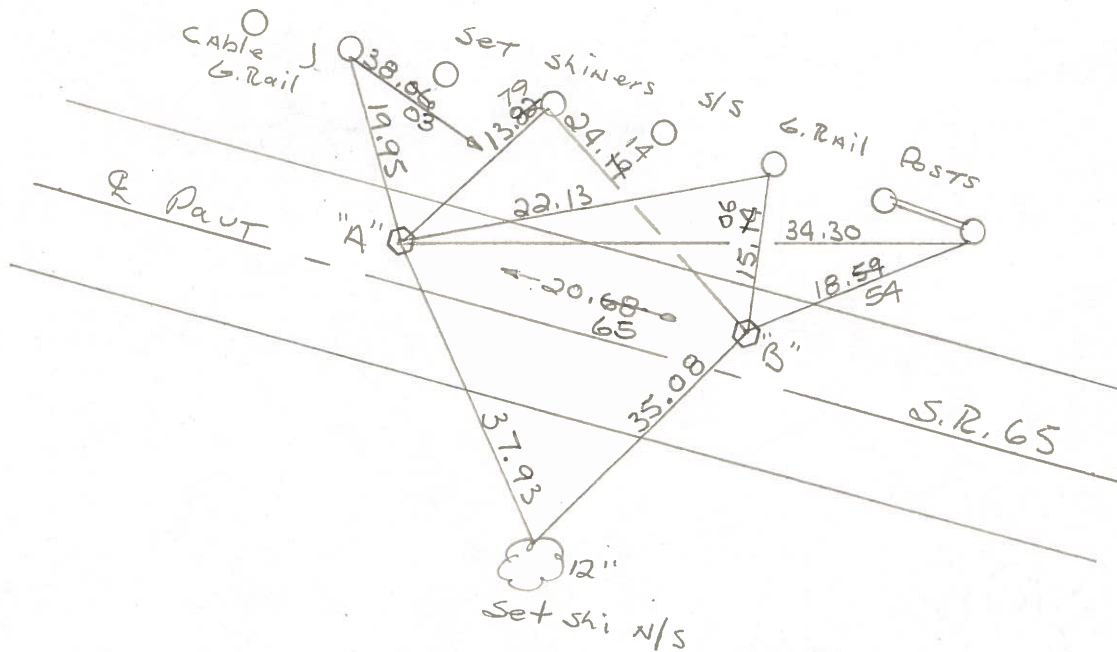

PT. "B" Fd R.R. SPK @ SURFACE ORIGIN UNKNOWN SLM 980 + 0.8

2.6' Lt. of & Paut

6.8' TO Lt. EP.