


O.D.O.T. DISTRICT 2 SURVEY OFFICE (USE ONLY)

PERSONNEL \_\_\_\_\_ REFERENCE NO. 37 D SHEET 15 OF 24  
 NOTES RHOADES DATE 4-27-17 ROUTE SR 65  
 H.C. LEU WEATHER CLOUDY COUNTY HENRY  
 R.C. HELDMAN TEMP. 67° TOWNSHIP DAMASCUS  
 \_\_\_\_\_ SECTION 11  
 \_\_\_\_\_ T 5 N R 8 E


TYPE MONUMENT MAG/WASHER  
 ON SURFACE - ~~BELOW~~ ON  
 LEFT - ☉ PAV'T - ~~RIGHT~~ 2.3'  
7.6' TO LT EDGE PAVEMENT  
 S.L.M. 980+15

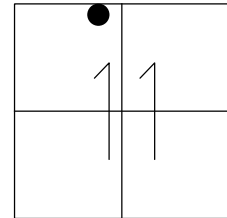

Grid: Northing: 640269.760 Easting: 1580831.227

RECORD:  
 ORIGIN UNKNOWN  
 FD LG.R.R.SPIKE  
 3" DOWN  
 4/14/03, MC  
 SET MAG/WASHER  
 5/19/03, MC  
 FD MAG/WASHER  
 REFD37  
 2/16/16, DCH  
 SET MAG/WASHER  
 10-5-17, JLL

DIST.  
 37B-37C=66.30'  
 37C-37D= 20.62'  
 37B-37D= 86.91'

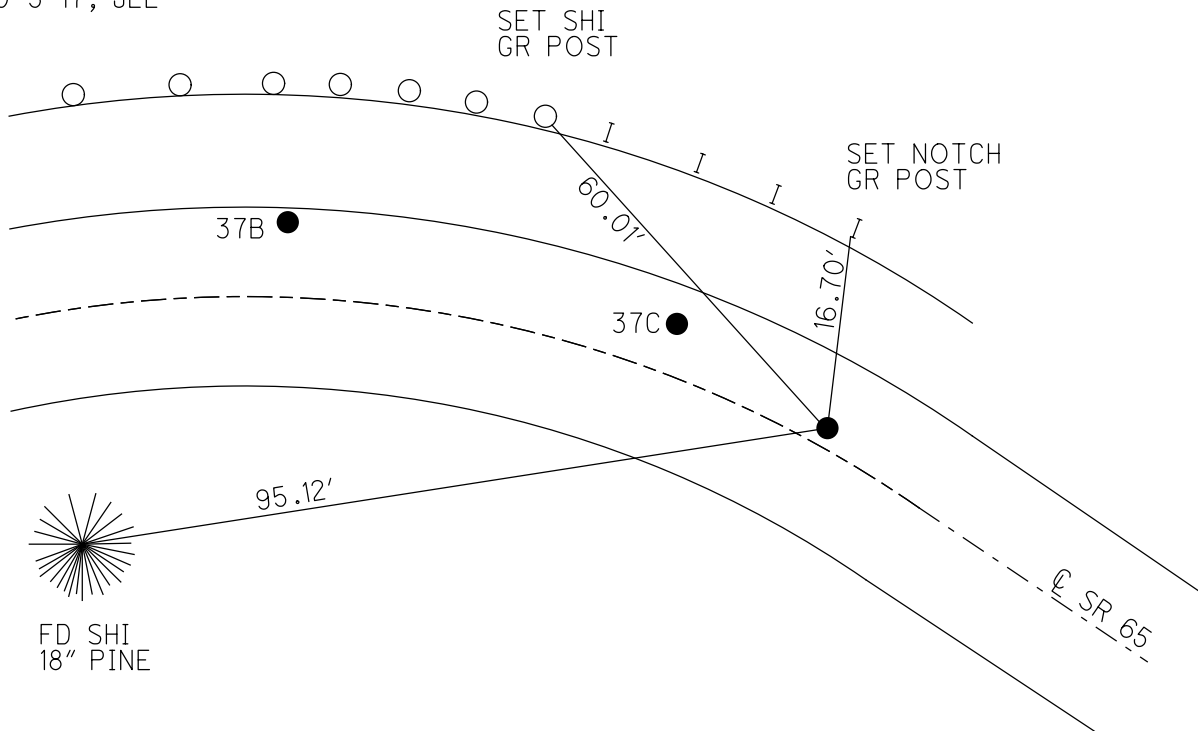

# O.D.O.T. DISTRICT 2 SURVEY OFFICE

PERSONNEL

REFERENCE NO. 37-E

SHEET 18 OF 28

NOTES BARNHISEL - H.C.

H.C. \_\_\_\_\_

DATE 4-14-03

ROUTE 65

R.C. GLASS

WEATHER CLEAR

COUNTY HENRY

RYALL


TEMP. + 60°

TOWNSHIP DAMACUS

SECTION 11


T 5 N R 8 E

|                                   |                           |
|-----------------------------------|---------------------------|
| "A"                               | "B"                       |
| TYPE MONUMENT <u>P.K./WASHER</u>  | <u>LG. R.R. SPK.</u>      |
| ON SURFACE - BELOW <u>SURFACE</u> | <u>3" DOWN</u>            |
| LEFT- & PAV'T. - <u>RIGHT</u>     | <u>2.8' LT. 1.6' LT.</u>  |
| <u>6.5' TO LT EDGE PAVEMENT</u>   | <u>7.7' TO LT. E.O.P.</u> |
| S.L.M. <u>979+32</u>              | <u>979+52</u>             |

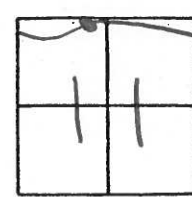

"ORIGIN UNKNOWN"

RESET MAG/WASHER @ BOTH POINTS  
 5-19-03  
 M.C.

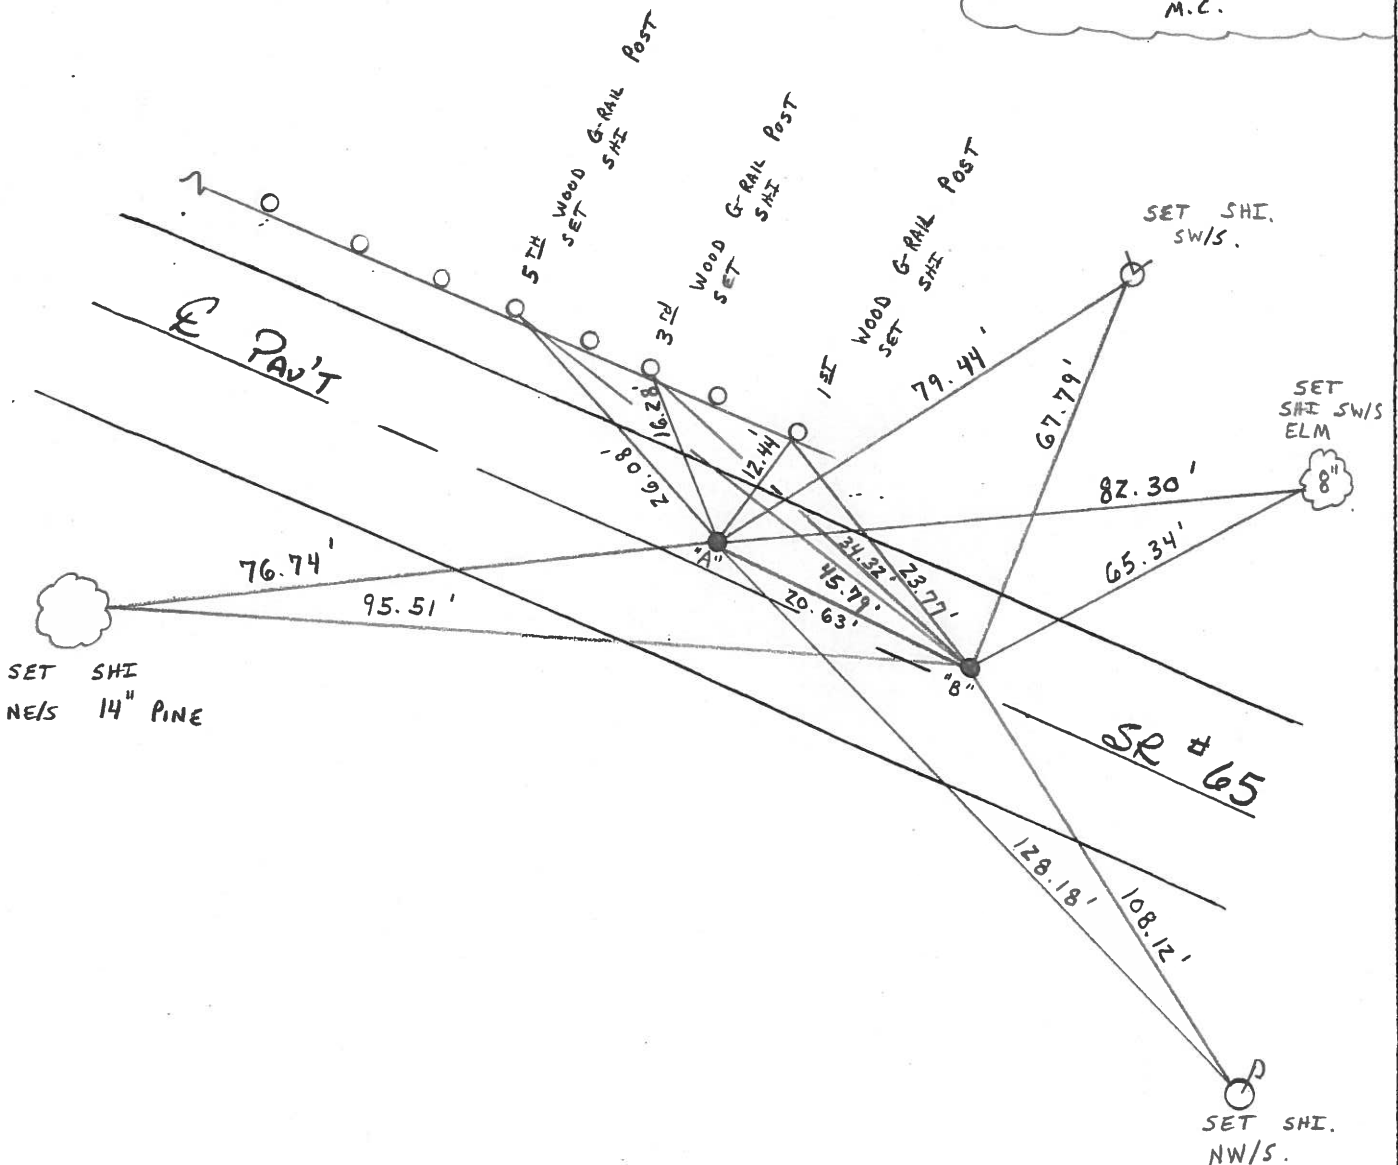

# O.D.O.T. DISTRICT 2 SURVEY OFFICE

PERSONNEL \_\_\_\_\_

REFERENCE NO. 37-B

SHEET \_\_\_\_\_ OF \_\_\_\_\_

NOTES VAN DUZEN

H.C. BARNHISEL

R.C. LONG

DATE 9-20-91

WEATHER CLEAR

TEMP. +56°F

ROUTE 65

COUNTY HENRY

TOWNSHIP DAMASCUS

SECTION \_\_\_\_\_

T \_\_\_\_\_ R \_\_\_\_\_

"A" & "B"

"A" = 37C  
"B" = 37D


TYPE MONUMENT PK/WASHER

ON SURFACE - BELOW YES


LEFT- & PAV'T. - RIGHT 2.6 8.6

7.4 TO LT. EDGE PAVEMENT "B" 8.5 TO LT. E.F.

S.L.M. "A" 980+43 "B" 980+63

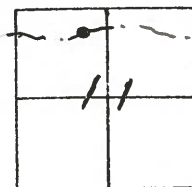

SET PK/WASHER  
 3-24-92  
 BVD  
 "ORIGIN UNKNOWN"

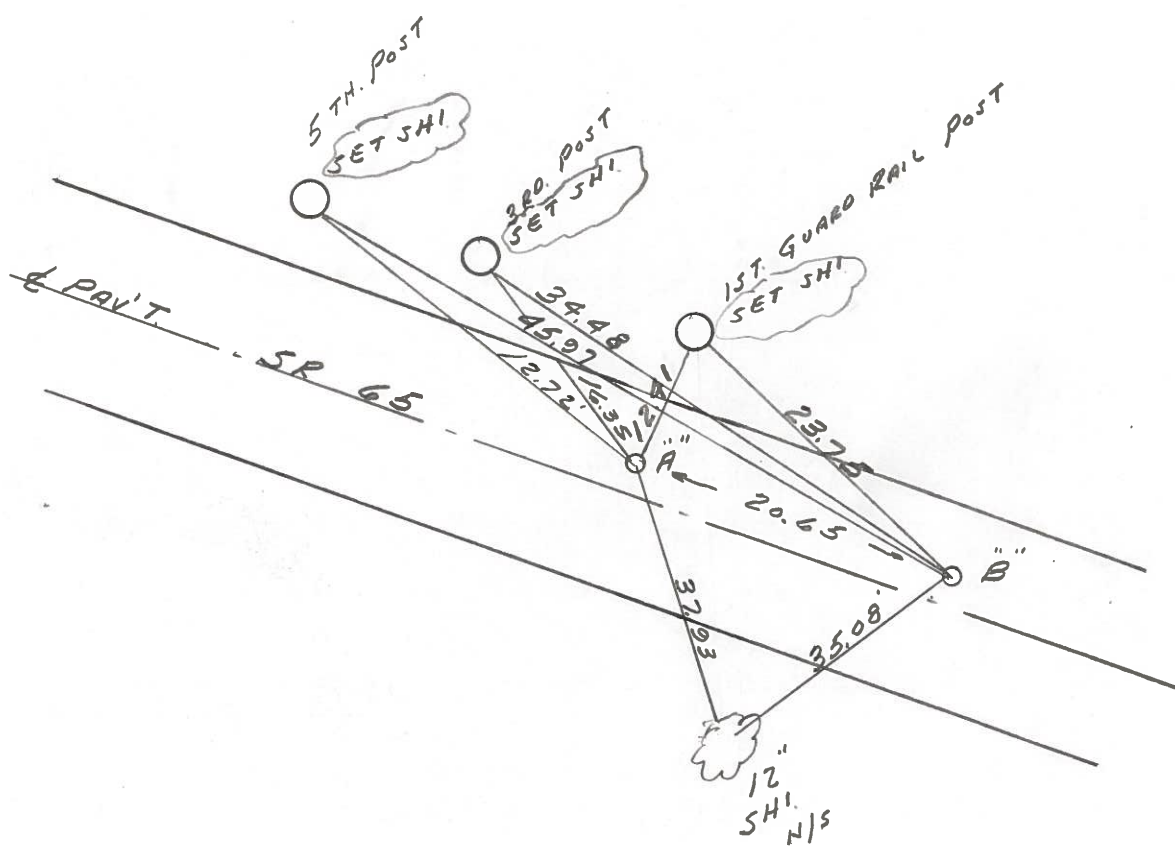

Q.D.O.T. DISTRICT 2 SURVEY OFFICE

SHEET \_\_\_\_\_ OF \_\_\_\_\_

County HENRY S.R. 65

Date 2-2-84

Township DAMASCUS

Weather Clear

Section 11

Temp. 35°

T5N, R8E

Personnel HOFFMAN


LOGHREE H.C.

HOUSEHOLDER R.C.

BARNHISEL

"A" = 37C

"B" = 37D

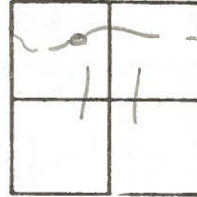

PT. "A" Fd R.R. SPK @ SURFACE ORIGIN UNKNOWN SLM 979 + 88


3.8' Lt. of & Paut

5.7' TO Lt. EP.

SET PK/WASHER

9-17-84

S.W.H.

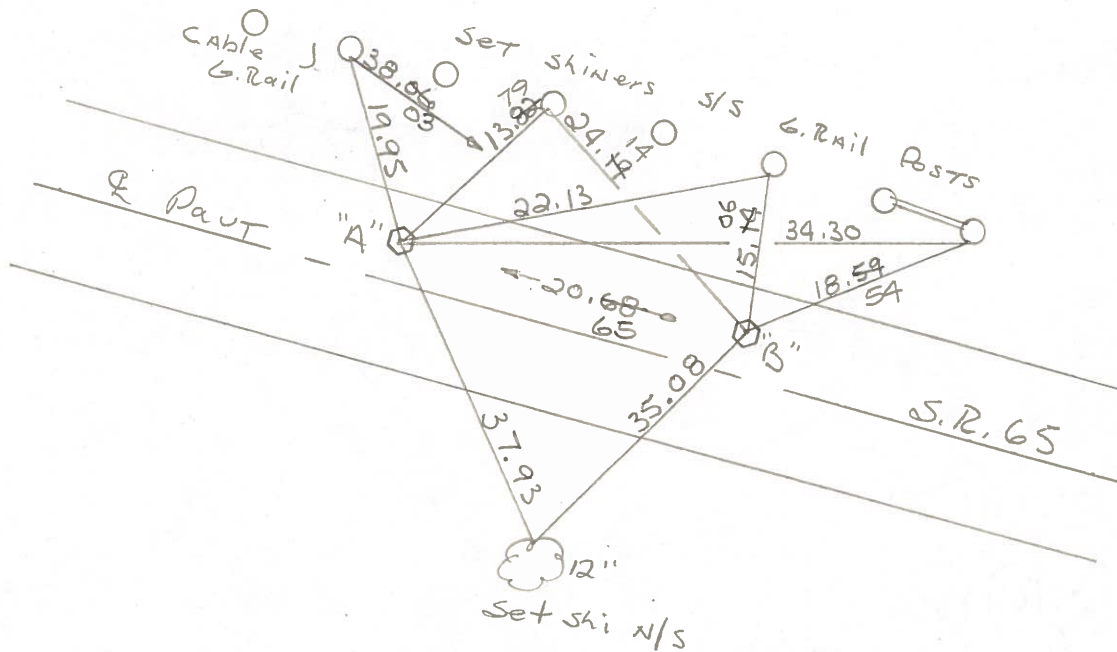

PT. "B" Fd R.R. SPK @ SURFACE ORIGIN UNKNOWN SLM 980 + 0.8

2.6' Lt. of & Paut

6.8' TO Lt. EP.