



O.D.O.T. DISTRICT 2 SURVEY OFFICE (USE ONLY)

PERSONNEL _____ REFERENCE NO. 39 SHEET 18 OF 24
 NOTES RHOADES DATE 4-28-17 ROUTE SR 65
 H.C. LEU WEATHER FAIR COUNTY HENRY
 R.C. HELDMAN TEMP. 46° TOWNSHIP DAMASCUS
 _____ SECTION 12
 _____ T 5 N R 8 E

TYPE MONUMENT MAG/WASHER
 ON SURFACE - ~~BELOW~~ ON _____
 LEFT - ☉ PAV'T - ~~RIGHT~~ 2.5
6.9' TO LT EDGE PAVEMENT
 S.L.M. 1011+91.88
 Grid: Northing: 639736.044 Easting: 1583962.399

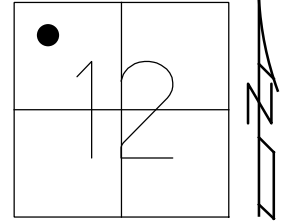

RECORD: P.I.
 DATA FROM 1924 PLAN
 STA. 110+02.3
 $\Delta = 3^\circ 43'$
 $D = 3'$
 $T = 61.94'$
 $R = 1909.12'$
 $L = 123.84'$
 $E = 1'$
 $\Delta = 3^\circ 49' 00''$ LT
 MEAS 1974
 FD P.K./WASHER
 4/14/03, MB
 SET MAG/WASHER
 5/19/03, MC
 FD MAG/WASHER
 REF39
 2/16/16, DCH
 SET MAG/WASHER
 10-5-17, JLL

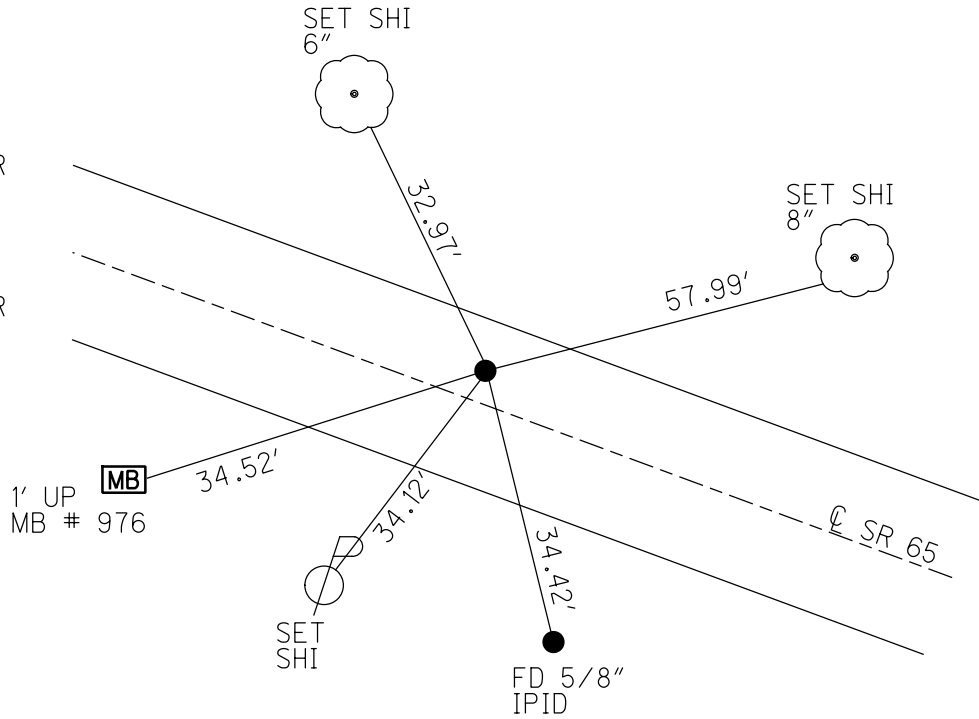

O.D.O.T. DISTRICT 2 SURVEY OFFICE

PERSONNEL _____

REFERENCE NO. 39

SHEET 20 OF 26

NOTES BARNHISEL - H.C.

H.C. _____

DATE 4-14-03

ROUTE 65

R.C. GLASS

WEATHER CLEAR

COUNTY HENRY

RYALL

TEMP. + 6.5°

TOWNSHIP DAMACUS

SECTION 12

T 5 N R 8 E


TYPE MONUMENT P.K. & WASHER

ON SURFACE - BELOW SURFACE


LEFT- & PAW'T. - RIGHT 3.3' LT.

6.9' TO LT. EDGE PAVEMENT

S.L.M. 1011 + 28

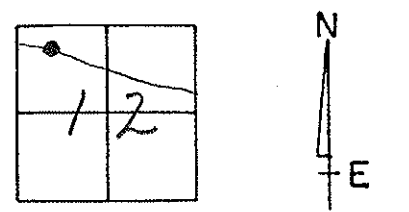

RESET P.K. & WASHER
5-19-03
M.C.

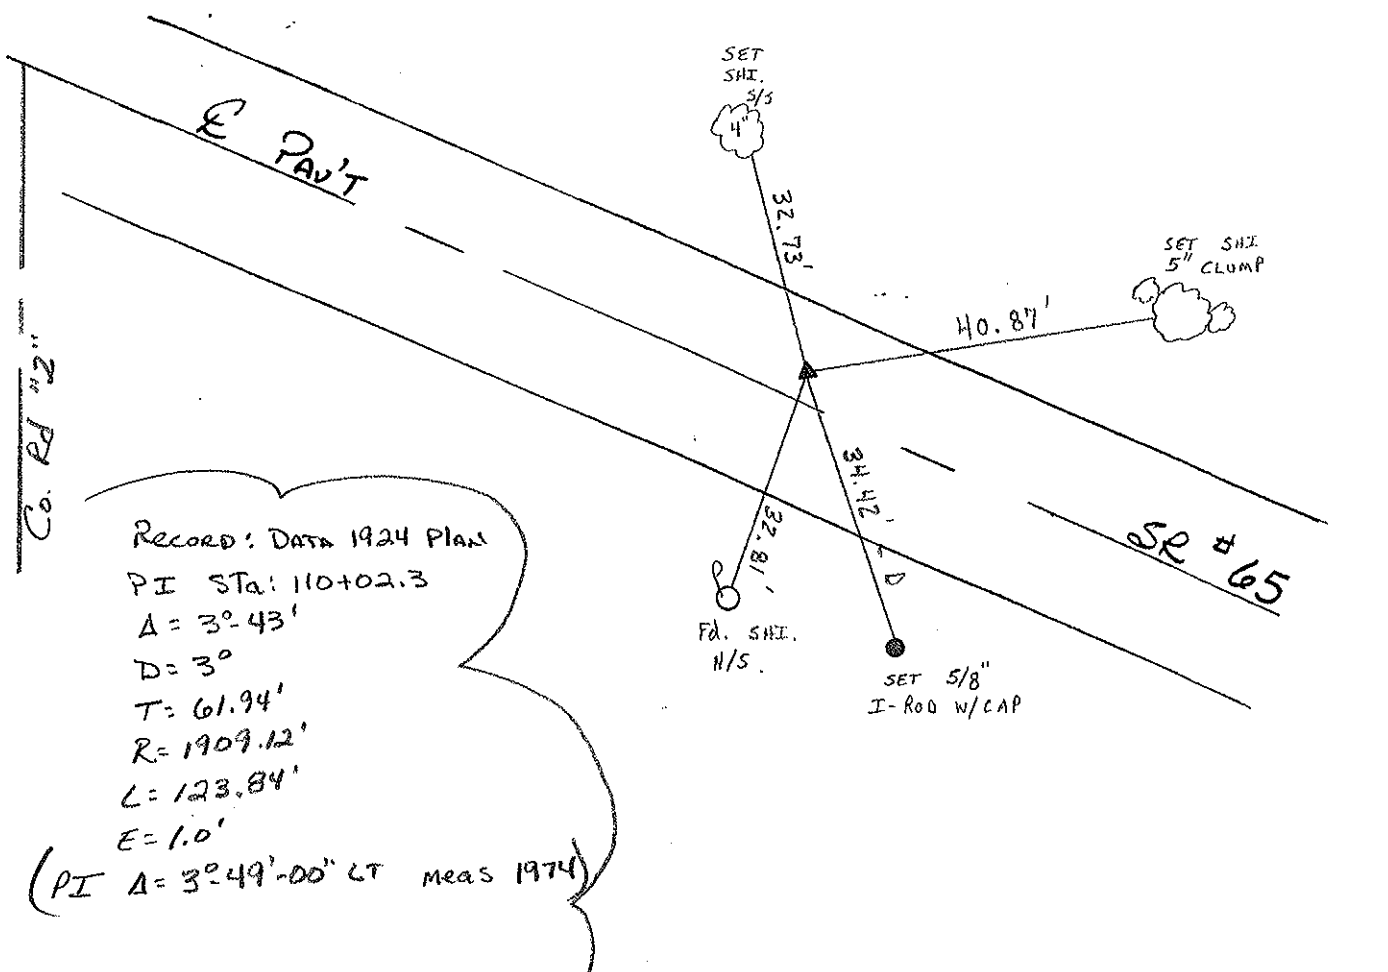

Record: DATA 1924 PLAN
 PI STA: 110+02.3
 $\Delta = 3^{\circ}43'$
 $D = 3^{\circ}$
 $T = 61.94'$
 $R = 1909.12'$
 $L = 123.84'$
 $E = 1.0'$
 (PI $\Delta = 3^{\circ}49'00''$ LT MEAS 1974)

Co. PI 2

O.D.O.T. DISTRICT 2 SURVEY OFFICE

PERSONNEL _____

REFERENCE NO. 39

SHEET _____ OF _____

NOTES VAN DUSEN

H.C. BARNHISEL

R.C. KUSZ

DATE 9-20-91

WEATHER CLEAR

TEMP. +56° F

ROUTE 65

COUNTY HENRY

TOWNSHIP DAMASCUS

SECTION 12

T 5 N R 8 E


TYPE MONUMENT PK & WASHER

ON SURFACE - BELOW YES


LEFT - C PAV'T. - RIGHT YES 2.4'

8.2 TO LT. EDGE PAVEMENT

S.L.M. 1012+39

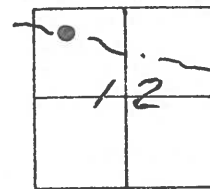

SET PK/WASHER
 3-24-92
 BVD

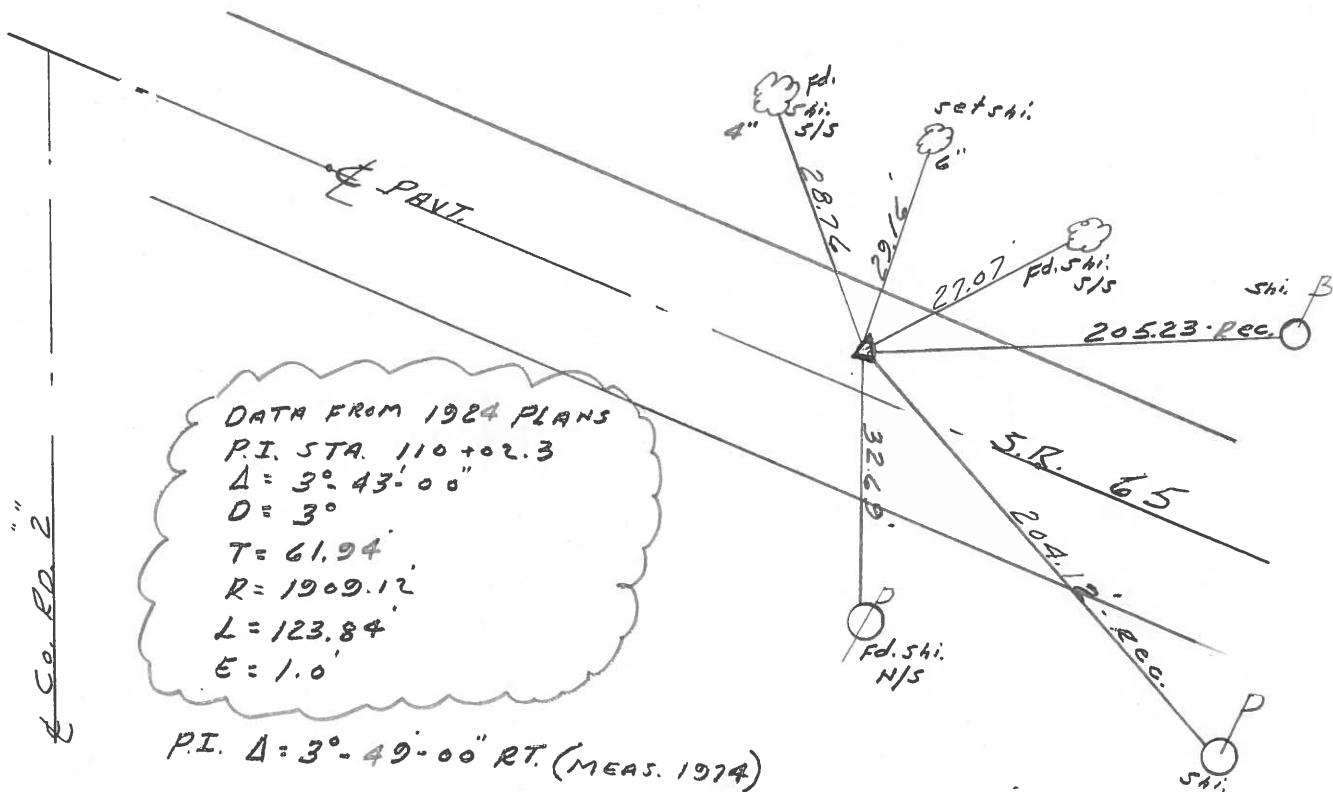

County HENRY S.R. 65

Township DAMASCUS

Section 12

TSN, R0E

Personnel HOFFMAN

LOEHRKE H.C.


HOUSEHOLDER R.C.

BARNHISEL

Date 2-3-84

Weather Lt. Rain

Temp. 35°

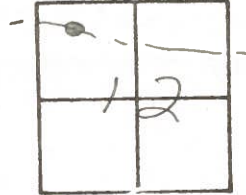

#39

Fd small R.R. SPK 1 1/2" below surface

S.L.M. 1011+85

2.8' Lt. of & part


SET PK/WASHER

6.4' to Lt. EP

9-17-84

12.2' to RT. EP

S.W.H.

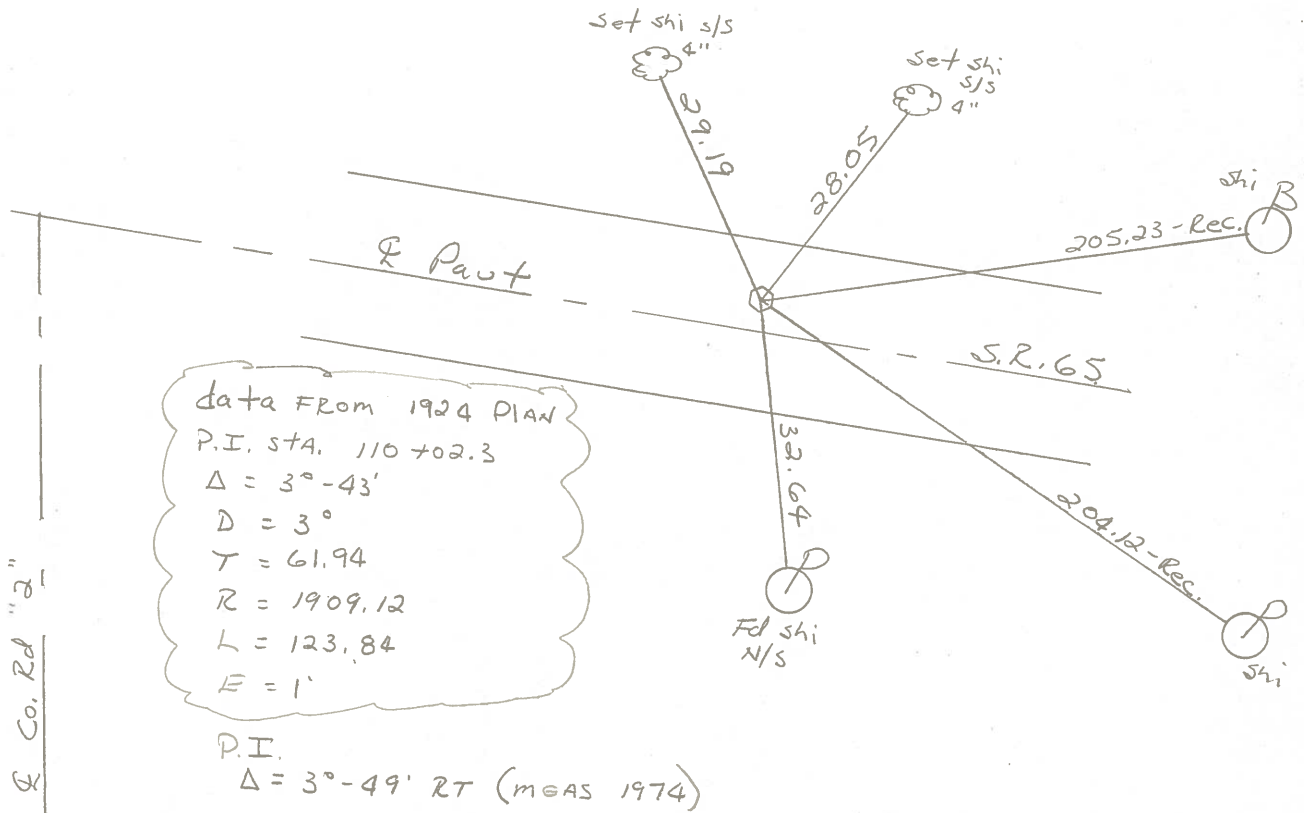

PERSONNEL	TITLE	PERSONNEL	TITLE	COUNTY	DATE
BURNSIDE				HENRY	3-6-74
SMITH				S. R. 65	WEATHER Cloudy
BOWERS				SEC.	TEMP. +50°
MEAD					

DESCRIPTION ± RW CONTROL TIES JOB NO. _____

