


O.D.O.T. DISTRICT 2 SURVEY OFFICE (USE ONLY)


PERSONNEL _____ REFERENCE NO. 39 A SHEET 19 OF 24
 NOTES RHOADES DATE 4-28-17 ROUTE SR 65
 H.C. LEU WEATHER FAIR COUNTY HENRY
 R.C. HELDMAN TEMP. 46° TOWNSHIP DAMASCUS
 _____ SECTION 12
 _____ T 5 N R 8 E

TYPE MONUMENT MAG/WASHER
 ON SURFACE - ~~BELOW~~ ON
 LEFT - ℄ PAV'T - RIGHT 3.8'
5.4' TO LT EDGE PAVEMENT
 S.L.M. 1023+43.65

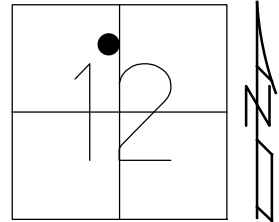

Grid: Northing: 639474.381 Easting: 1585084.097

RECORD: P.I.
 DATA FROM 1924 PLAN
 STA. 121+39
 $\Delta = 5^{\circ}12'$
 $D = 1^{\circ}-11'$
 $T = 220.33'$
 $R = 4852.05'$
 $L = 440.35'$
 $E = 5'$
 $\Delta = 5^{\circ}12' 00''$ RT
 MEAS 1974
 SET MAG/WASHER
 5/19/03, MC
 SET MAG NAIL
 REFA39
 2-16-2016, DCH
 SET MAG/WASHER
 10-5-17, JLL

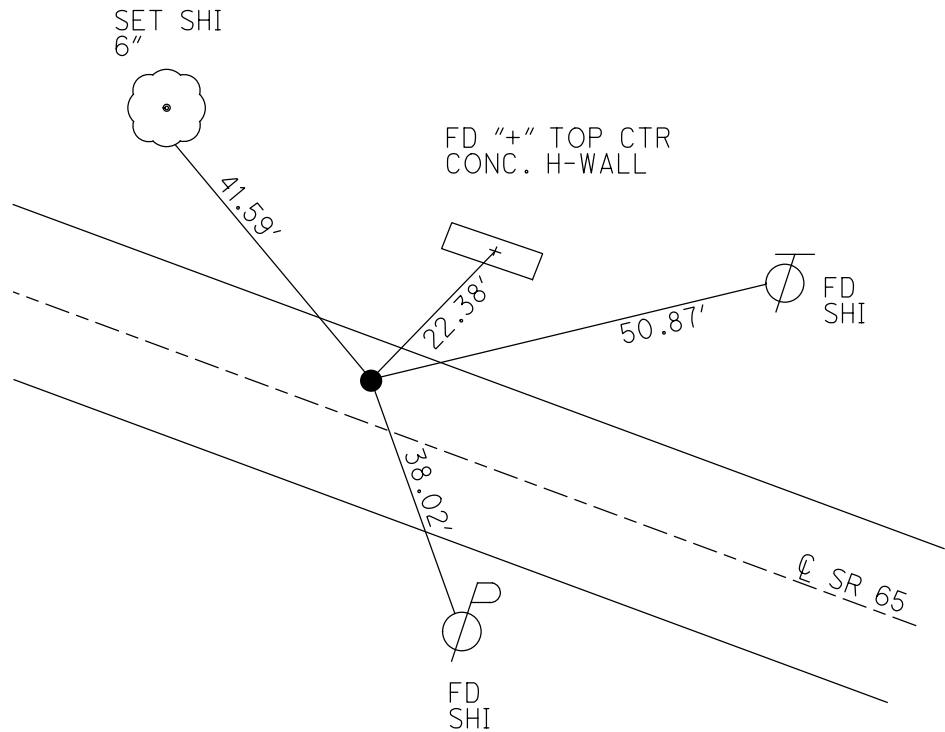

O.D.O.T. DISTRICT 2 SURVEY OFFICE

PERSONNEL _____

REFERENCE NO. 39-A

SHEET 21 OF 26

NOTES BARNHISEL - H.C.

H.C. _____

DATE 4-14-03

ROUTE 65

R.C. GLASS

WEATHER CLEAR

COUNTY HENRY

RYALL

TEMP. + 6.5 °

TOWNSHIP DAMACUS

SECTION 12

T S N R B E


TYPE MONUMENT P.K. & WASHER

ON SURFACE - BELOW SURFACE


LEFT- & PAV'T. - RIGHT 4.6' LT

5.4' TO LT. EDGE PAVEMENT

S.L.M. 1022 + 79

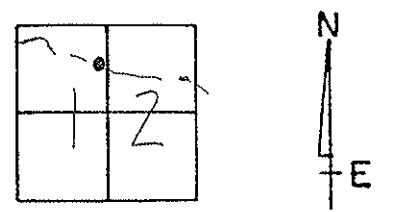

RESET MAG & WASHER
5-19-03
M.C.

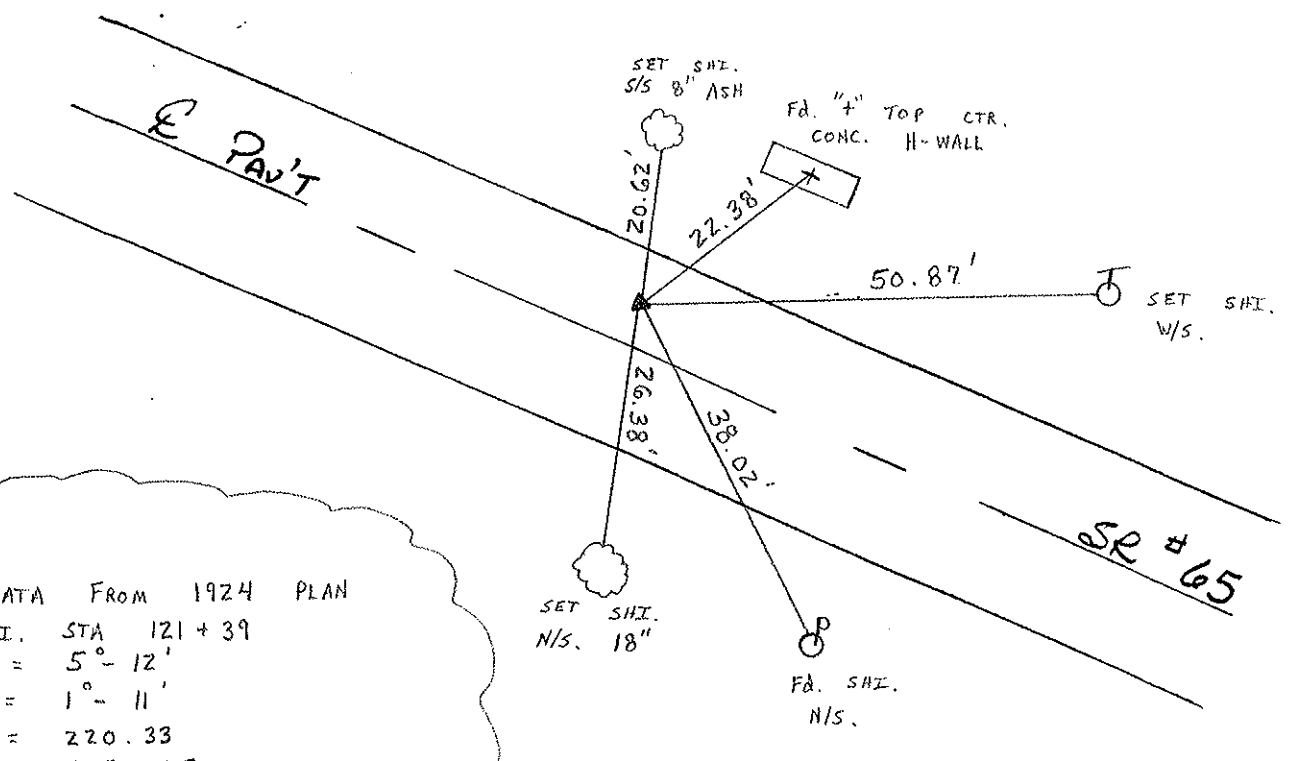

DATA FROM 1924 PLAN
 P.I. STA 121 + 39
 A = 5° - 12'
 D = 1° - 11'
 T = 220.33
 R = 4852.05
 L = 440.35
 E = 5'
 P.I.
 Δ = 5° - 12' RT. (MEAS. 1974)

O.D.O.T. DISTRICT 2 SURVEY OFFICE

PERSONNEL _____

REFERENCE NO. 39-A

SHEET _____ OF _____

NOTES LONG

H.C. VANBUSEN

R.C. BARNHISEL

DATE 9-20-91

WEATHER CLEAR

TEMP. 56°

ROUTE 65

COUNTY HENRY

TOWNSHIP DAMASCUS

SECTION 12

T 5 N R 8 E


TYPE MONUMENT PK/WASHER

ON SURFACE - BELOW YES


LEFT- & PAV'T. - RIGHT 4.3'

6.6' TO LT EDGE PAVEMENT

S.L.M. 1023+90

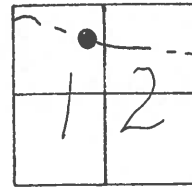

SET PK/WASHER
 3-24-92
 BVD

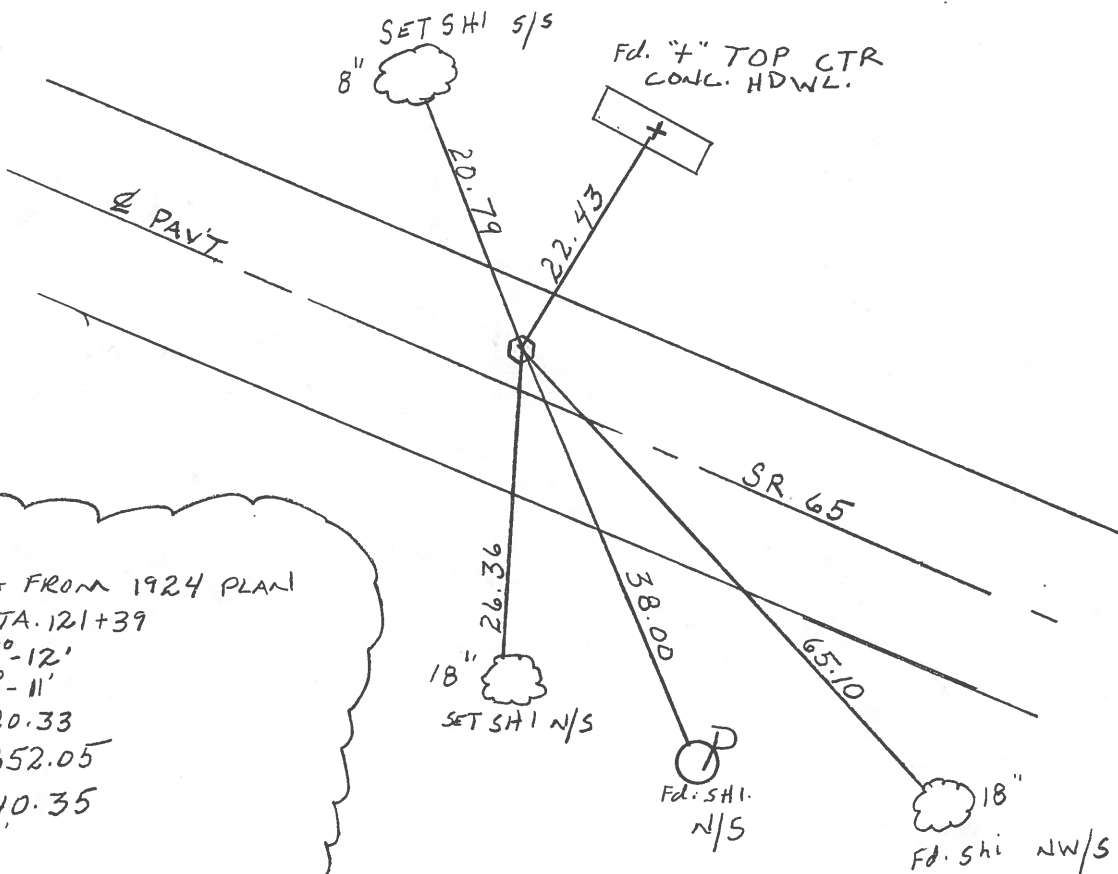

DATA FROM 1924 PLAN
 P.I. STA. 121+39
 $\Delta = 5^{\circ}-12'$
 $D = 1^{\circ}-11'$
 $T = 220.33$
 $R = 4852.05$
 $L = 440.35$
 $E = 5'$

P.F.
 $\Delta = 5^{\circ}-12'$ RE. (MEAS. 1974)

County HENRY S.R. 65

Date 2-3-84

Township DAMASCUS

Weather Cloudy

Section 12

Temp. 36°

T5N, R8E


Personnel HOFFMAN

LOEHKE H.C.

Householder R.C.

BARNHISEL

#39-A

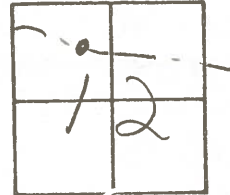

Fd. small R.R. SPK 1 1/2" down

SLM 1023 + 36

4.9' Lt. of Q Paut


SET PK/WASHER

4.7' TO Lt. EP.

13.8' TO Rt. EP.

9-17-84

S.W.H.

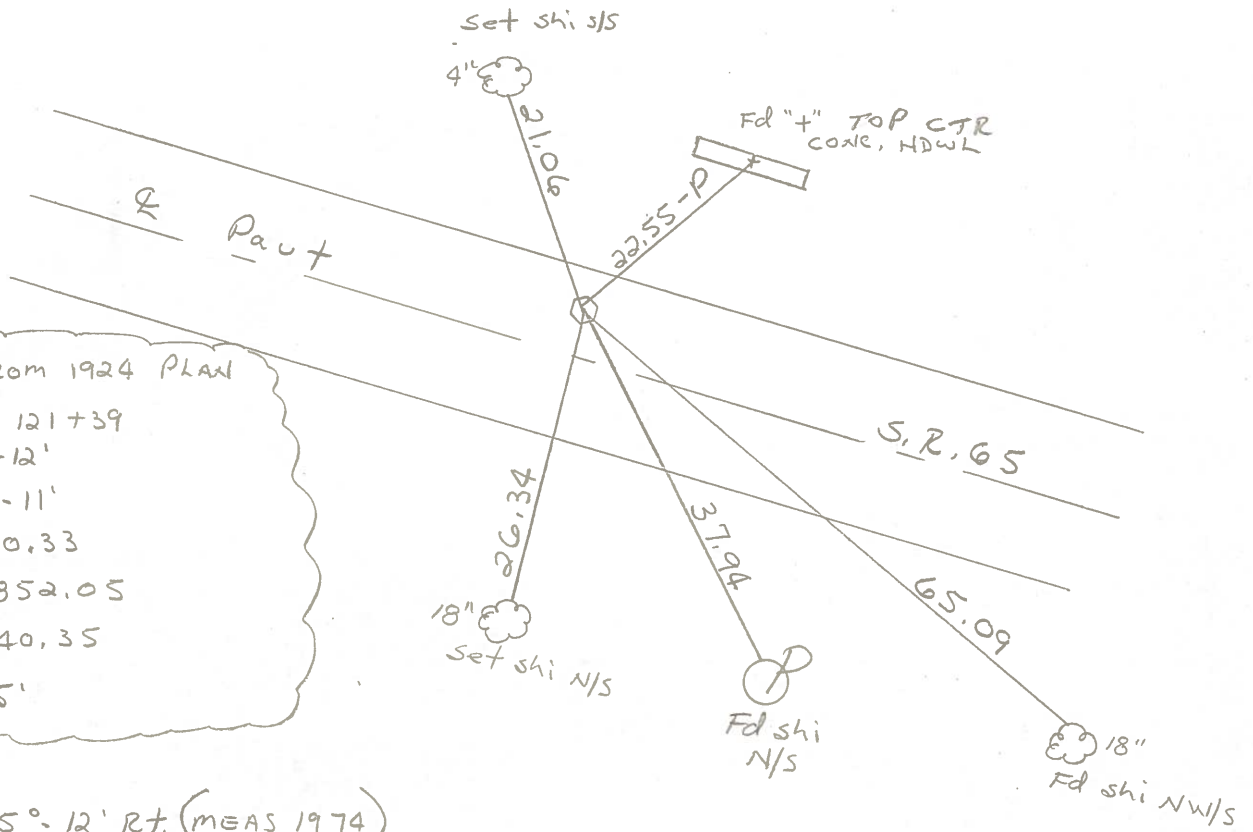

DATA FROM 1924 PLAN
 P.I. STA 121+39
 $\Delta = 5^\circ - 12'$
 $D = 1^\circ - 11'$
 $T = 220.33$
 $R = 4852.05$
 $L = 440.35$
 $E = 5'$

P.I.
 $\Delta = 5^\circ - 12' \text{ RT. (MEAS 1974)}$

SHEET NO. _____

PERSONNEL	TITLE	PERSONNEL	TITLE
BURNSIDE			
SMITH			
BOWERS			
MEAD			

COUNTY HENRY DATE 3-7-74
 S. R. 65 WEATHER CLEAR
 SEC. _____ TEMP. +53°

DESCRIPTION ± RW CONTROL TIES JOB NO. _____

