



O.D.O.T. DISTRICT 2 SURVEY OFFICE (USE ONLY)

PERSONNEL	REFERENCE NO.	39 B	SHEET	20	OF	24
NOTES	LEU	DATE	2-16-2016	ROUTE	SR 65	
H.C.	LEU	WEATHER	CLOUDY	COUNTY	HENRY	
R.C.	HOMAN	TEMP.	33°	TOWNSHIP	DAMASCUS	
				SECTION	12	
				T	5	N
				R	8	E

TYPE MONUMENT SM.R.R.SPIKE
~~ON SURFACE~~ - BELOW 5"
 LEFT - ☉ PAV'T - ~~RIGHT~~ 1.8'
8.1' TO LT EDGE PAVEMENT
 S.L.M. 1034+00.55
 Grid: Northing: 639141.650 Easting: 1586087.579

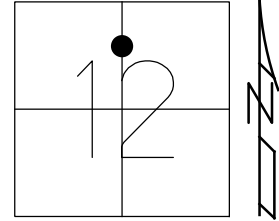

RECORD: P.I.
 DATA FROM 1924 PLAN
 STA. 132+13.8
 $\Delta = 5^{\circ}50' 00''$
 $D = 2^{\circ}28' 00''$
 $T = 118.14'$
 $R = 2318.76'$
 $L = 238.16'$
 $E = 3'$
 $\Delta = 5^{\circ}50' 00''$ RT
 MEAS 1974
 FD P.K./WASHER
 4/14/03, MB
 SET MAG/WASHER
 5/19/03, MC
 FD SM.R.R.SPIKE
 REFB39
 2/16/16, DCH
 SET MAG/WASHER
 10-5-17, JLL

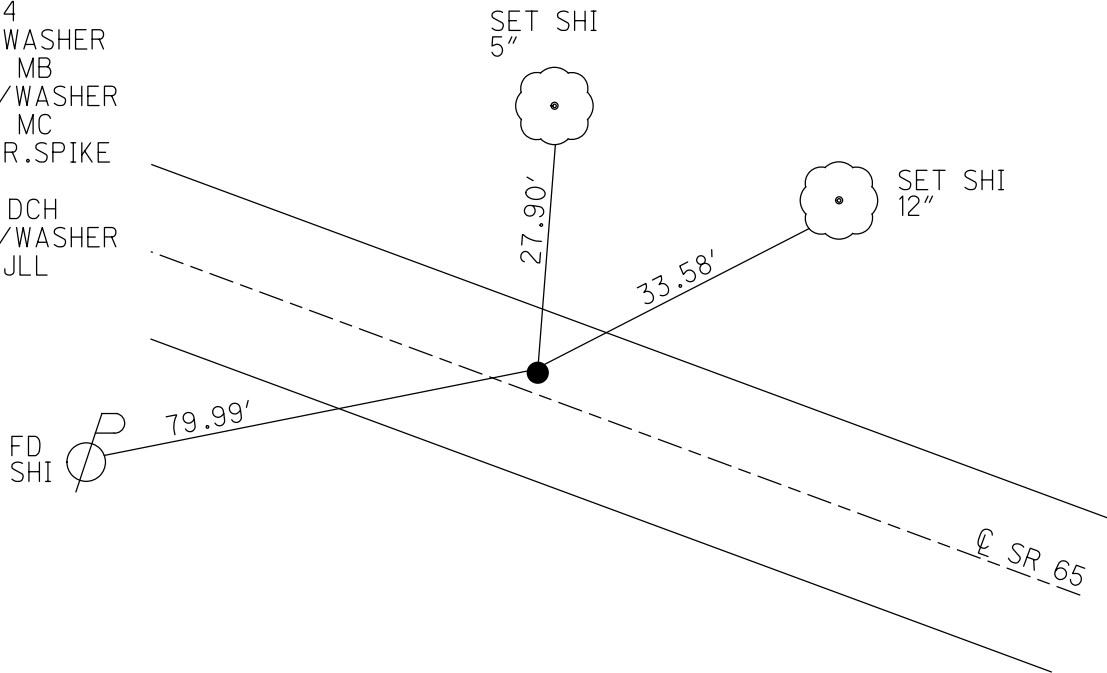

O.D.O.T. DISTRICT 2 SURVEY OFFICE

PERSONNEL _____

REFERENCE NO. 39-8

SHEET 22 OF 26

NOTES BARNHISEL - H.C.

H.C. _____

DATE 4-14-03

ROUTE 65

R.C. GLASS

WEATHER CLEAR

COUNTY HENRY

RYALL

TEMP. +65°

TOWNSHIP DAMACUS

SECTION 12

T5 NR B E


TYPE MONUMENT P.K. & WASHER

ON SURFACE - BELOW SURFACE


LEFT- & PAV'T. - RIGHT 2.0' LT

8.1' TO LT. EDGE PAVEMENT

S.L.M. 1033 + 35

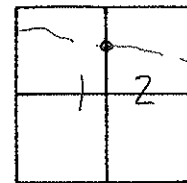

RESET MAG & WASHER
5-19-03
M.C.

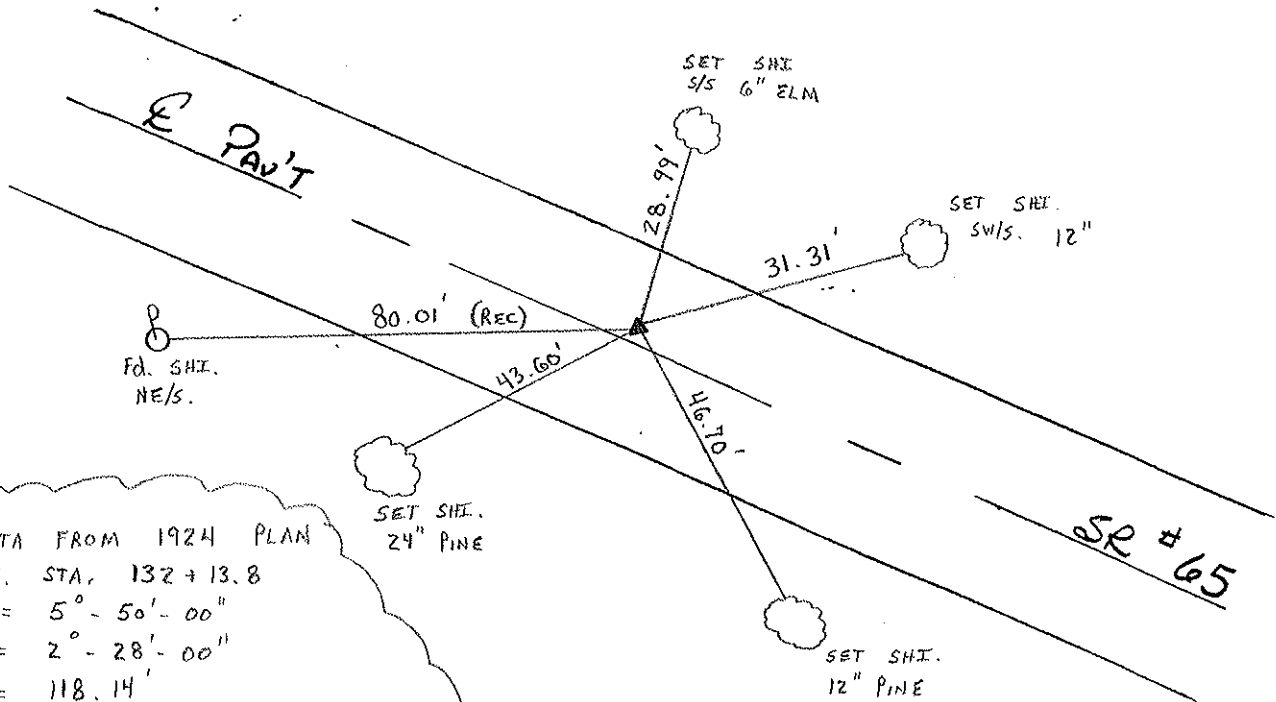

DATA FROM 1924 PLAN

P.I. STA. 132+13.8

$\Delta = 5^{\circ} - 50' - 00''$

$D = 2^{\circ} - 28' - 00''$

$T = 118.14'$

$R = 2318.76'$

$L = 238.16'$

$E = 3.0'$

P.I.

$\Delta = 5^{\circ} - 50' - 00''$ RT (MEAS. 1974)

O.D.O.T. DISTRICT 2 SURVEY OFFICE

PERSONNEL _____ REFERENCE NO. 39-B SHEET _____ OF _____

NOTES VAN DUSEN

H.C. BARNHISEL

R.C. LONG

DATE 9-20-91

WEATHER CLEAR

TEMP. +56° F

ROUTE 65

COUNTY HENRY

TOWNSHIP DAMASCUS

SECTION 12

T5 NR 8 E


TYPE MONUMENT P.K./WASHER

ON SURFACE - ~~BELOW~~ YES


LEFT- & PAV'T. - ~~RIGHT~~ YES 2.0'

10' TO LT. EDGE PAVEMENT

S.L.M. 1034+46

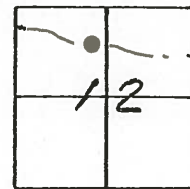

SET PK/WASHER
3-24-92
BVD

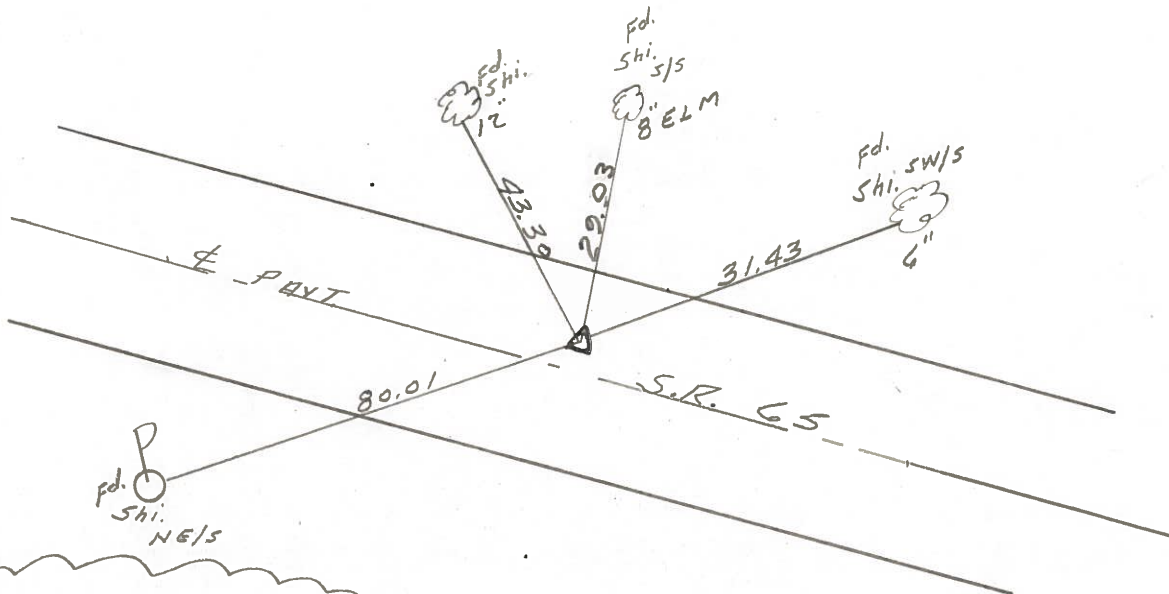

DATA FROM 1924 PLAN
P.I. STA. 132+13.8
 $\Delta = 5^{\circ} 50' 00''$
 $D = 2' 28' 00''$
 $T = 118.14'$
 $R = 2318.76'$
 $L = 238.16'$
 $E = 3.0'$

P.I.
 $\Delta = 5^{\circ} 50' 00''$ RT. (MEAS. 1974)

County HENRY S.R. 65

Date 2-3-84

Township DAMASCUS

Weather P. Clear

Section 12

Temp. 35°

T&N, R&E


Personnel HOFFMAN

LOENRKE H.C.

HOUSEHOLDER R.C.

BARNHISEL

39-B

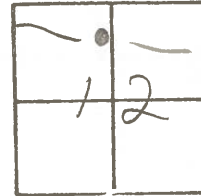

Fd. small P.R. spk 2" Below Surface

SLM = 1033 + 93

2.0' Lt. of R. paut


7.2' TO Lt. EP.

11.2' TO Rt. EP.

SET PK/WASHER

9-17-84

S.W.H.

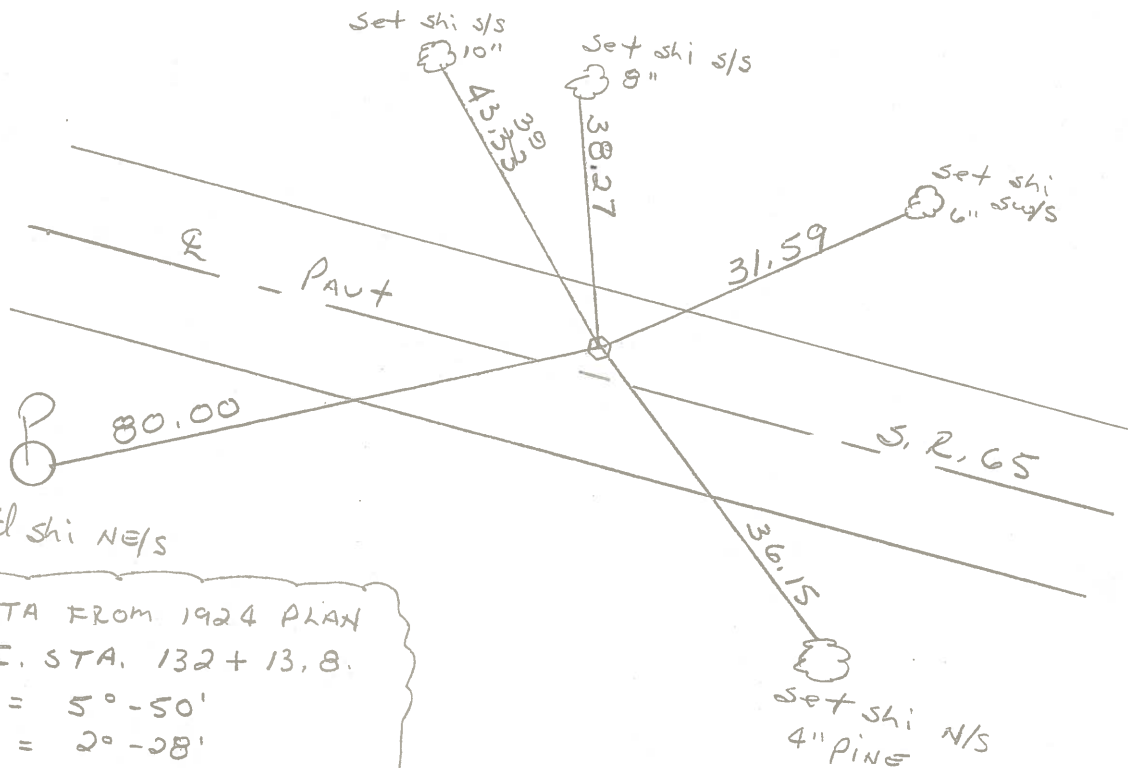


DATA FROM 1924 PLAN
 P.I. STA. 132 + 13.8.
 $\Delta = 5^\circ - 50'$
 $D = 2^\circ - 28'$
 $T = 118.14'$
 $R = 2318.76'$
 $L = 238.16'$
 $E = 3'$

P.I.
 $\Delta = 5^\circ - 50' RT. (MEAS 1974)$

PERSONNEL TITLE PERSONNEL TITLE
 BURNSIDE _____
 SMITH _____
 BOWERS _____
 MEAD _____

COUNTY HENRY DATE 3-7-74
 S. R. 65 WEATHER CLEAR
 SEC. _____ TEMP. +53°

DESCRIPTION ± RW CONTROL TIES JOB NO. _____

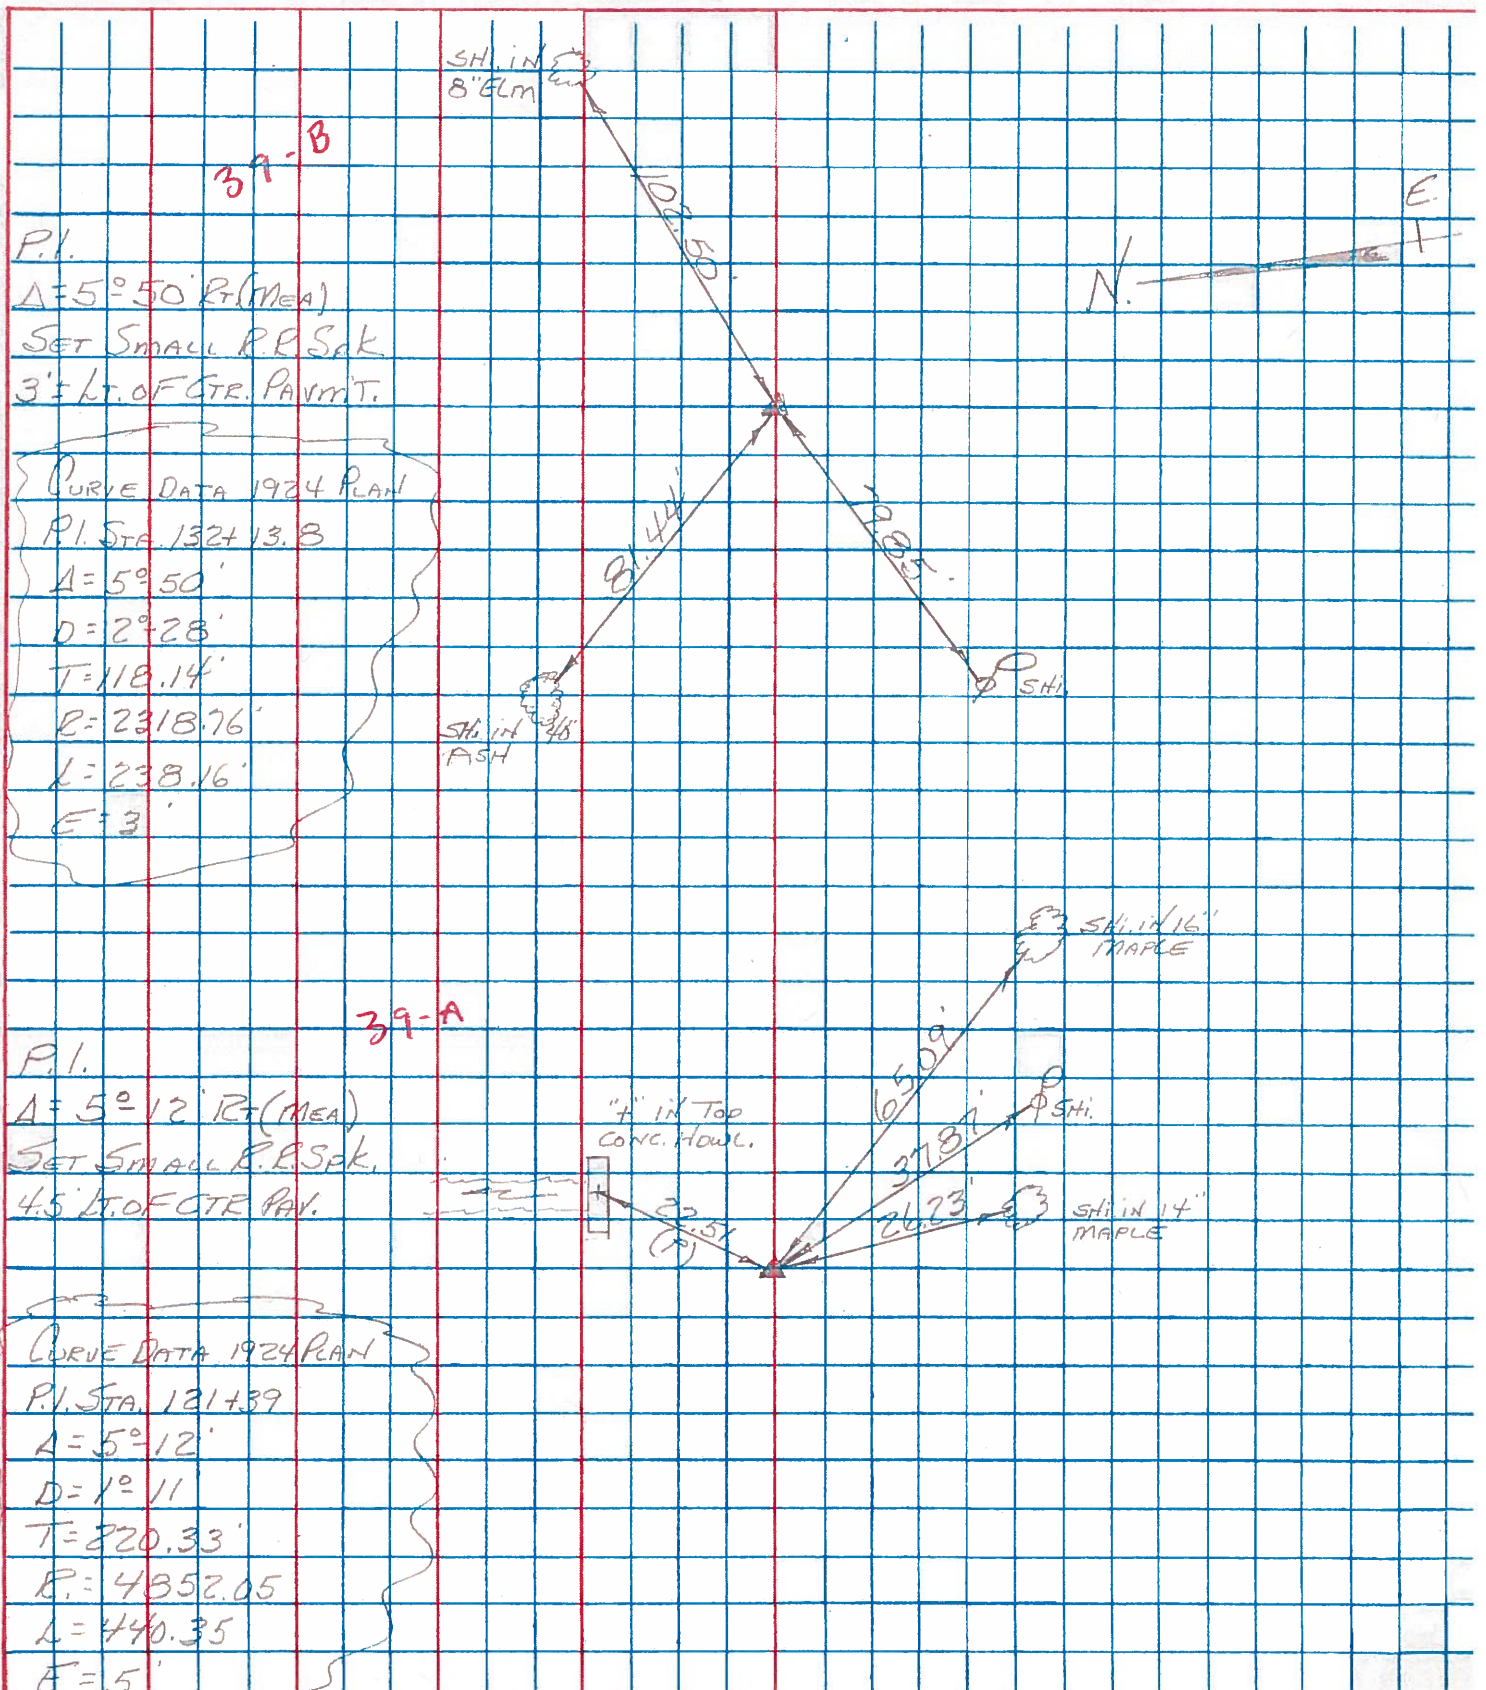

P.I.
 $\Delta = 5^\circ 50'$ Rt (MEA)
 SET SMALL R.P. SAK
 3' Lt. OF CTR. PAVMT.

CURVE DATA 1924 PLAN
 P.I. STA. 132+13.8
 $A = 5^\circ 50'$
 $D = 2^\circ 28'$
 $T = 118.14'$
 $R = 2318.76'$
 $L = 238.16'$
 $E = 3'$

P.I.
 $\Delta = 5^\circ 12'$ Rt (MEA)
 SET SMALL R.P. SAK
 4.5' Lt. OF CTR. PAV.

CURVE DATA 1924 PLAN
 P.I. STA. 131+39
 $A = 5^\circ 12'$
 $D = 1^\circ 11'$
 $T = 220.33'$
 $R = 4352.05'$
 $L = 440.35'$
 $E = 1.5'$