
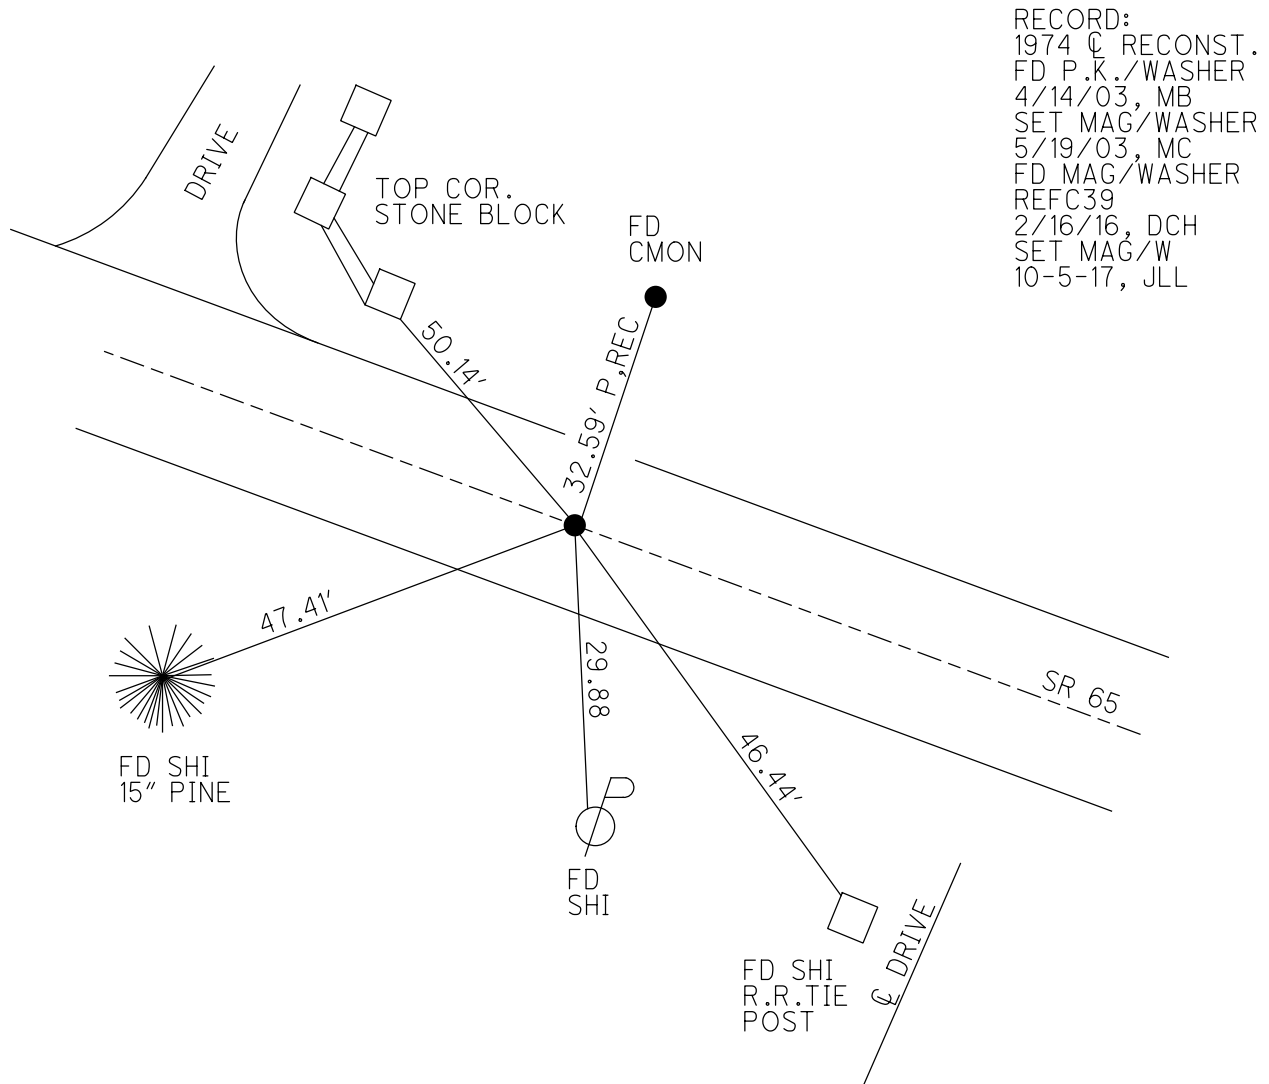


O.D.O.T. DISTRICT 2 SURVEY OFFICE (USE ONLY)

PERSONNEL	REFERENCE NO.	39 C	SHEET	21	OF	24
NOTES	RHOADES	DATE	4-28-17	ROUTE	SR 65	
H.C.	LEU	WEATHER	FAIR	COUNTY	HENRY	
R.C.	HELDMAN	TEMP.	46°	TOWNSHIP	DAMASCUS	
				SECTION	12	
				T	5	N
				R	8	E

TYPE MONUMENT MAG/WASHER
 ON SURFACE - ~~BELOW~~ ON _____
~~LEFT - C~~ PAV'T - ~~RIGHT~~ 0.8'
 10.5' TO LT EDGE PAVEMENT
 S.L.M. 1037+10.42
 Grid: Northing: 638994.295 Easting: 1586416.117

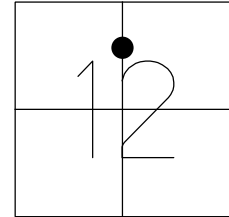

RECORD:
 1974 C RECONST.
 FD P.K./WASHER
 4/14/03, MB
 SET MAG/WASHER
 5/19/03, MC
 FD MAG/WASHER
 REFC39
 2/16/16, DCH
 SET MAG/W
 10-5-17, JLL

O.D.O.T. DISTRICT 2 SURVEY OFFICE

PERSONNEL _____

REFERENCE NO. 39-C

SHEET 23 OF 26

NOTES BARNHISEL - H.C.

H.C. _____

DATE 4-14-03

ROUTE 65

R.C. GLASS

WEATHER CLEAR

COUNTY HENRY

RYALL

TEMP. +65°

TOWNSHIP DAMACUS

SECTION 12

T 5 N R 8 E


TYPE MONUMENT P.K. & WASHER

ON SURFACE - BELOW SURFACE

LEFT - PAV'T. - RIGHT ON ϕ


10.5' TO LT. EDGE PAVEMENT

S.L.M. 1036 + 94

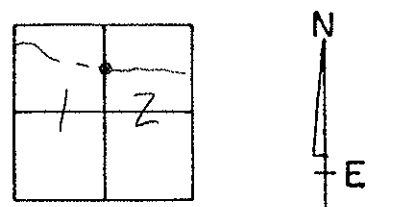

RECORD: USED FOR LINE IN
1974 RECONSTRUCTION OF S.R. #65 ϕ

RESET MAG & WASHER
5-19-03
M.C.

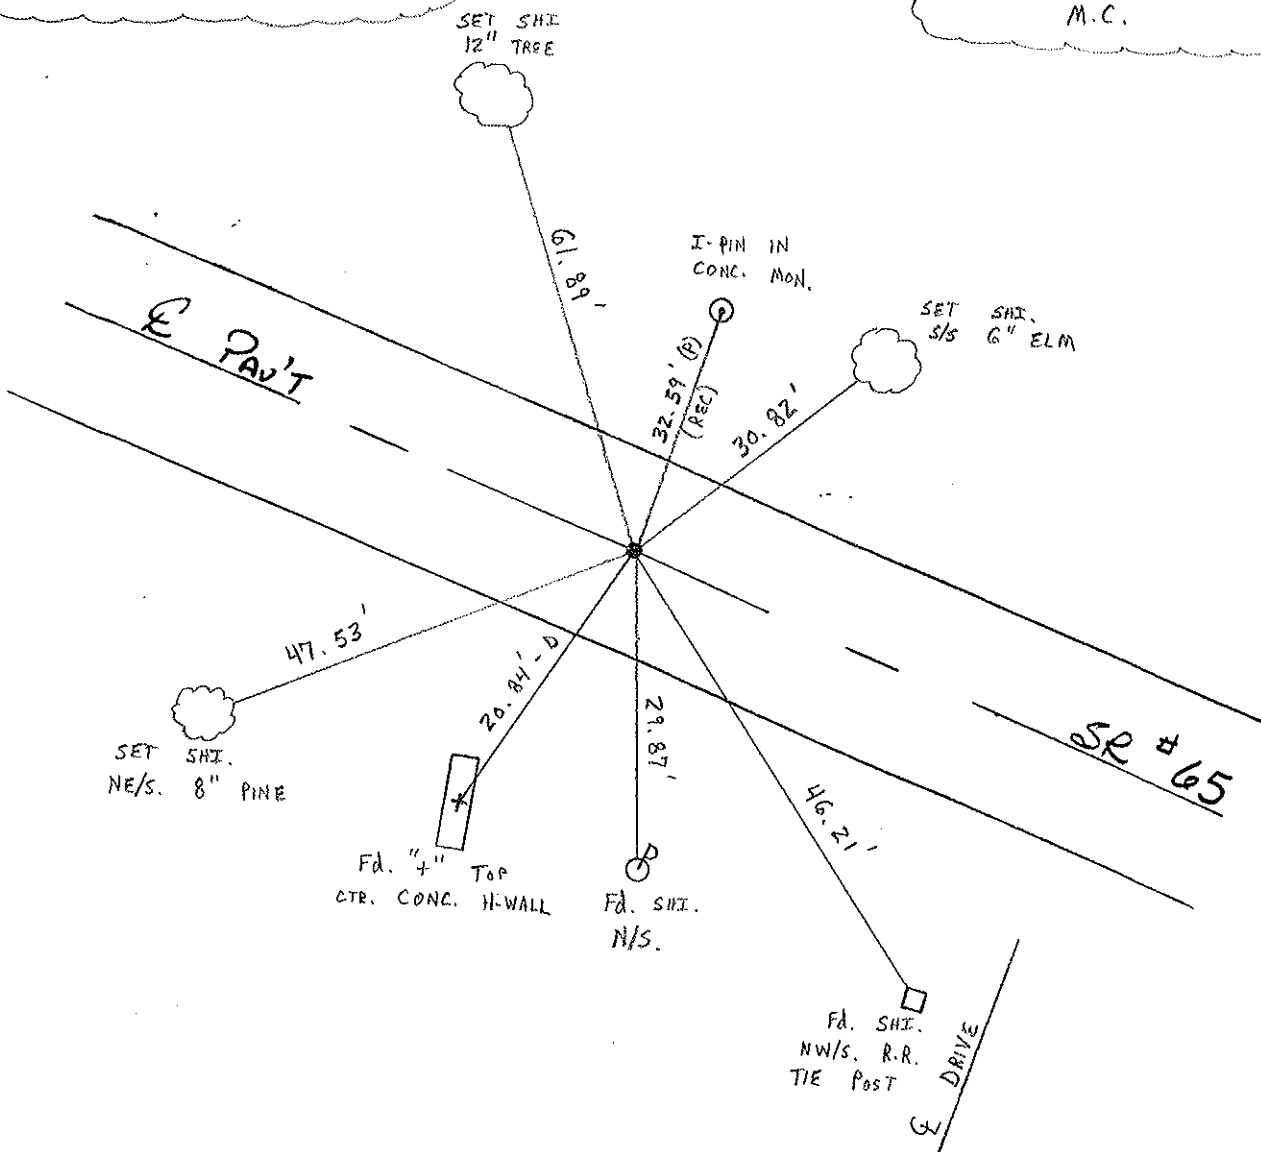

O.D.O.T. DISTRICT 2 SURVEY OFFICE

PERSONNEL _____

REFERENCE NO. 39-C

SHEET _____ OF _____

NOTES LONG

H.C. VANDUSEN

DATE 9-20-91

ROUTE 65

R.C. BARNHISEL

WEATHER CLEAR

COUNTY HENRY

TEMP. + 56°

TOWNSHIP DAMASCUS

SECTION 12

T 5 N R 8 E


TYPE MONUMENT PK/WASHER

ON SURFACE - ~~BELOW~~ YES

LEFT- & PAV'T. - RIGHT .6'


9.0' TO RT. EDGE PAVEMENT

S.L.M. 1038+05

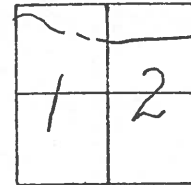

SET PK/WASHER
3-24-92
BVD

RECORDS
USED FOR LINE IN 1974
RECONSTRUCTION OF
SR. 65 &

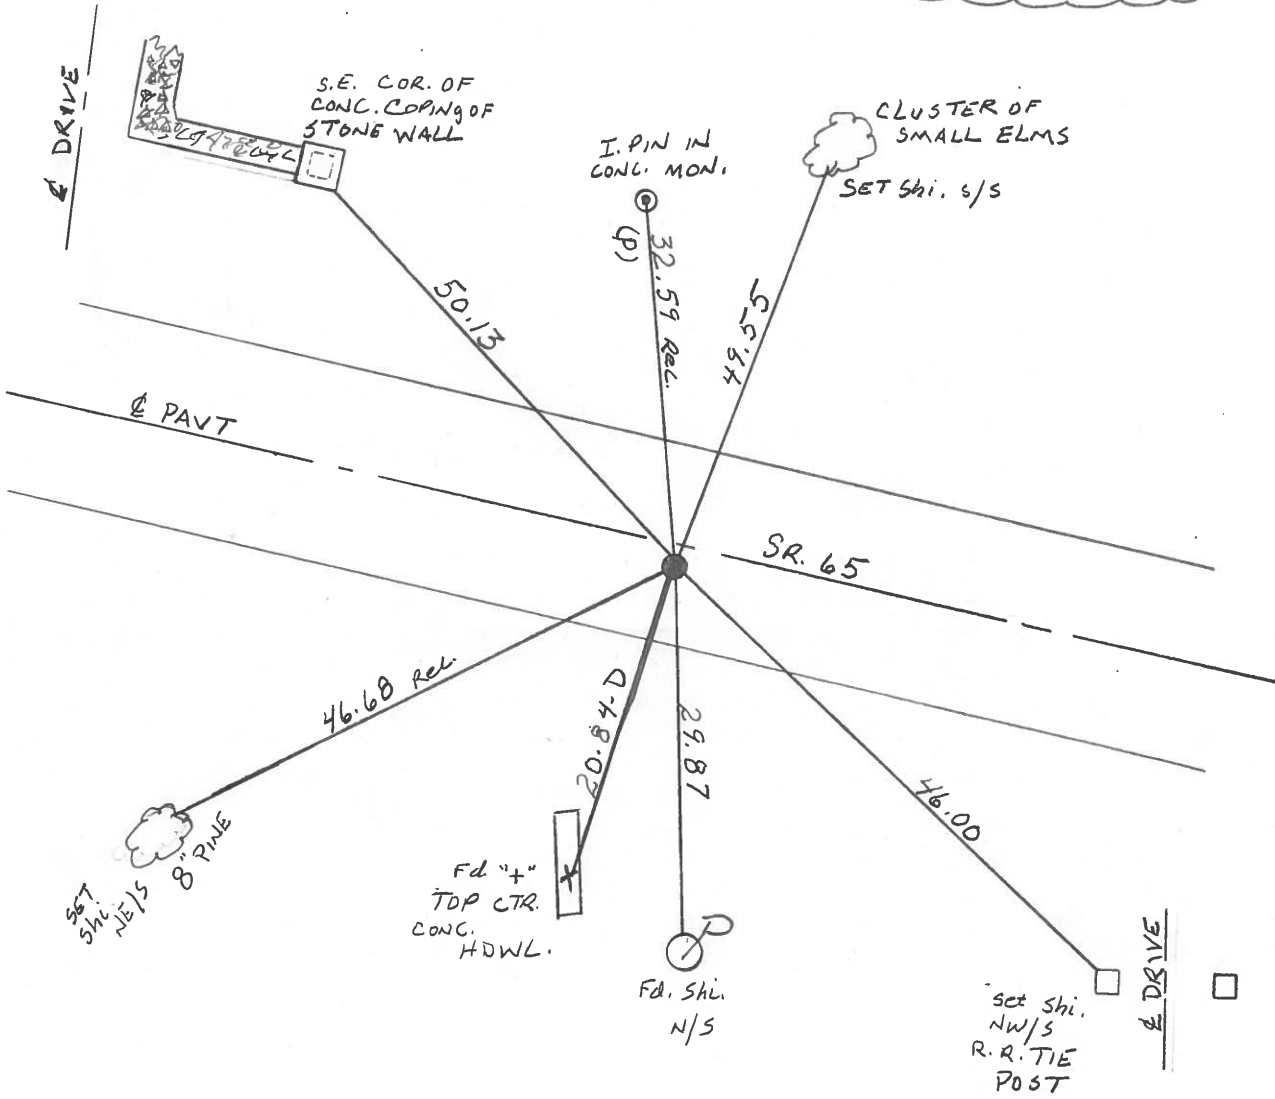

County HENRY S.R. 65

Date 2-3-84

Township DAMASCUS

Weather Cloudy

Section 12

Temp. 30°

T5N, R8E


Personnel HOFFMAN

LOEHRKE H.C.

HOUSEHOLDER R.C.

BARNHISEL

#39-C

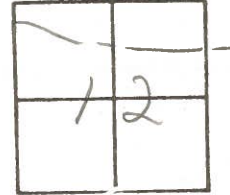

Fd 1" IRON ROD 2" BELOW SURFACE

SLM 1037+53


Record:

USED FOR LINE IN 1974 RECONSTRUCTION
of SR65 &

SET PK/WASHER

9-17-84

S.W.H.

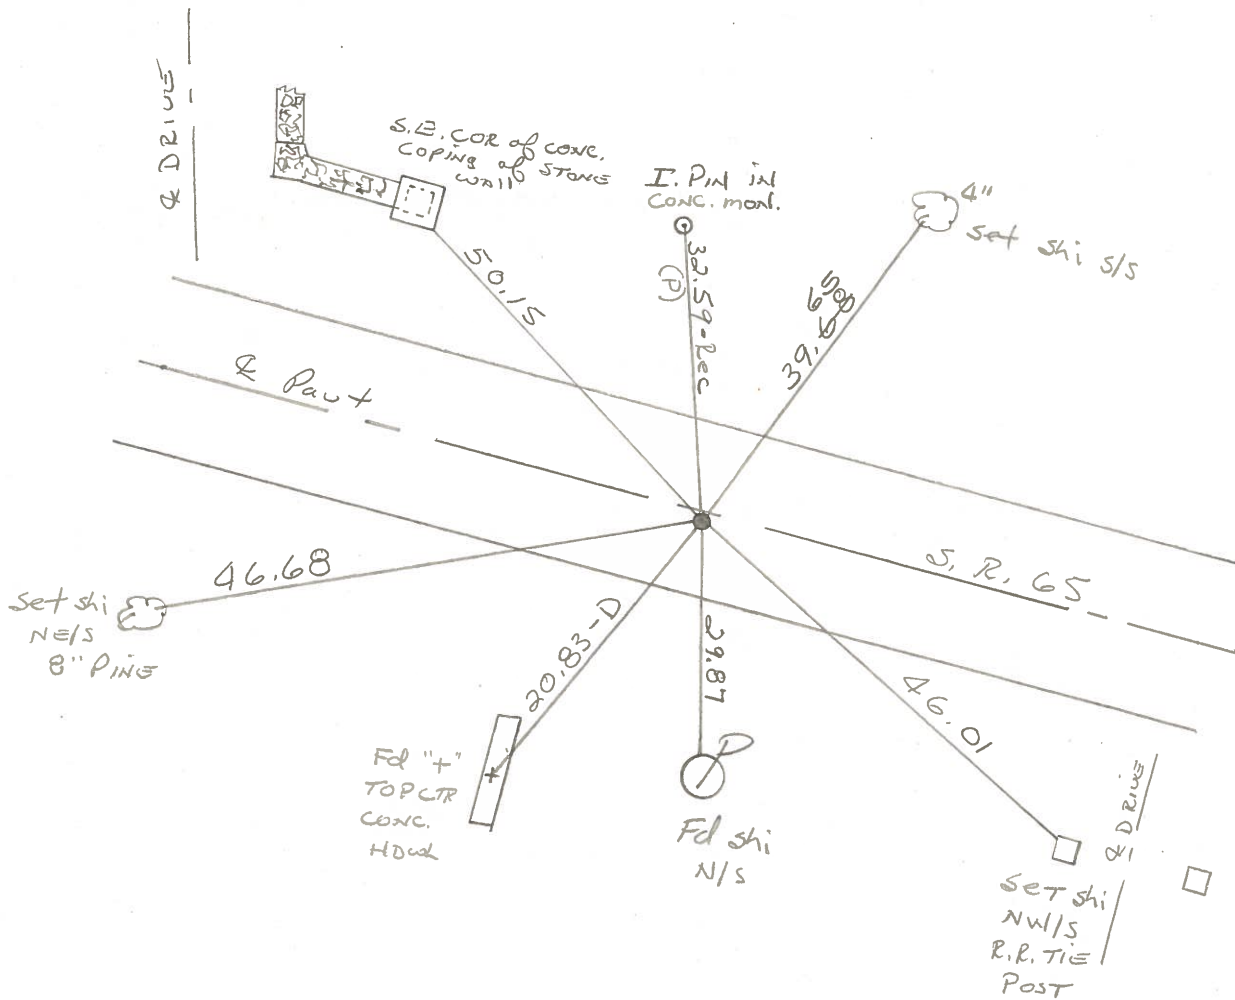

PERSONNEL	TITLE	PERSONNEL	TITLE
BURNSIDE			
SMITH			
BOWERS			
MEAD			

COUNTY HENRY DATE 3-7-74
 S. R. 65 WEATHER CLEAR
 SEC. _____ TEMP. +60°

DESCRIPTION ± P.W. CONTROL TIES JOB NO. _____

