


O.D.O.T. DISTRICT 2 SURVEY OFFICE (USE ONLY)


PERSONNEL _____ REFERENCE NO. 39 D SHEET 22 OF 24
 NOTES RHOADES DATE 4-28-17 ROUTE SR 65
 H.C. LEU WEATHER FAIR COUNTY HENRY
 R.C. HELDMAN TEMP. 46° TOWNSHIP DAMASCUS
 _____ SECTION 12
 _____ T 5 N R 8 E

TYPE MONUMENT MAG/WASHER
 ON SURFACE - ~~BELOW~~ ON
~~LEFT~~ - ℄ PAV'T - RIGHT 5.0'
5.1' TO RT EDGE PAVEMENT
 S.L.M. 1041+34.31

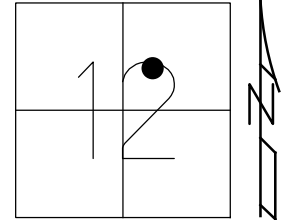

Grid: Northing: 638841.110 Easting: 1586757.184

RECORD: P.I.
 DATA 1924 PLAN
 STA. 139+48
 $\Delta = 1^{\circ}54' 00''$
 $\Delta = 2^{\circ}00' 40''$ LT
 MEANS. 1974
 FD P.K.NAIL
 4/14/03, MB
 SET MAG/WASHER
 5/19/03, MC
 FD MAG/WASHER
 REFD39
 2/16/16, DCH
 SET MAG/WASHER
 10-5-17, JLL

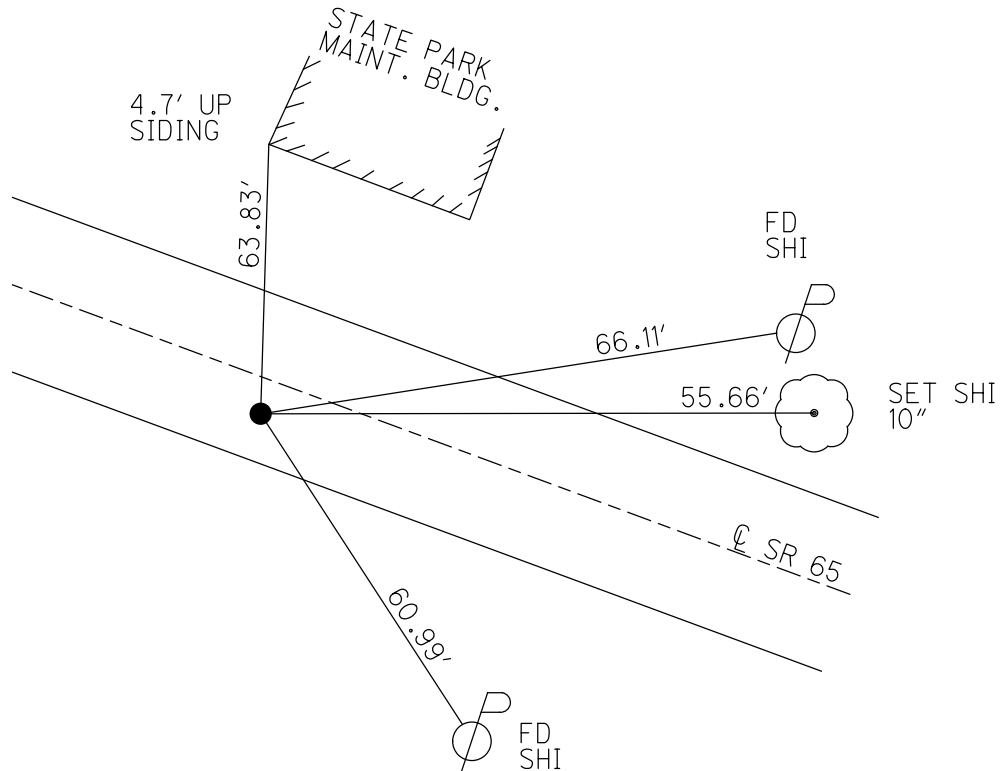

O.D.O.T. DISTRICT 2 SURVEY OFFICE

PERSONNEL

REFERENCE NO. 39-D

SHEET 24 OF 26

NOTES BARNHISEL - H.C.

H.C. _____

DATE 4-14-03

ROUTE 65

R.C. GLASS

WEATHER CLEAR

COUNTY HENRY

RYALL

TEMP. +65°

TOWNSHIP DAMACUS

SECTION 12

T 5 N R 8 E


TYPE MONUMENT P.K. NAIL

ON SURFACE - BELOW SURFACE

LEFT- <math>\epsilon</math> PAV'T. - RIGHT 4.4' RT

5.1' TO RT. EDGE PAVEMENT

S.L.M. 1040 + 68

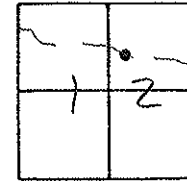

DATA 1924 PLAN

P.I. STA. 139+48


$\Delta = 1^{\circ} - 54' - 00''$

P.I. $\Delta = 2^{\circ} - 00' - 40''$ LT.
(MEAS. 1974)

RESET MAG & WASHER

5-19-03

M.C.

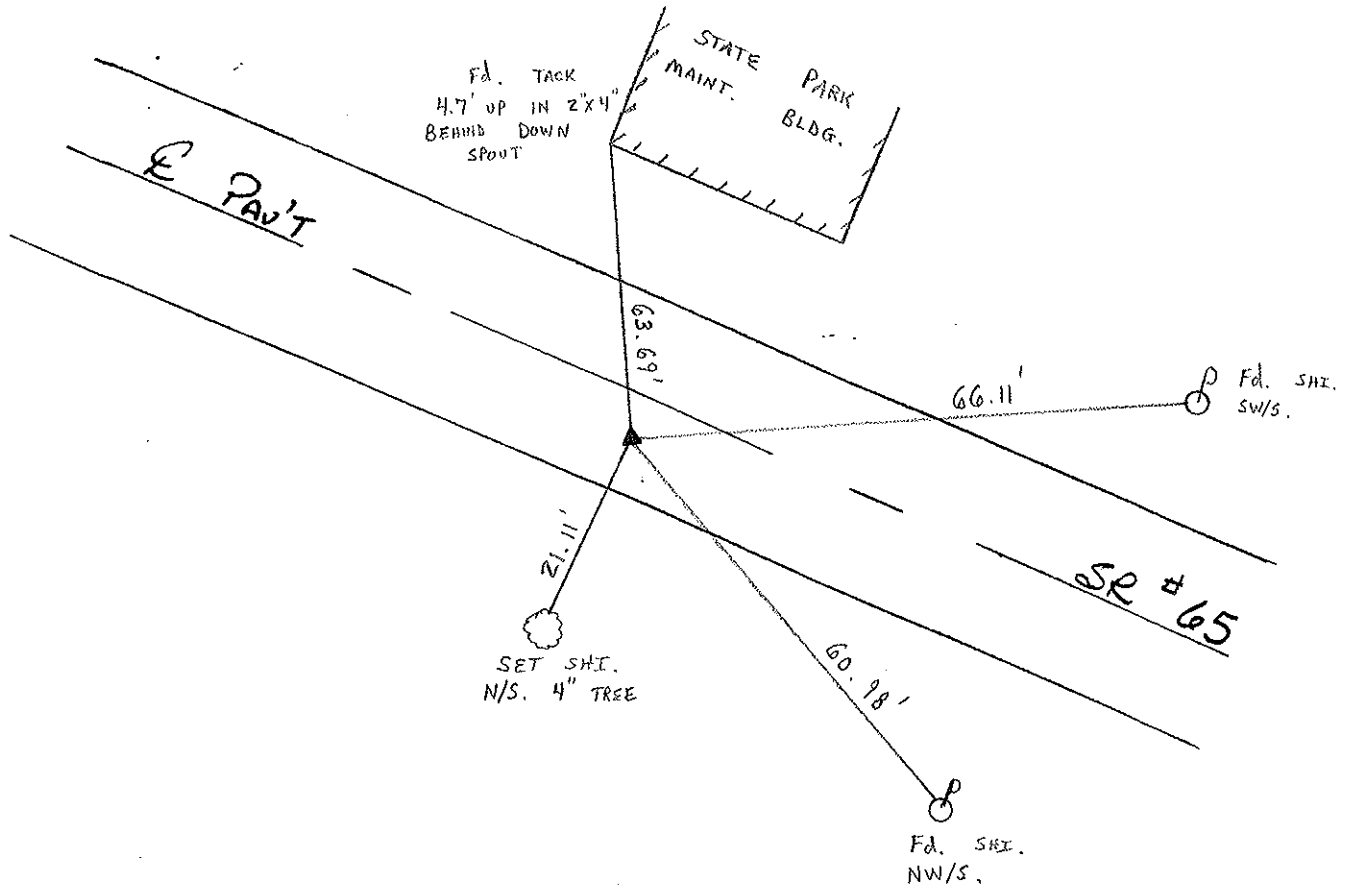

O.D.O.T. DISTRICT 2 SURVEY OFFICE

PERSONNEL

REFERENCE NO. 39-D

SHEET _____ OF _____

NOTES VAN DUSEN

H.C. BARNHISEL

R.C. LONG

DATE 9-20-91

WEATHER CLEAR

TEMP. +56°F

ROUTE 65

COUNTY HENRY

TOWNSHIP DAMASCUS

SECTION 12

T. _____ R. _____


TYPE MONUMENT P.K./WASHER

ON SURFACE - ~~BELOW~~ YES

~~LEFT - C PAVT.~~ - RIGHT YES 4.8

5.6 TO RT. EDGE PAVEMENT


S.L.M. 1041+79

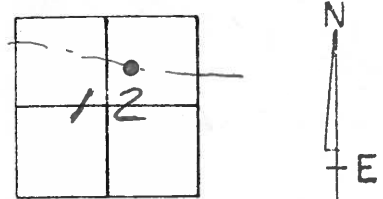

SET PK/WASHER
 3-24-92
 BVD

DATA 1924 PLAN
 P.I. STA. 139+48
 $\Delta = 1^{\circ}54'00''$

P.I. $\Delta = 2^{\circ}00'40''$ LT.
 (MEAS. 1974)

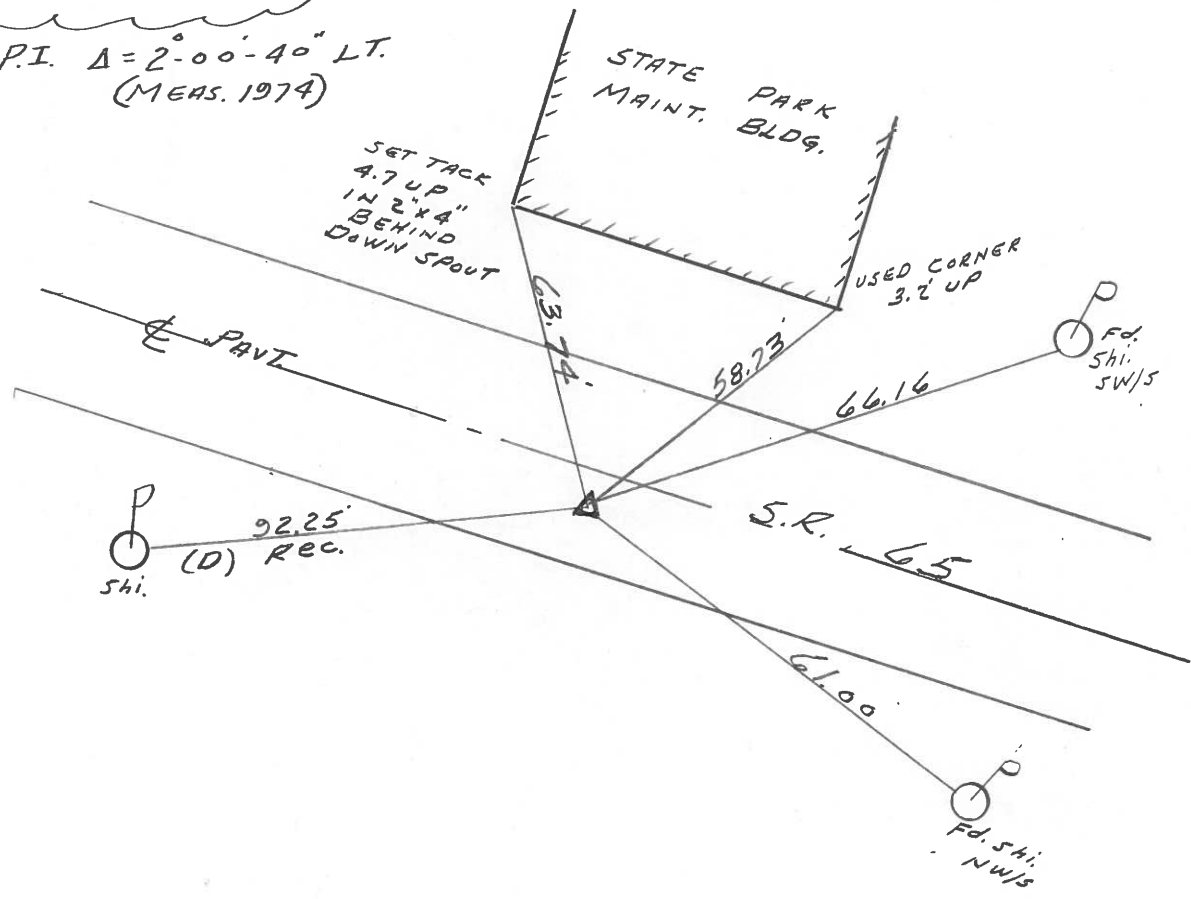

County HENRY S.R. 65

Township DAMASCUS

Section 12

T5N, R8E

Personnel HOFFMAN

LOEHLE H.C.

HOUSEHOLDER R.C.


BARNHISEL

39-D

Date 2-3-84

Weather Cloudy

Temp. 30°

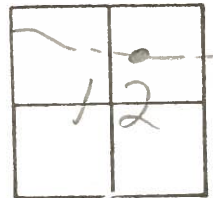

Fd P.K. Nail 1/2" Below surface

SLM 1041+26

4.2' Rt. of & PAUT

6.0' TO RT. EP.

13.0' TO Lt. EP.


SET PK/WASHER

9-17-84

SWH


DATA 1924 PLAN
 P.I. STA 139+48
 $\Delta = 10-54'$

P.I.
 $\Delta = 20-00'-40''$ Lt.
 (MEAS 1974)

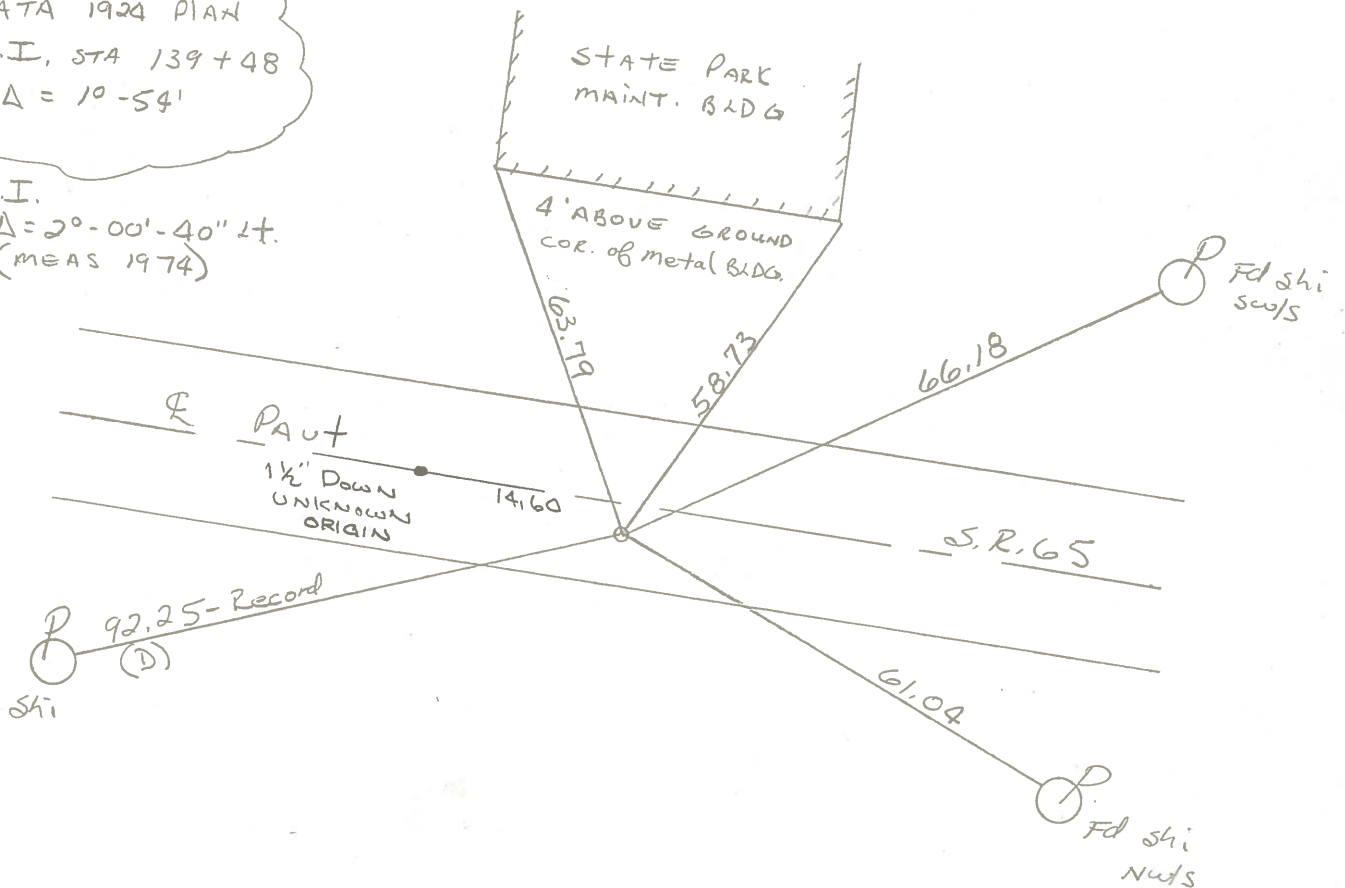

PERSONNEL	TITLE	PERSONNEL	TITLE	COUNTY	HENRY	DATE	3-7-74
BURNSIDE				S. R.	65	WEATHER	CLEAR
SMITH				SEC.		TEMP.	+60°
BOWERS							
MEAD							

DESCRIPTION ± PLY CONTROL TIES JOB NO. _____

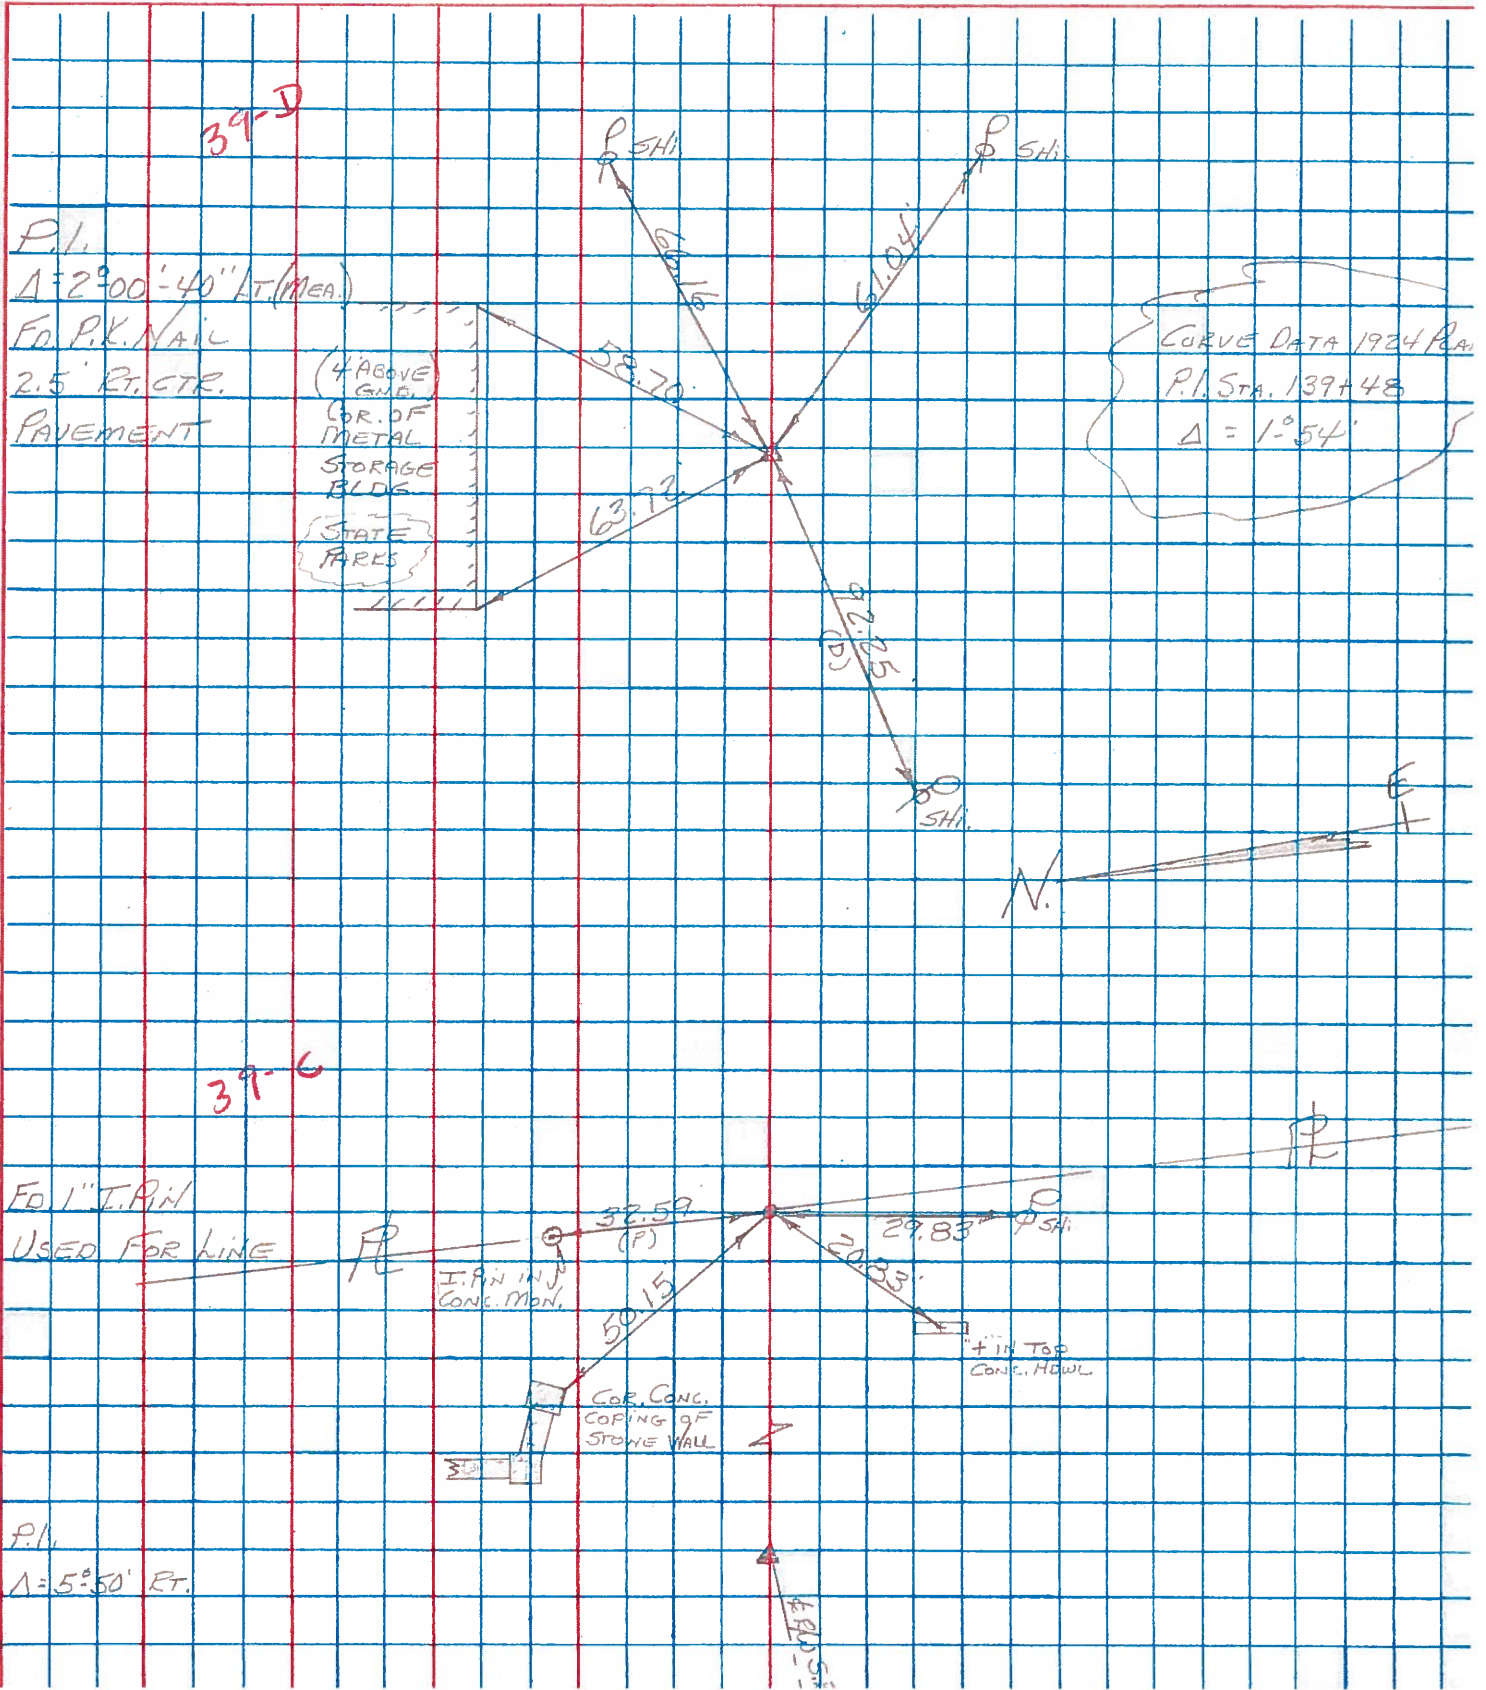

CURVE DATA 1924 P.C.
 P.I. STA. 139+48
 $\Delta = 1^{\circ}54'$