



O.D.O.T. DISTRICT 2 SURVEY OFFICE (USE ONLY)

PERSONNEL \_\_\_\_\_ REFERENCE NO. 39 E SHEET 23 OF 24  
 NOTES RHOADES DATE 4-28-17 ROUTE SR 65  
 H.C. LEU WEATHER FAIR COUNTY HENRY  
 R.C. HELDMAN TEMP. 46° TOWNSHIP DAMASCUS  
 \_\_\_\_\_ SECTION 12  
 \_\_\_\_\_ T 5 N R 8 E

TYPE MONUMENT MAG/WASHER  
 ON SURFACE - ~~BELOW~~ ON \_\_\_\_\_  
~~LEFT - C~~ PAV'T - RIGHT 5.6'  
5.4' TO RT EDGE PAVEMENT  
 S.L.M. 1052+65.17  
 Grid: Northing: 638414.488 Easting: 1587804.490

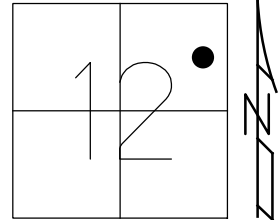

RECORD: P.I.  
 DATA FROM 1924 PLAN  
 STA. 150+92.2  
 $\Delta = 8^{\circ}17' 00''$  LT  
 D = 5'1" 00"  
 T = 82.80'  
 R = 1143.38'  
 L = 165.30'  
 E = 3'  
 $\Delta = 8^{\circ}05' 30''$  LT  
 1974  
 FD P.K./WASHER  
 4/14/03  
 SET MAG/WASHER  
 5/19/03, MC  
 FD MAG/WASHER  
 REFE39  
 2/16/16, DCH  
 SET MAG/WASHER  
 10/4/17, JLL

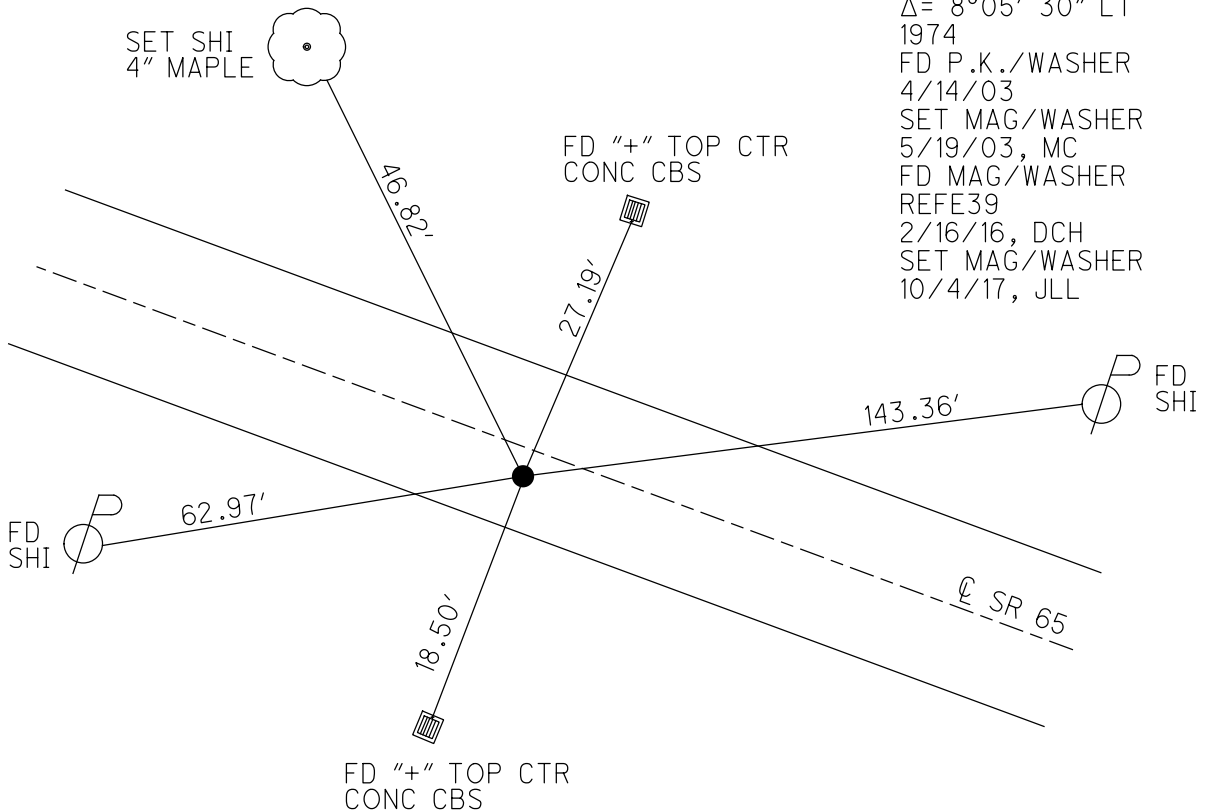

# O.D.O.T. DISTRICT 2 SURVEY OFFICE

PERSONNEL

REFERENCE NO. 39-E

SHEET 25 OF 26

NOTES BARNHISEL - H.C.

H.C. \_\_\_\_\_

DATE 3-11-03

ROUTE 65

R.C. GLASS

WEATHER CLEAR

COUNTY HENRY

RYALL

TEMP. +56°

TOWNSHIP DAMACUS

SECTION 12

T. 5 N. R. 8 E


TYPE MONUMENT P.K. & WASHER

ON SURFACE - BELOW SURFACE


LEFT - 0 PAV'T. - RIGHT 4.0' RT

5.4' TO RT. EDGE PAVEMENT

S.L.M. 1051+99

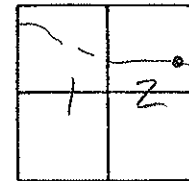

RESET MAG/WASHER  
5-19-03  
M.C.

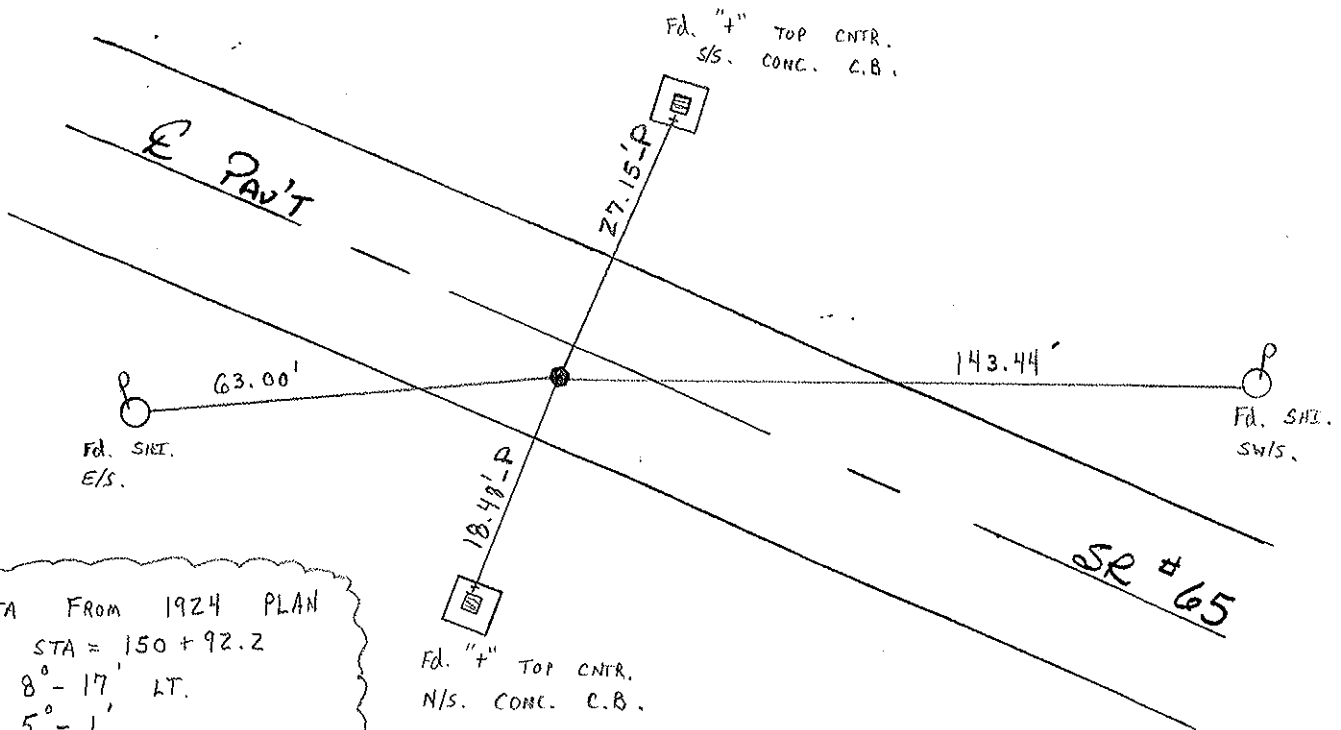

DATA FROM 1924 PLAN

P.I. STA = 150+92.2

A = 8°-17' LT.

D = 5'-1'

T = 82.80

R = 1143.38

L = 165.30

E = 3'

P.I.

A = 8°-05'-30" LT. (1974)

# O.D.O.T. DISTRICT 2 SURVEY OFFICE

PERSONNEL

REFERENCE NO. 39-E

SHEET \_\_\_\_\_ OF \_\_\_\_\_

NOTES LONG

H.C. VANDUSEN

DATE 9-20-91

ROUTE 65

R.C. BARNHISEL

WEATHER CLEAR

COUNTY HENRY

TEMP. +56°

TOWNSHIP DAMASCUS

SECTION 12

T 5 N R B E


TYPE MONUMENT P.K. / WASHER

ON SURFACE - ~~BELOW~~ YES


LEFT - ℄ PAV'T. - RIGHT 4.0'

5.8 TORT. EDGE PAVEMENT

S.L.M. 1053+10

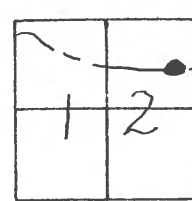

SET PK/WASHER  
 3-24-92  
 BVD

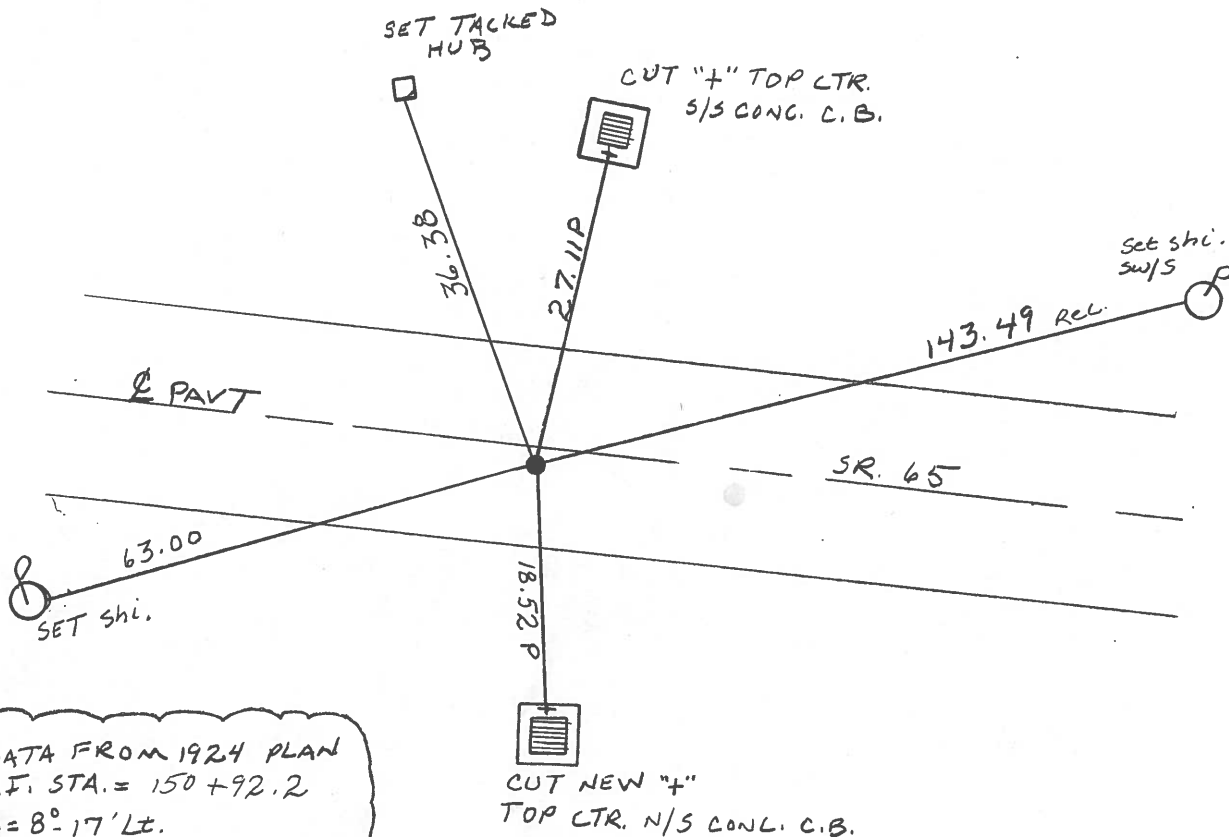

DATA FROM 1924 PLAN  
 P.I. STA. = 150+92.2  
 $\Delta = 8^{\circ} 17' Lt.$   
 $D = 5^{\circ} - 1'$   
 $T = 82.80$   
 $R = 1143.38$   
 $L = 165.30$   
 $E = 3'$

P.I.  
 $\Delta = 8^{\circ} 05' 30'' Lt. (1974)$

County HENRY S.R. 65

Township DAMASCUS

Section 12

TSN, R8E

Personnel HOFFMAN

LOHRKE H.C.


HOUSEHOLDER R.C.

BARNHISEL

Date 2-3-84

Weather Cloudy

Temp. +30°

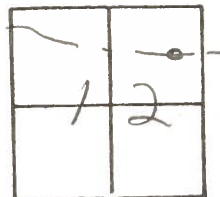

Fd P.K. Nail 1 1/2" below surface

S.L.M. 1052+58

3.9' Rt of &Paut


5.5' to RT. EP

13.0' to Lt. EP

SET PK/WASHER

9-17-84

S.W.H.

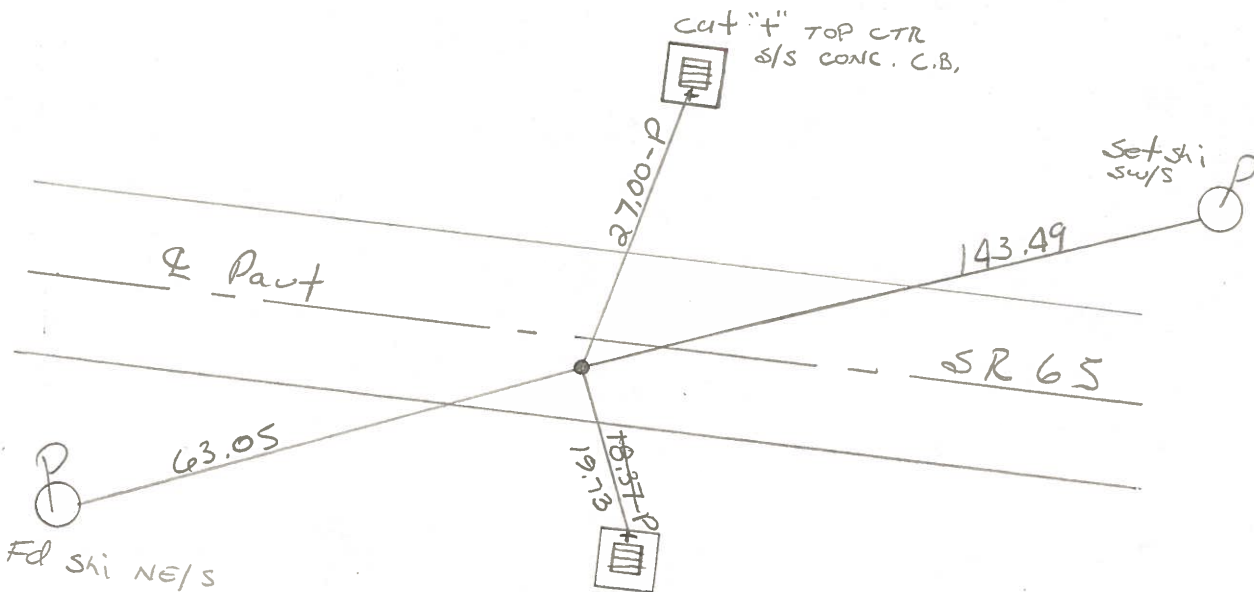

DATA FROM 1924 PLAN  
 P.I. STA = 150+92.2  
 $\Delta = 8^{\circ}-17'$  Lt.  
 $D = 5^{\circ}-1'$   
 $T = 82.80$   
 $R = 1143.38$   
 $L = 165.30$   
 $E = 3'$

P.I.  
 $\Delta = 8^{\circ}-05'-30''$  2T (1974)