

O.D.O.T. DISTRICT 2 SURVEY OFFICE (USE ONLY)

PERSONNEL

REFERENCE NO. 1

SHEET 1 OF 21

NOTES GARRETT

DATE 7/6/20

ROUTE SR 108

H.C. LEU

WEATHER PTLY CLOUDY

COUNTY HENRY

R.C. MAHLER

TEMP. 93°

TOWNSHIP PLEASANT

AUBLE

SECTION 35

DWG BY NIESE PID 95739

T 3 N R 6 E

TYPE MONUMENT MAG/WASHER

ON SURFACE - ~~BELOW~~ ON

OFFSET  $\odot$  PAVEMENT ON LT : RT

10.1' TO LT EDGE PAVEMENT


STATION: 0+00

HORZ.DATUM: NAD83 (2011)

GEOID: NAVD88 2012A


GRID: NORTHING: 550587.432

EASTING: 1519269.750

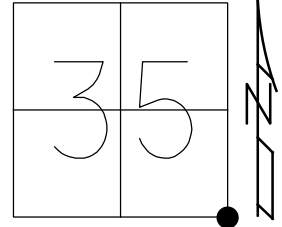

RECORD:  
 FD SMALL R.R. SPIKE  
 4/29/03, MB  
 SET MAG/WASHER  
 10/30/03, MB  
 FD MAG/WASHER  
 REF1  
 2/14/19, JLL  
 SET MAG/WASHER  
 12/14/20, DSA

DIST. 1-1AA= 29.45'

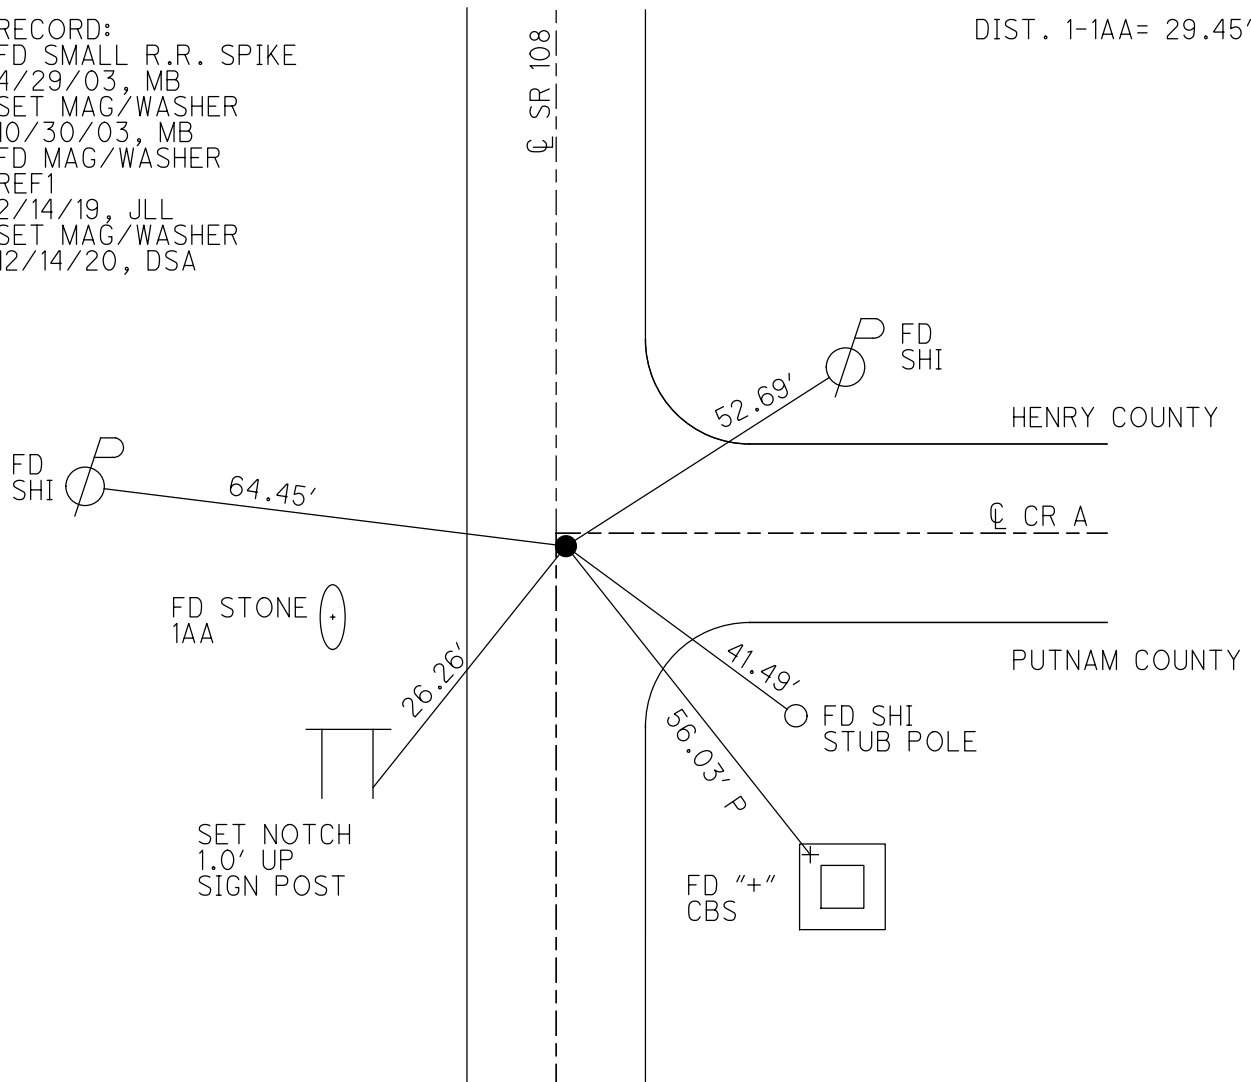

# O.D.O.T. DISTRICT 2 SURVEY OFFICE

PERSONNEL \_\_\_\_\_

REFERENCE NO. 1

SHEET 1 OF 20

NOTES BRUMBAUGH

H.C. BARNHISEL

R.C. GLASS

RYALL

DATE 4-29-03

WEATHER CLEAR

TEMP. +50°

ROUTE S.R. #108

COUNTY HENRY

TOWNSHIP PLEASANT

SECTION 35

T 3 N R 6 E


TYPE MONUMENT 5m. R.R. SPK.

ON SURFACE - BELOW 3" DOWN


LEFT - ♀ PAV'T. - RIGHT ON ♀

10.1 TO LT. EDGE PAVEMENT

S.L.M. 0+00

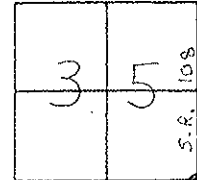

RESET MAG/WASHER  
10/30/03  
M.B.

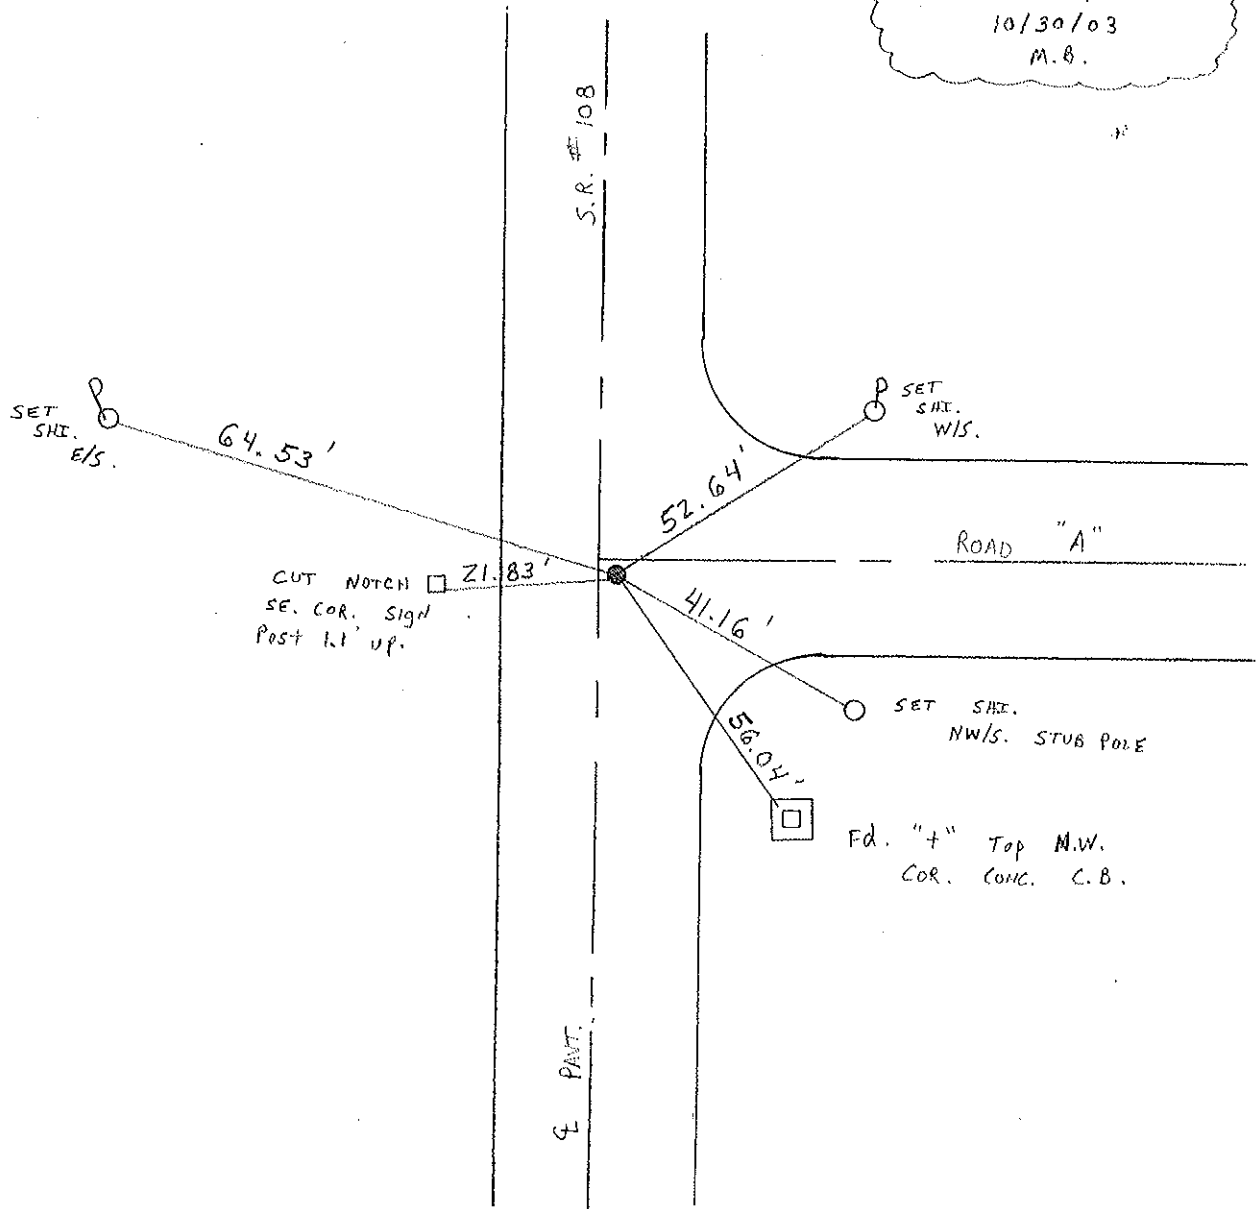

Resurfaced 2003

### O.D.O.T. DISTRICT 2 SURVEY OFFICE

PERSONNEL

REFERENCE NO. 1

SHEET 1 OF 54

NOTES LOEHRKE

H.C. POMETO

DATE 7-17-92

ROUTE S.R. 100

R.C. FALKOWSKI

WEATHER RAIN

COUNTY Henry

TEMP. +70

TOWNSHIP PLEASANT

SECTION \_\_\_\_\_

T 3 N R 6 E


TYPE MONUMENT P.K. & WASHER

ON SURFACE - BELOW Yes


LEFT - 0 PAV'T. - RIGHT 0.5

10.2 TO 14 EDGE PAVEMENT

S.L.M. 0-02

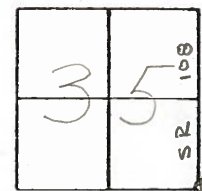

POTNAM CO.

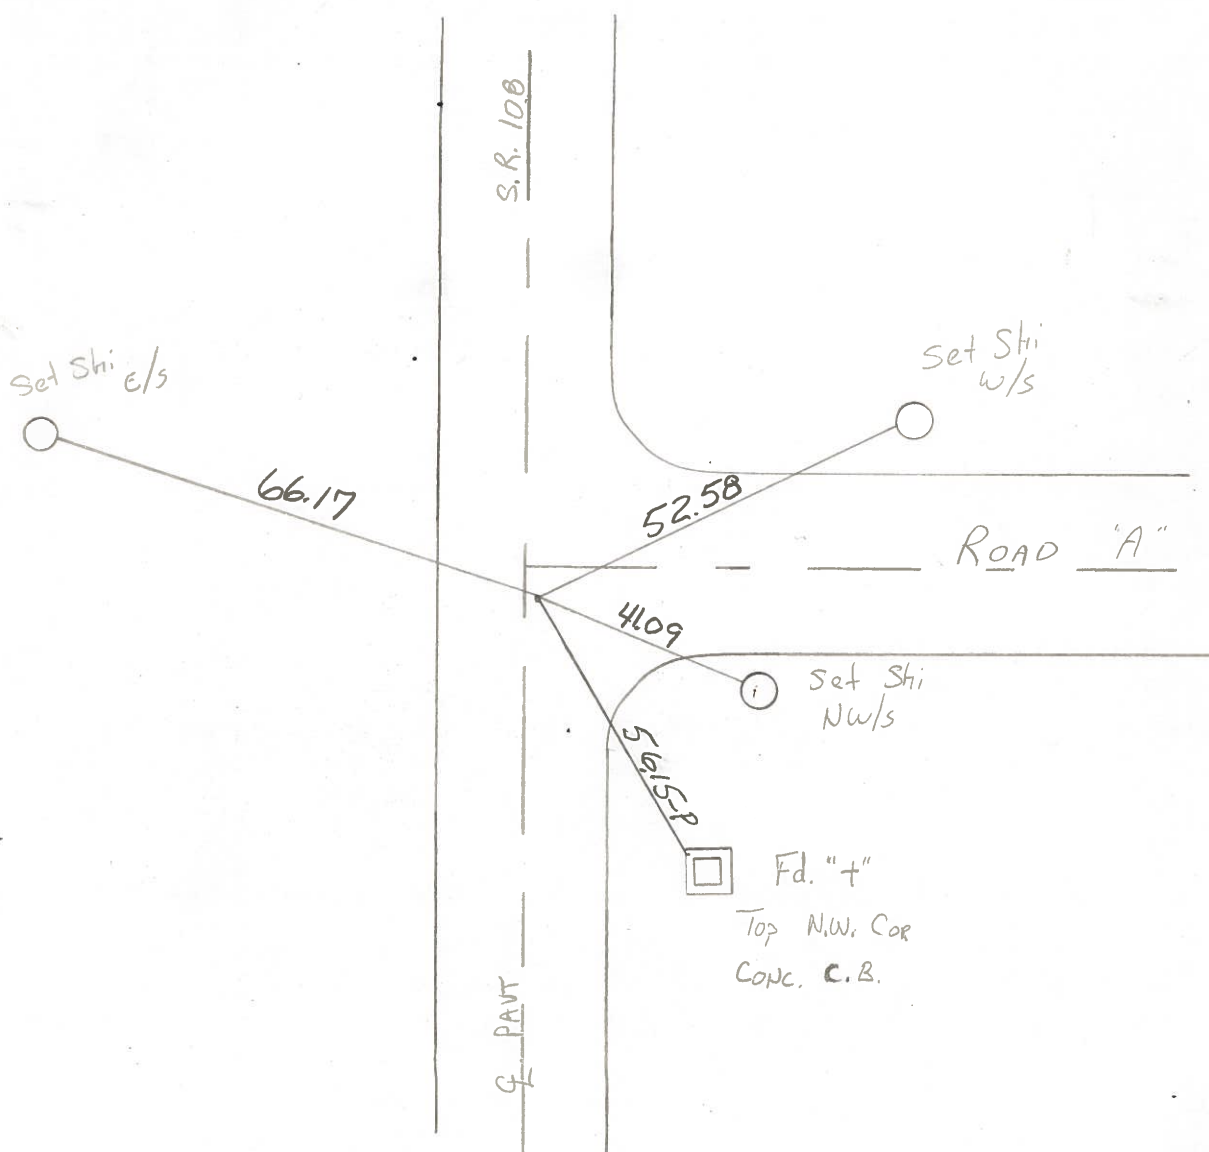

County Henry S.R. 108

Township Pleasant

Section \_\_\_\_\_

T3N, R6E

Personnel Barnhisel


Loehrke H.C.

Householder R.C.

Date 5-2-84

Weather Clear

Temp. +55°

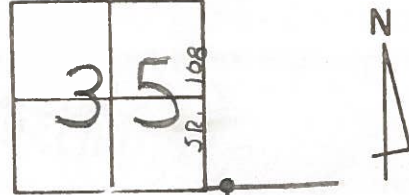

Putnam Co

8-20-84

Set PK./WASHER

M.D.B.

①


SLM: 0+00

4.7 ft S. OF E PAVT  
OF RD "A"

9.7 Rt. OF Lt. EP.

1.0 Rt of E 108

FD. 3m RR. SPK  
@ SURFACE

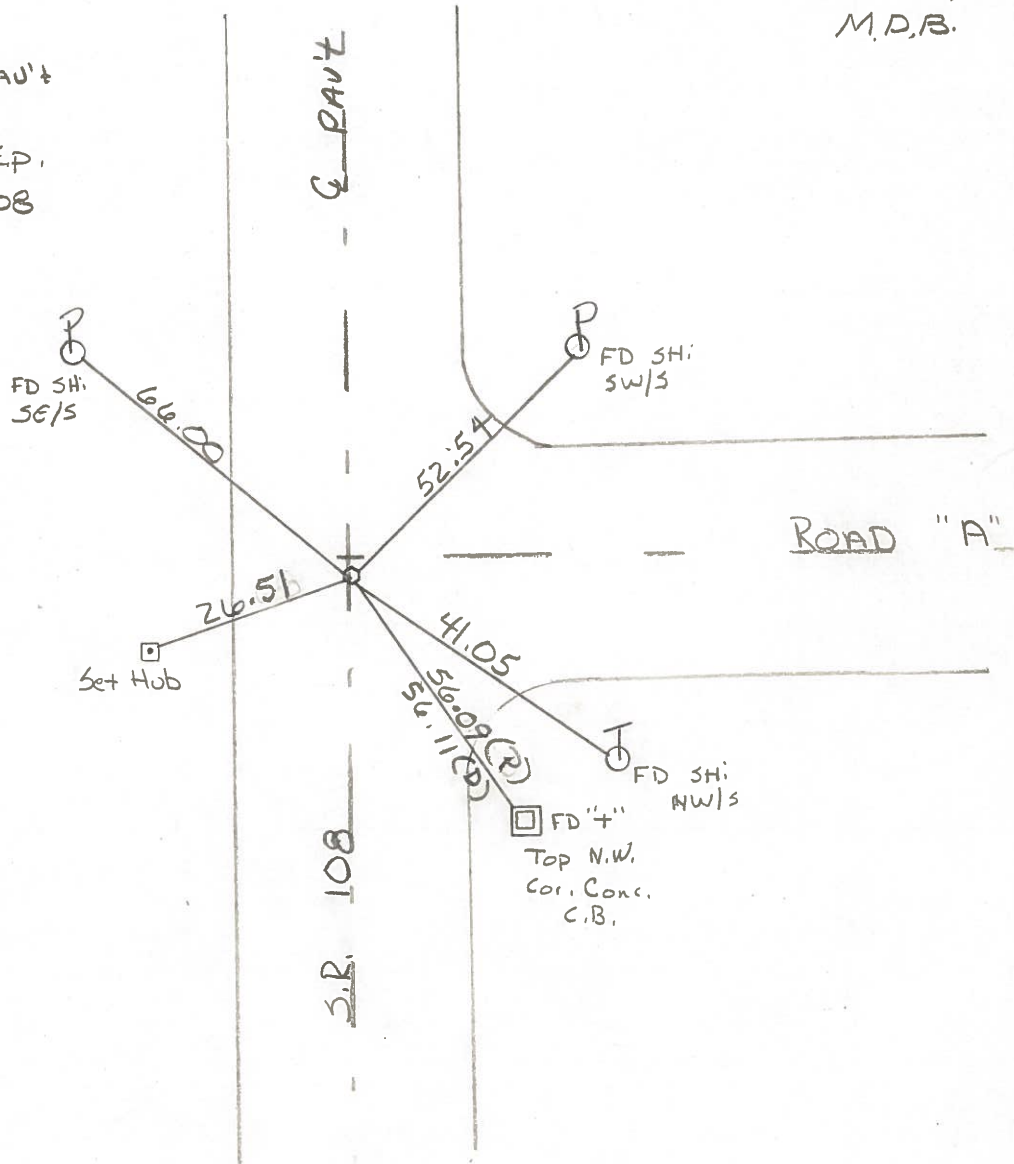

County HENRY

Township PLEASANT

Section \_\_\_\_\_

T3N, R6E

Personnel BURNSIDE

BOWERS


\_\_\_\_\_

\_\_\_\_\_

Date 8-2-78

Weather CLOUDY

Temp. +72°

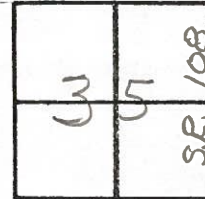

PUTNAM Co.



HENRY

SEC. 35

COUNTY ①

SEC. 36


108

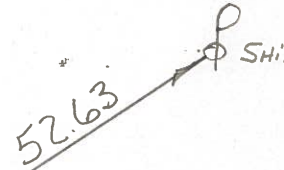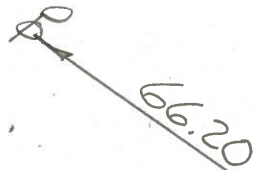

ROAD "A"

FD. R.R. SPK  
@ SURFACE

PUTNAM CO. STONE?

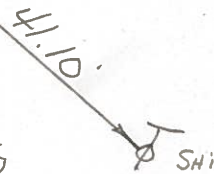

S.R.

"+" Top N.W.  
COR CONC.  
C.B.

PUTNAM

COUNTY