


O.D.O.T. DISTRICT 2 SURVEY OFFICE (USE ONLY)


PERSONNEL \_\_\_\_\_ REFERENCE NO. 1 A SHEET 3 OF 21  
 NOTES GARRETT DATE 7/6/20 ROUTE SR 108  
 H.C. LEU WEATHER CLEAR COUNTY HENRY  
 R.C. MAHLER TEMP. 81° TOWNSHIP PLEASANT  
AUBLE SECTION 35  
 DWG BY NIESE PID 95739 T 3 N R 6 E

TYPE MONUMENT 1/2" IPIPE  
~~ON SURFACE~~ - BELOW 6.5'  
 OFFSET Q PAVEMENT 8.8' LT : ~~RT~~  
1.7' TO LT EDGE PAVEMENT  
 STATION: 26+42.28

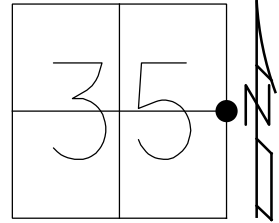

HORIZ.DATUM: NAD83 (2011) GEOID: NAVD88 2012A  
 GRID: NORTHING: 553229.869 EASTING: 1519278.304

RECORD:  
 FD 1/2" IPIPE  
 OVER STONE  
 FD P.K./WASHER  
 3" DOWN  
 4/29/03, MB  
 SET MAG/WASHER  
 10/30/03, MB  
 FD MAG NAIL  
 2/14/19, JLL  
 FD MAG NAIL  
 ON SURFACE  
 FD SM R.R.SPIKE  
 5" DOWN  
 REFA1  
 FD 1/2" IPIPE  
 6.5" DOWN  
 REFA1P  
 HIT CLAY  
 15" DOWN  
 7/6/20, JLL  
 SET MAG/WASHER  
 12/14/20, DSA

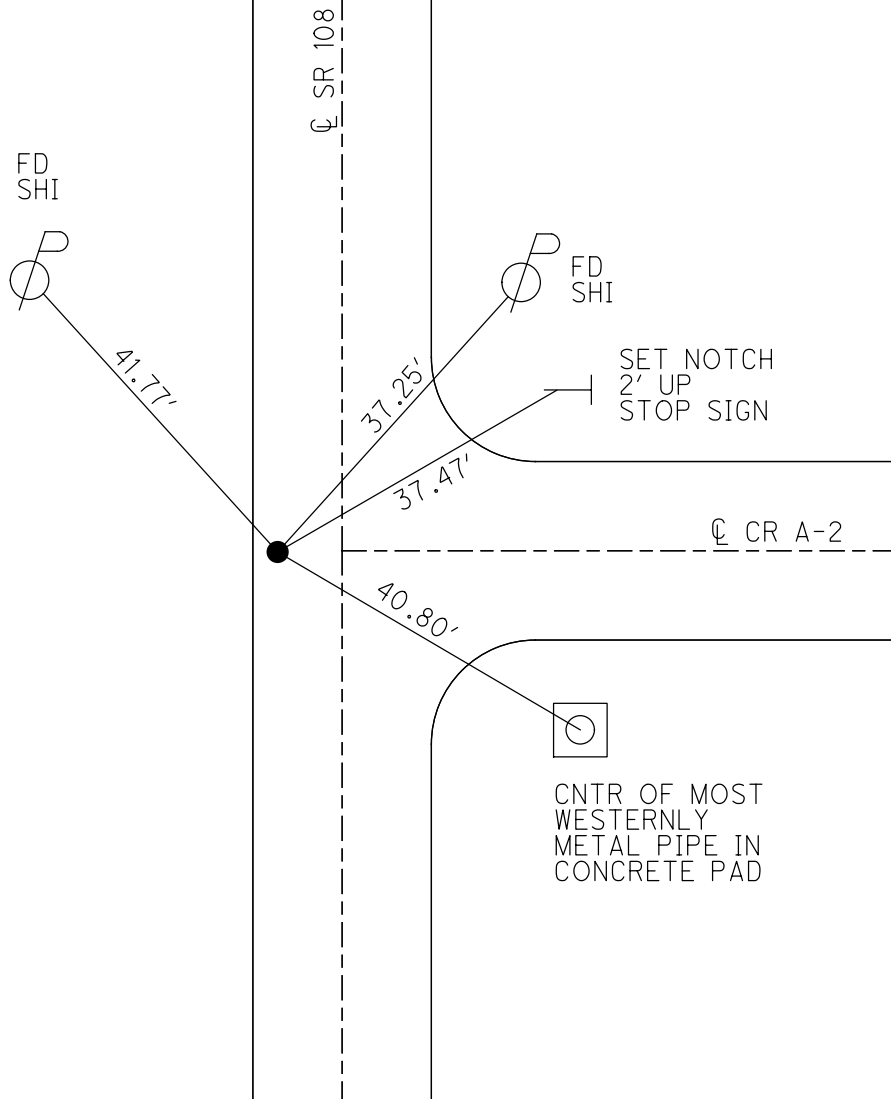

# O.D.O.T. DISTRICT 2 SURVEY OFFICE

PERSONNEL

REFERENCE NO. 1-A

SHEET 2 OF 20

NOTES BRUMBAUGH

H.C. BARNHISEL

R.C. GLASS

RYALL

DRAWN By: CANTERBURY

DATE 4-29-03

WEATHER CLEAR

TEMP. +50°

ROUTE S.R. # 108

COUNTY HENRY

TOWNSHIP PLEASANT

SECTION 35

T 3 N R 6 E


TYPE MONUMENT P.K. / WASHER

ON SURFACE - BELOW 3" DOWN

LEFT - ~~C~~ PAV'T. - RIGHT 8.3' LT


1.7 TO LT EDGE PAVEMENT

S.L.M. 26 + 45

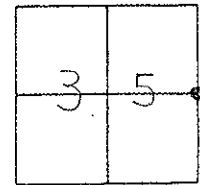

RECORD: 1/2" IRON PIPE OVER STONE

RESET MAR/WASHER  
10/30/03  
M.B.

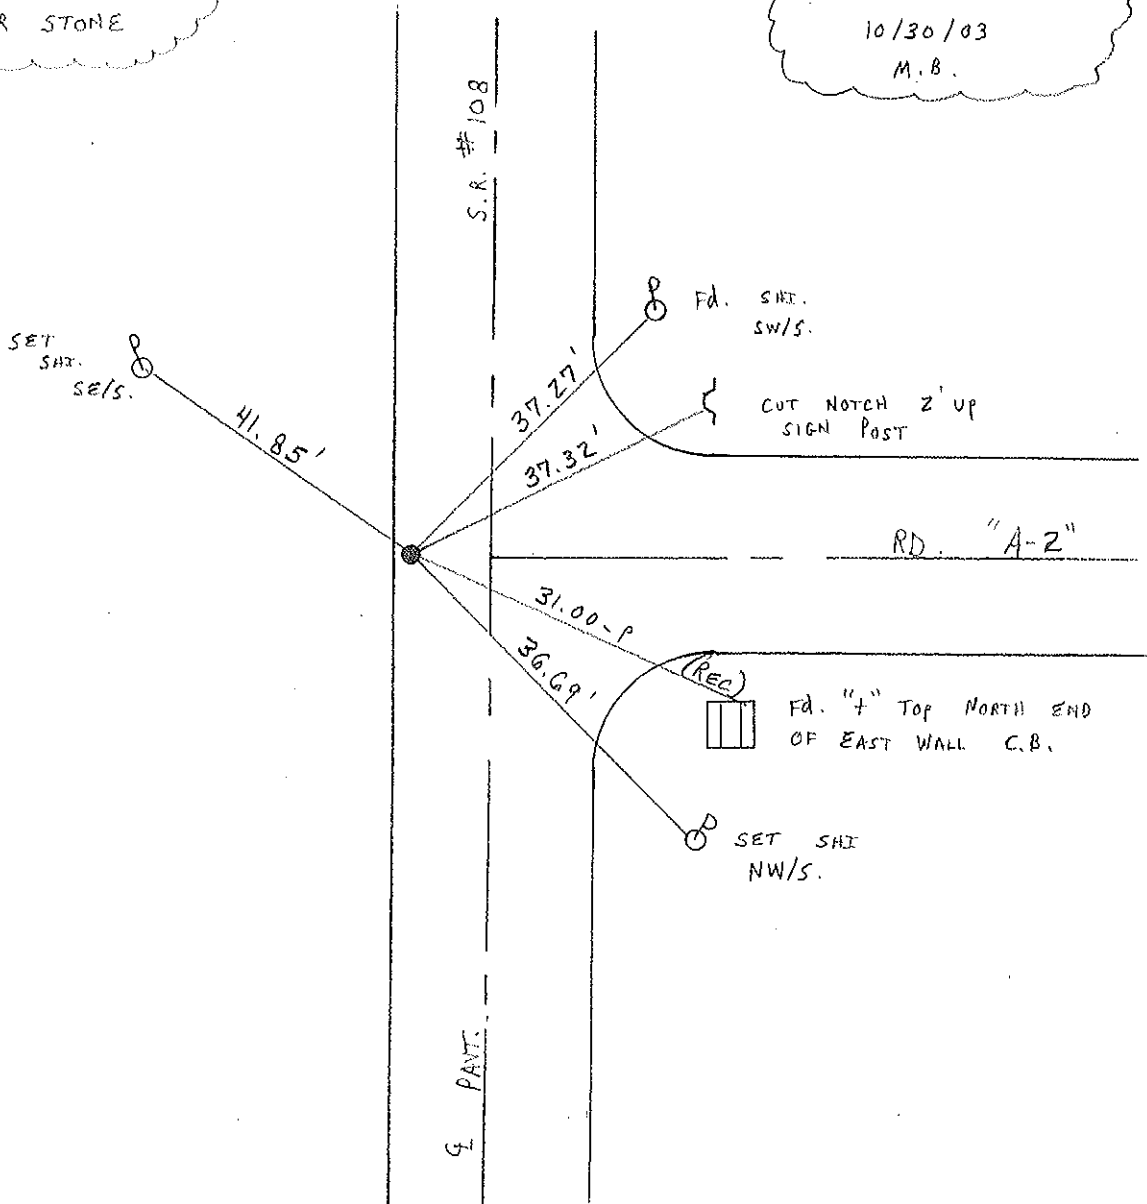

# O.D.O.T. DISTRICT 2 SURVEY OFFICE

PERSONNEL

REFERENCE NO. 1-A

SHEET 2 OF 54

NOTES Loehrke

H.C. FALKOWSKI

DATE 7-17-92

ROUTE SR108

R.C. ROMETO

WEATHER RAIN

COUNTY HENRY

TEMP. +70

TOWNSHIP PLeasant

SECTION 35

Reset 9-29-92

T 3 N 6 E


TYPE MONUMENT P.K. / WASHER

ON SURFACE - BELOW Yes


LEFT - ☉ PAV'T. - RIGHT 0.4

23 TO 4 EDGE PAVEMENT

S.L.M. 26+45

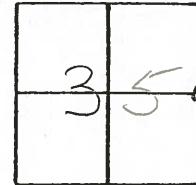

RECORD:  
1/2" IRON PIPE  
OVER STONE

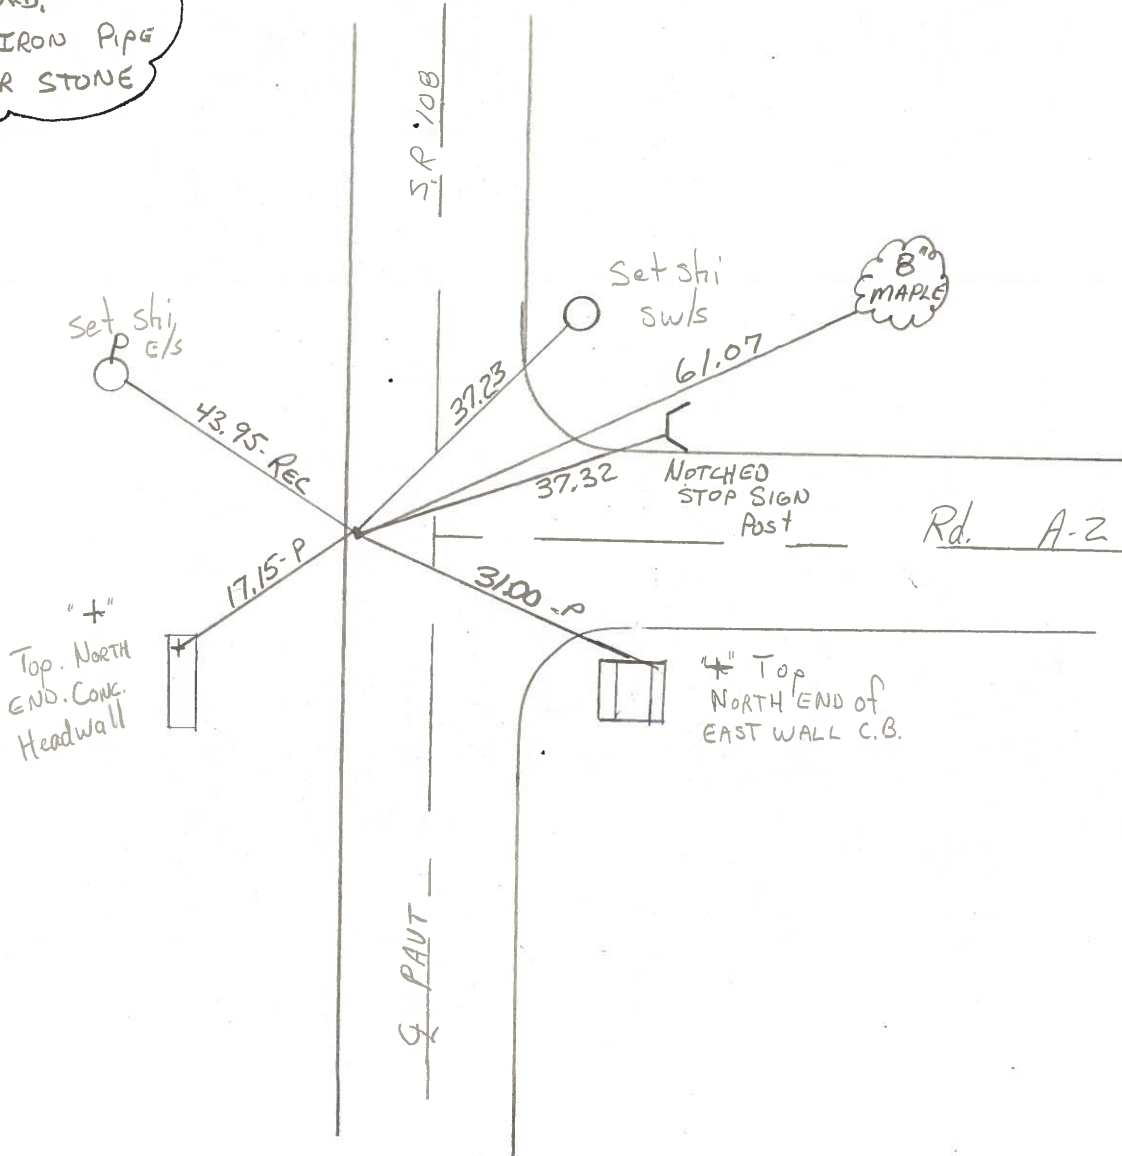

County Henry S.R. 108

Township Pleasant

Section E 1/4 Post Sec. 35

T3N, R6E

Personnel Barnhiser


Loehrke H.C.

Householder R.C.

Date 5-2-84

Weather Clear

Temp. +55°

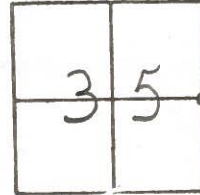


#1-A

FD, 5m RR, SPK  
 @ surface  
 SLM: 26+42  
 1.5 Rt of Lt ER  
 8.9 Lt @ 108  
 E of "A-2"

RECORDED  
 FD 1/2 IRON PIPE  
 @ surface over  
 stone + on west  
 edge Pavt SR 108

8-20-84  
 SET PK/WASHER  
 M.D.B.

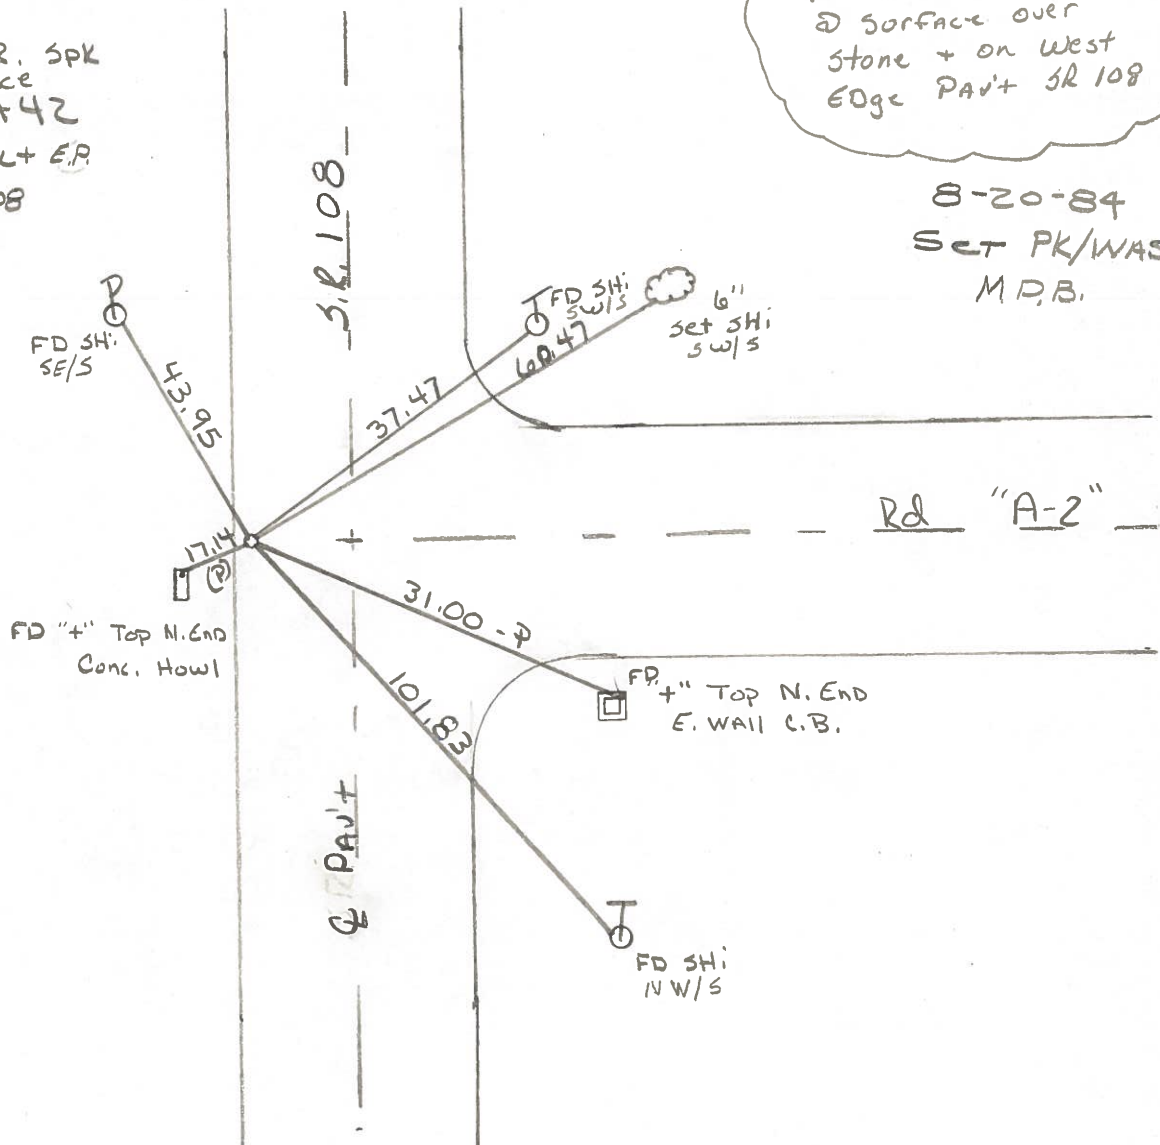

Q.D.O.T. DISTRICT 2 SURVEY OFFICE

Sht. 2 of 11  
S.R. 108

County HENRY

Date 8-2-78

Township PLEASANT


Weather CLOUDY

Section E 1/4 POST SEC. 35

Temp. +73°

T3N, R6E

Personnel BURNSIDE  
BOWERS

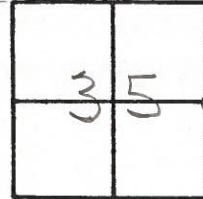

1-A

FD. 1/2" IRON PIPE  
@ SURFACE OVER  
STONE & ON WEST  
EDGE PAVE, S.R. 108

