

O.D.O.T. DISTRICT 2 SURVEY OFFICE (USE ONLY)

PERSONNEL

REFERENCE NO. 2 A

SHEET 5 OF 21

NOTES GARRETT

DATE 7/7/20

ROUTE SR 108

H.C. AUBLE

WEATHER SUNNY

COUNTY HENRY

R.C. MAHLER

TEMP. 79°

TOWNSHIP PLEASANT

DWG BY NIESE

PID 95739

SECTION 26

T 3 N R 6 E

TYPE MONUMENT R.R.SPIKE

~~ON SURFACE~~ - BELOW 2.5"

OFFSET  $\varnothing$  PAVEMENT 9.3' ~~LT~~ : RT

- TO - EDGE PAVEMENT



STATION: 91+67.42

HORZ.DATUM: NAD83 (2011)

GEOID: NAVD88 2012A

GRID: NORTHING: 559754.419

EASTING: 1519358.887

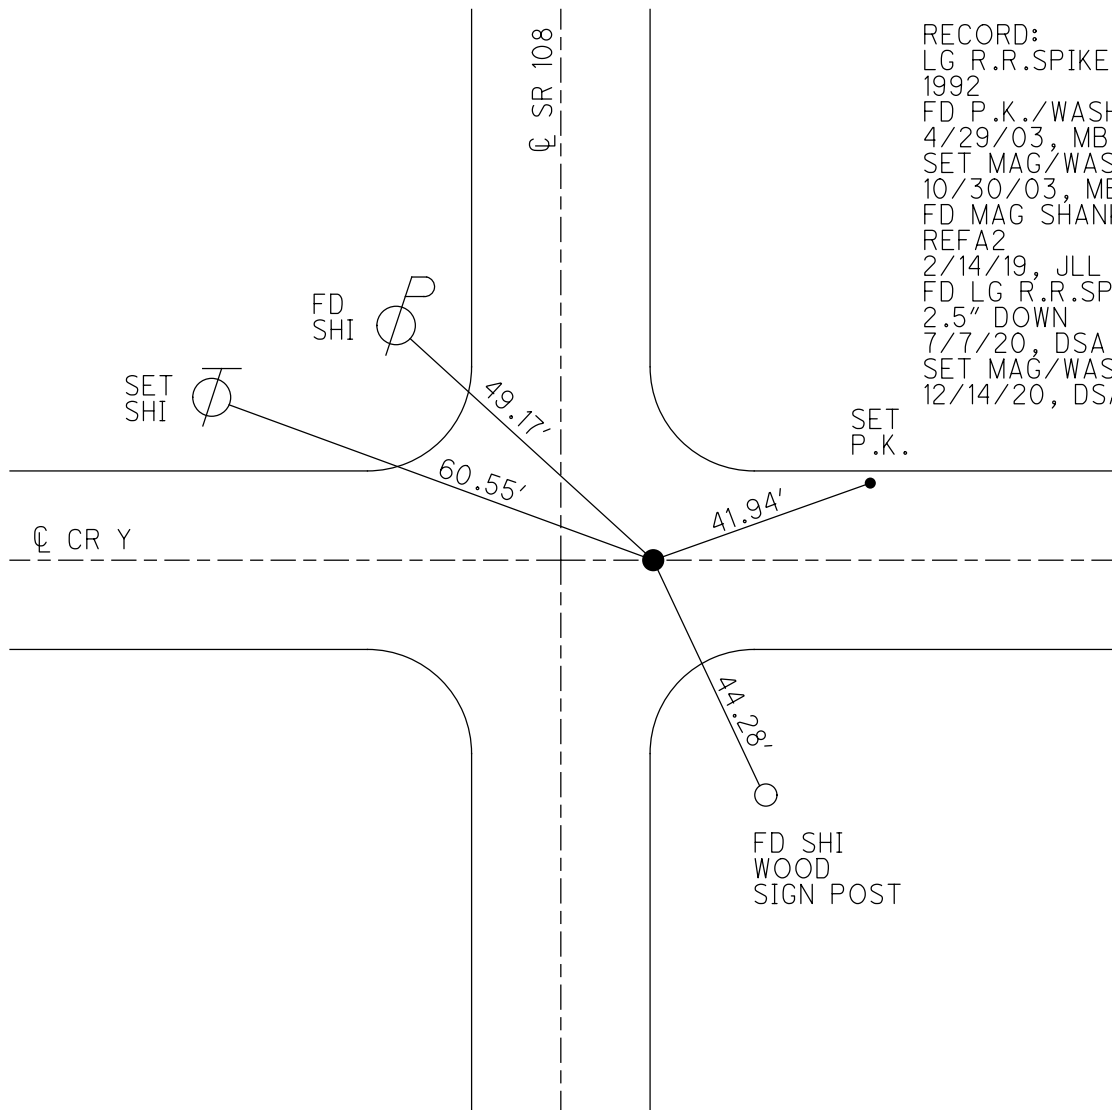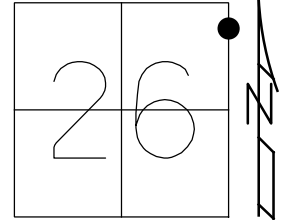

RECORD:  
 LG R.R.SPIKE  
 1992  
 FD P.K./WASHER  
 4/29/03, MB  
 SET MAG/WASHER  
 10/30/03, MB  
 FD MAG SHANK  
 REFA2  
 2/14/19, JLL  
 FD LG R.R.SPIKE  
 2.5" DOWN  
 7/7/20, DSA  
 SET MAG/WASHER  
 12/14/20, DSA

# O.D.O.T. DISTRICT 2 SURVEY OFFICE

PERSONNEL

REFERENCE NO. 2-A

SHEET 4 OF 20

NOTES BRUMBAUGH

H.C. BARNHISEL

R.C. GLASS

RYALL

DRAWN BY: CANTERBURY

DATE 4-29-03

WEATHER CLEAR

TEMP. +50°

ROUTE S.R.# 108

COUNTY HENRY

TOWNSHIP PLEASANT

SECTION 26

T 3 N R 6 E


TYPE MONUMENT P.K / WASHER

ON SURFACE - ~~BELOW~~ SURFACE

LEFT - ~~CL~~ PAV'T. - RIGHT 9.3' RT.


TO EDGE PAVEMENT

S.L.M. 91+70

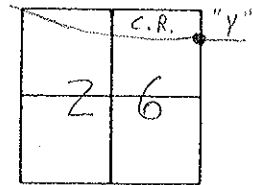

RECORD: 1992 NOTES CALL  
FOR A LG. R.R. SPK.

RESET MAG/WASHER  
10/30/03  
M.B.

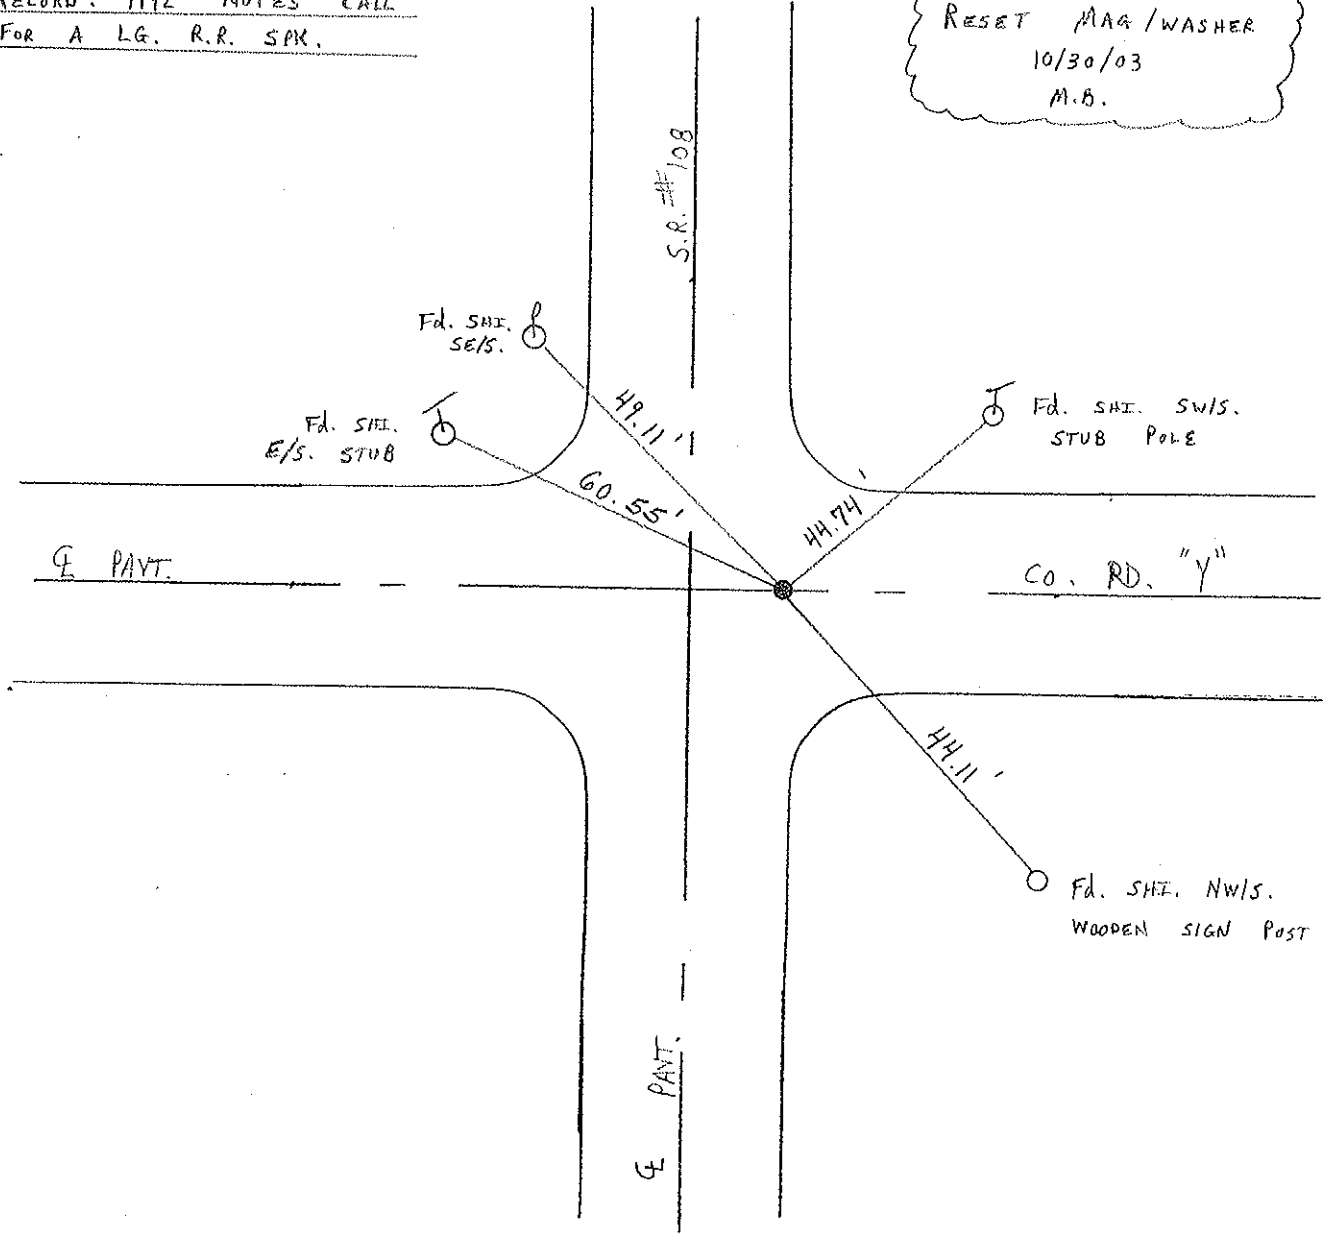

# O.D.O.T. DISTRICT 2 SURVEY OFFICE

PERSONNEL \_\_\_\_\_

REFERENCE NO. \_\_\_\_\_

SHEET 4 OF 54

NOTES LOEHRKE

H.C. CURTIS

R.C. ROMETO

FALKOWSKI

DATE 7-21-92

WEATHER Pt Cloudy

TEMP. +70

ROUTE S.R. 108

COUNTY HENRY

TOWNSHIP PLEASANT

SECTION 26

T 3 N R 6 E

TYPE MONUMENT Lg R.R. Spike


ON SURFACE - BELOW Yes

LEFT - ~~C~~ PAV'T. - RIGHT 9.4'

0.6 TO Rt EDGE PAVEMENT

S.L.M. 91 + 70

Set P.K. / WASHER  
9-29-92

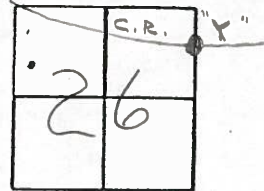

**2-A**

