

O.D.O.T. DISTRICT 2 SURVEY OFFICE (USE ONLY)

PERSONNEL

REFERENCE NO. 5 A

SHEET 9 OF 21

NOTES GARRETT

DATE 7/7/20

ROUTE SR 108

H.C. AUBLE

WEATHER SUNNY

COUNTY HENRY

R.C. MAHLER

TEMP. 88°

TOWNSHIP PLEASANT

SECTION 14

DWG BY NIESE

PID 95739

T 3 N R 6 E

TYPE MONUMENT MAG/WASHER

ON SURFACE - ~~BELOW~~ ON

OFFSET \odot PAVEMENT 3' LT : ~~RT~~

7.3' TO LT EDGE PAVEMENT


STATION: 185+45.16

HORZ.DATUM: NAD83 (2011)

GEOID: NAVD88 2012A

GRID: NORTHING: 569131.476

EASTING: 1519472.369

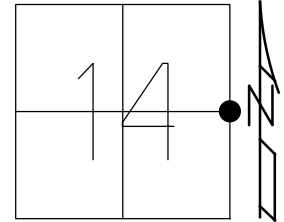

SET MAG
ASPHALT DR

SET
SHI



43.99'

48.46'

36.57'

FD
SHI




\odot SR 108

RECORD:
FD P.K./WASHER
4/30/03, MB
SET MAG/WASHER
10/30/03, MB
FD MAG/WASHER
REF6
2/10/16, JLL
FD MAG/WASHER
REF6
2/14/19, JLL
10/4/19, JFO
7/7/20, DSA
SET MAG/WASHER
12/14/20, DSA


O.D.O.T. DISTRICT 2 SURVEY OFFICE (USE ONLY)

PERSONNEL _____ REFERENCE NO. 5 A SHEET 2 OF 16
 NOTES BRUMBAUGH DATE 4/30/03 ROUTE SR 108
 H.C. BARNHISEL WEATHER SUNNY COUNTY HENRY
 R.C. RYALL TEMP. 55° TOWNSHIP PLEASANT
 _____ CANTERBURY _____ SECTION 14
 _____ T 3 N R 6 E

TYPE MONUMENT P.K./WASHER
 ON SURFACE - ~~BELOW~~ ON _____
 LEFT - ☉ PAV'T - ~~RIGHT~~ 2.4'
7.3' TO LT EDGE PAVEMENT
 S.L.M. 184+55
 Grid: Northing: 569131.493 Easting: 1519472.380

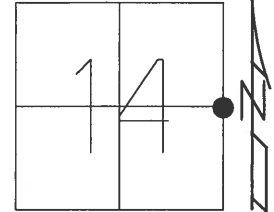

RECORD:
 SET MAG/WASHER
 10/30/03, MB
 FD MAG/WASHER
 REF6
 2/10/16, JLL

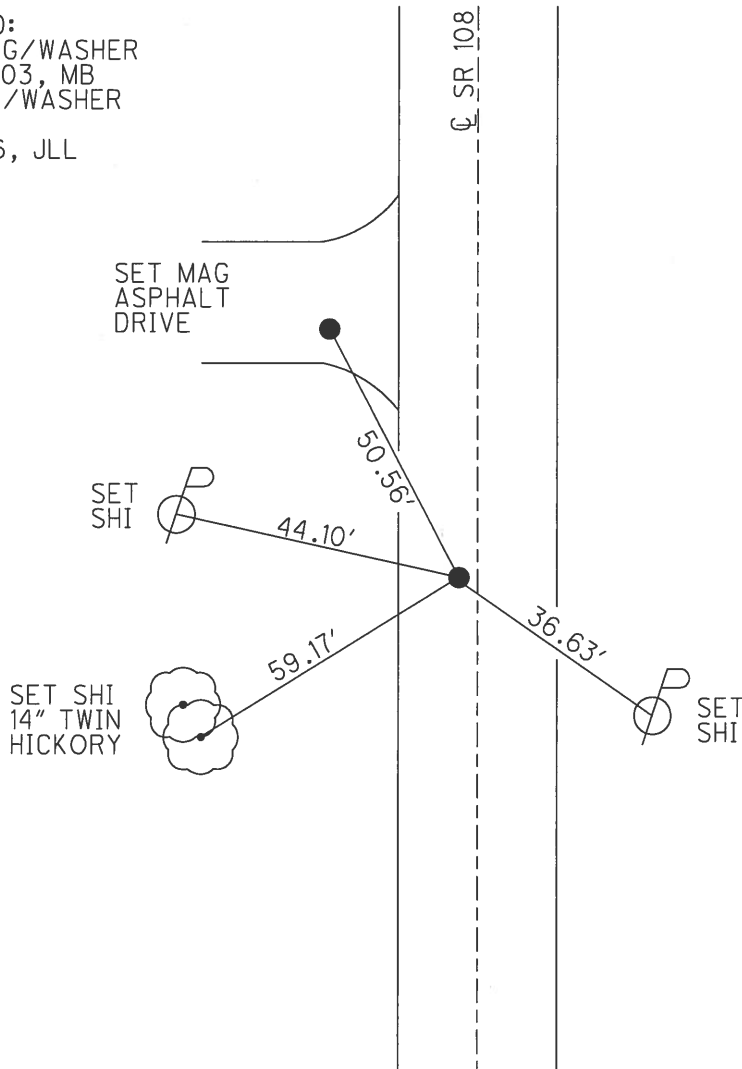

O.D.O.T. DISTRICT 2 SURVEY OFFICE

PERSONNEL

REFERENCE NO. 5-A

SHEET 8 OF 20

NOTES BRUMBAUGH

H.C. BARNHISEL

R.C. RYALL

DRAWN BY: CANTERBURY

DATE 4-30-03

WEATHER SUN

TEMP. + 55°

ROUTE S.R. # 108

COUNTY HENRY

TOWNSHIP PLEASANT

SECTION 13

T 3 N R 6 E



TYPE MONUMENT P.R. / WASHER

ON SURFACE - BELOW SURFACE


LEFT - Q PAV'T. - RIGHT 2.4' LT &

7.3' TO LT. EDGE PAVEMENT

S.L.M. 185 + 50

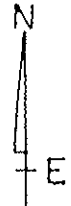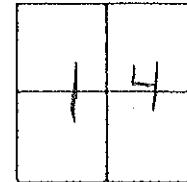

RESET MAG/WASHER
 10/30/03
 M.B.

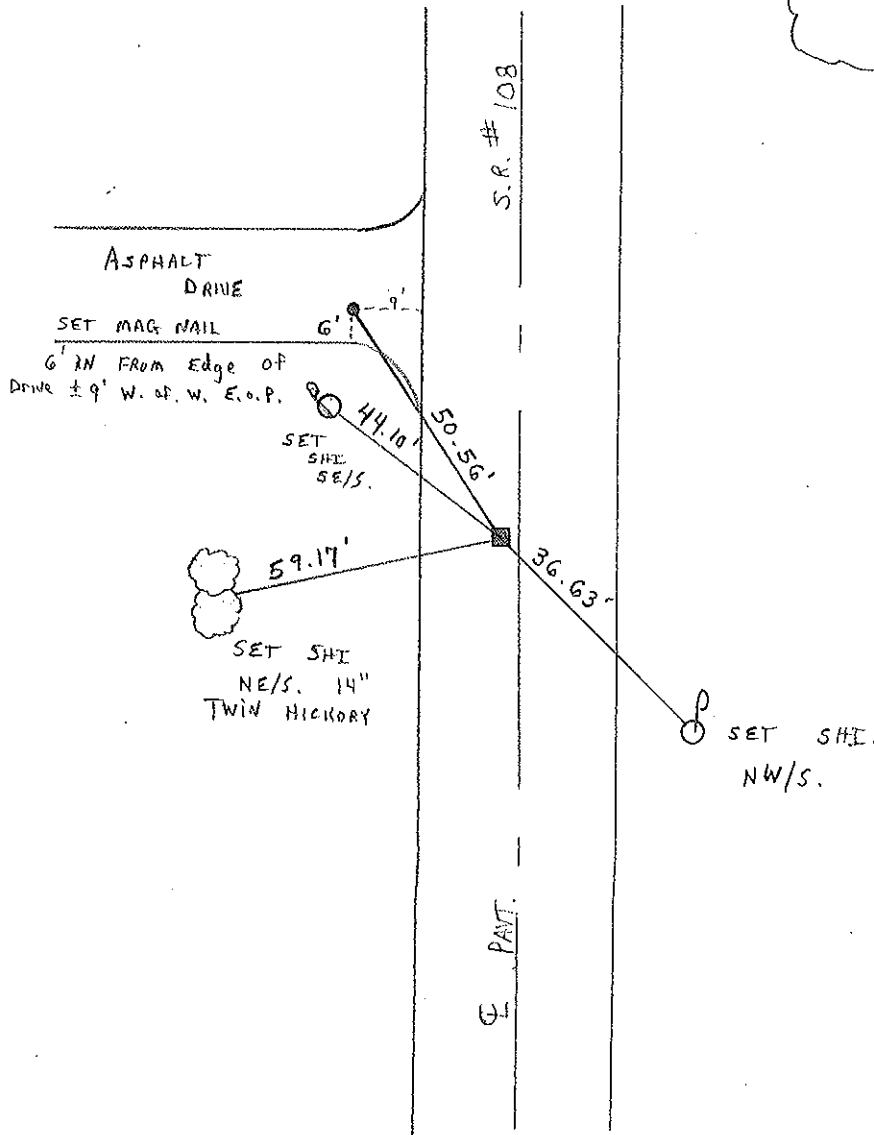

O.D.O.T. DISTRICT 2 SURVEY OFFICE

PERSONNEL _____

REFERENCE NO. 5-A

SHEET _____ OF _____

NOTES CORDES

H.C. BARNHISEL

DATE 10-6-94

ROUTE 108

R.C. CANTERBURY

WEATHER SUNNY

COUNTY HENRY

MOSEER

TEMP. +55° F

TOWNSHIP PLEASANT

SLOVAK

SECTION 13

T3 N R 6 E


TYPE MONUMENT LG RR SPIKE (BY HENRY County)

~~ON SURFACE~~ - BELOW 3" down

LEFT- & PAV'T. - RIGHT 2.5

ZZ TO LT. EDGE PAVEMENT

S.L.M. 185+50

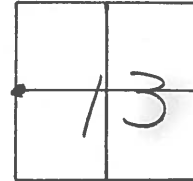

RESET PK AND WASHER TO SURFACE
10-6-94 B.W.C.

