

O.D.O.T. DISTRICT 2 SURVEY OFFICE (USE ONLY)

PERSONNEL

REFERENCE NO. 6

SHEET 10 OF 24

NOTES BRUMBAUGH

DATE 4/30/03

ROUTE SR 108

H.C. BARNHISEL

WEATHER PTLY.CLOUDY

COUNTY HENRY

R.C. RYALL

TEMP. 55°

TOWNSHIP PLEASANT

CANTERBURY

SECTION 14

DWG BY RHOADES PID _____

T 3 N R 6 E

TYPE MONUMENT P.K.SHANK

ON SURFACE - ~~BELOW~~ ON _____

OFFSET ☉ PAVEMENT 1.3' LT : ~~RT~~

8.5' TO LT EDGE PAVEMENT


STATION: 205+46

HORZ.DATUM: _____


GEOID: _____

GRID: NORTHING: _____

EASTING: _____

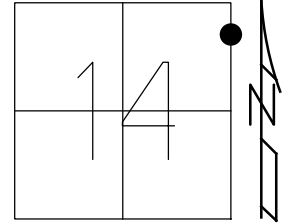

RECORD:
FD P.K.SHANK
4/30/03, MB
SET MAG/WASHER
10/30/03, MB

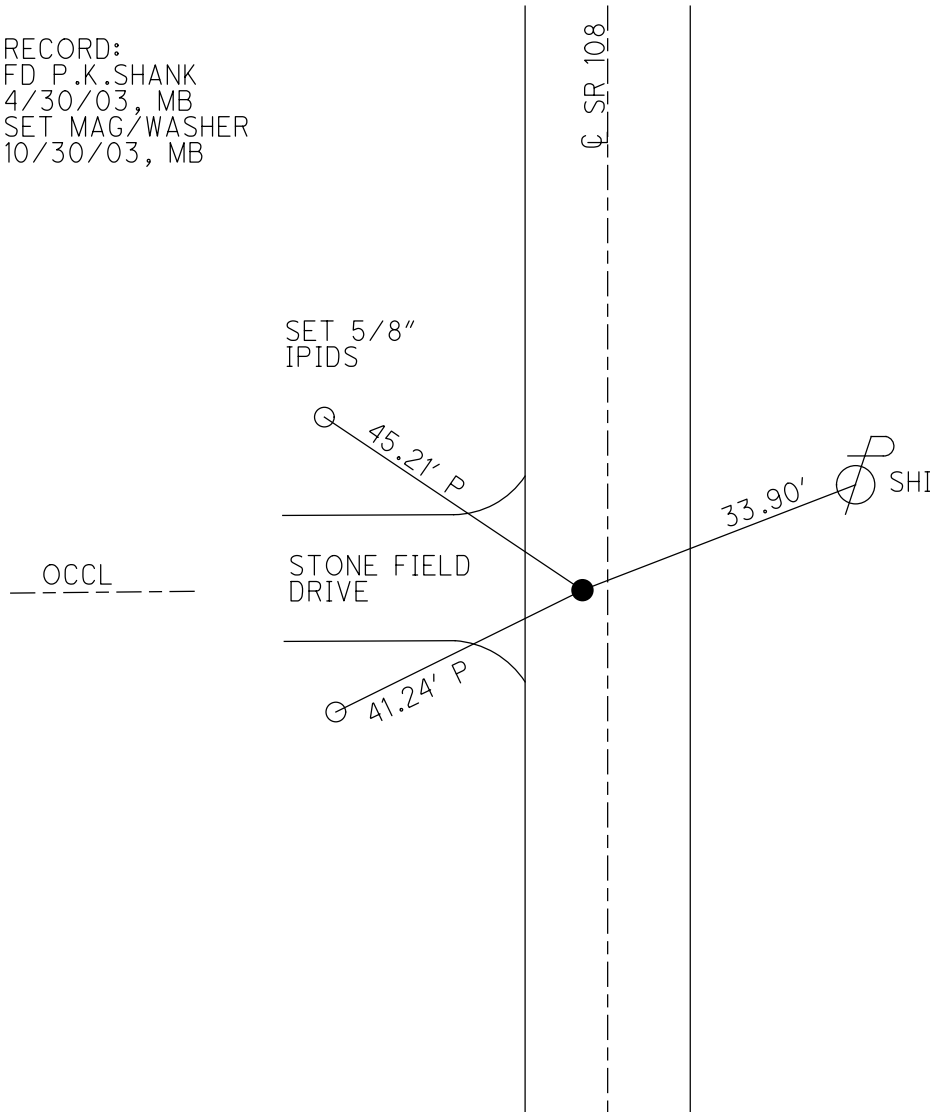

O.D.O.T. DISTRICT 2 SURVEY OFFICE

PERSONNEL

REFERENCE NO. 6

SHEET 9 OF 20

NOTES BRUMBAUGH

H.C. BARNHISEL

R.C. RYALL

DRAWN: CANTERBURY

DATE 4-30-03

WEATHER Pt. CLOUDY

TEMP. +55°

ROUTE S.R. # 108

COUNTY HENRY

TOWNSHIP PLEASANT

SECTION 14

T 3 N R 6 E


TYPE MONUMENT P.K. SHANK

ON SURFACE - BELOW SURFACE


LEFT - PAV'T. - RIGHT 1.3' LT &

8.5 TO LT. EDGE PAVEMENT

S.L.M. 205+46

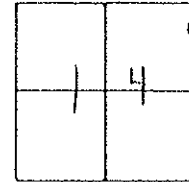

RESET MAG/WASHER
10/30/03
MB

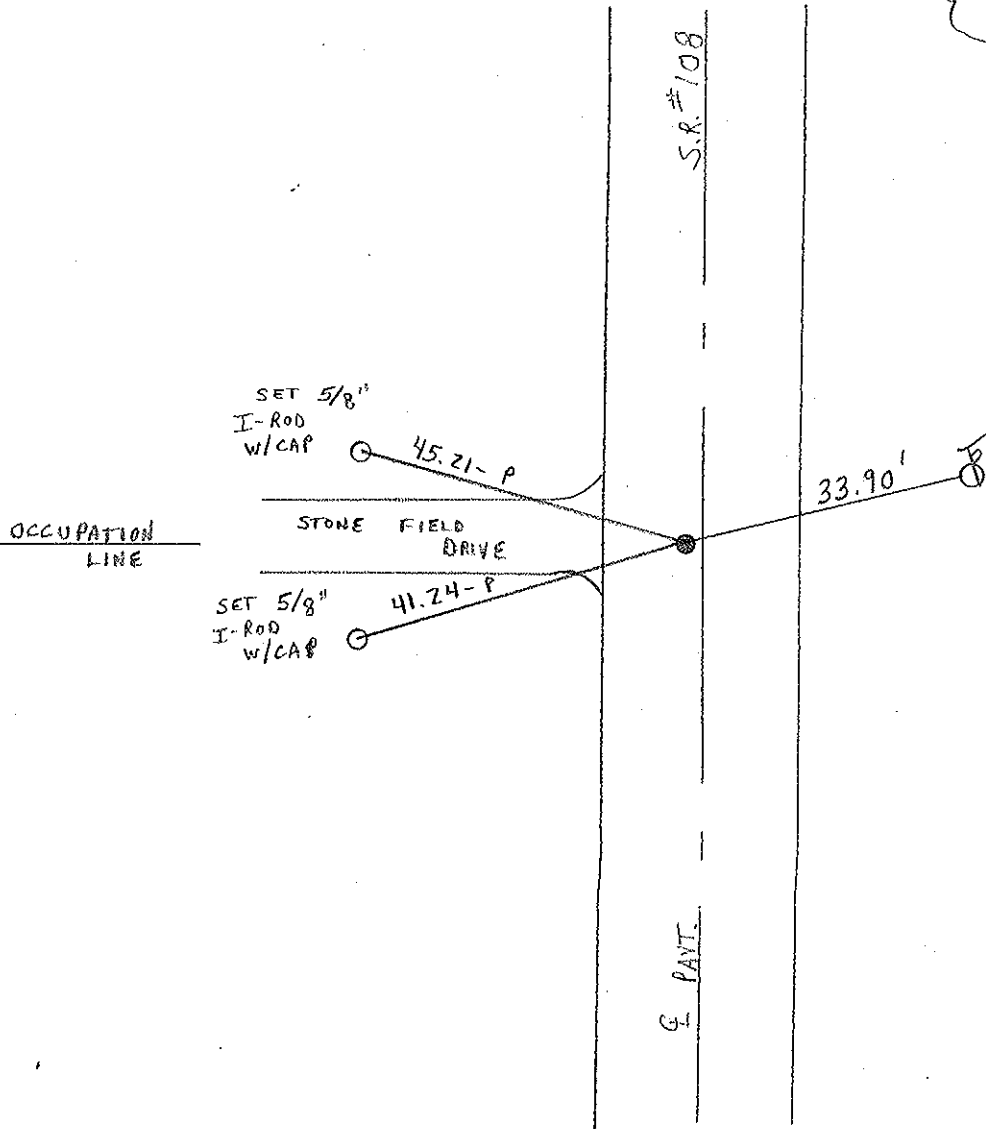

O.D.O.T. DISTRICT 2 SURVEY OFFICE

PERSONNEL

REFERENCE NO. 6



SHEET 8 OF 54

NOTES Loehrke
H.C. CURTIS
R.C. ROMETO
FALKOWSKI

DATE 7-21-92
WEATHER Pt Cloudy
TEMP. +72

ROUTE S.R. 108
COUNTY HENRY
TOWNSHIP PLEASANT
SECTION 14
T 3 N R 6 E

TYPE MONUMENT P.K. / WASHER ^{Reset} 9-29-92
ON SURFACE - BELOW Yes
LEFT- & PAV'T. - RIGHT 1.3'
9.0' TO Lt EDGE PAVEMENT
S.L.M. 205+46

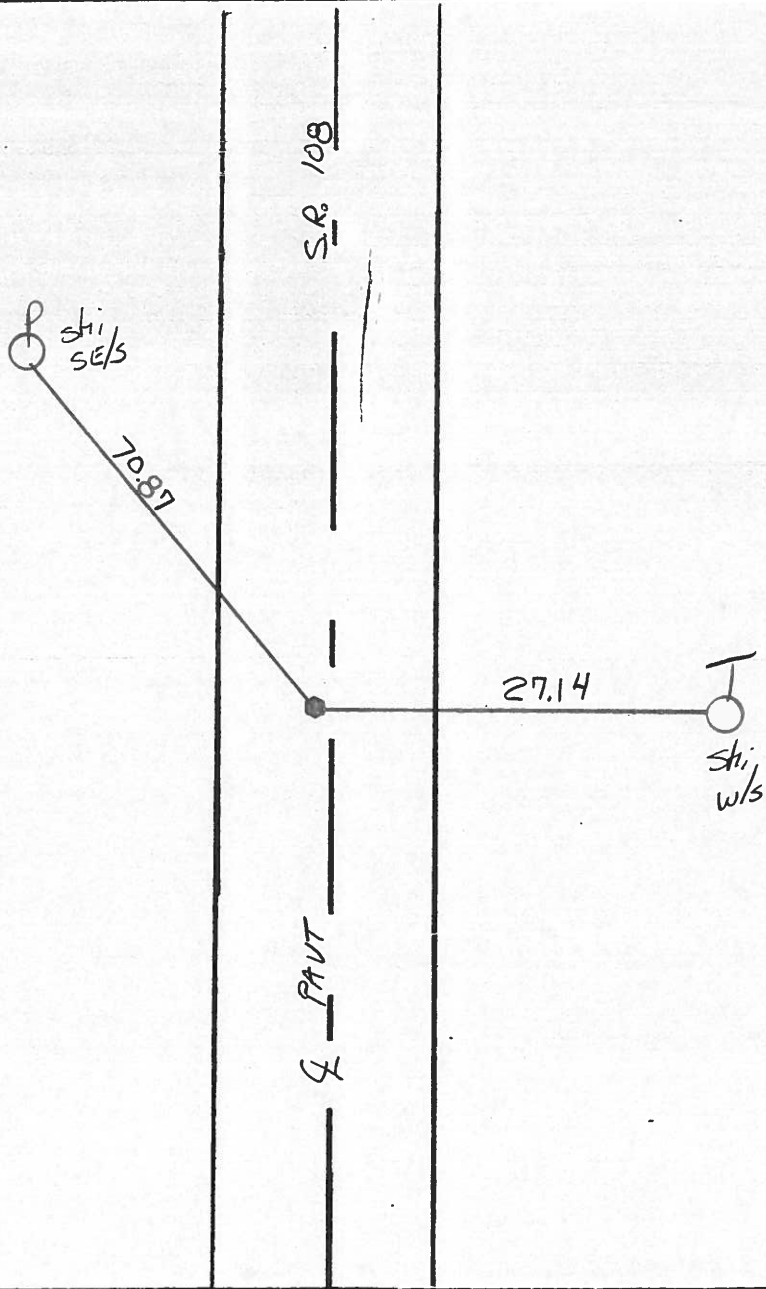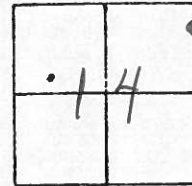

County HENRY S.R. 108

Date 5-2-84

Township PLEASANT

Weather Clear

Section 14


Temp. + 58°

T3N, R6E

Personnel Barnhiser

Loehrke H.C.

Householder R.C.

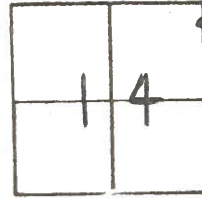

#6

FD 5m RR SPK @ surface

8-27-84


SET PK/WASHER

SLM: 205+33

1.8 Lt of E 108

8.1 Rt of Lt EP

11.2 Lt of Rt EP

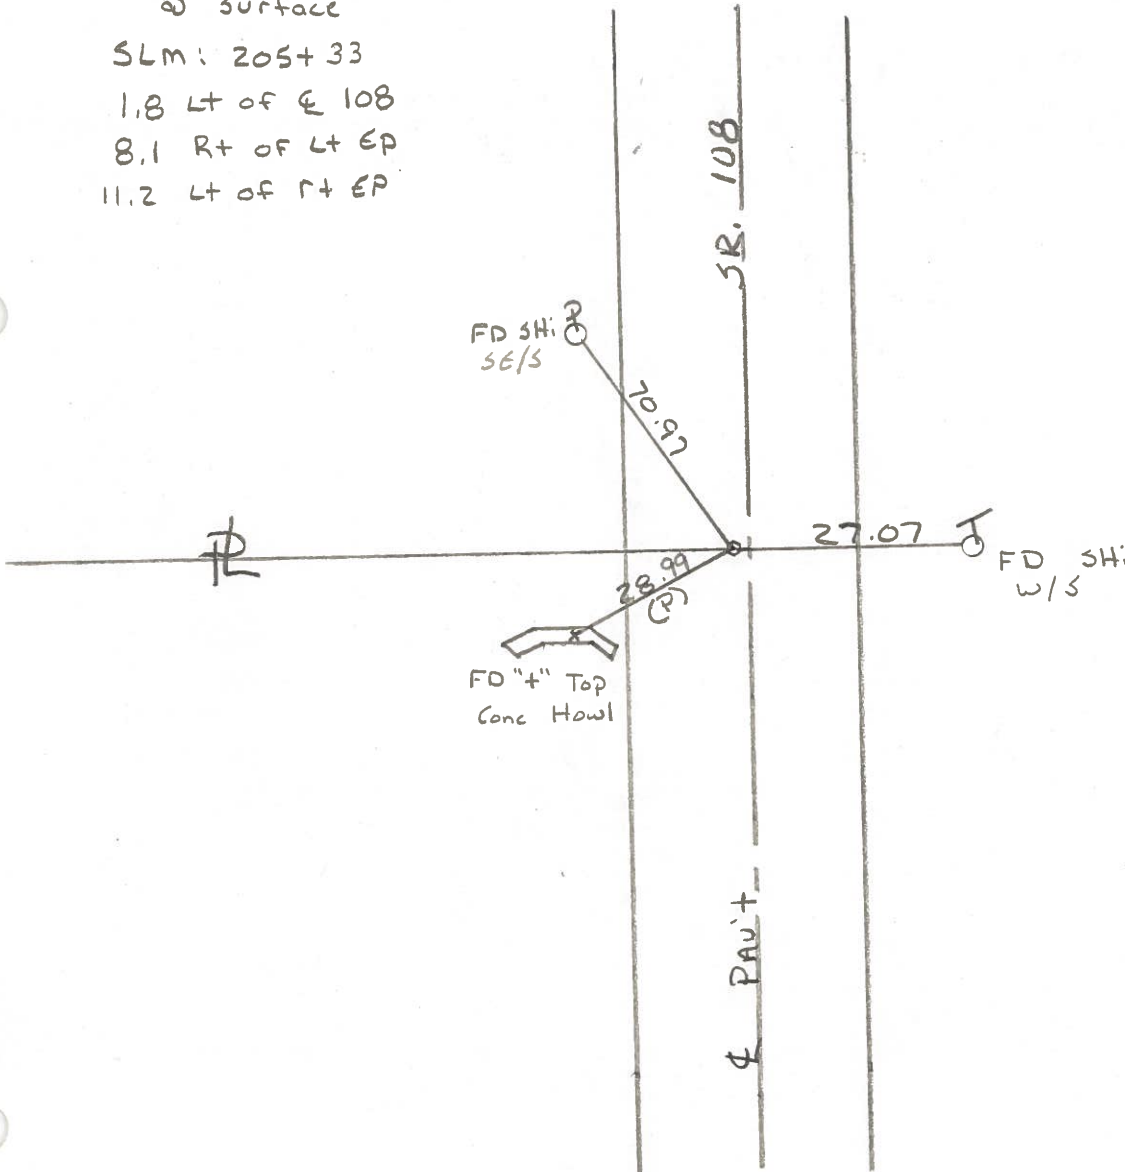

O.D.O.T. DISTRICT 2 SURVEY OFFICE

Sht. 6 of 11
S-R.108

County HENRY

Date 8-2-78

Township PLEASANT


Weather LT-RAIN

Section 500'± S. SEC. COR. 1, 12, 13, 14

Temp. +82°

T3N, R6E

Personnel BURNSIDE

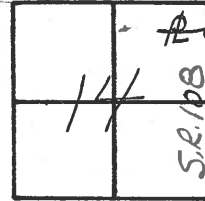

SMITH


BOWERS

KNAPE

MEAD

6

FD. SMALL SPK @
SURFACE & 2'± W.
CTR. PAVE.

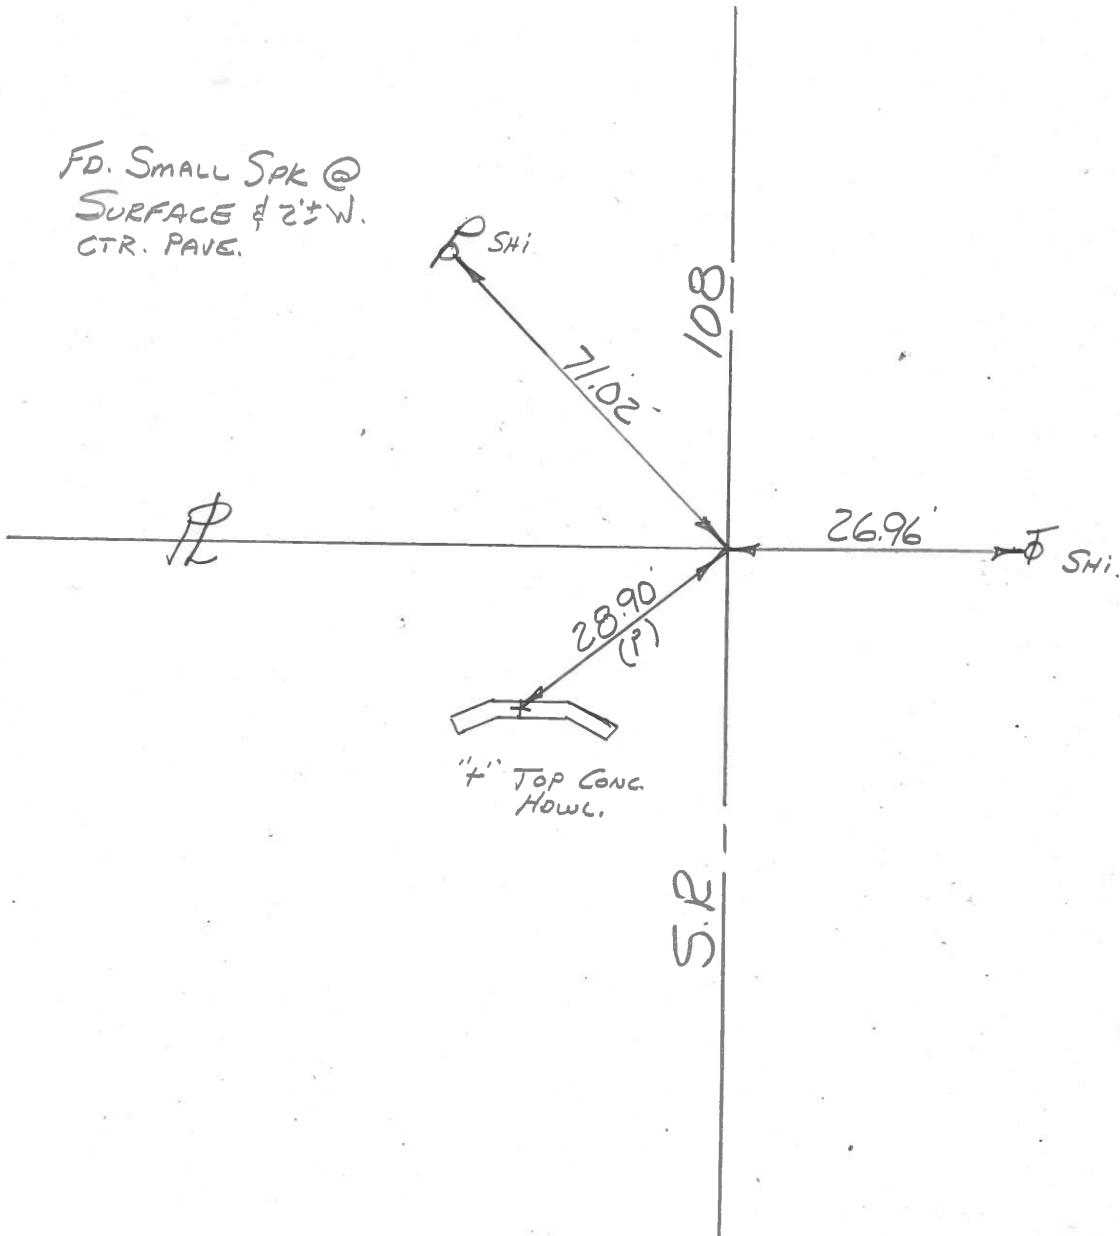

PERSONNEL	TITLE	PERSONNEL	TITLE	COUNTY	DATE
Tomsic				HENRY	July 15, 1974
Neuser				S. R. 108	WEATHER
Granata				SEC. Pleasant Twp	TEMP.

DESCRIPTION LEFT CENTER LINE RIGHT JOB NO.

