

O.D.O.T. DISTRICT 2 SURVEY OFFICE (USE ONLY)

PERSONNEL

REFERENCE NO. 7 B

SHEET 13 OF 24

NOTES HOFFMAN

DATE 1/22/82

ROUTE SR 108

H.C. HOUSEHOLDER

WEATHER SNOW, WINDY

COUNTY HENRY

R.C. LOEHRKE

TEMP. 14°

TOWNSHIP PLEASANT

GRIFFITH

SECTION 11

DWG BY RHOADES

PID _____

T 3 N R 6 E

TYPE MONUMENT P.K.NAIL

ON SURFACE - ~~BELOW~~ ON

OFFSET \bar{C} PAVEMENT 4.1' LT : ~~RT~~

5.8' TO LT EDGE PAVEMENT


STATION: 221+14.20

HORZ.DATUM: _____


GEOID: _____

GRID: NORTHING: _____

EASTING: _____

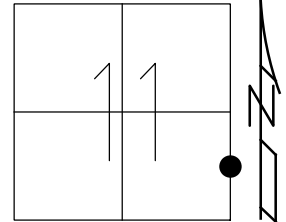

RECORD:
 SET P.K.NAIL
 F/C BRIDGE CONTROL
 1/22/82, CL
 D.N.RESET
 9/92, CL

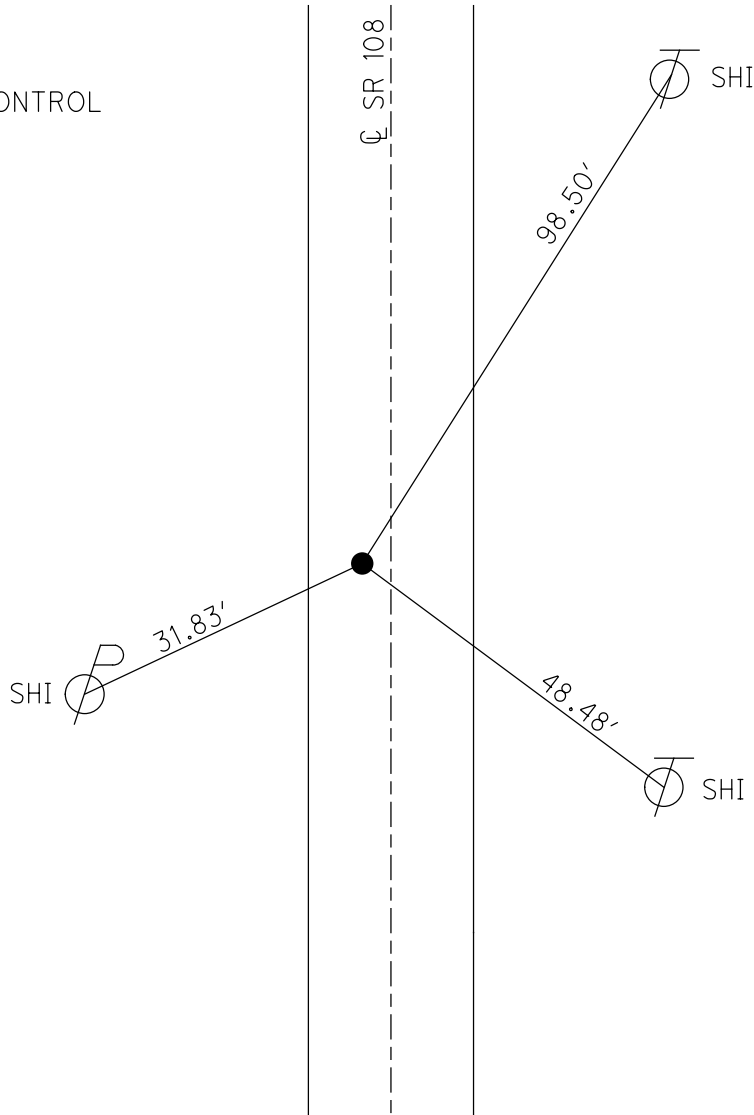

County HENRY S.R. 108

Date 1-22-82

Township PLEASANT


Weather Slow - Windy

Section 11

Temp. + 14°

T3N, R6E

Personnel HOFFMAN
Householder
Loehke
Griffith

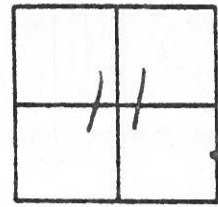


Set P.K. Nail FOR $\&$ Bridge Control STA 221 + 14.20

4.1 W. of $\&$ PAUT.

#7-B

13.6 to E.E.P.

5.8 to W.E.P.

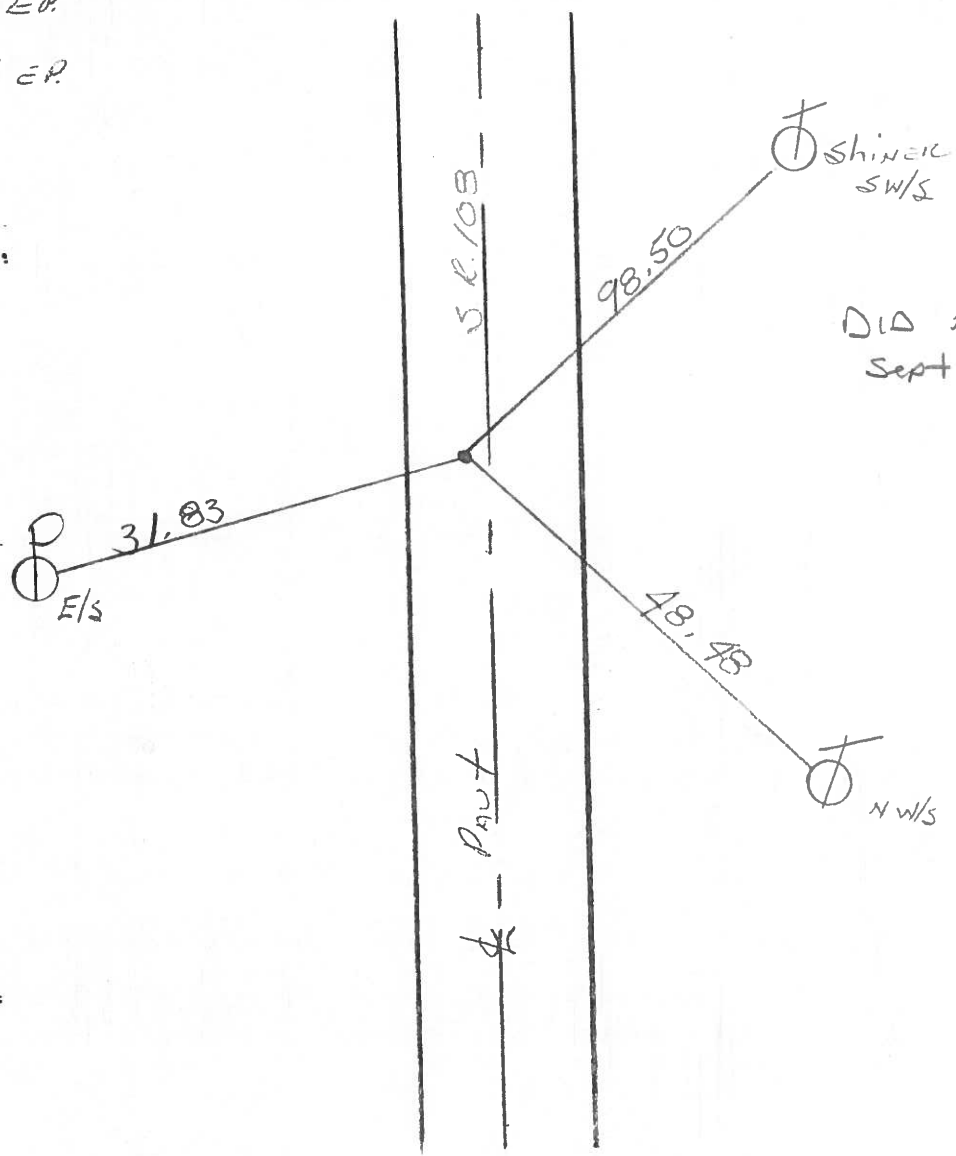

DID NOT Re-set
Sept, 1992
CL.